


BENCHMARKS

BM #2 - "□" Top of Curb @ 4.72m West
and 27.83m North of the Centerline
of both Central and Kessler.
Elev. = 398.546 SI Units
(1307.55 MSL Datum)


5 0 10 25
Scale: 1:200
• = Iron

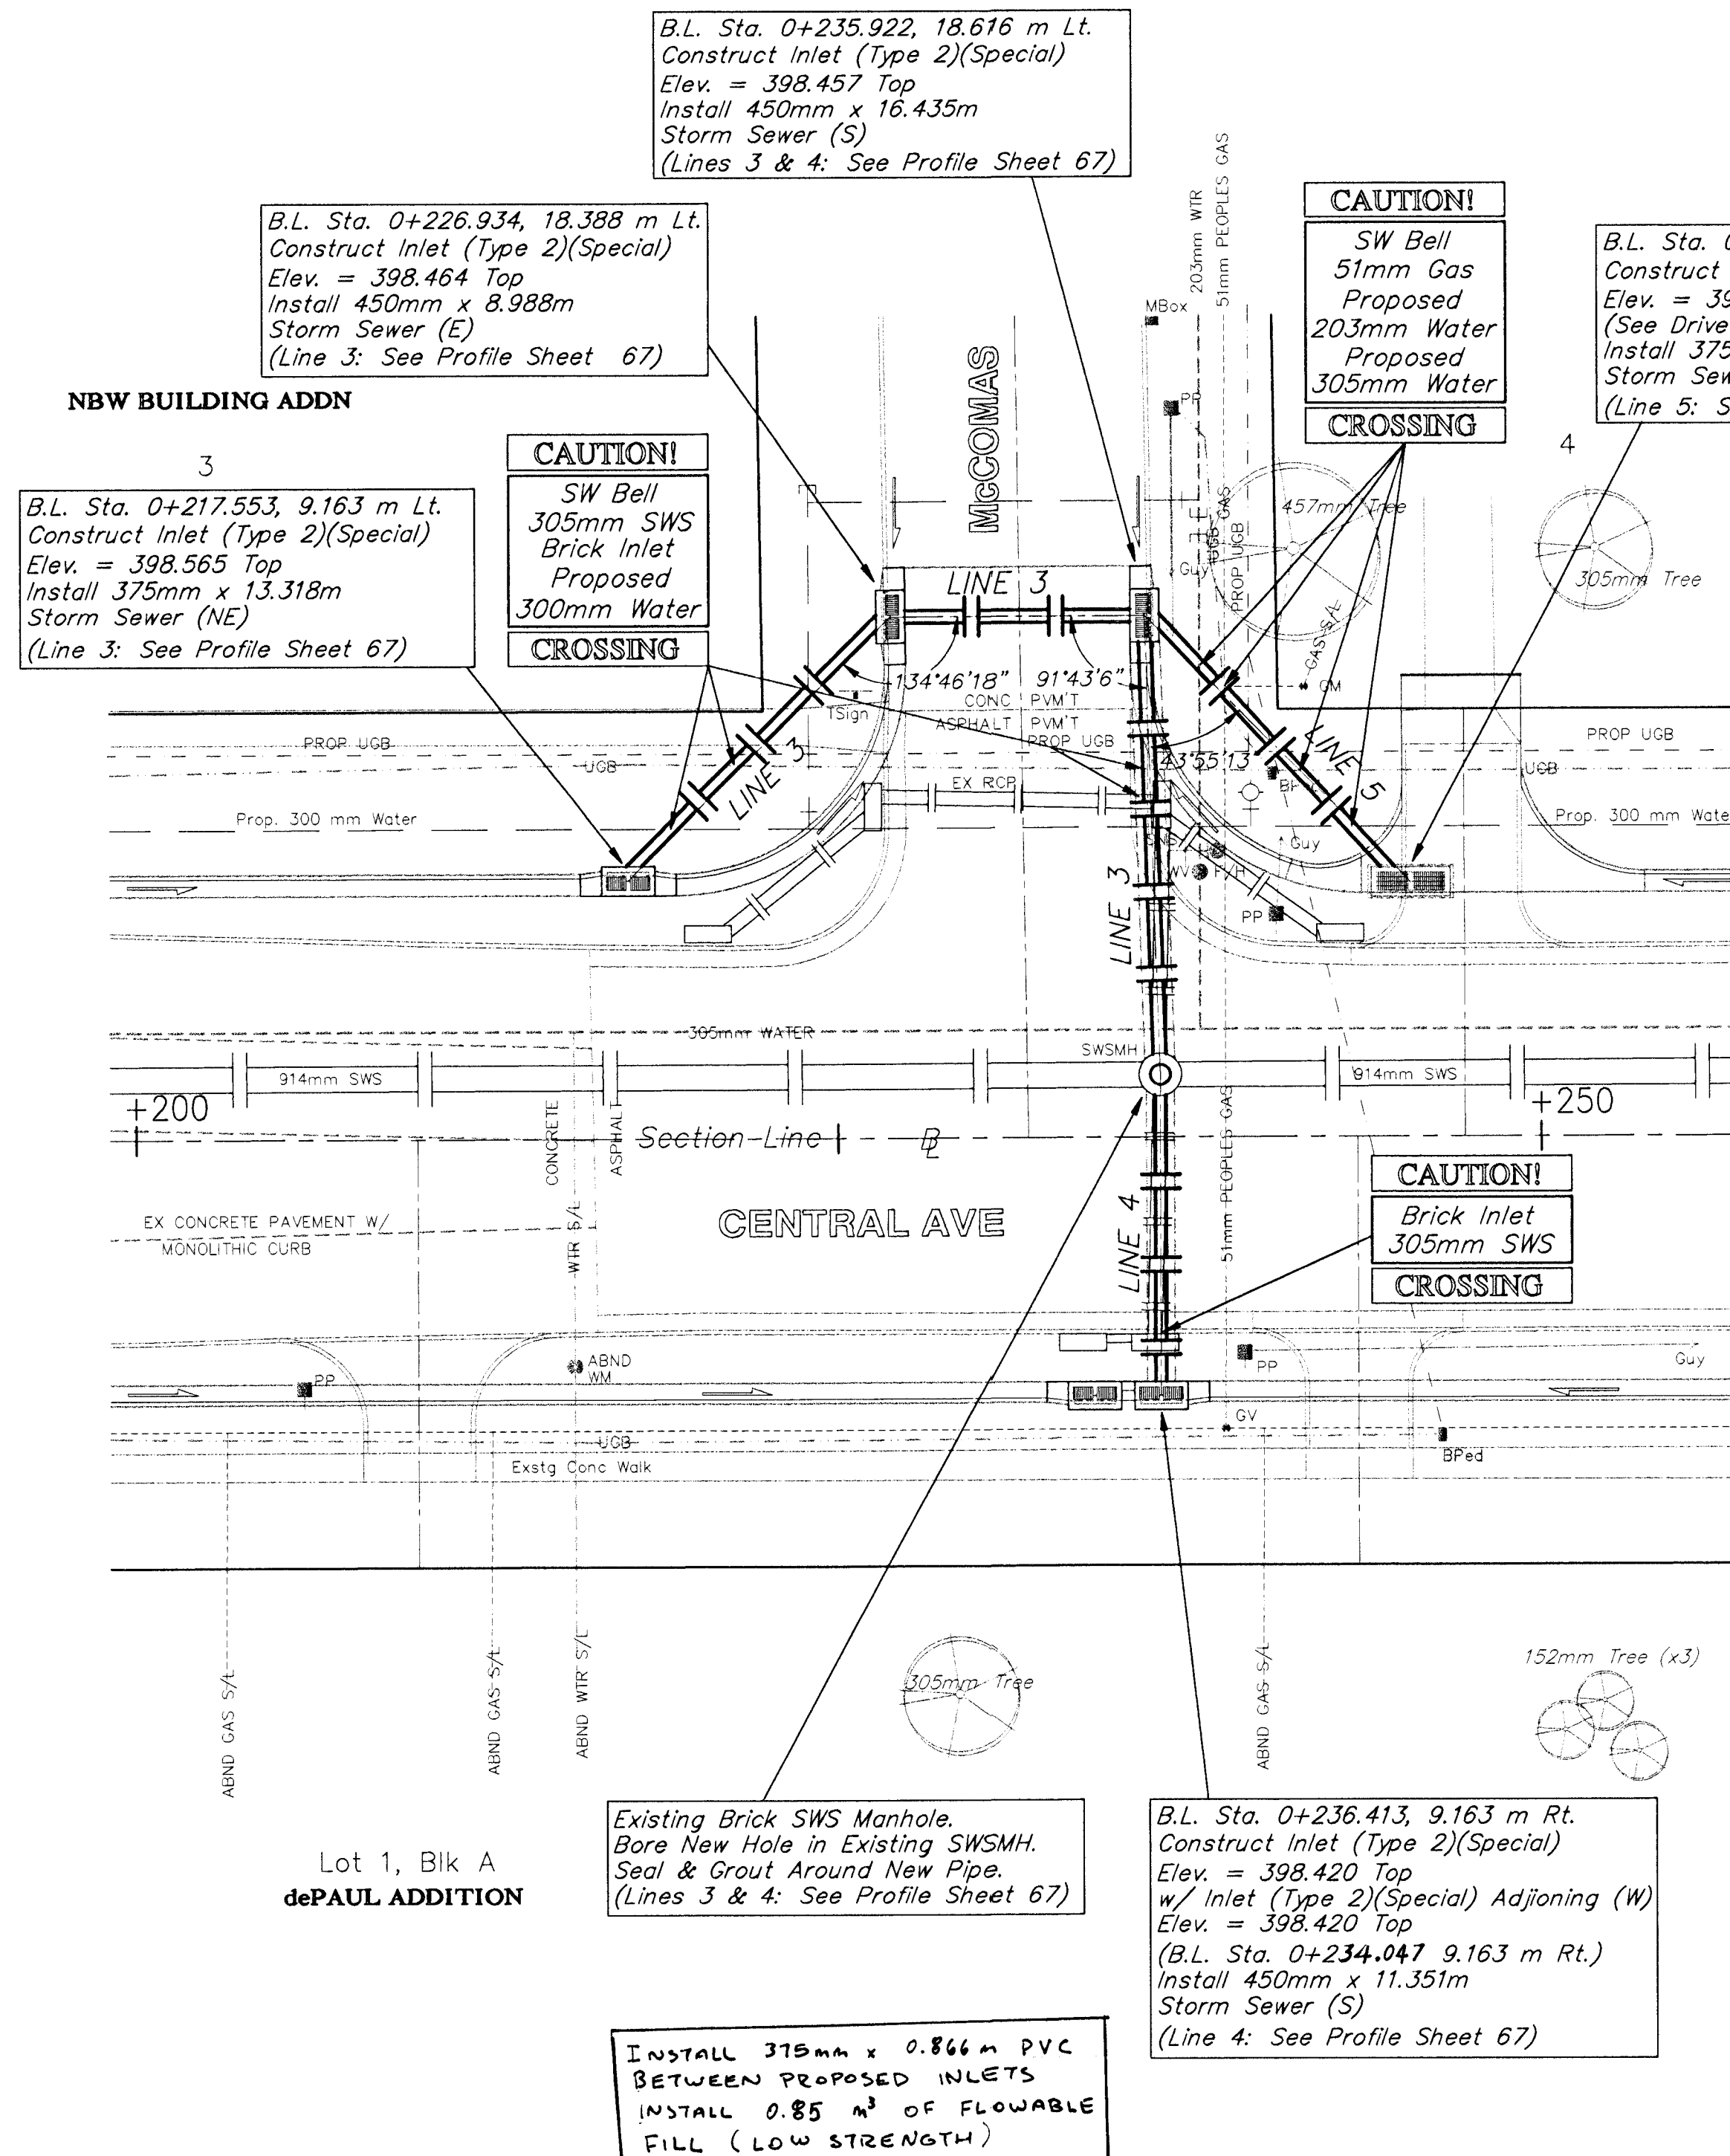

BENCHMARKS

BM #5 - City Disc Located @ 9.14m South
and 12.8m East of the Centerline
of both Sheridan and Central.
Elev. = 399.012 SI Units
(1309.08 MSL Datum)

5 0 10 25
Scale: 1:200
• = Iron

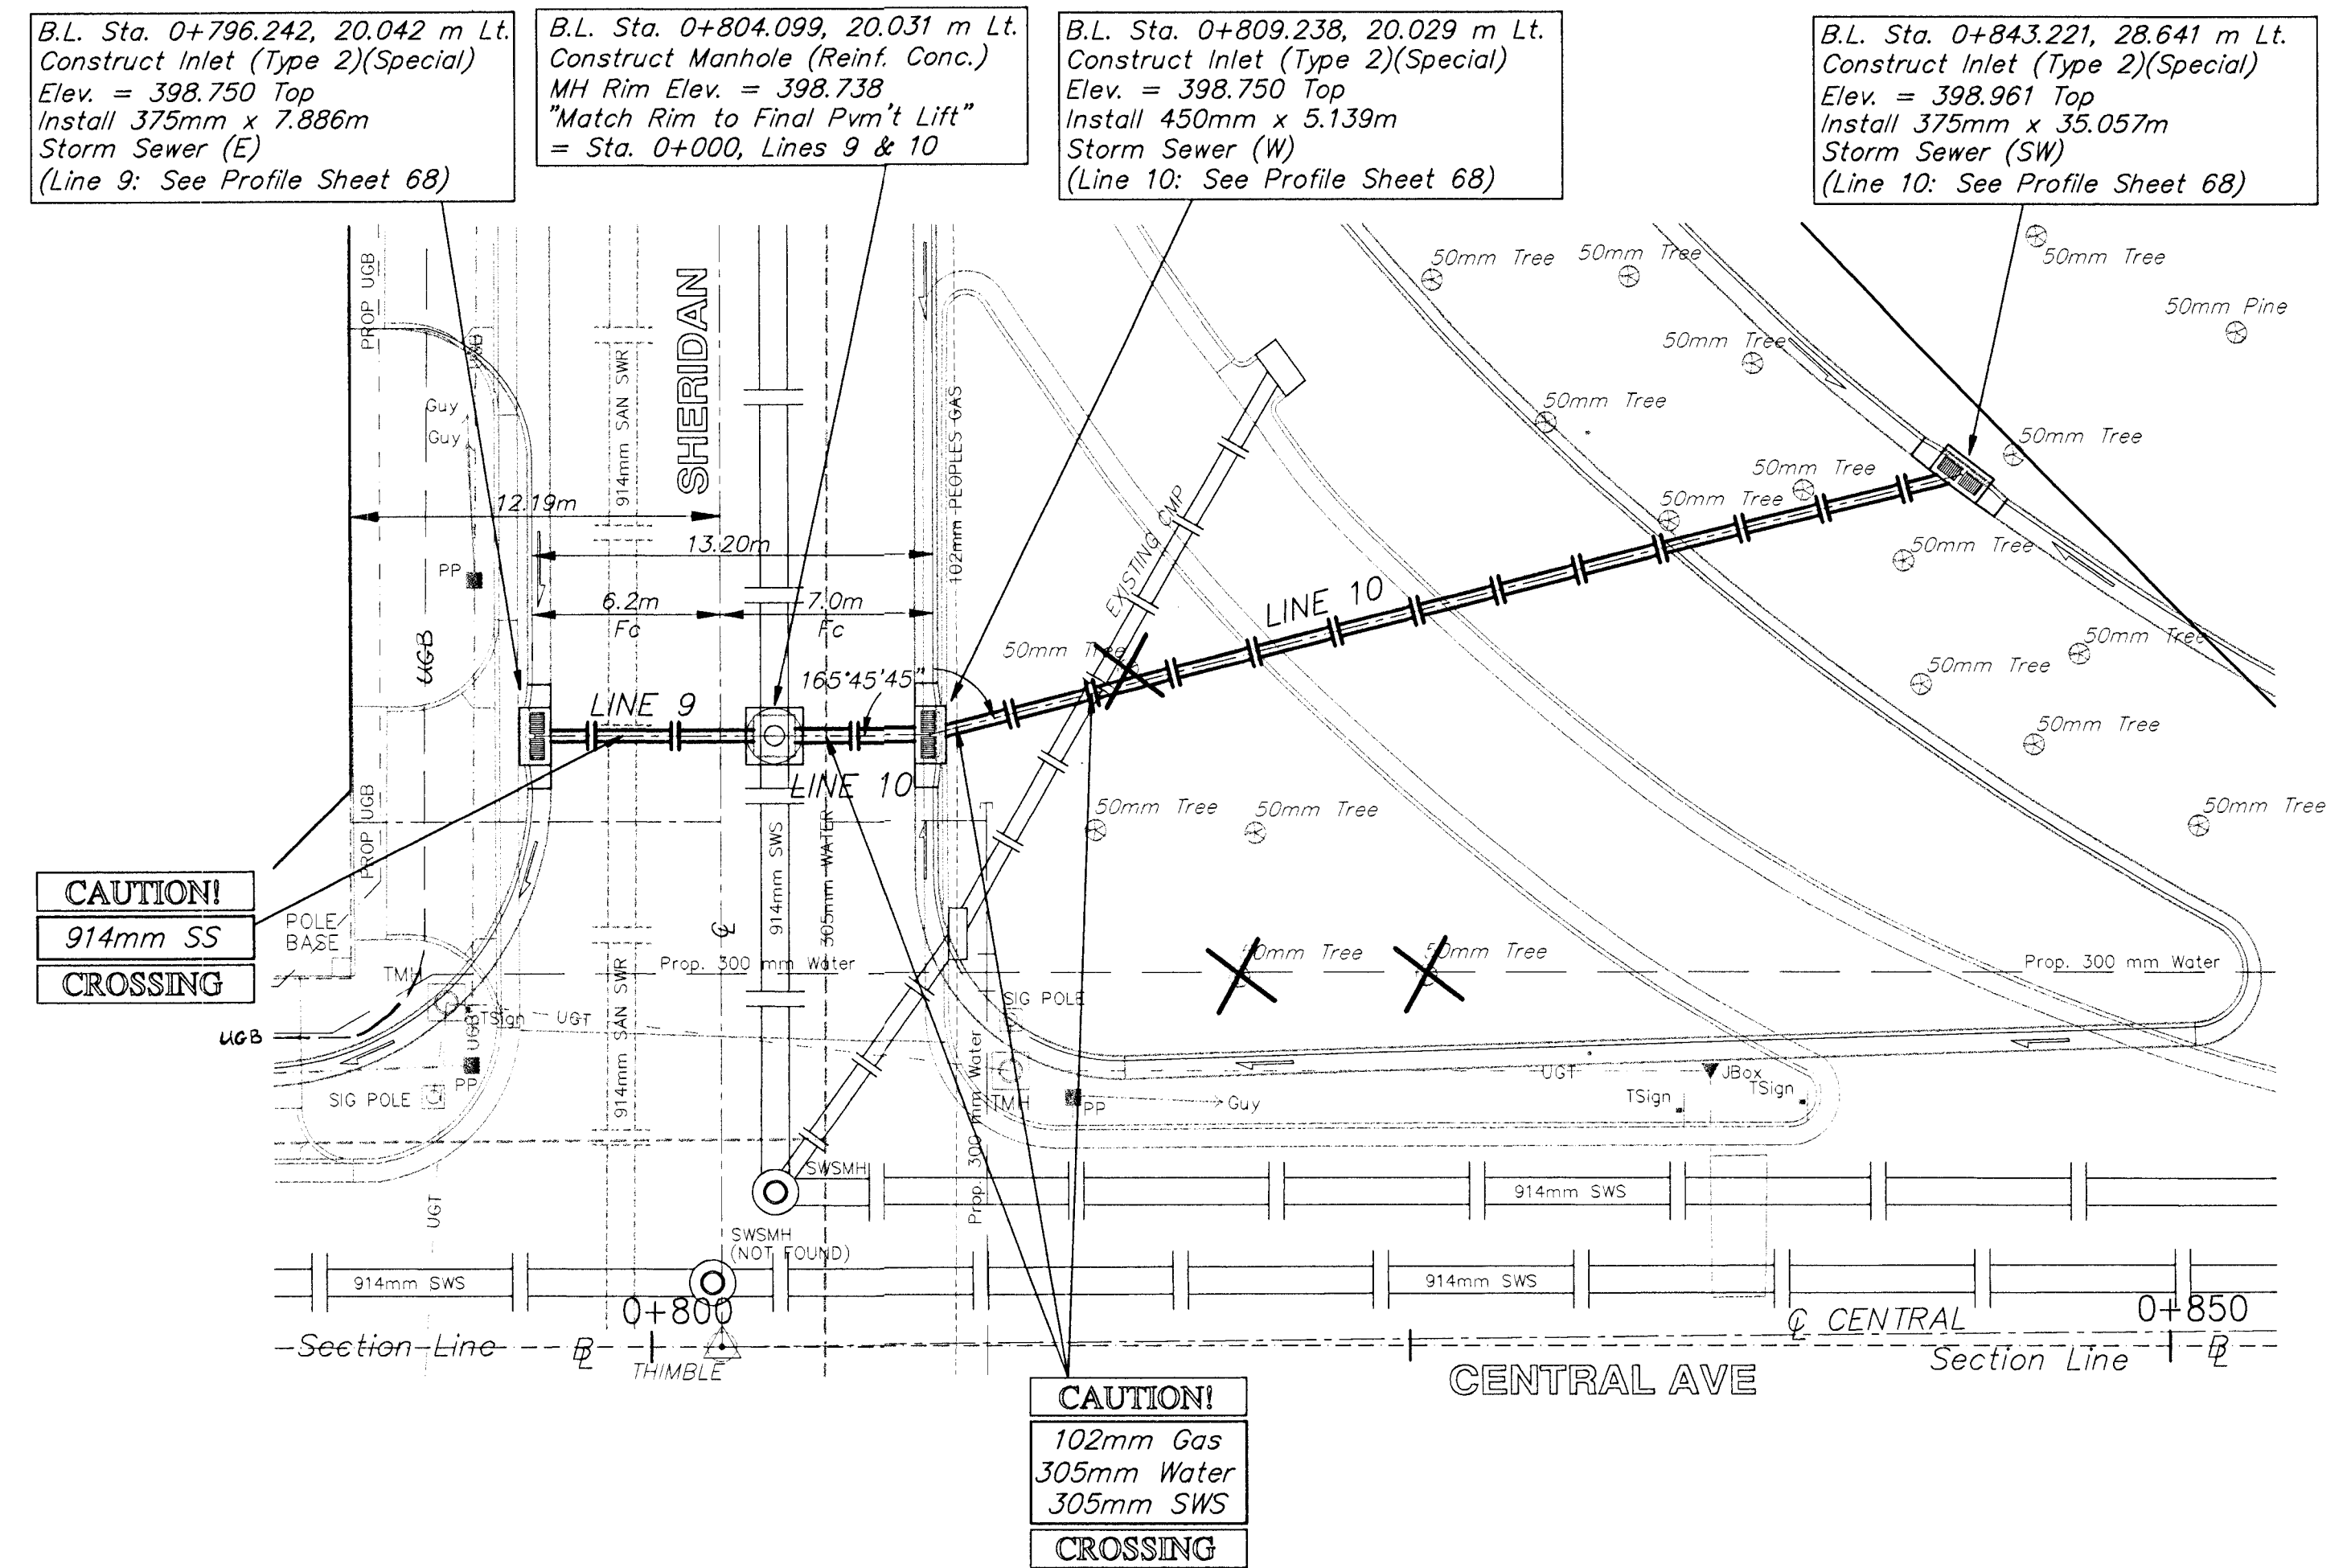

PROJECT NUMBER				
472 - 82906				
DESIGN	DRAWN	APPROVED	DATE	SCALE
STAFF	STAFF	JFB	NOV 98	NOTED

PROJECT NUMBER	
95-05-E028	
SHEET NAME	
CENTZOO	
SWS15	

McCOMAS @ CENTRAL / ZOO @ CENTRAL
STORM SEWER NOS. 3, 4, 5, 9, & 10
CENTRAL AVENUE - PHASE 1 - WEST ST TO MCLEAN

BAUGHMAN COMPANY P.A.
ENGINEERING, SURVEYING, & PLANNING
316-282-7271 • 315 ELLIS • WICHITA, KANSAS 67211

SHEET
65
OF
202