
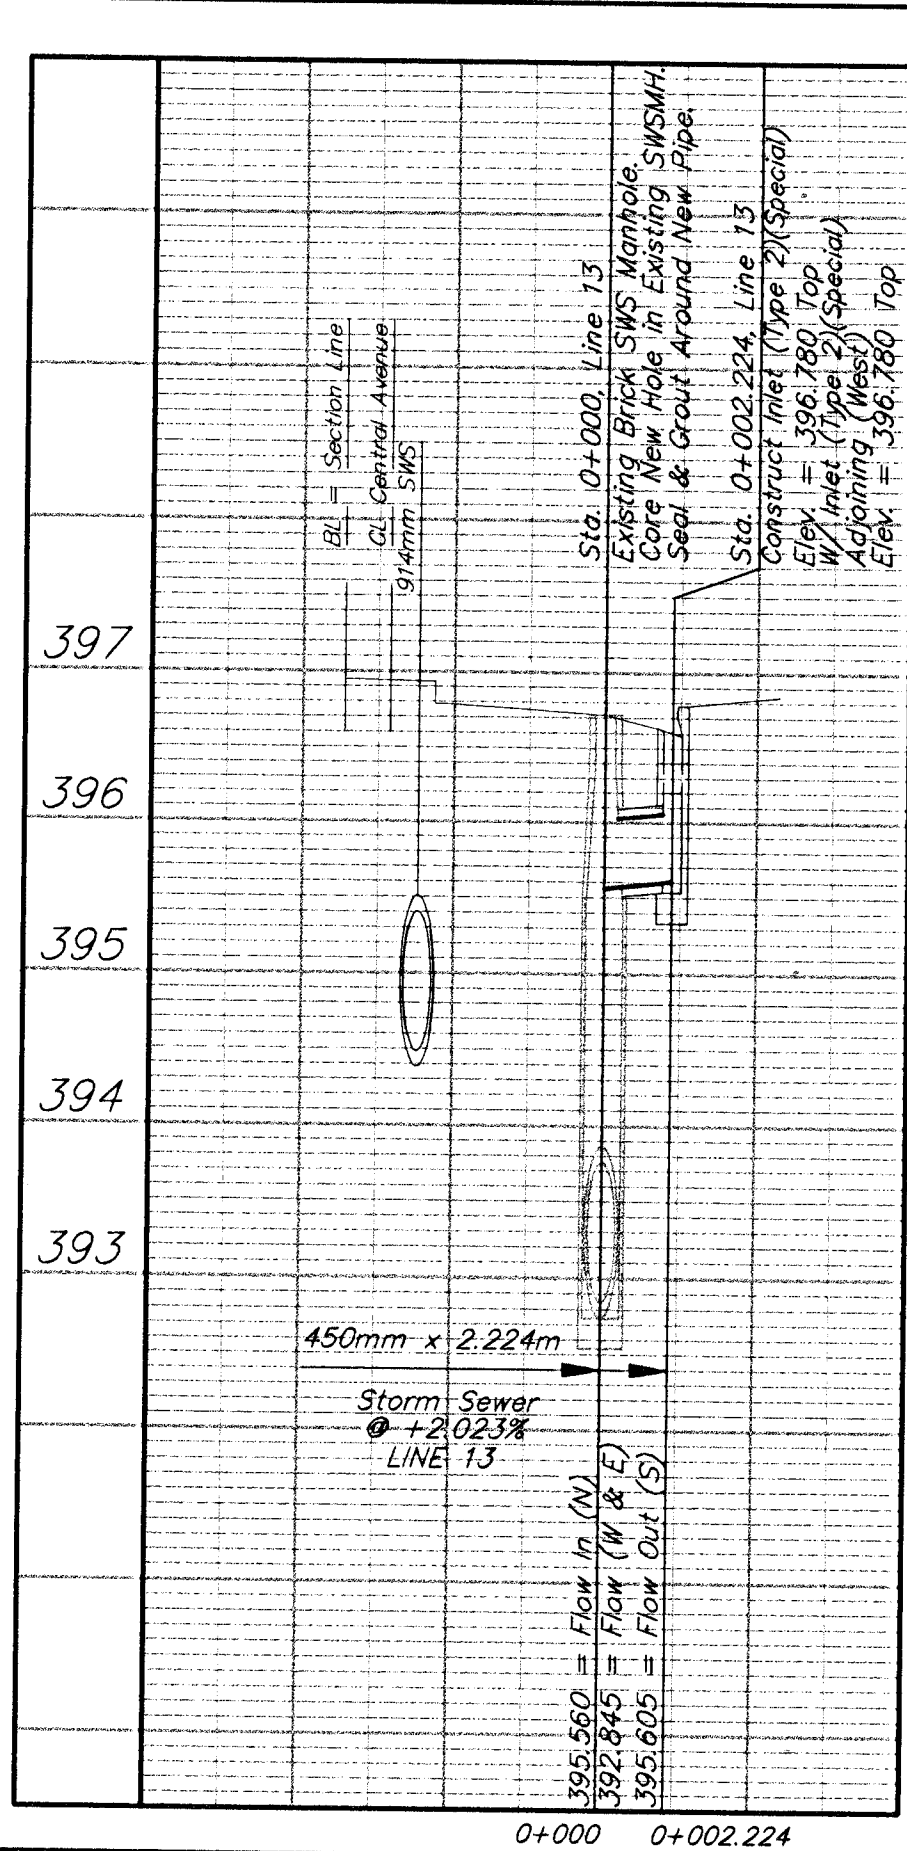
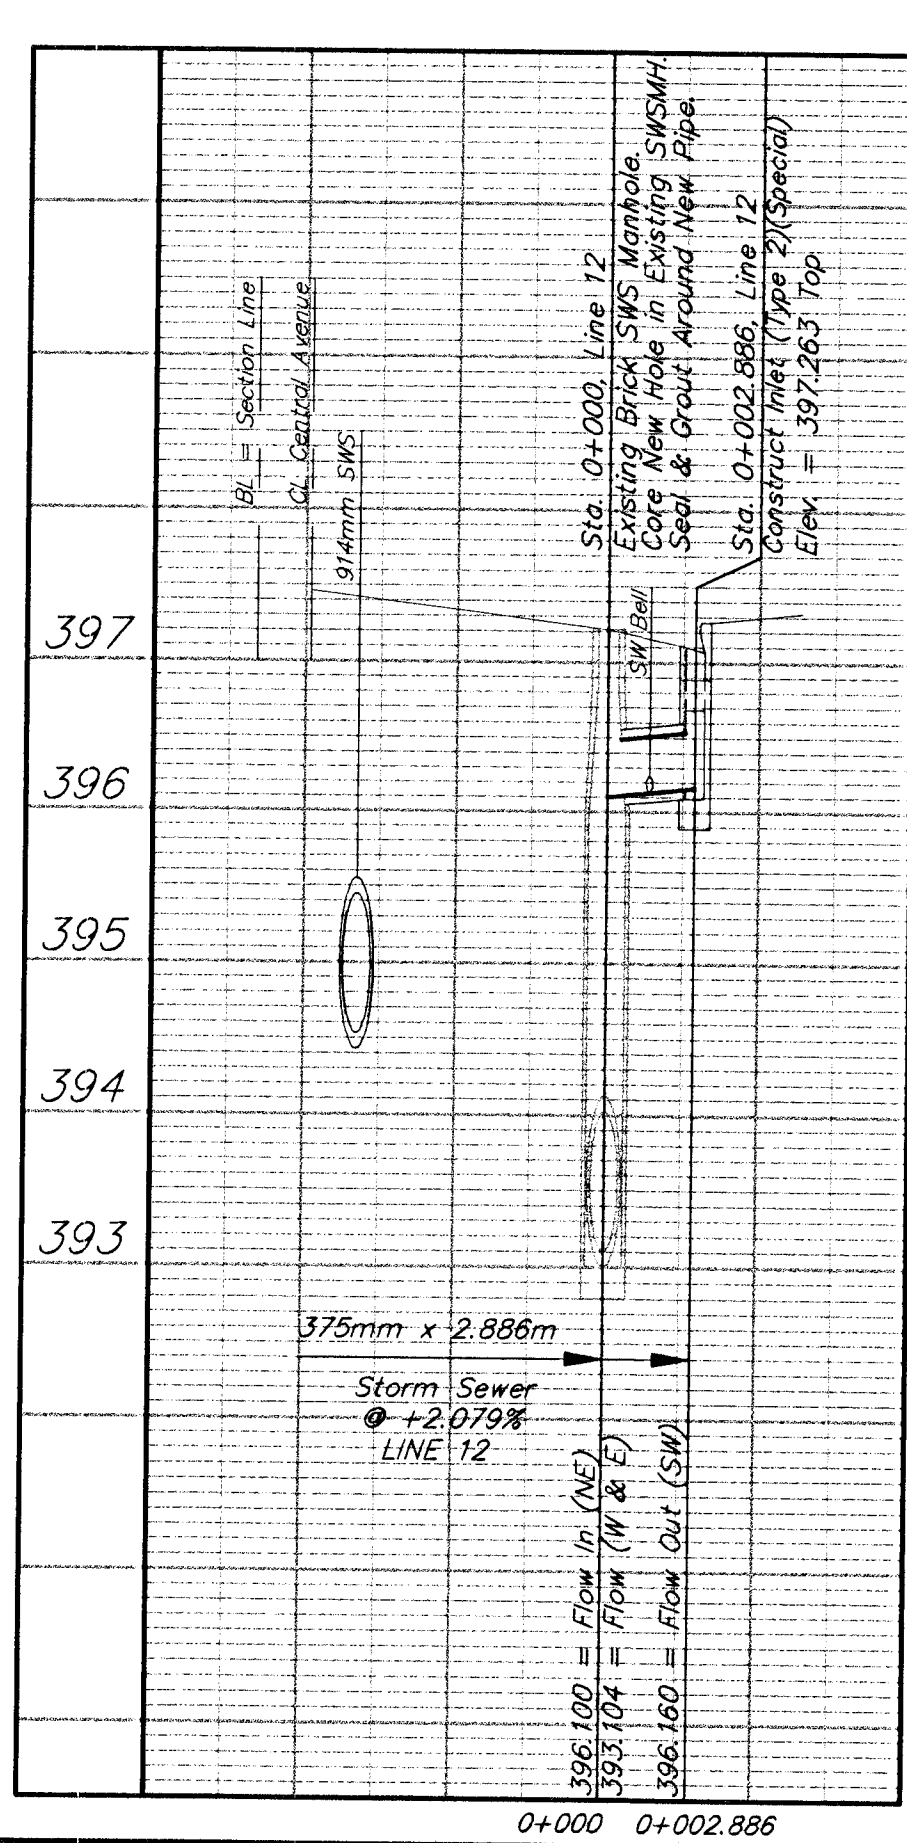
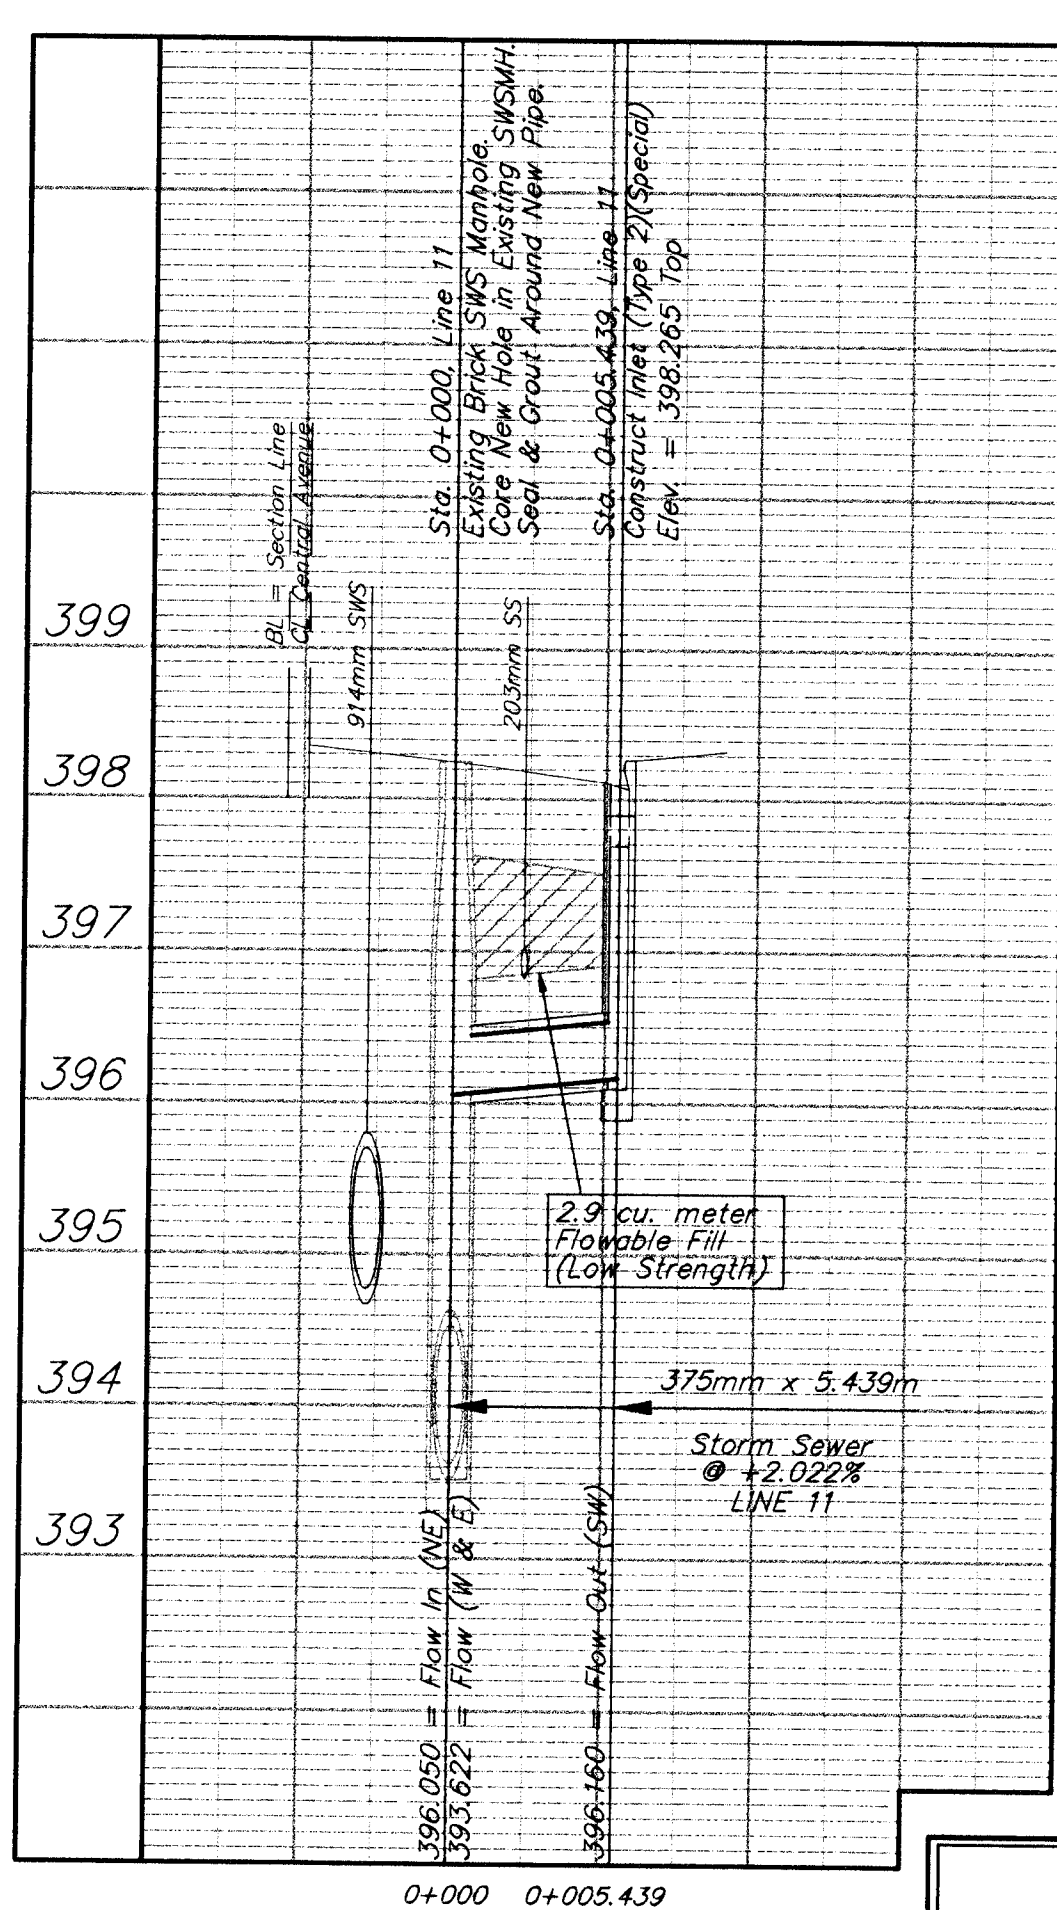
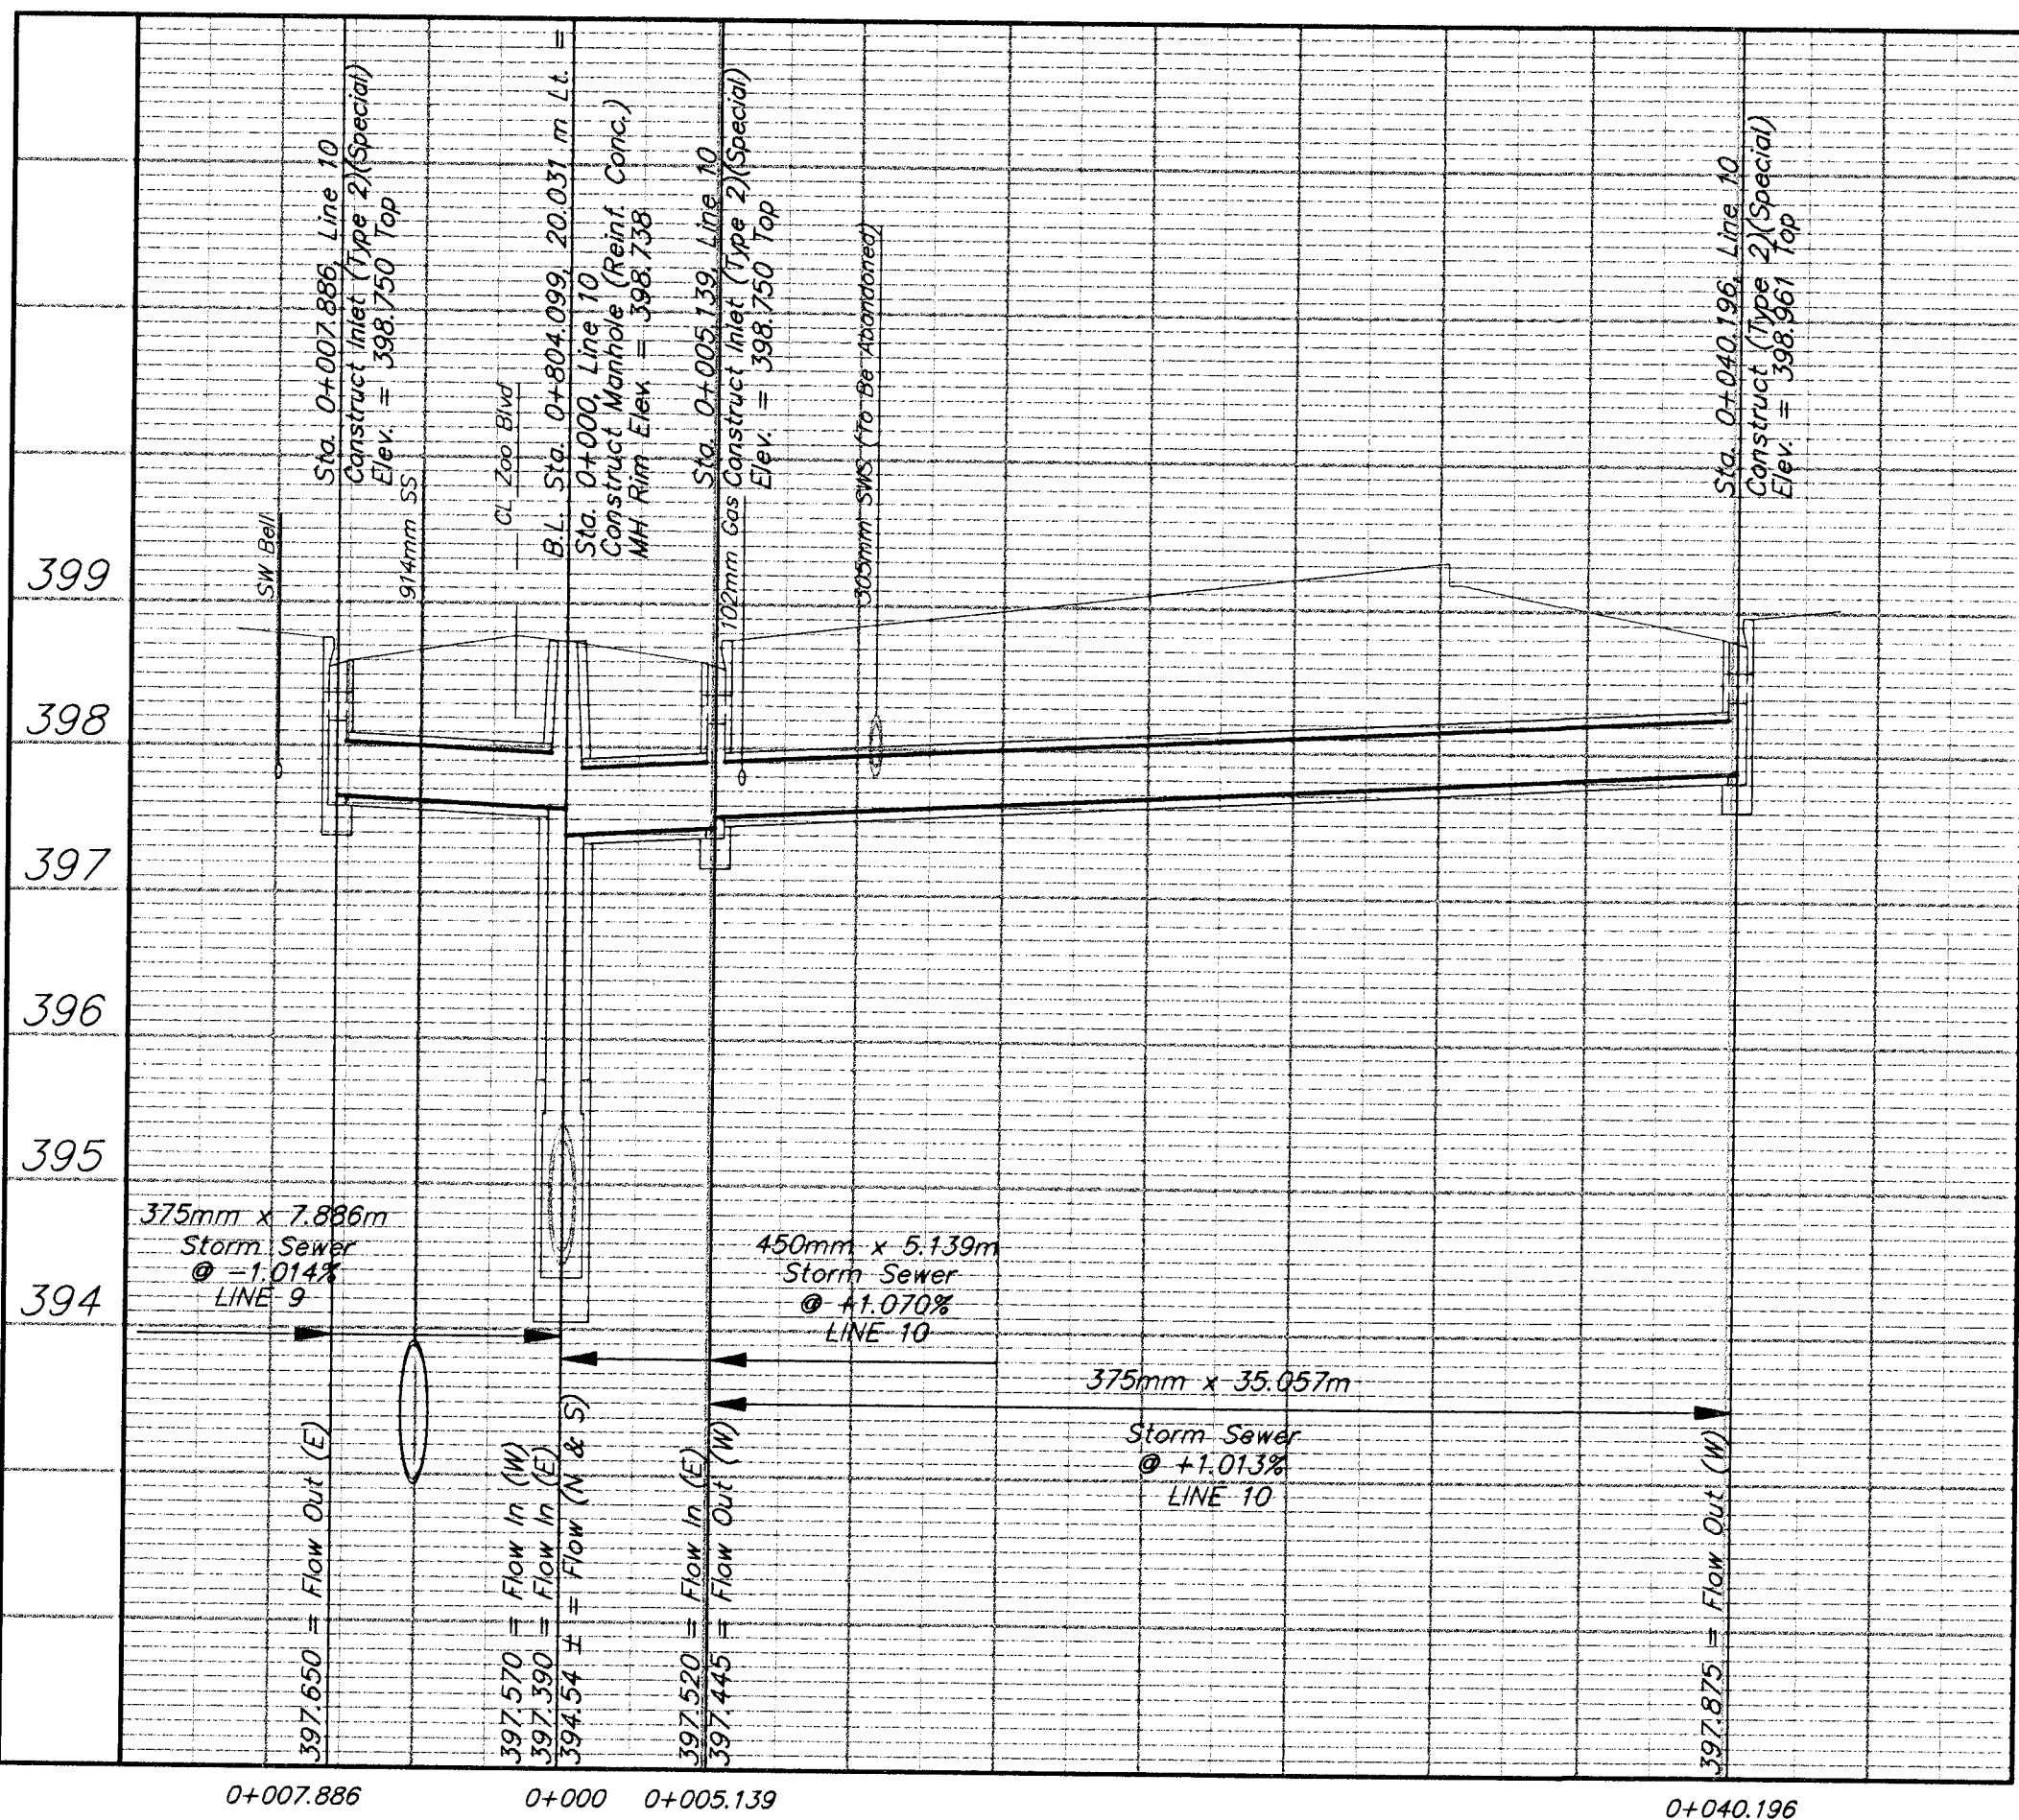
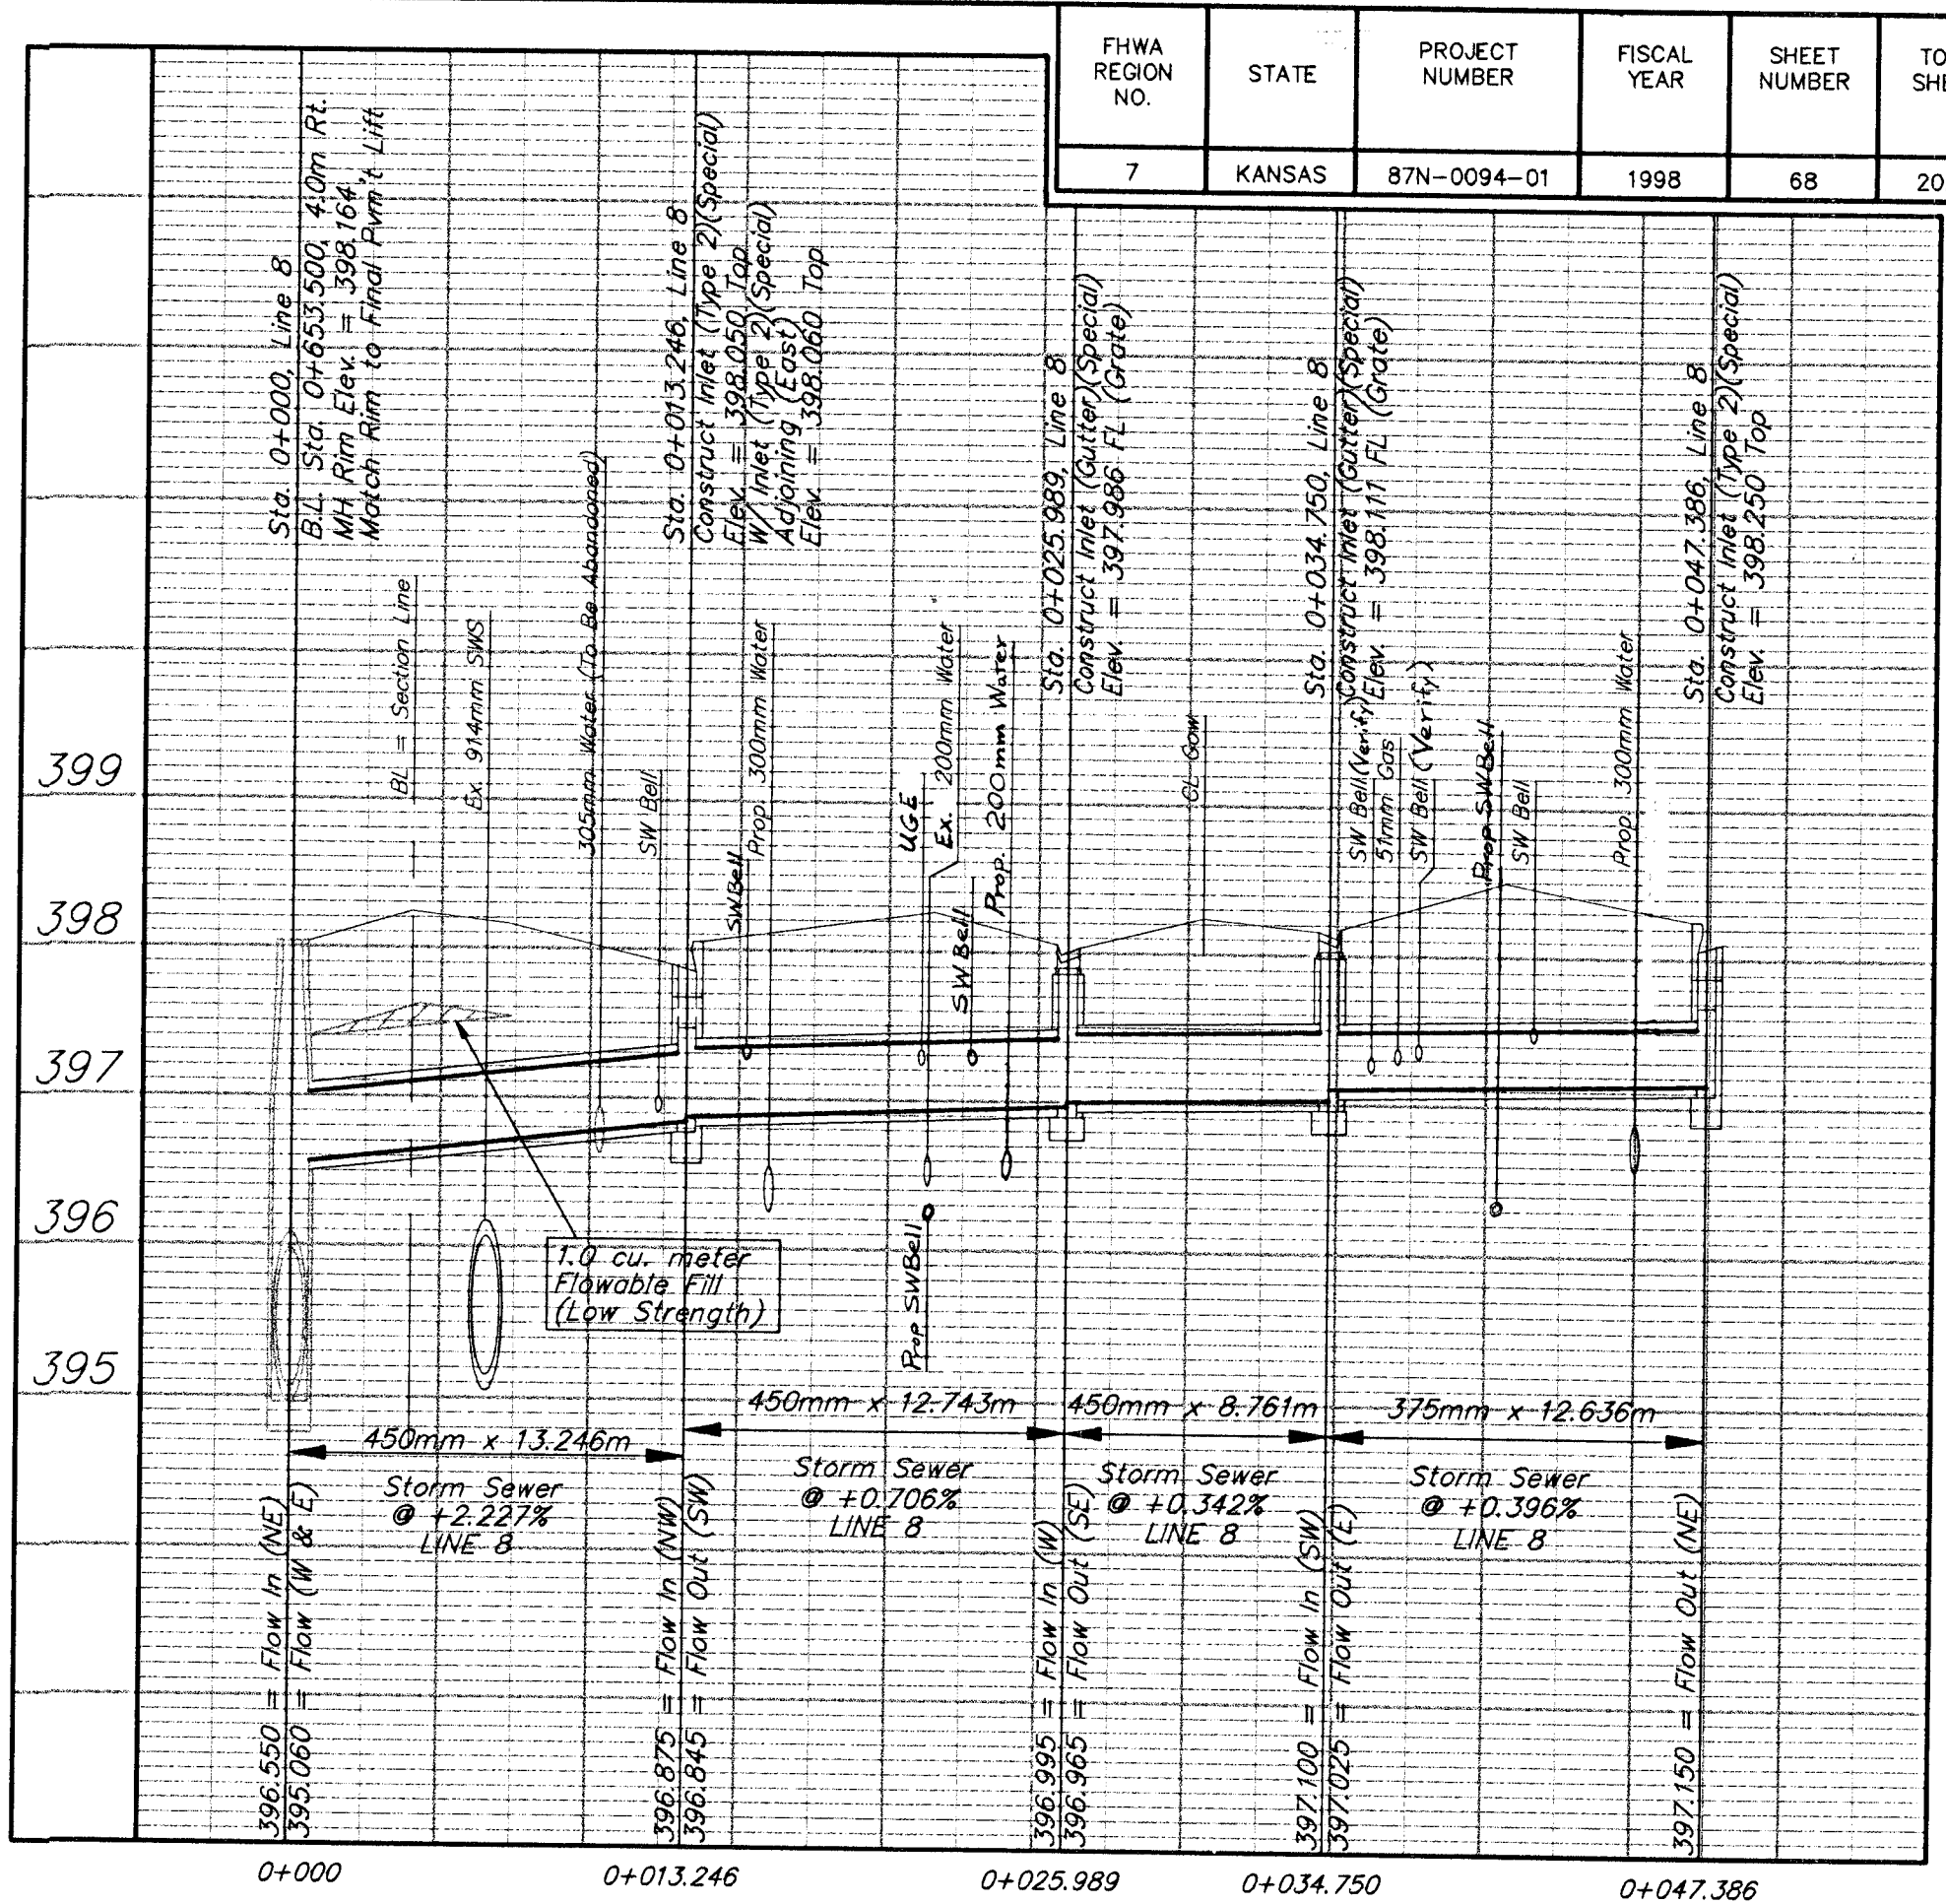
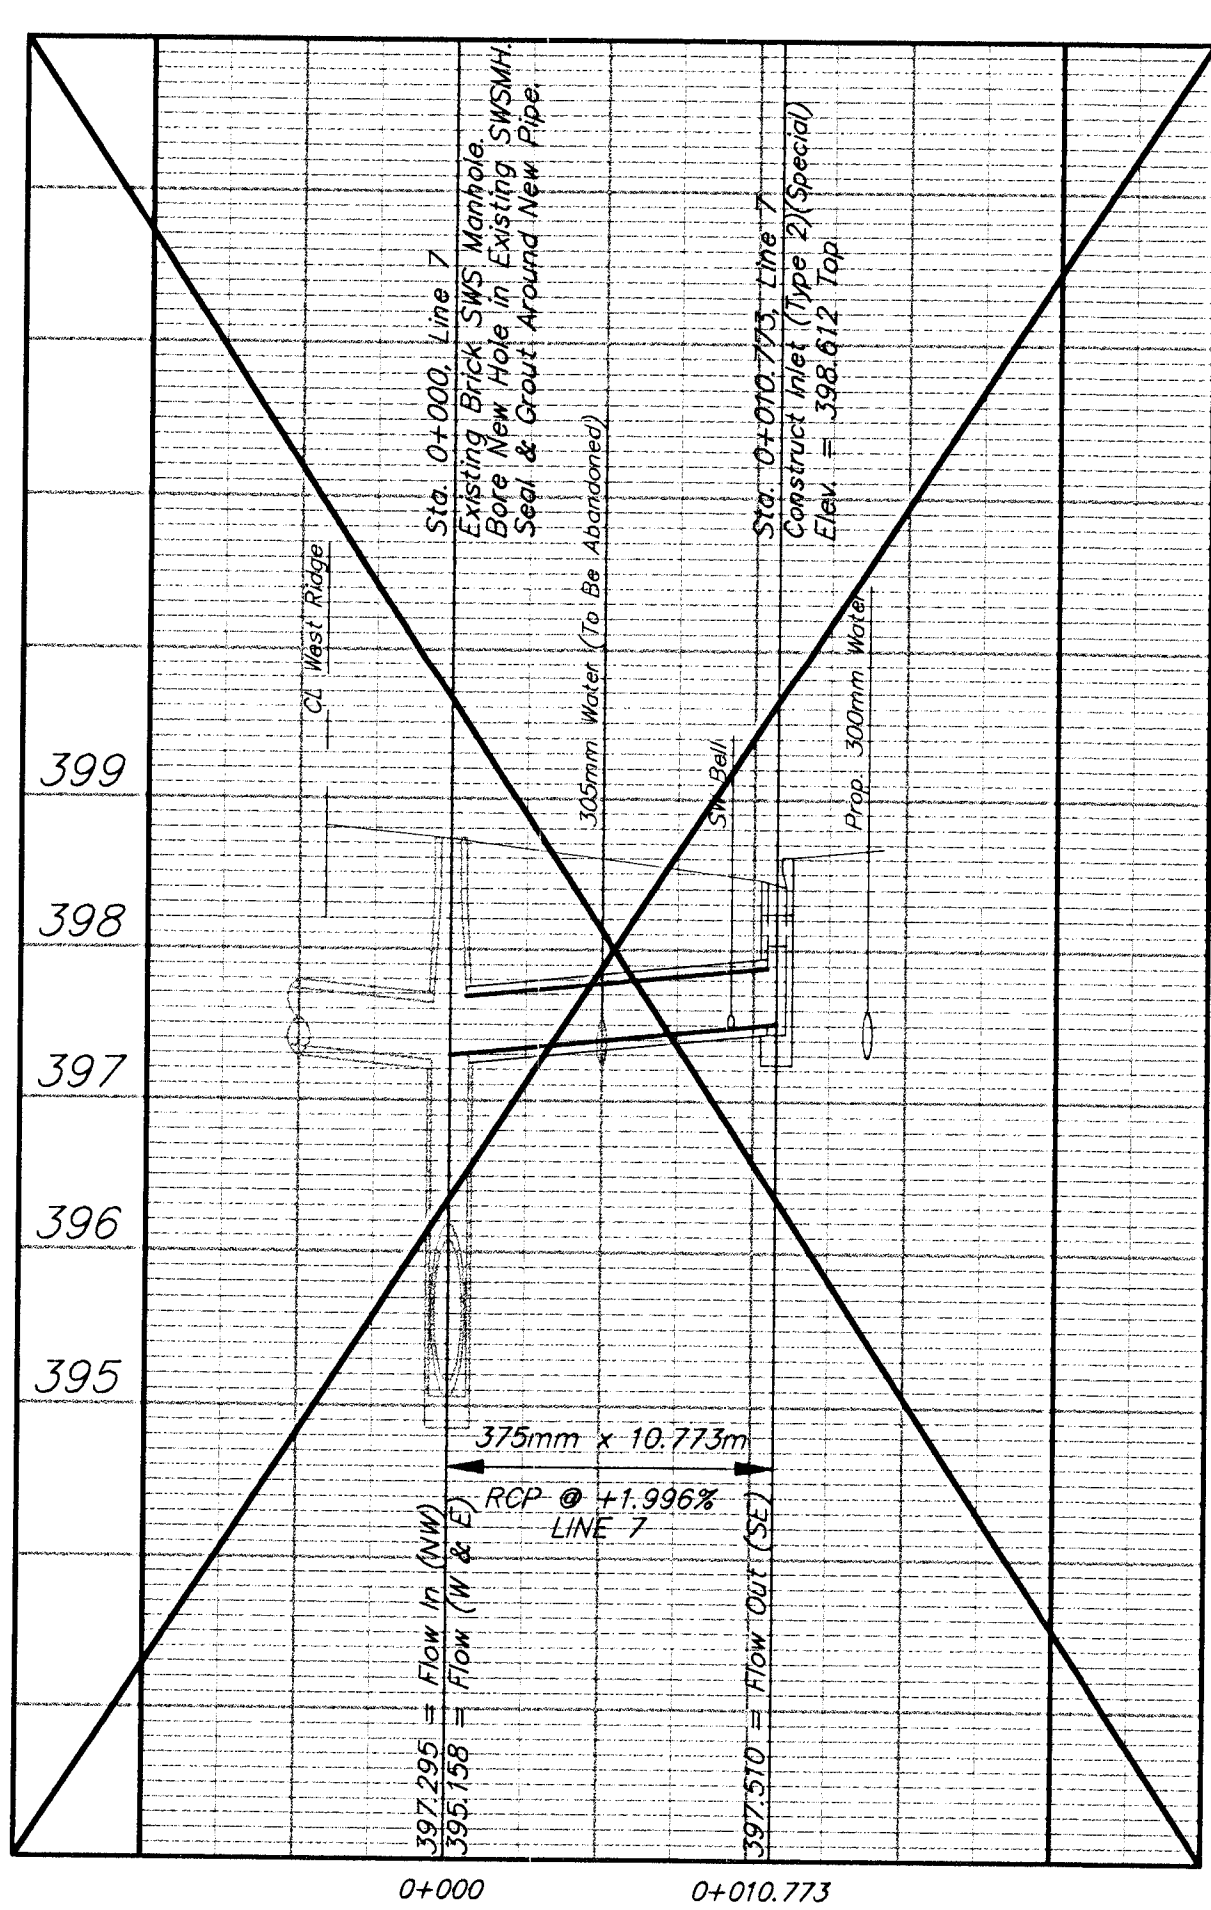
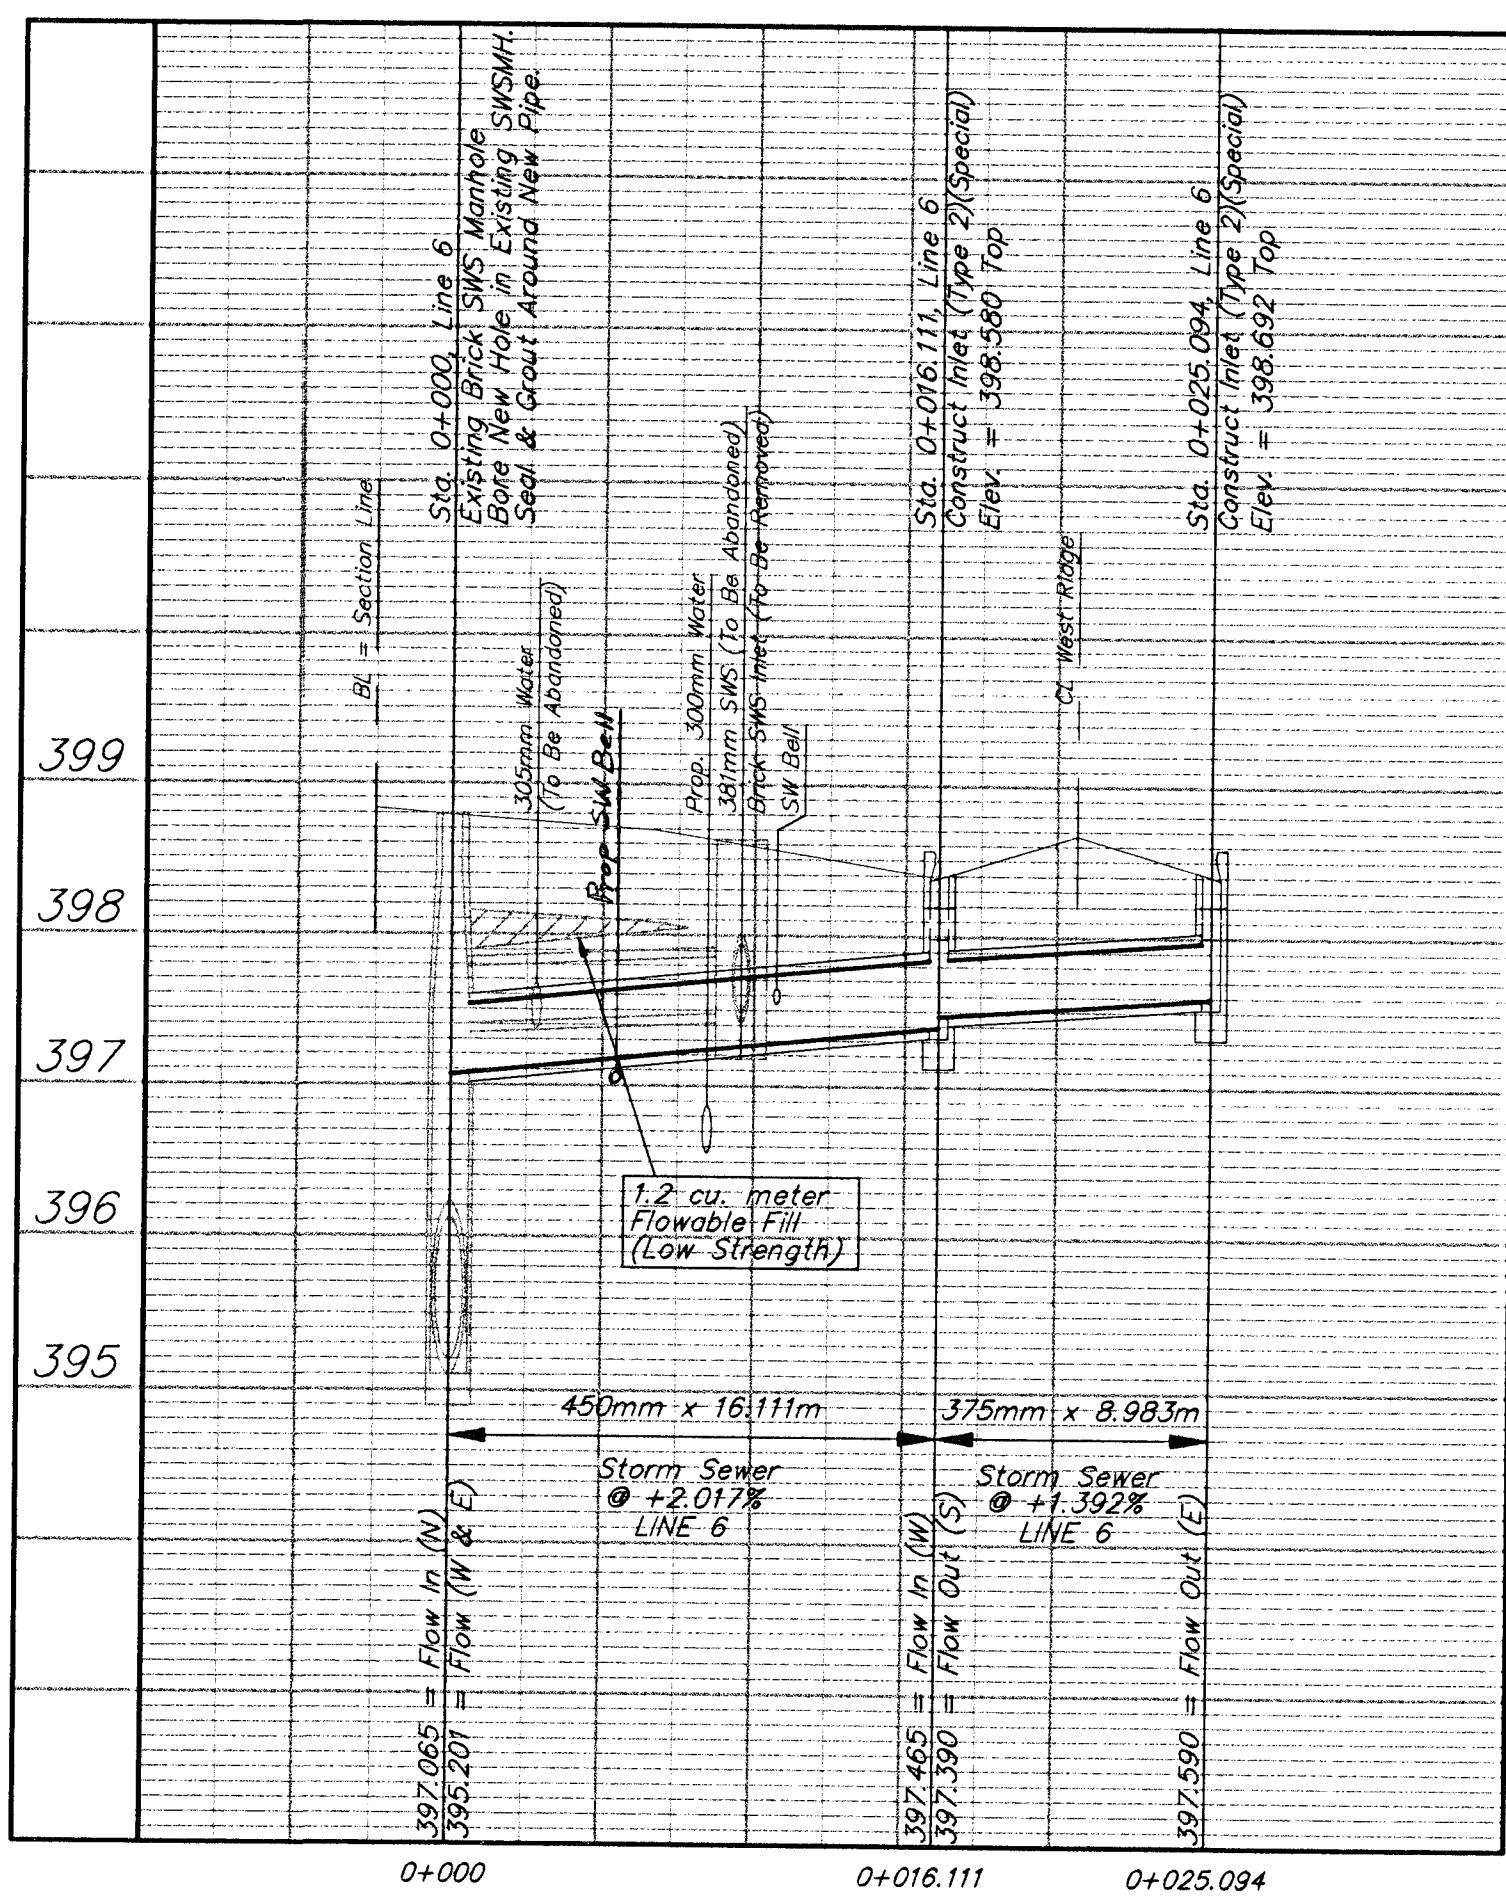


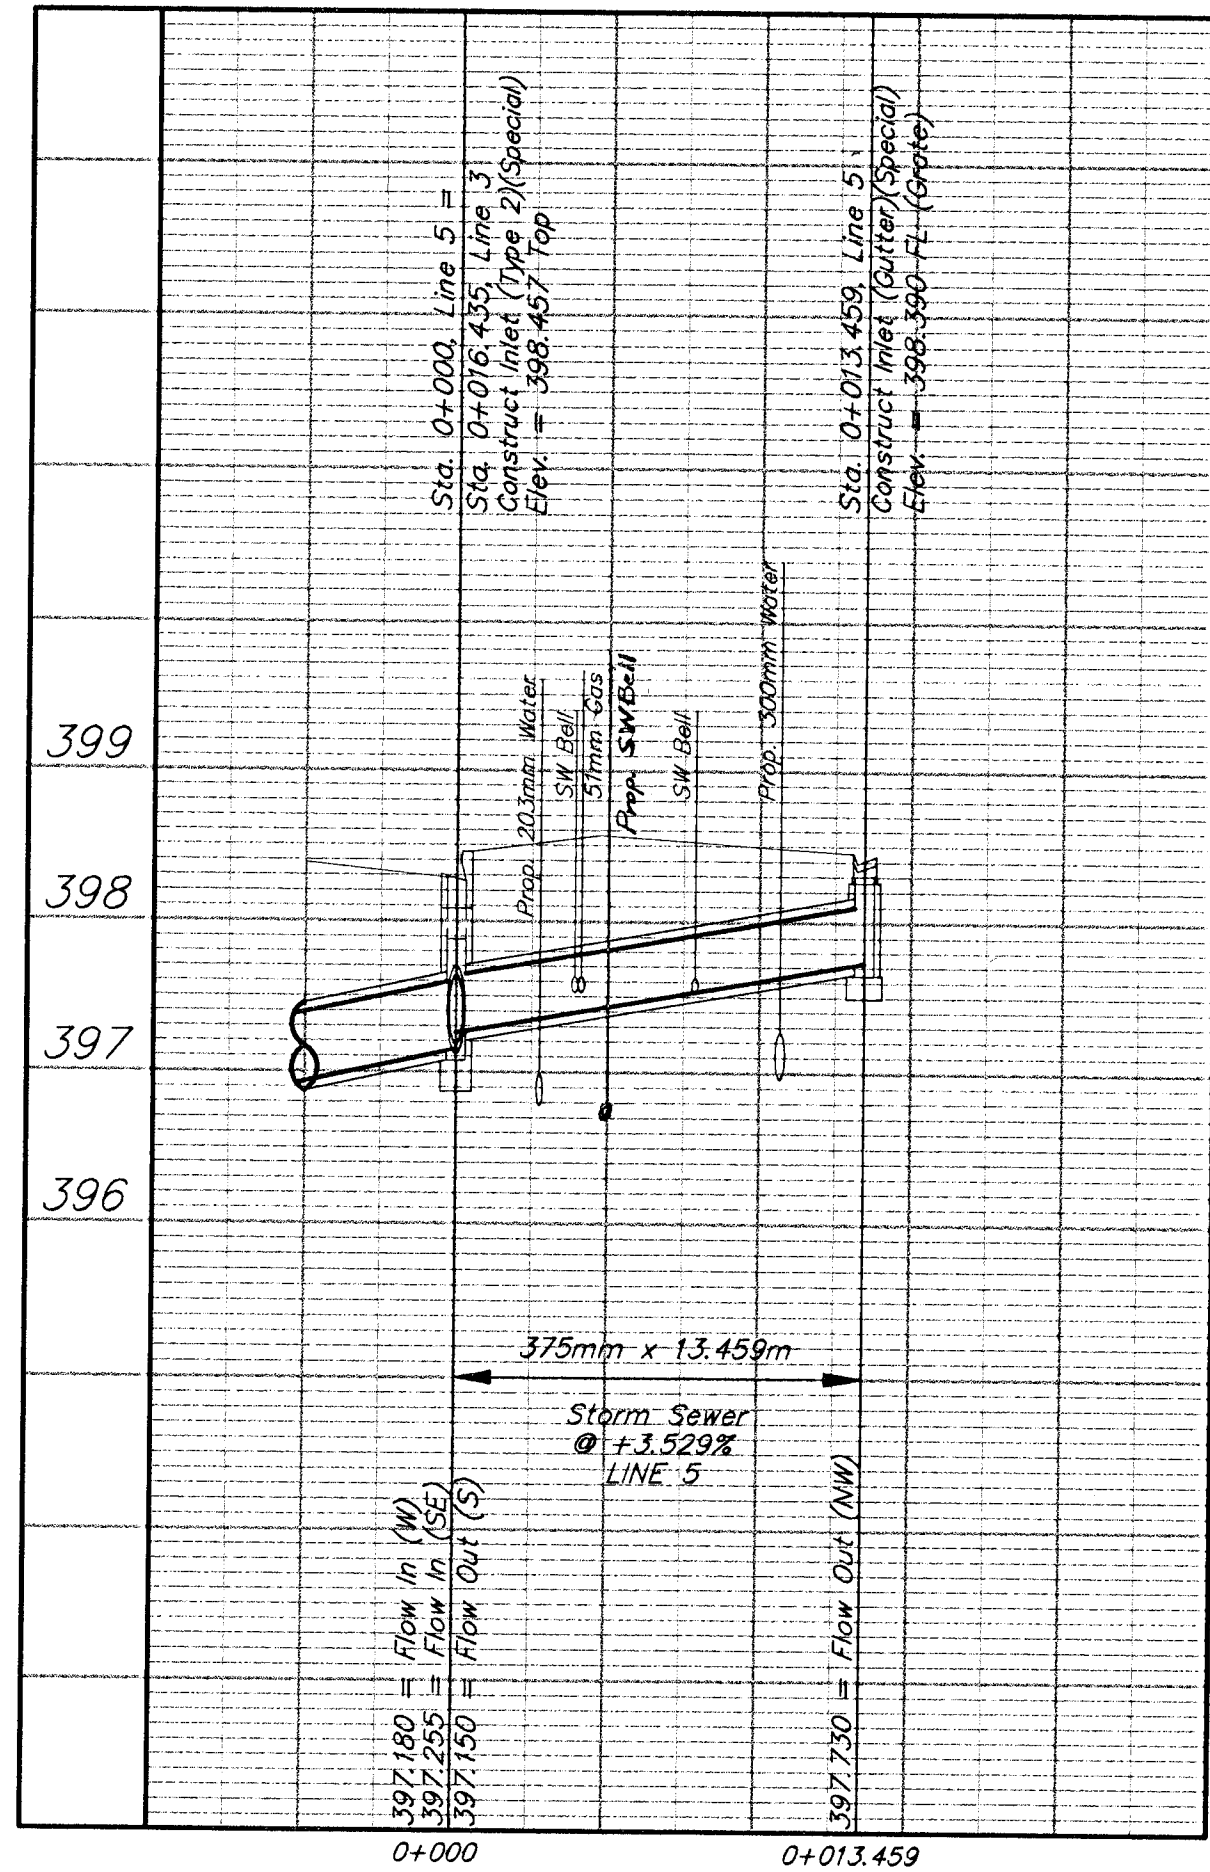

Scale:
1:250 (Horiz.)
1:50 (Vert.)

KDOT
METRIC

PROJECT NUMBER				
472 - 82906				
DESIGN	DRAWN	APPROVED	DATE	SCALE
STAFF	STAFF	JFB	NOV 98	NOTED

PROJECT NUMBER	
95-05-E028	
SHEET NAME	
CENTZOO	
SWSPROF3	

STORM WATER IMPROVEMENTS
SWS PROFILES
CENTRAL AVENUE - PHASE 1 - WEST ST TO MCLEAN

BAUGHMAN COMPANY P.A.
ENGINEERING, SURVEYING, & PLANNING
316-282-7271 • 315 ELLIS • WICHITA, KANSAS 67211

SHEET
68
202