

RR Spike in N. Face of PP in N. R/W of Maple N. of Nineiron. Elev. = 177.01 (City Datum)

" " Cut center of north Headwall of RCBC in N. R/W of Maple 570' East of centerline of City View. Elev. = 187.91 (City Datum)

+42.5
Sta 0+06.0, Line 3
Begin construction of 36" RCP w/ end section. Install 4x12" S.Y. light stone rip-rap as indicated.

Contractor to Regrade Ditch Side Slopes and Surrounding Area to Ensure Positive Drainage From Ditch to Ex. RCBC.

CAUTION!
Ex. UG Elec. & CATV Crossings


CAUTION!
Elec. Box & CATV Ped. Near

+11.6
Sta 4+08.6, Line 3
Construct std. manhole (7' Dia.) Top Elev. = 164.40' Match Point

Scale: 1" = 20' Horizontal
1" = 5' Vertical
• = Iron

RIVERSIDE HEALTH
SYSTEM ADDITION

23
SHADOW WOODS
ADDITION

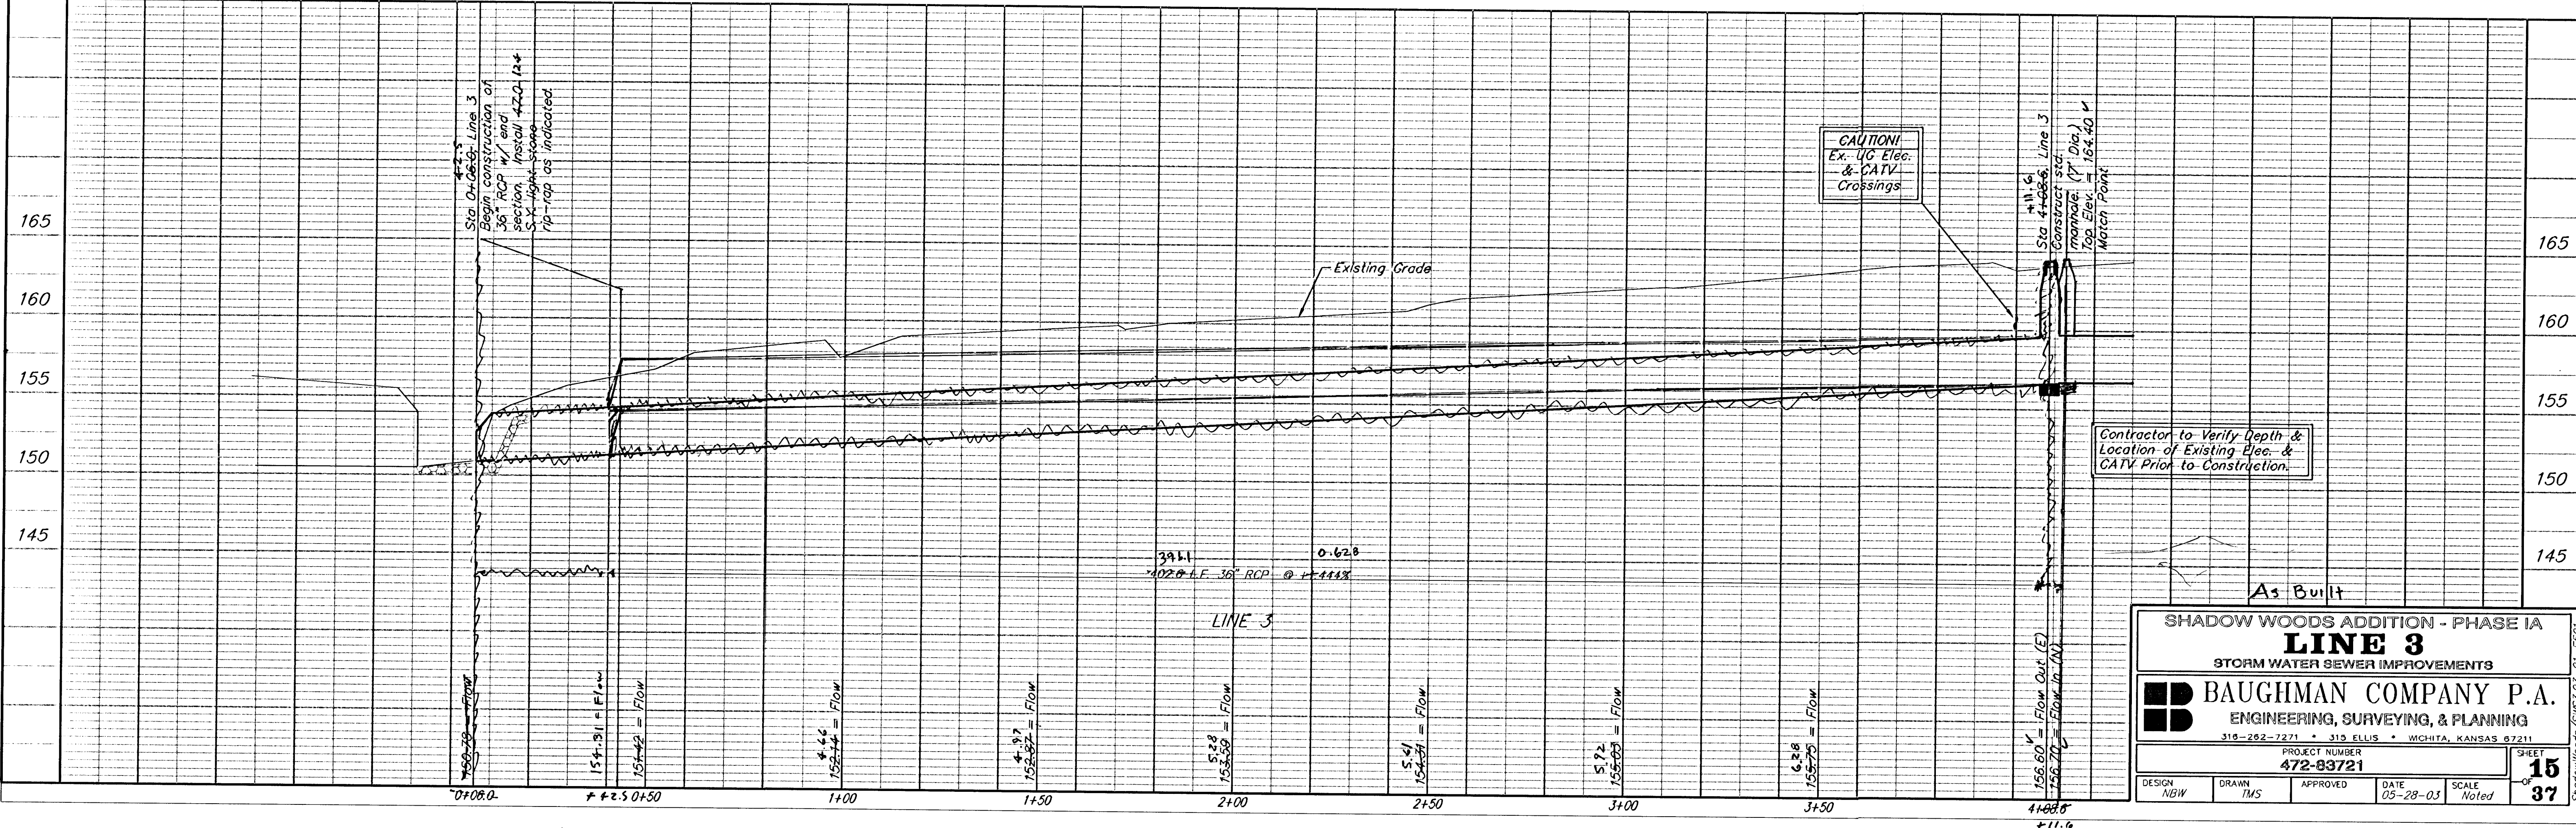

LINE 3
STORM WATER SEWER IMPROVEMENTS

BAUGHMAN COMPANY P.A.
ENGINEERING, SURVEYING, & PLANNING
310-262-7271 • 310 ELLIS • WICHITA, KANSAS 67211

PROJECT NUMBER

DESIGN: NBW DRAWN: TMS APPROVED: DATE: 05-28-03 SCALE: Noted

SHEET
15
OF
37