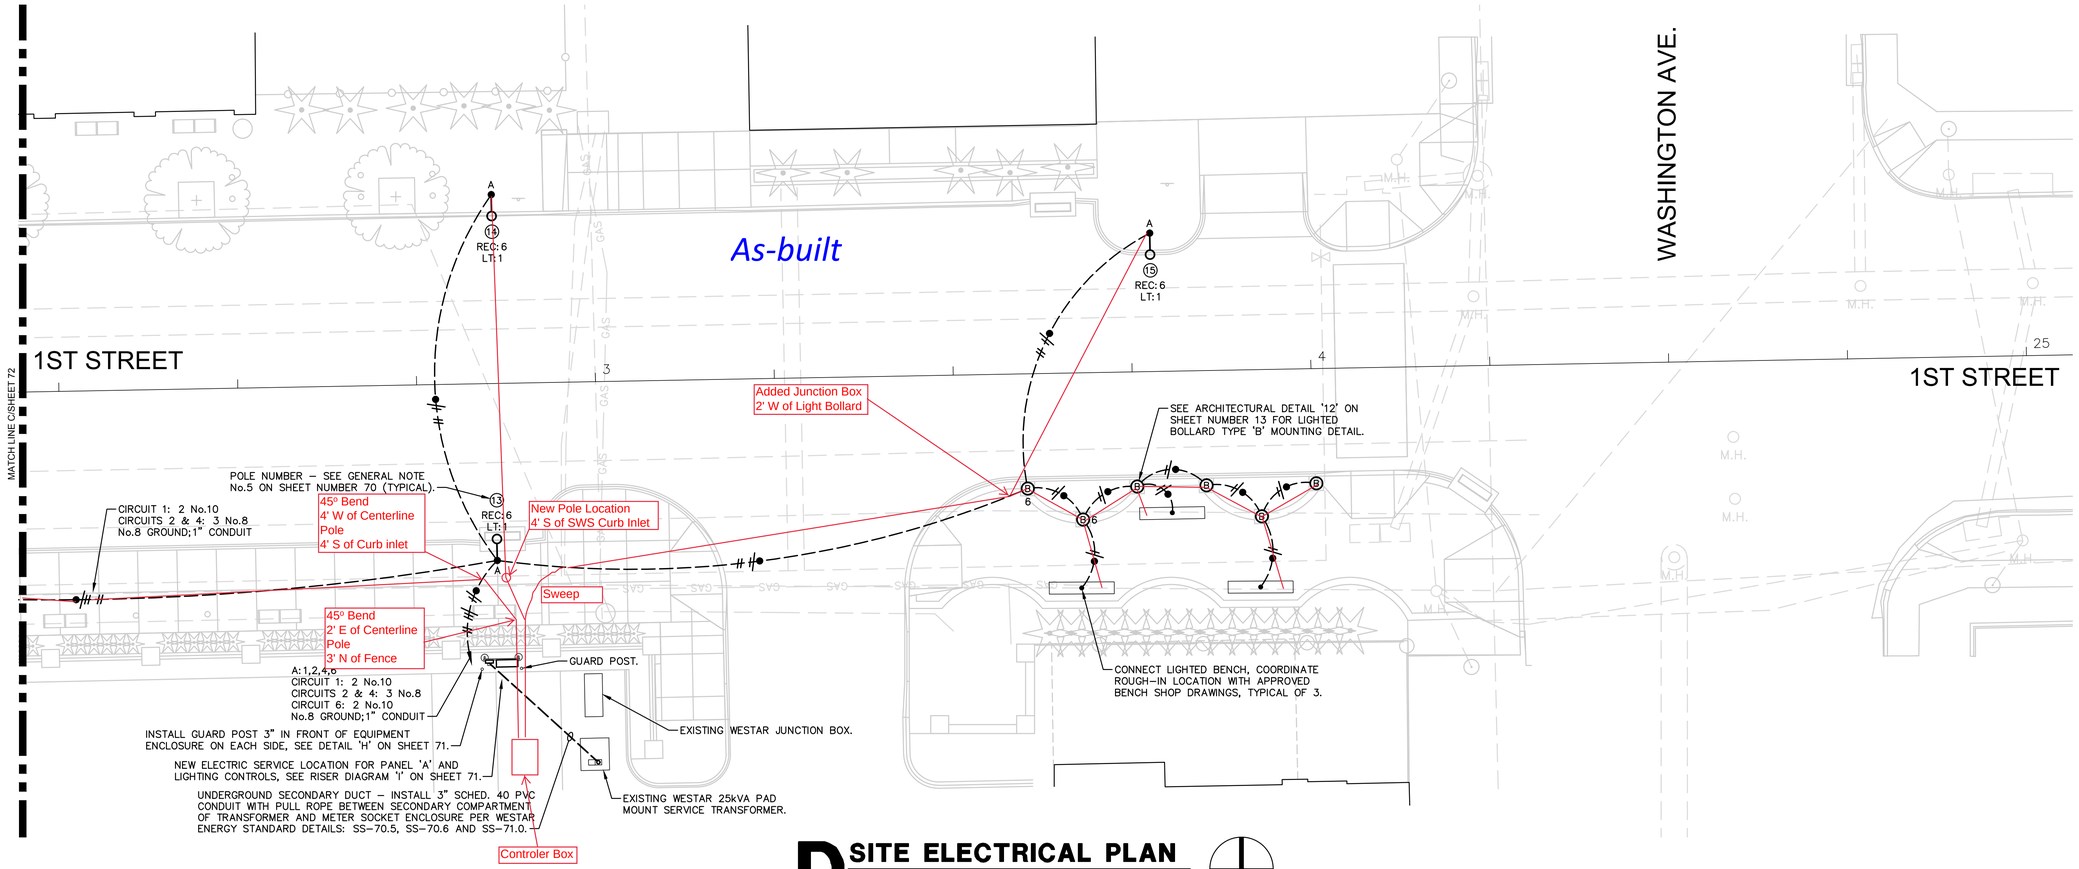

D SITE ELECTRICAL PLAN

1"=10'-0"

TranSystems
245 NORTH WACO
SUITE 222
WICHITA, KANSAS 67202
PHONE: 316-303-3000
FAX: 316-303-0156

CONSULTANTS:
LK ARCHITECTURE
SUITE 200
345 NORTH RIVERVIEW ST.
WICHITA, KANSAS 67203
PHONE: 316-268-0230

1ST STREET IMPROVEMENTS
SANTE FE TO WASHINGTON IN OLD TOWN

WICHITA, KANSAS

CITY OF WICHITA

REVISIONS:		
MARK	DATE	DESCRIPTION

PROJ NO: 472-85285
SCALE: 1" = 10'-0"
DATE: 7/5/17
DESIGNED BY: ST
DRAWN BY: ST
CHECKED BY: .

SHEET TITLE:
SITE ELECTRICAL PLAN

SHEET NO.
74
SHEET 74 OF 90

CADconform Certify This File
IF THIS DRAWING IS LESS THAN 22" X 36" IT IS A REDUCED SIZE DRAWING
CADconform Certify This File
L/K DWG. NAME: 63–64–65–66–67.dwg; Jun 29 2017 – 10:28am; LAST EDITED BY: stucker