


NOTE:
 Elm Street to be Closed to
 Through Traffic During Construction.
 Do Not Close Elm St. & Pine St.
 at the Same Time.

Note:
 Pavement, Sidewalks, Etc.
 To Be Removed Are
 Indicated By:

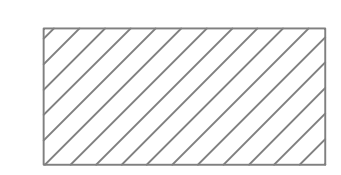

Sta. 9+60.00
 Sta. 9+85.00 - SS Line 1
 N-5713.08, E-10004.16
 Construct MH, Shallow SS
 (5' Dia.) (Lined)
 Top Elev = 1300.84
 MH moved 25'S to avoid
 conflict with underground
 gas line and electric poles

