
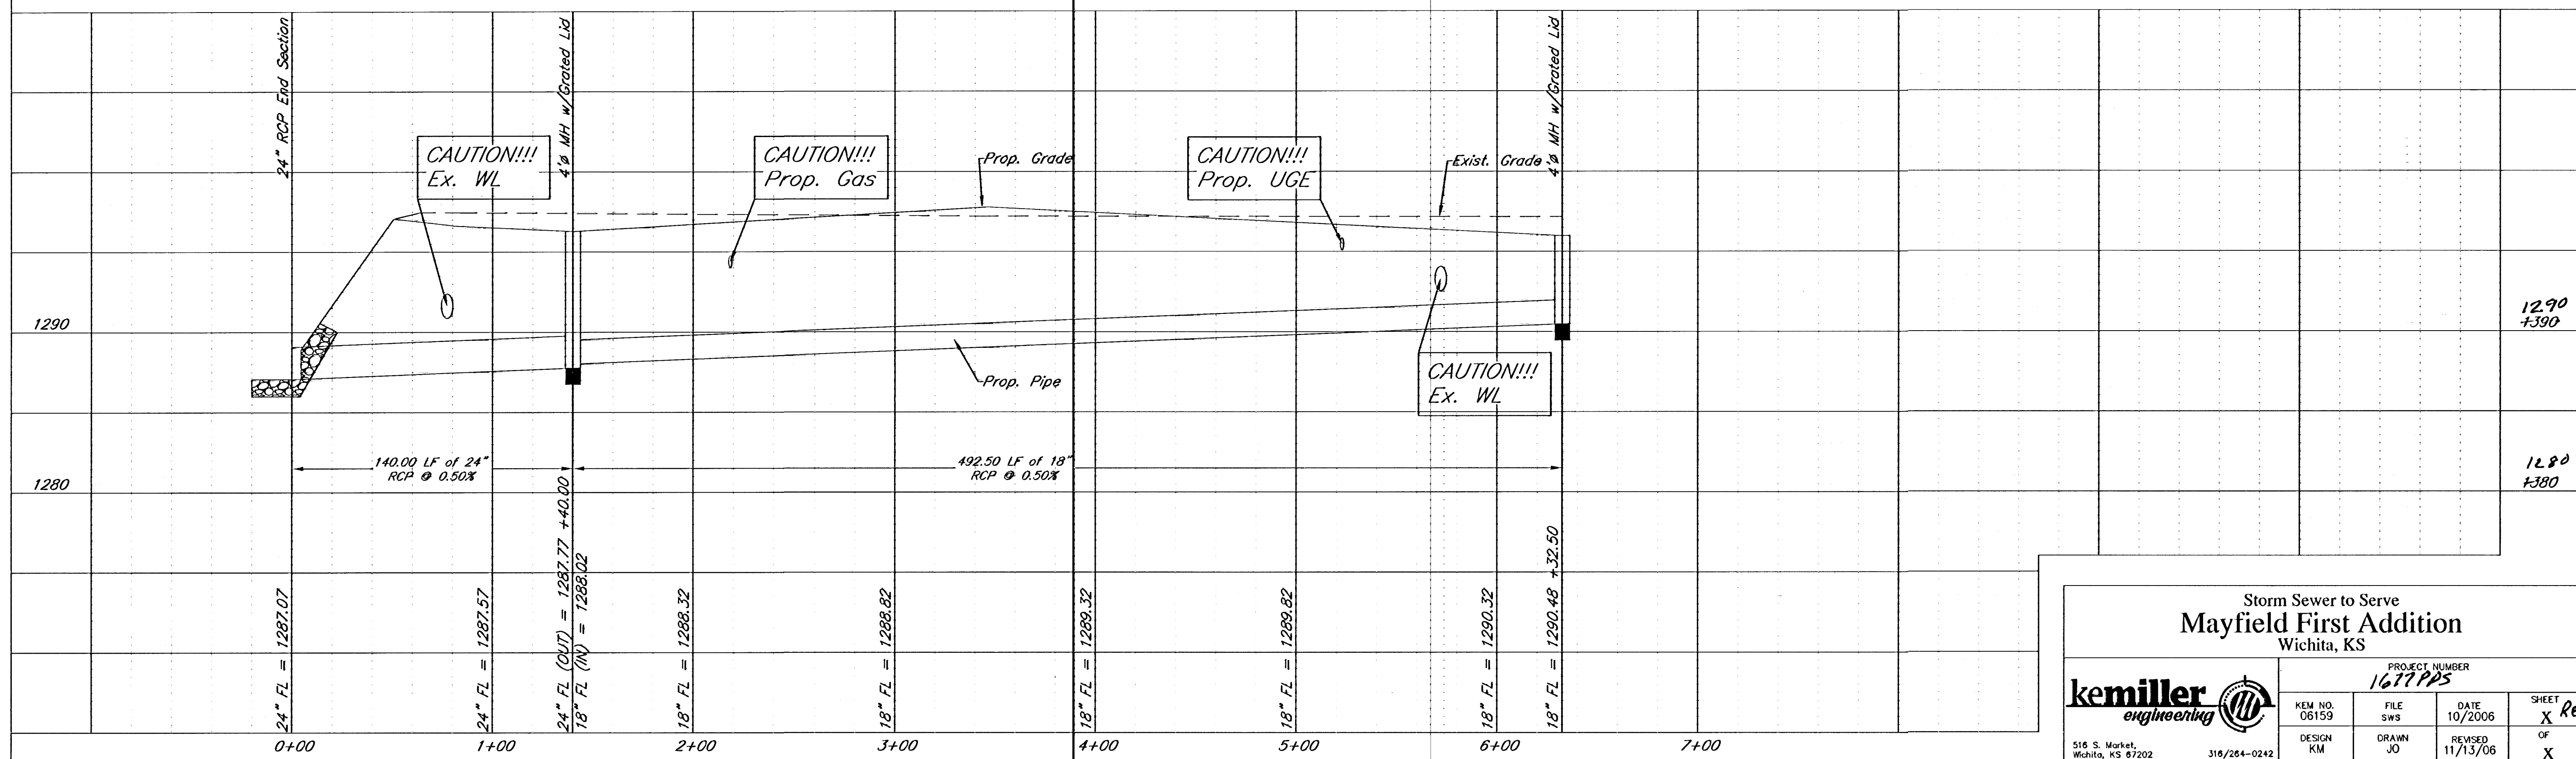


2441731
2002

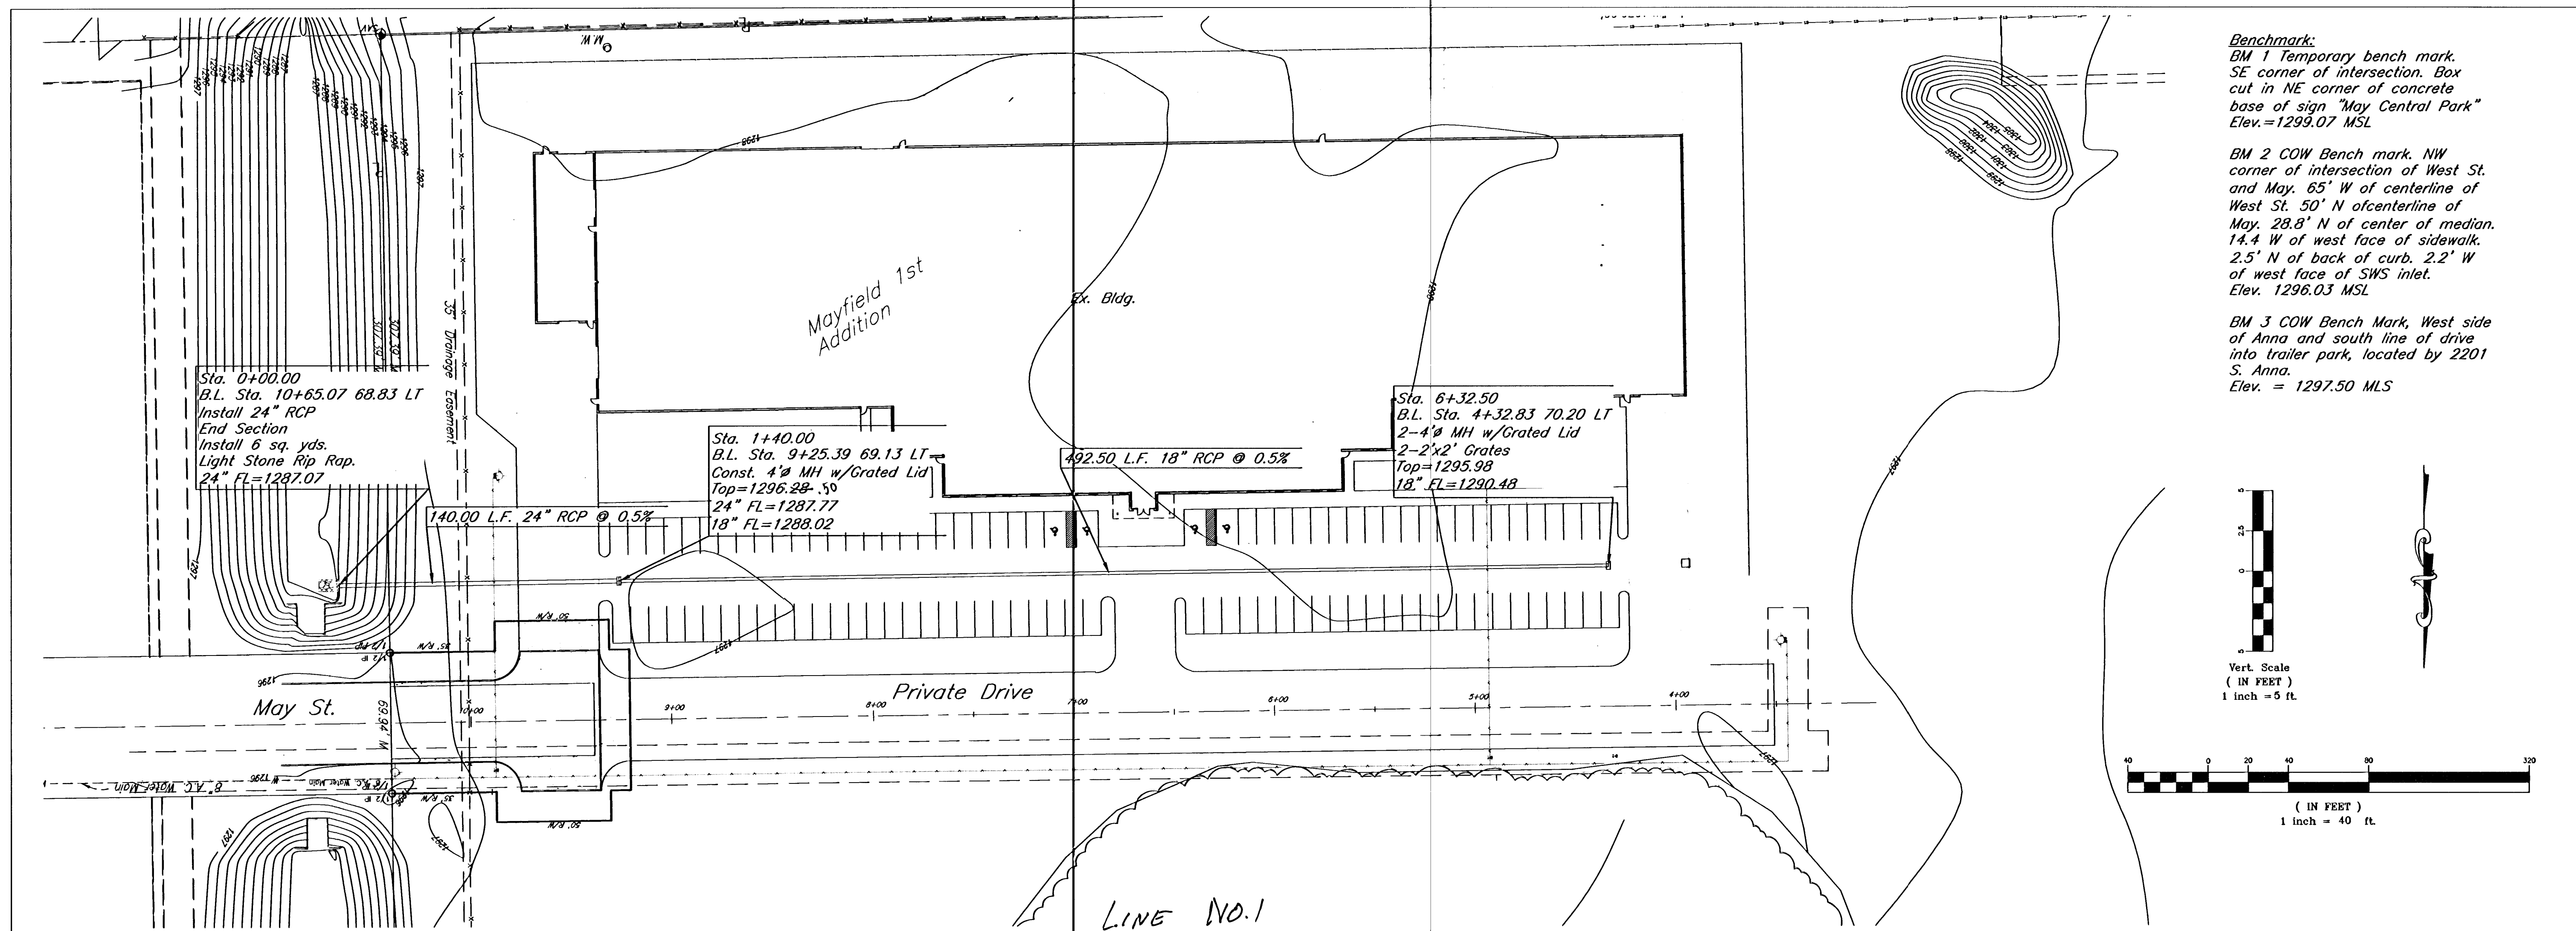

Storm Sewer to Serve Mayfield First Addition Wichita, KS				
PROJECT NUMBER 1677PPS		SHEET X		
KEM NO. 06159	FILE SWS	DATE 10/2006	REVISED 11/13/06	
DESIGN KM	DRAWN JO	OF X	Revised sheet 2 of 8	

kemiller
engineering

516 S. Market,
Wichita, KS 67202

316/284-0242