


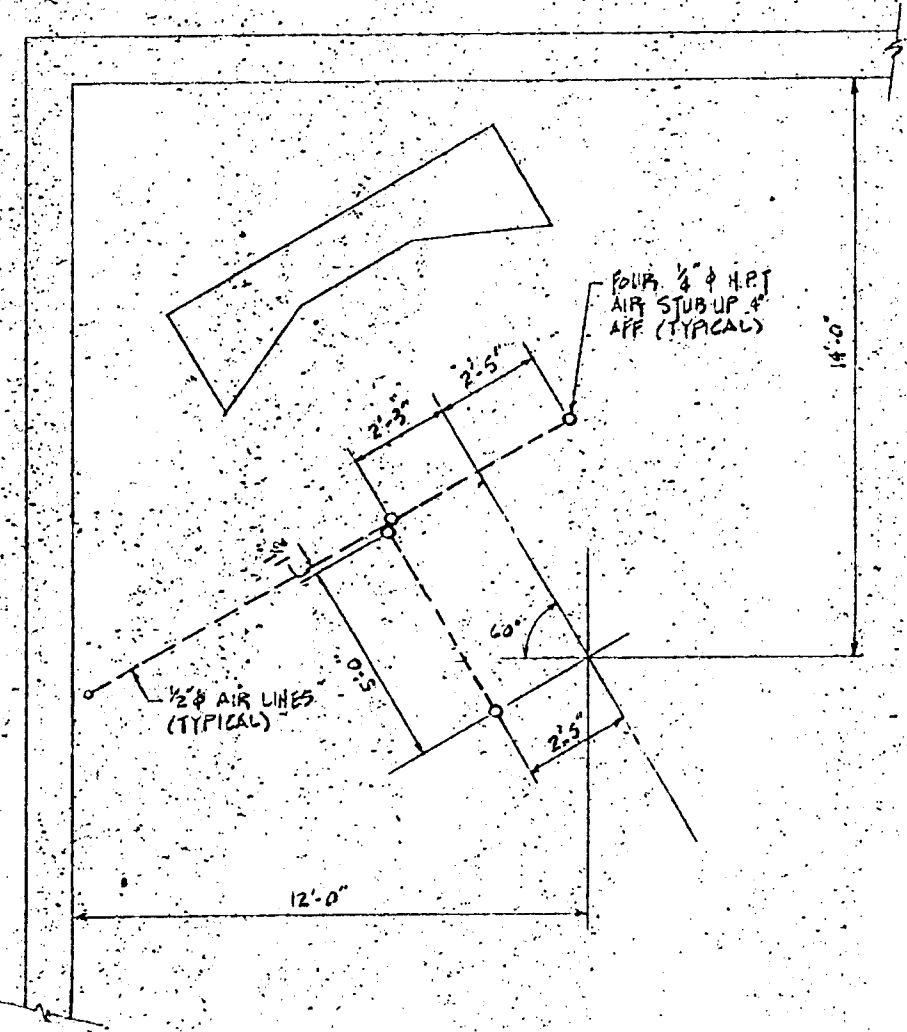


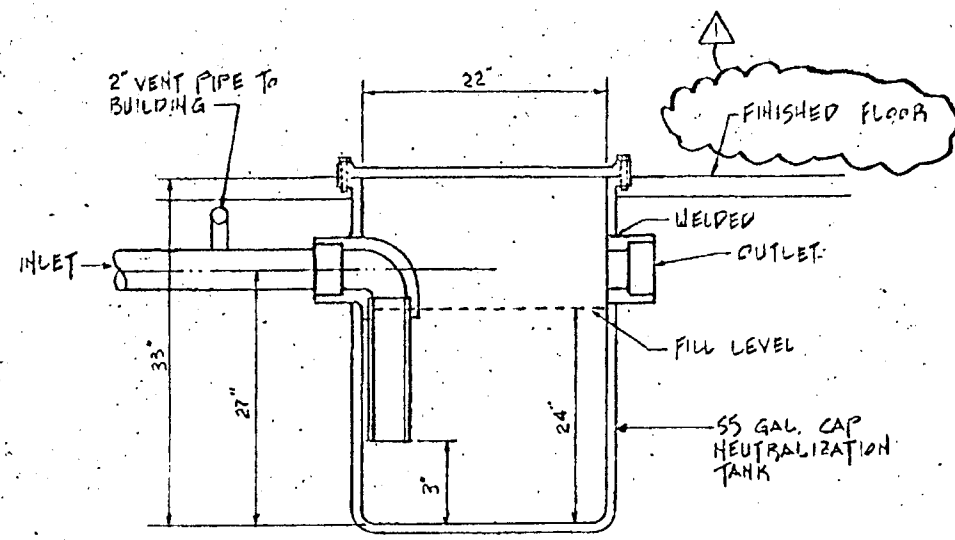


B ALIGNMENT AREA UNDERGROUND AIR
SCALE: 1/4" = 1'-0"

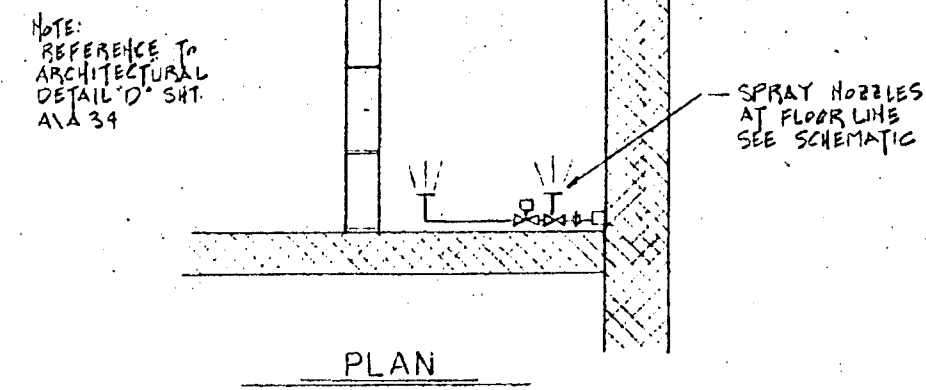

C NEUTRALIZATION TANK DETAIL
NO SCALE

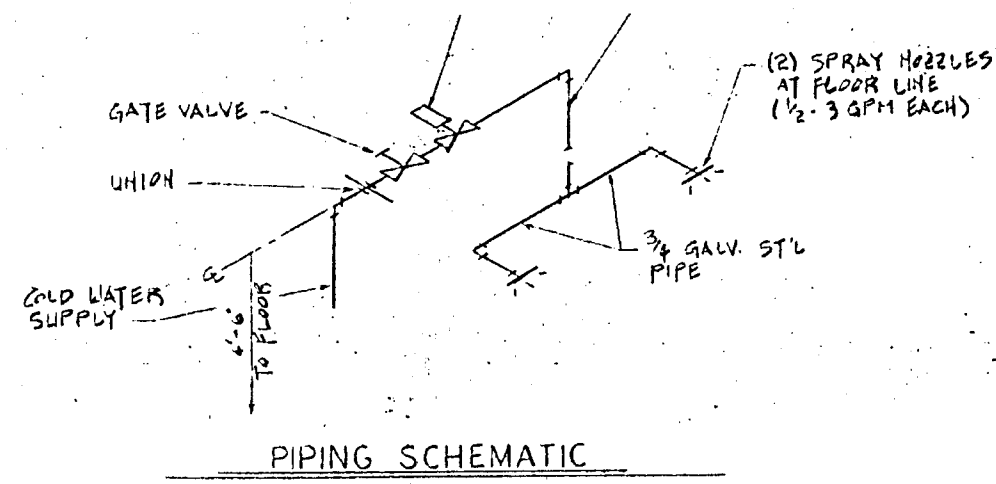

D BATTERY ROOM PIPING
SCALE 3/8" = 1'-0"

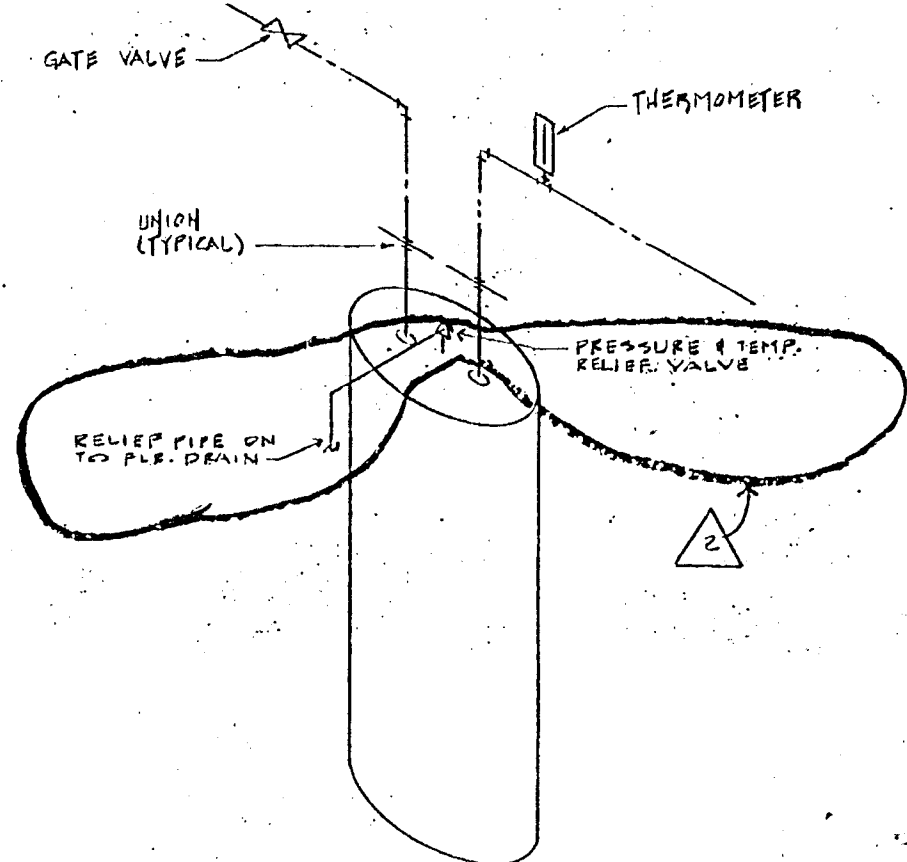

E TYPICAL WATER HEATER DETAIL
NO SCALE


G

FIXTURE SCHEDULE							
MARK	FIXTURE	WASTE	VENT	TRAP	HW	CW	REMARKS
P-1	WATER CLOSET (MEN)	4"	2"	INT.		1"	TRV PLUMB.
P-2	URINAL	3"	2"	INT.		1/4"	1/2" EX. WALL HUNG
P-3	LAVATORY	2"	1 1/2"	1 1/2"	1/4"	1/4"	WALL HUNG
P-11	WASH FOUNTAIN	2"	1 1/2"	2"	1"	1"	
P-5	SERVICE SINK	3"	1 1/2"	2"	3/4"	3/4"	W.S.S. SINK
P-13	SHOWER	2"	1 1/2"	1 1/2"	3/4"	3/4"	
P-14	DRINKING FOUNTAIN	2"	1 1/2"	1 1/2"	1/4"	1/4"	SHG. PUB.
P-12	WATER CLOSET (WOMEN)	4"	2"	INT.		1/4"	1" EX. FLOOR MT.
P-15	REC. NO. OFFICE					1/4"	
P-10	HA. INSIDE					1/4"	
P-16	KITCHEN UNIT	2"	1 1/2"	1 1/2"	3/4"	3/4"	BY PLUMBING CONTR. SEE PLUMB. FOR SIZE
R-01	ROOF DRAIN						

H

EQUIPMENT LIST				
ITEM	QTY	FURNISHED BY	INSTALLED BY	REMARKS
TIRE CHANGER	4	J.C. PENNEY	GENERAL CONTR. PIPING BY PLUMB. SUB-CONTR.	
TUBE TEST TANK	1	J.C. PENNEY	J.C. PENNEY	
AIR COMPRESSORS	2	J.C. PENNEY	PLUMBING SUB. CONTR.	15 HP
ELECT. CORD REEL	5	J.C. PENNEY	ELECTRICAL SUB. CONTR.	110 VOLT
BATTERY CHARGERS	1	J.C. PENNEY	J.C. PENNEY	24-2/10000 HOURS OF ST. LOUIS 110.
COMPLETE BRAKE SHOP	1	J.C. PENNEY	J.C. PENNEY	
ALIGNMENT RACK	1	J.C. PENNEY	J.C. PENNEY	
ALIGNMENT CABINET	1	J.C. PENNEY	J.C. PENNEY	
SINGLE POST LIFT	10	J.C. PENNEY	EQUIP. BY SUPPLIER PIPING BY PLUMB. SUB-CONTR.	EXCAVATION BY GENERAL CONTRACTOR
TWO POST FRAME LIFT	4	J.C. PENNEY	EQUIP. BY SUPPLIER PIPING BY PLUMB. SUB-CONTR.	EXCAVATION BY GENERAL CONTRACTOR
WIND SCREEN	3	J.C. PENNEY	J.C. PENNEY	
DISC. LATHE	1	J.C. PENNEY	J.C. PENNEY	
WORK BENCH	8	J.C. PENNEY	J.C. PENNEY	
PART CLEANING TANK	1	J.C. PENNEY	J.C. PENNEY	
AIR PRESSURE REGULATOR	7	J.C. PENNEY	PLUMBING SUB. CONTR.	
AIR LINE LUBRICATOR	7	J.C. PENNEY	PLUMBING SUB. CONTR.	
AIR LINE FILTER	7	J.C. PENNEY	PLUMBING SUB. CONTR.	
3/8" x 3/8" QUICK COUPLER END	20	J.C. PENNEY	PLUMBING SUB. CONTR.	
ELECT. CORD REEL	3	J.C. PENNEY	ELECTRICAL SUB. CONTR.	200 VOLT

J WATER HEATERS

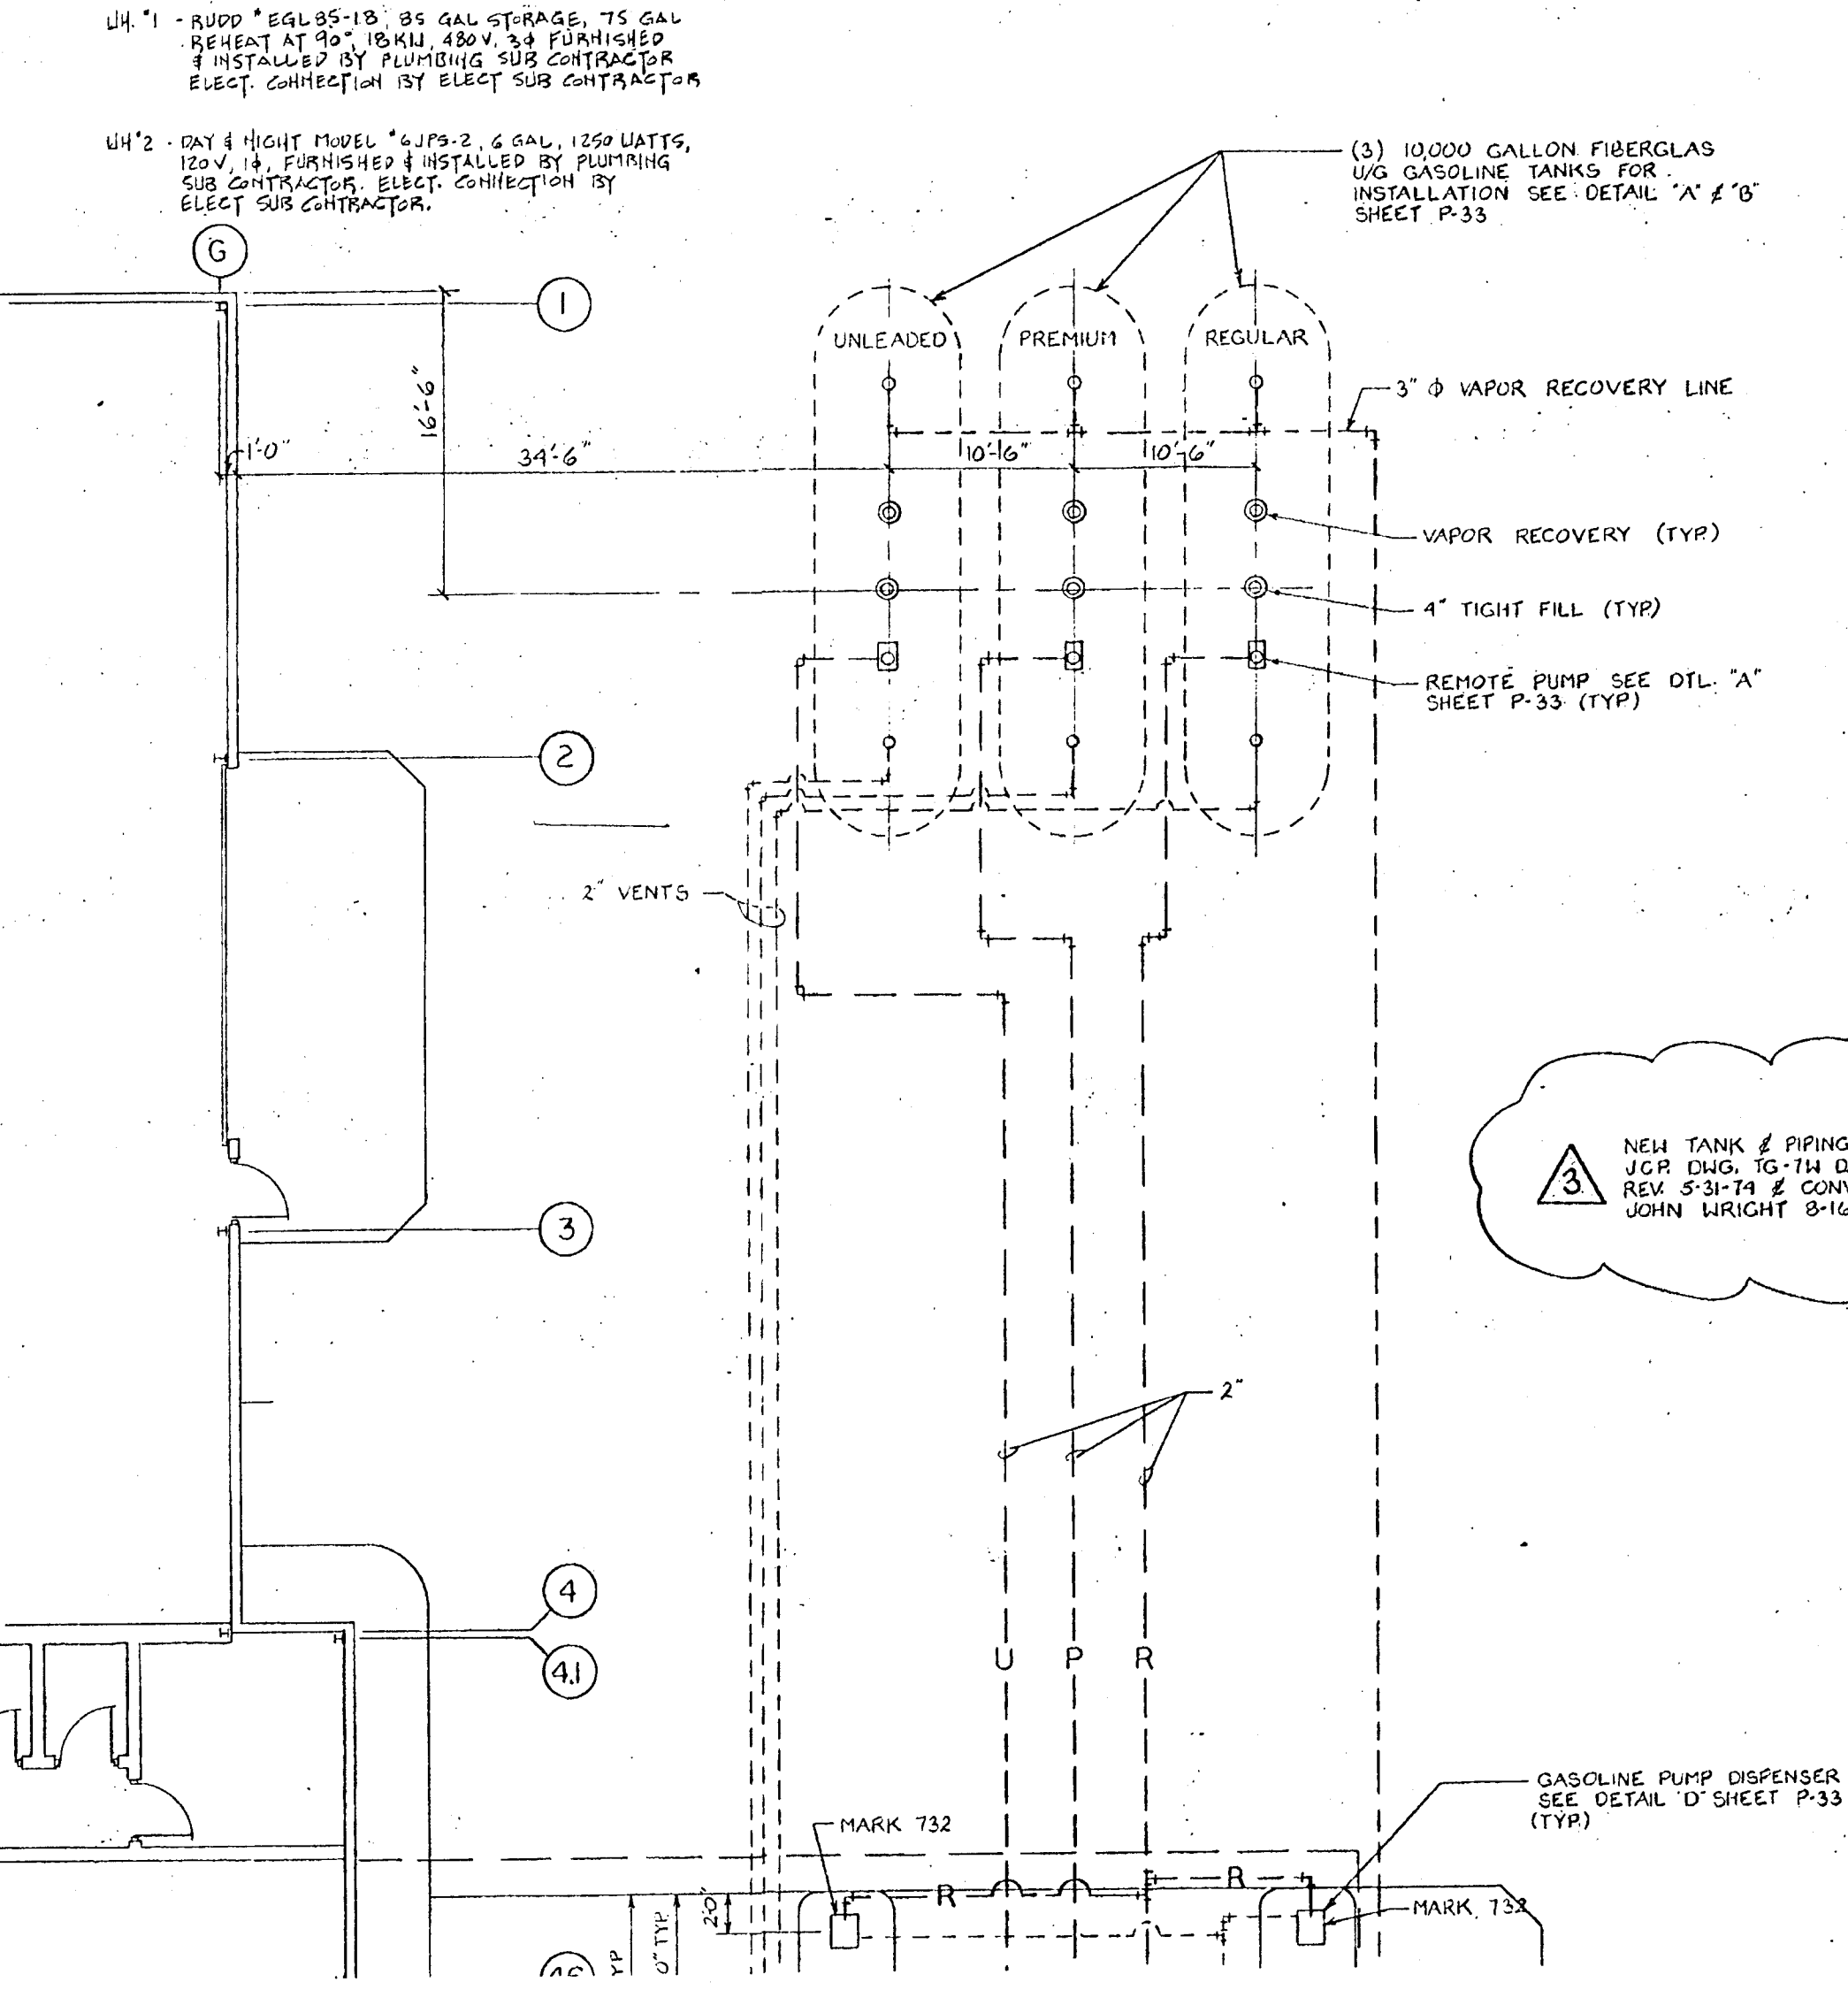

K

LEGEND		
SYMBOL	ABV	DESCRIPTION
	CW	DOMESTIC COLD WATER
	HW	DOMESTIC HOT WATER
	W	SANITARY WASTE
	AW	ACID RESISTANT WASTE LINE
	A	OVERHEAD AIR LINE
	A	UNDERFLOOR AIR LINE
		VENT OR DRAIN LINE AS IND. ON Dwg.
	AW	ACID RESISTANT WASTE LINE
	RL	RAIN LEADER
	R	REGULAR GASOLINE LINE
	P	PREMIUM GASOLINE LINE
	F	GASOLINE FILL LINE
	FD	FLOOR DRAIN
	ARFD	ACID RESISTANT FLOOR DRAIN
	RD	ROOF DRAIN

L

EQUIPMENT LIST						
ITEM	QTY	FURNISHED BY	INSTALLED BY	LOCATION	REMARKS	
10,000 GALLON FIBERGLASS TANK	3	J.C. PENNEY	J.C. PENNEY	DTL. A-10-31	G.S. & C.S. MOD. ORDER WITH TANKS	
FIBERGLASS TANK STRAPS	12	J.C. PENNEY	J.C. PENNEY	AT TANKS		
ALUM. DROPPING TUBES	2	J.C. PENNEY	J.C. PENNEY	AT TANKS		
REDUCTION GAS PUMP (GASOLINE)	3	J.C. PENNEY	J.C. PENNEY	AT TANKS	CK. LENGTH BEFORE INST.	
RED JACKET LENS OIL	3	J.C. PENNEY	J.C. PENNEY	AT TANKS	INST. PER MFG. INSTRUCTIONS	
RED JACKET ADAPTER	3	J.C. PENNEY	J.C. PENNEY	AT TANKS		

PRINTS ISSUED

DATE	PURPOSE	NO.
8-9-73	J.C.P. APPROVAL	10
9-17-73	AS DESIGNED-ESTIMATES	3
10-5-73	BLOOM. PERMIT	1
11-3-73	FIN. APPROVAL	3
12/2/73	J.C.P. OTHER DRAWING	

FOR CONSTRUCTION: 12/19/73

REVISIONS:

DATE	ITEM	NO.
11/14/73	PER J.C. PENNEY REP. MARKS	1
1/5/74	PER J.C. PENNEY REP. MARKS	2
3/21/74	PER J.C. PENNEY REP. MARKS	3

THE LAW COMPANY, INC.

GALVIN KINGDON RA. BERGER
313 S. MAIN ST. WICHITA, KANS. 67202
PHONE (316) 268-8888
ARCHITECTS & ENGINEERS

DRAWN	CHECKED
HINE JAMES	D.P.C.
RELATED DRAWINGS	
SHELL	
DETAILS	
STRUCTURE	
MECHANICAL	
ELECTRICAL	
OTHER	
SEQUENCE NUMBER	
OF SHEETS	

TOWNE EAST SQUARE (KELLOGG MALL)