



Saved: 10-23-2006 6:56:50 PM by BDB
C:\Users\BDB\Documents\2006\10-23-2006 12:31:45 PM by BDB
C:\Users\BDB\Documents\2006\10-23-2006 12:31:45 PM by BDB

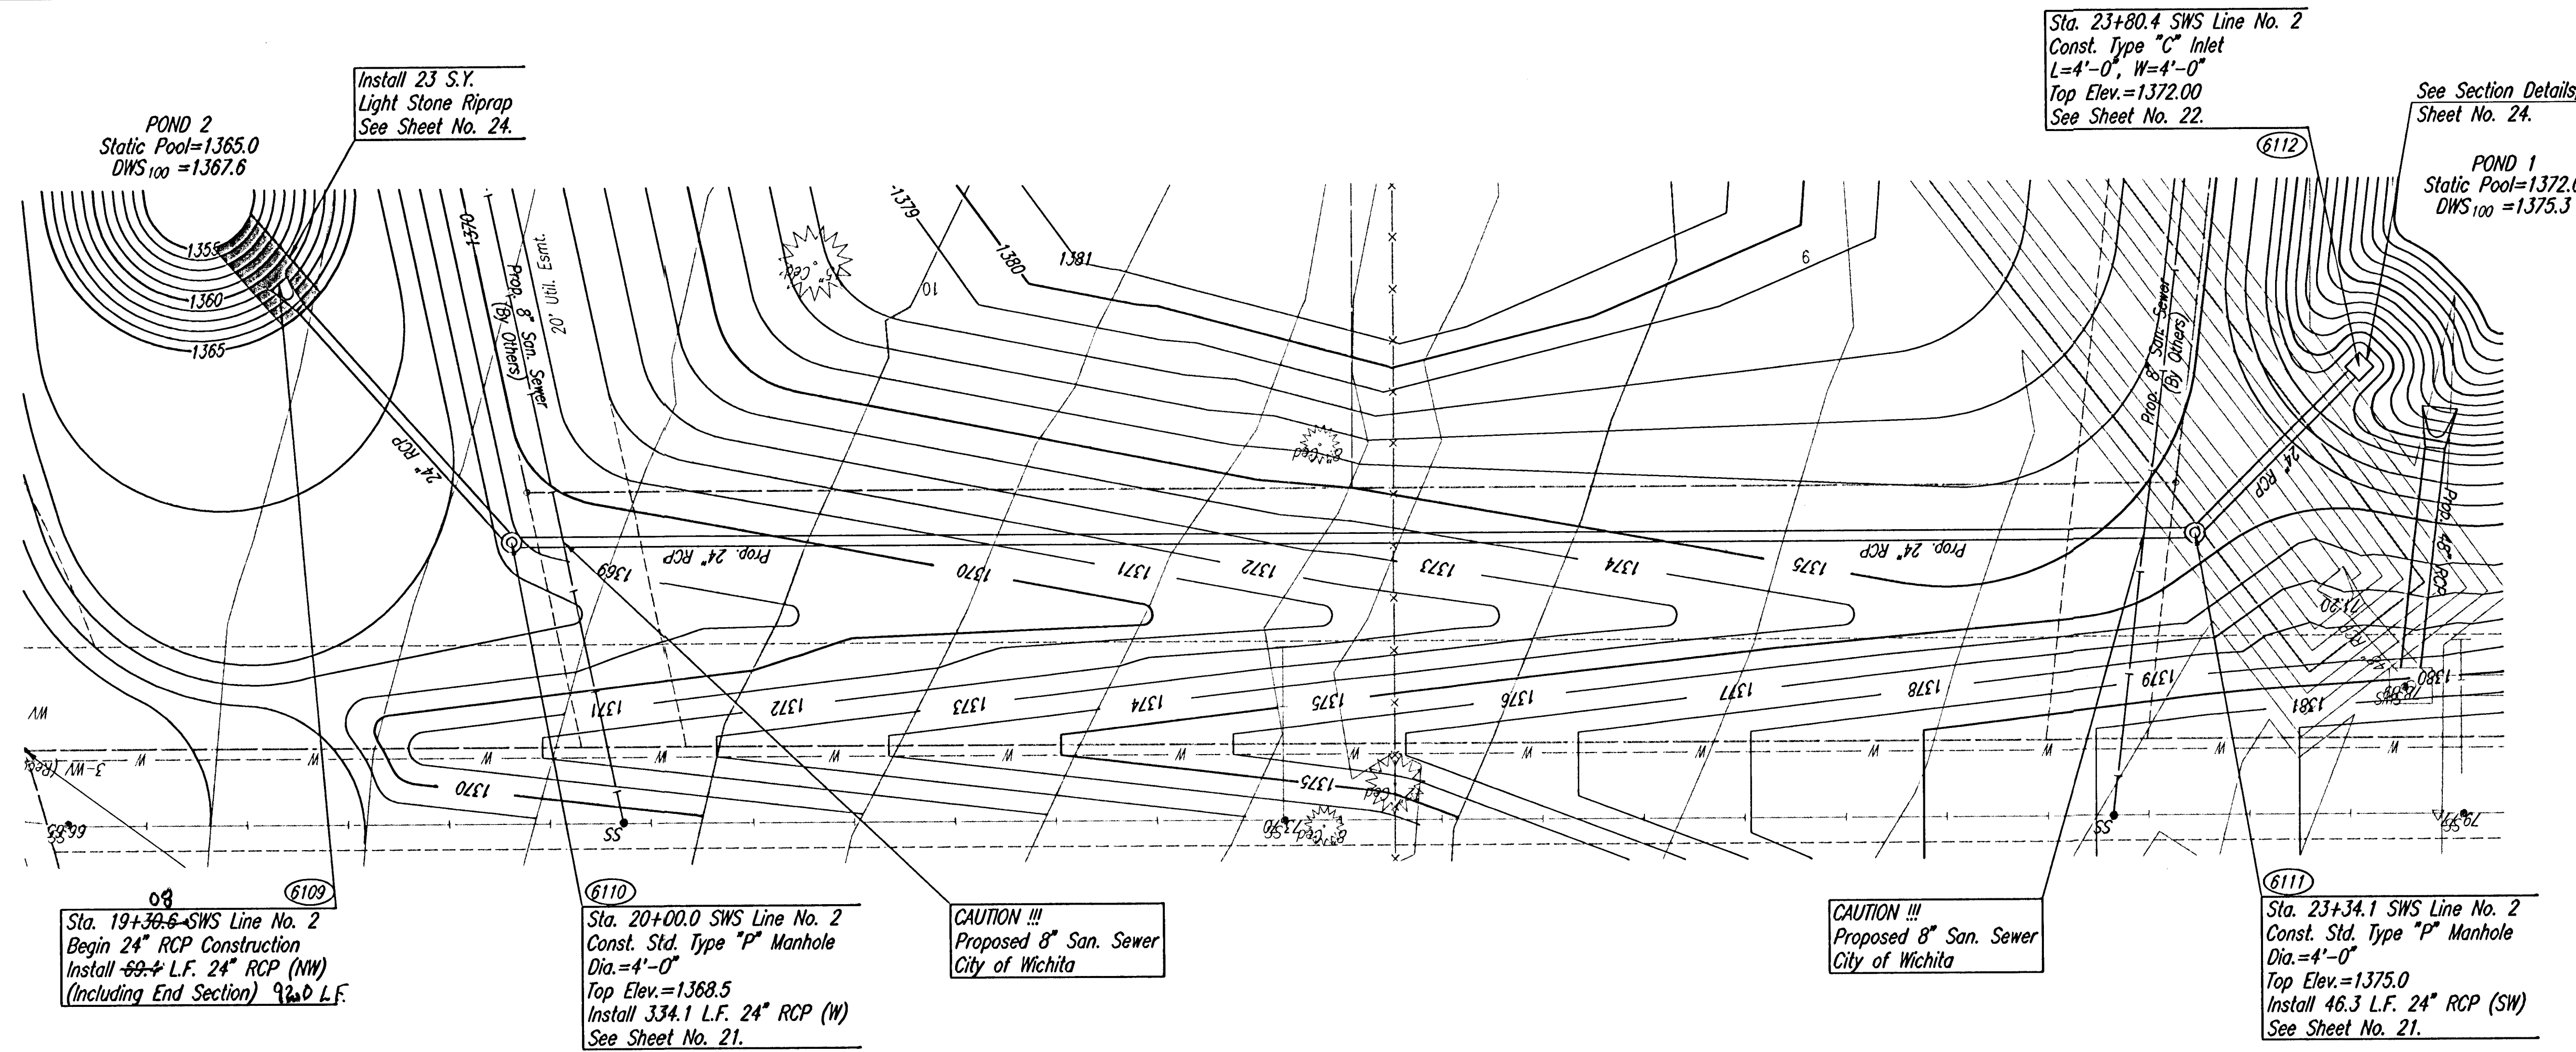

COORDINATE LIST		
POINT	NORTH	EAST
6109	386,526.6233	2,372,990.5439
6110	386,577.8082	2,372,943.7218
6111	386,573.2881	2,372,609.6822
6112	386,539.9989	2,372,577.5096

6109 = COORDINATE POINT NO.
SEE SHEET NO. 2 FOR PLAT COORDINATES

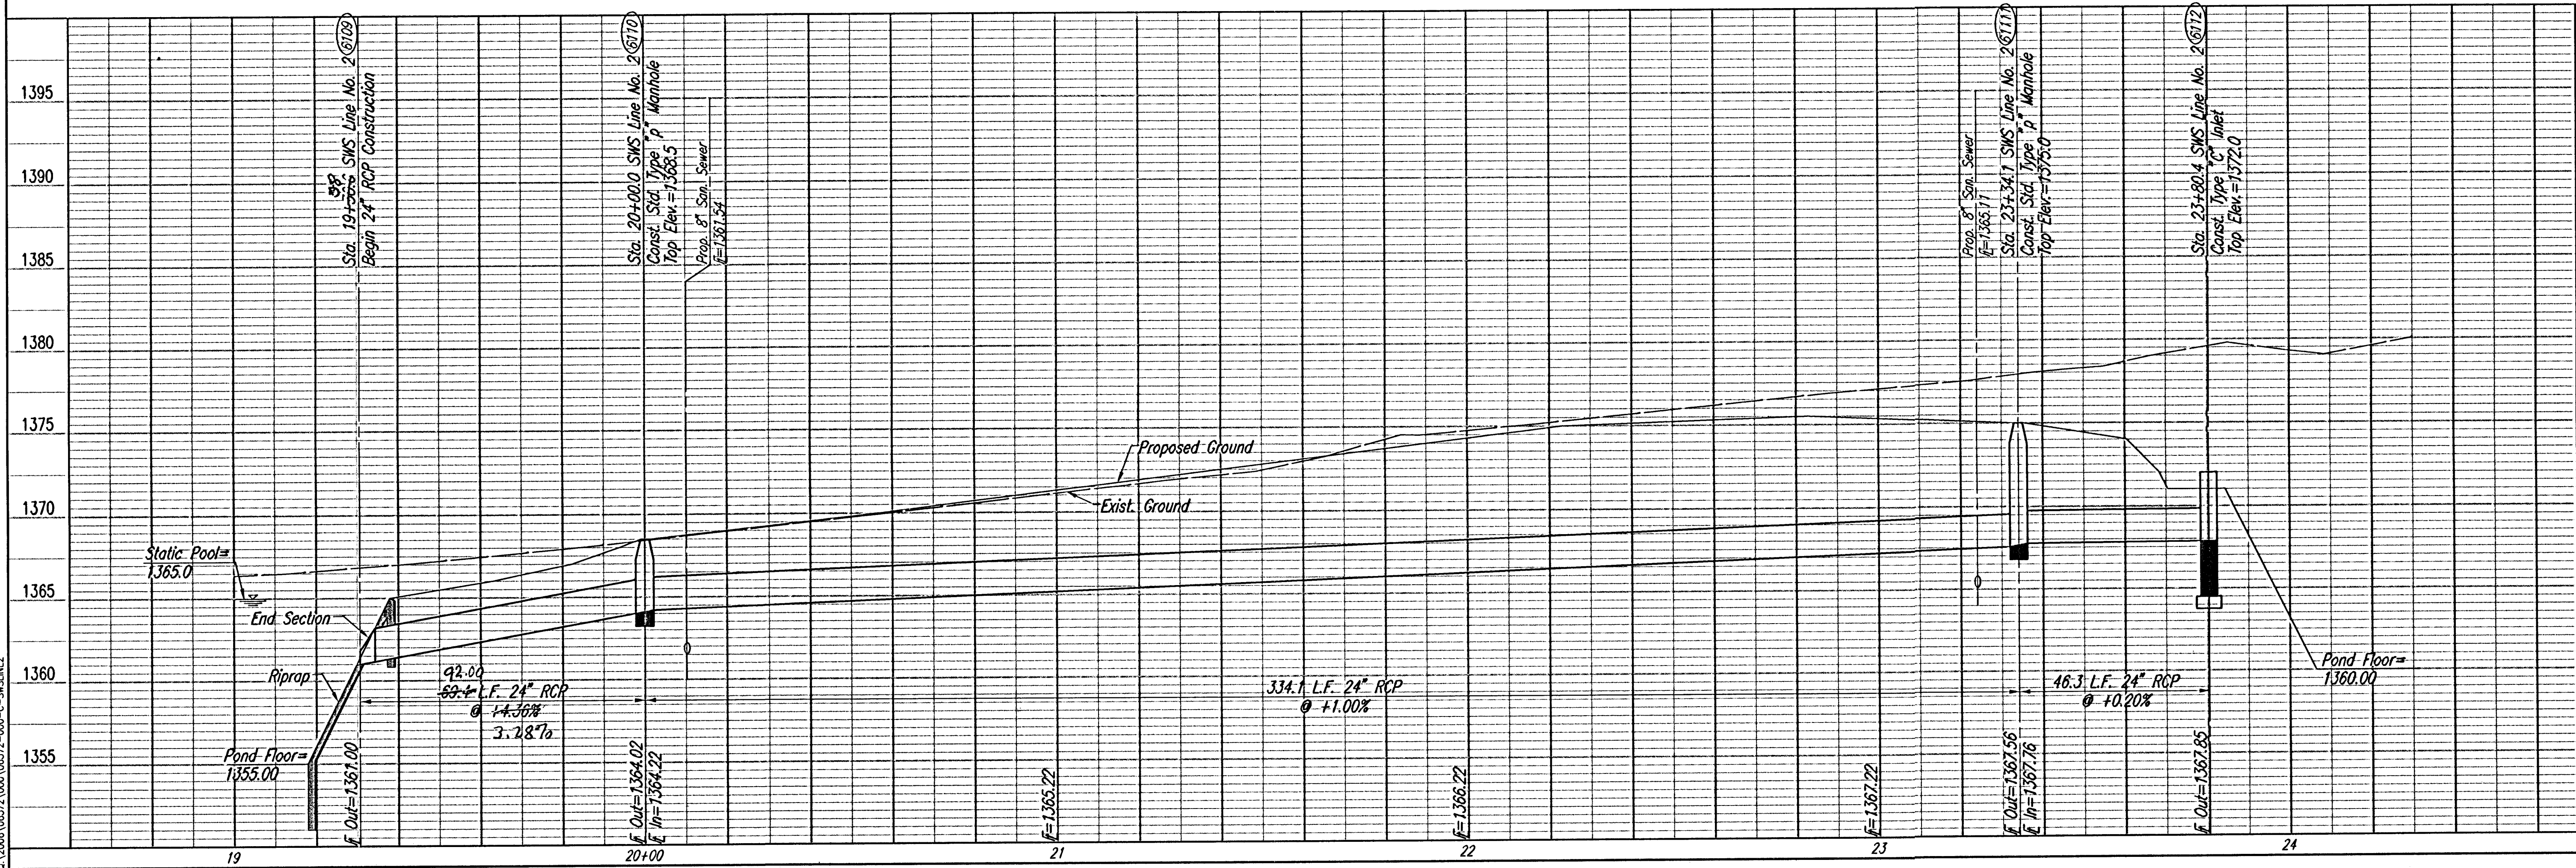