
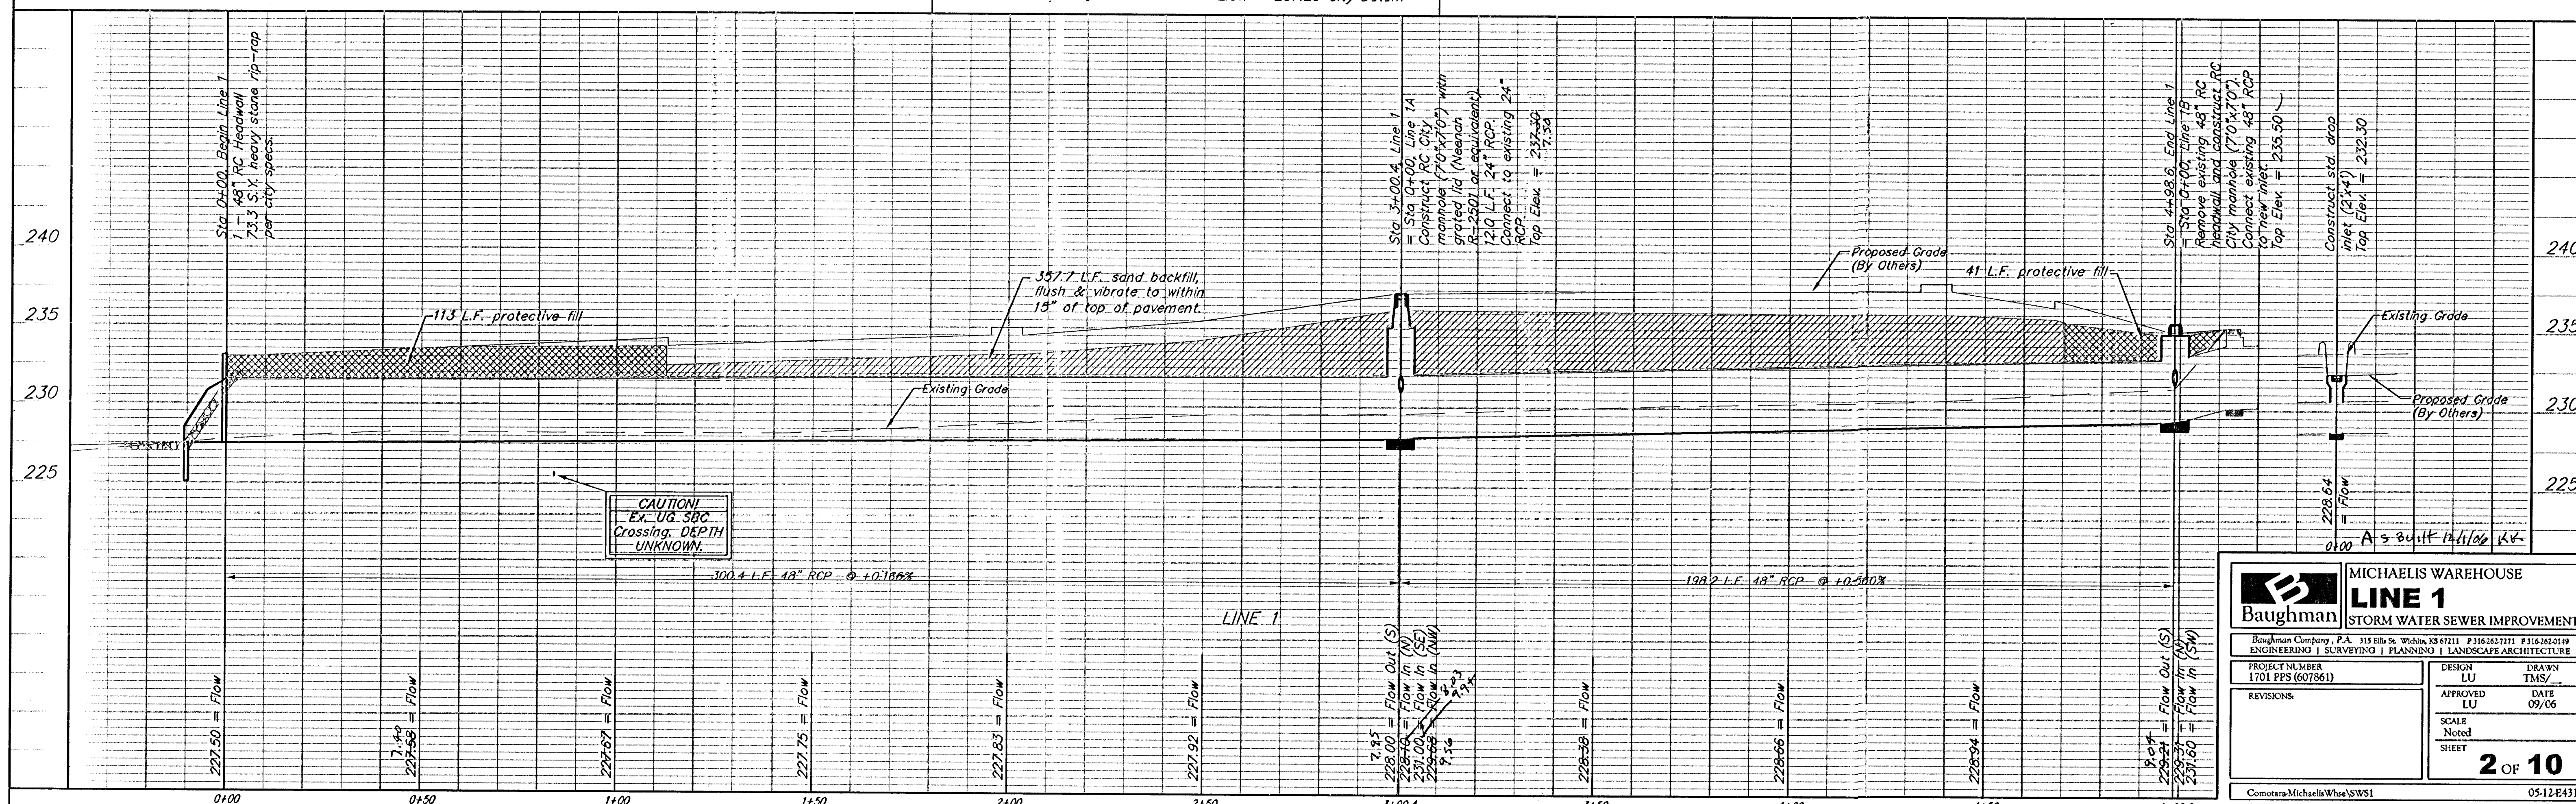


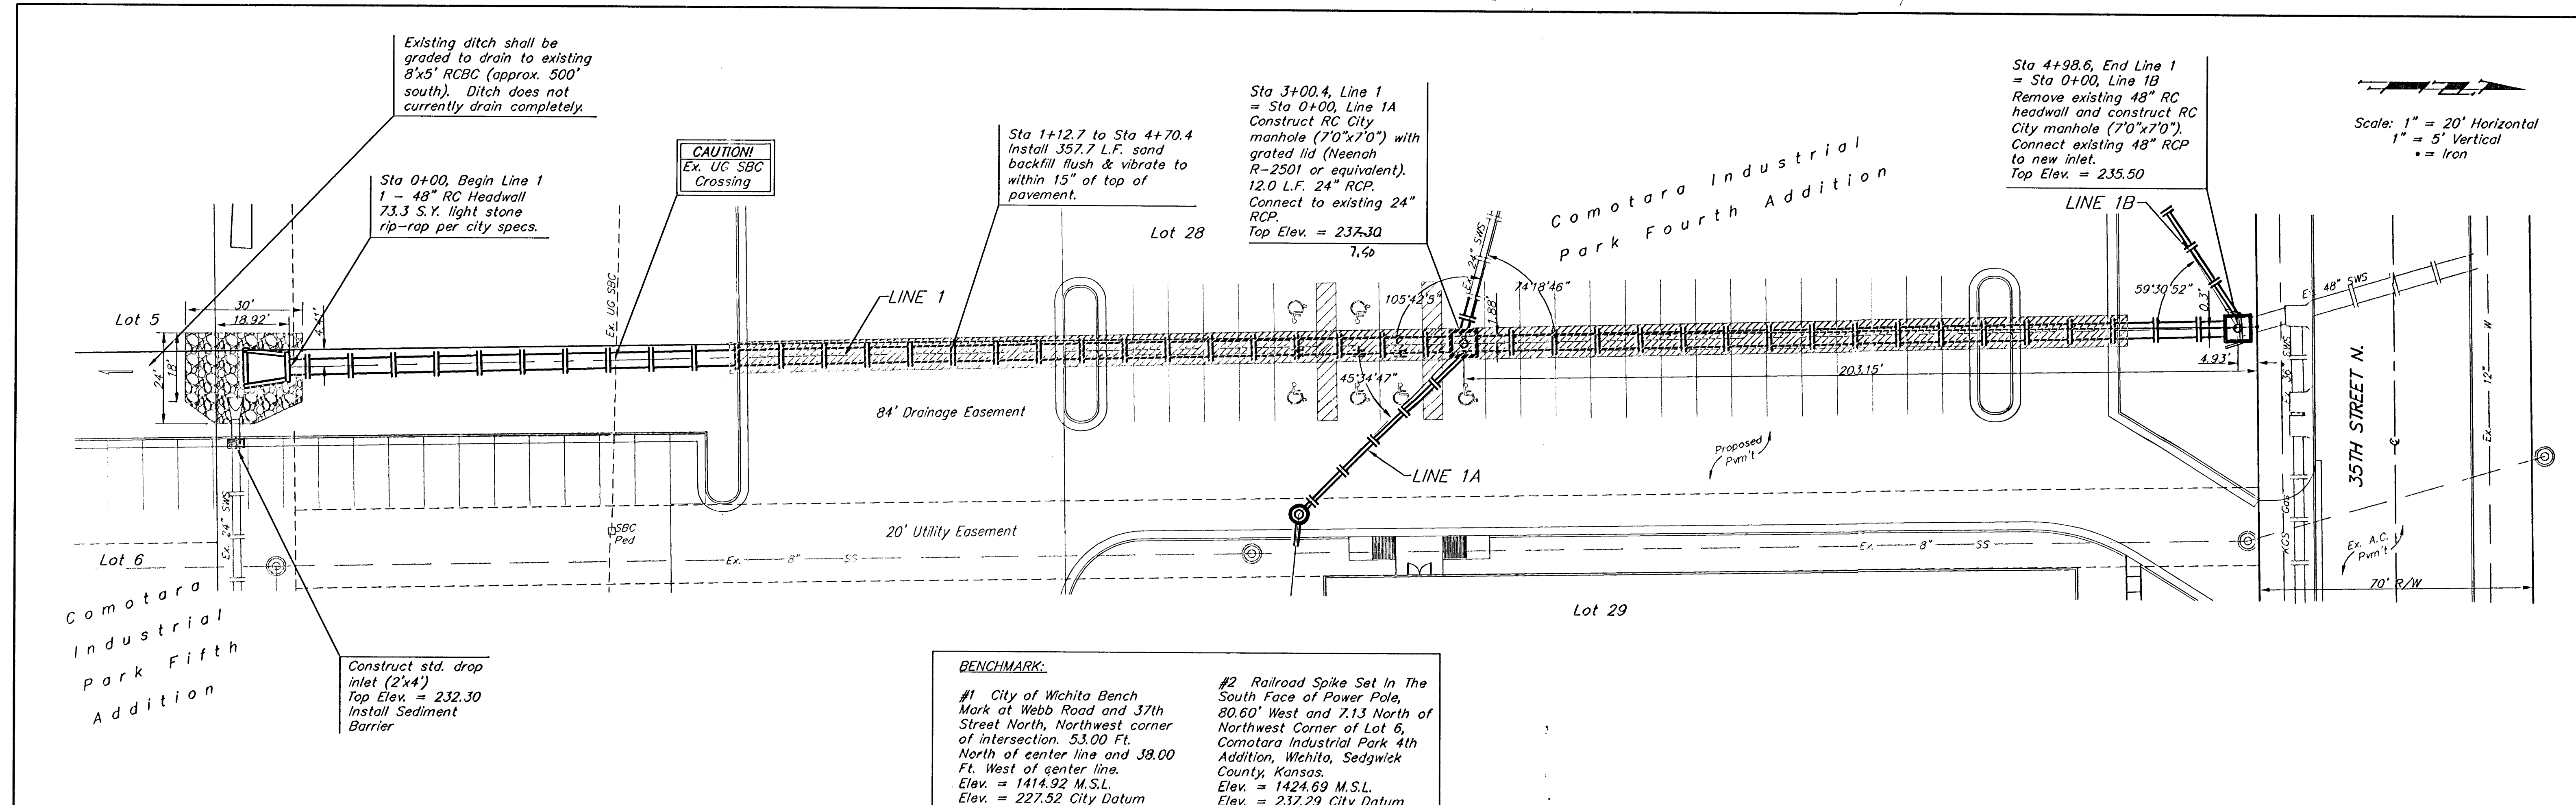

MICHAELIS WAREHOUSE

LINE 1

STORM WATER SEWER IMPROVEMENTS

Baughman Company, P.A. 315 Ellis St. Wichita, KS 67211 P 3162627271 F 3162621049

ENGINEERING | SURVEYING | PLANNING | LANDSCAPE ARCHITECTURE

PROJECT NUMBER
1701 FPS (607861)

DESIGN
LU

DRAWN
TMS

APPROVED
LU

DATE
09/06

REVISIONS

SCALE
Noted

SHEET
2 OF 10

Comotara-Michaelis Warehouse

05-12-E431