
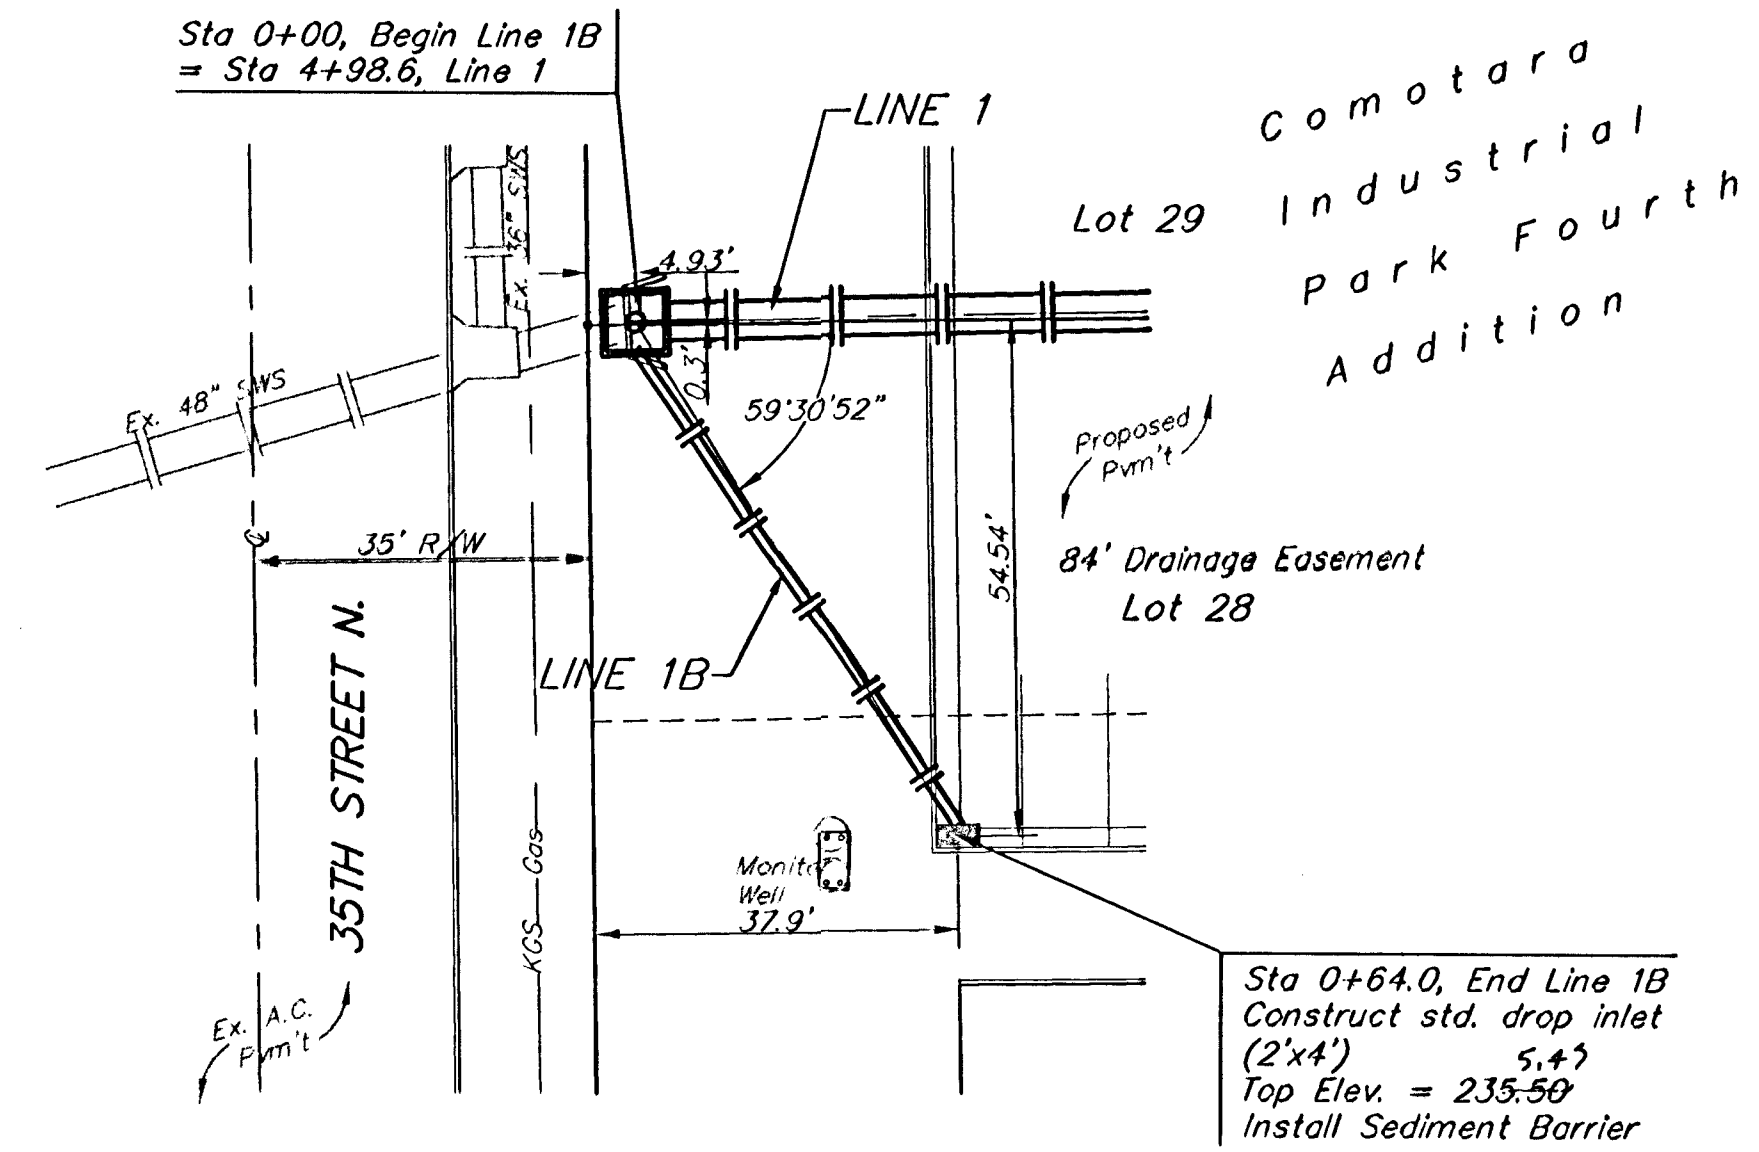



# **BENCHMARK:**

#1 City of Wichita Bench Mark at Webb Road and 37th Street North, Northwest corner of intersection, 53.00 Ft. North of center line and 38.00 Ft. West of center line.  
Elev. = 1414.92 M.S.L.  
Elev. = 227.52 City Datum

#2 Railroad Spike Set In The South Face of Power Pole, 80.60' West and 7.13 North of Northwest Corner of Lot 6, Comotara Industrial Park 4th Addition, Wichita, Sedgwick County, Kansas.  
Elev. = 1424.69 M.S.L.  
Elev. = 237.29 City Datum

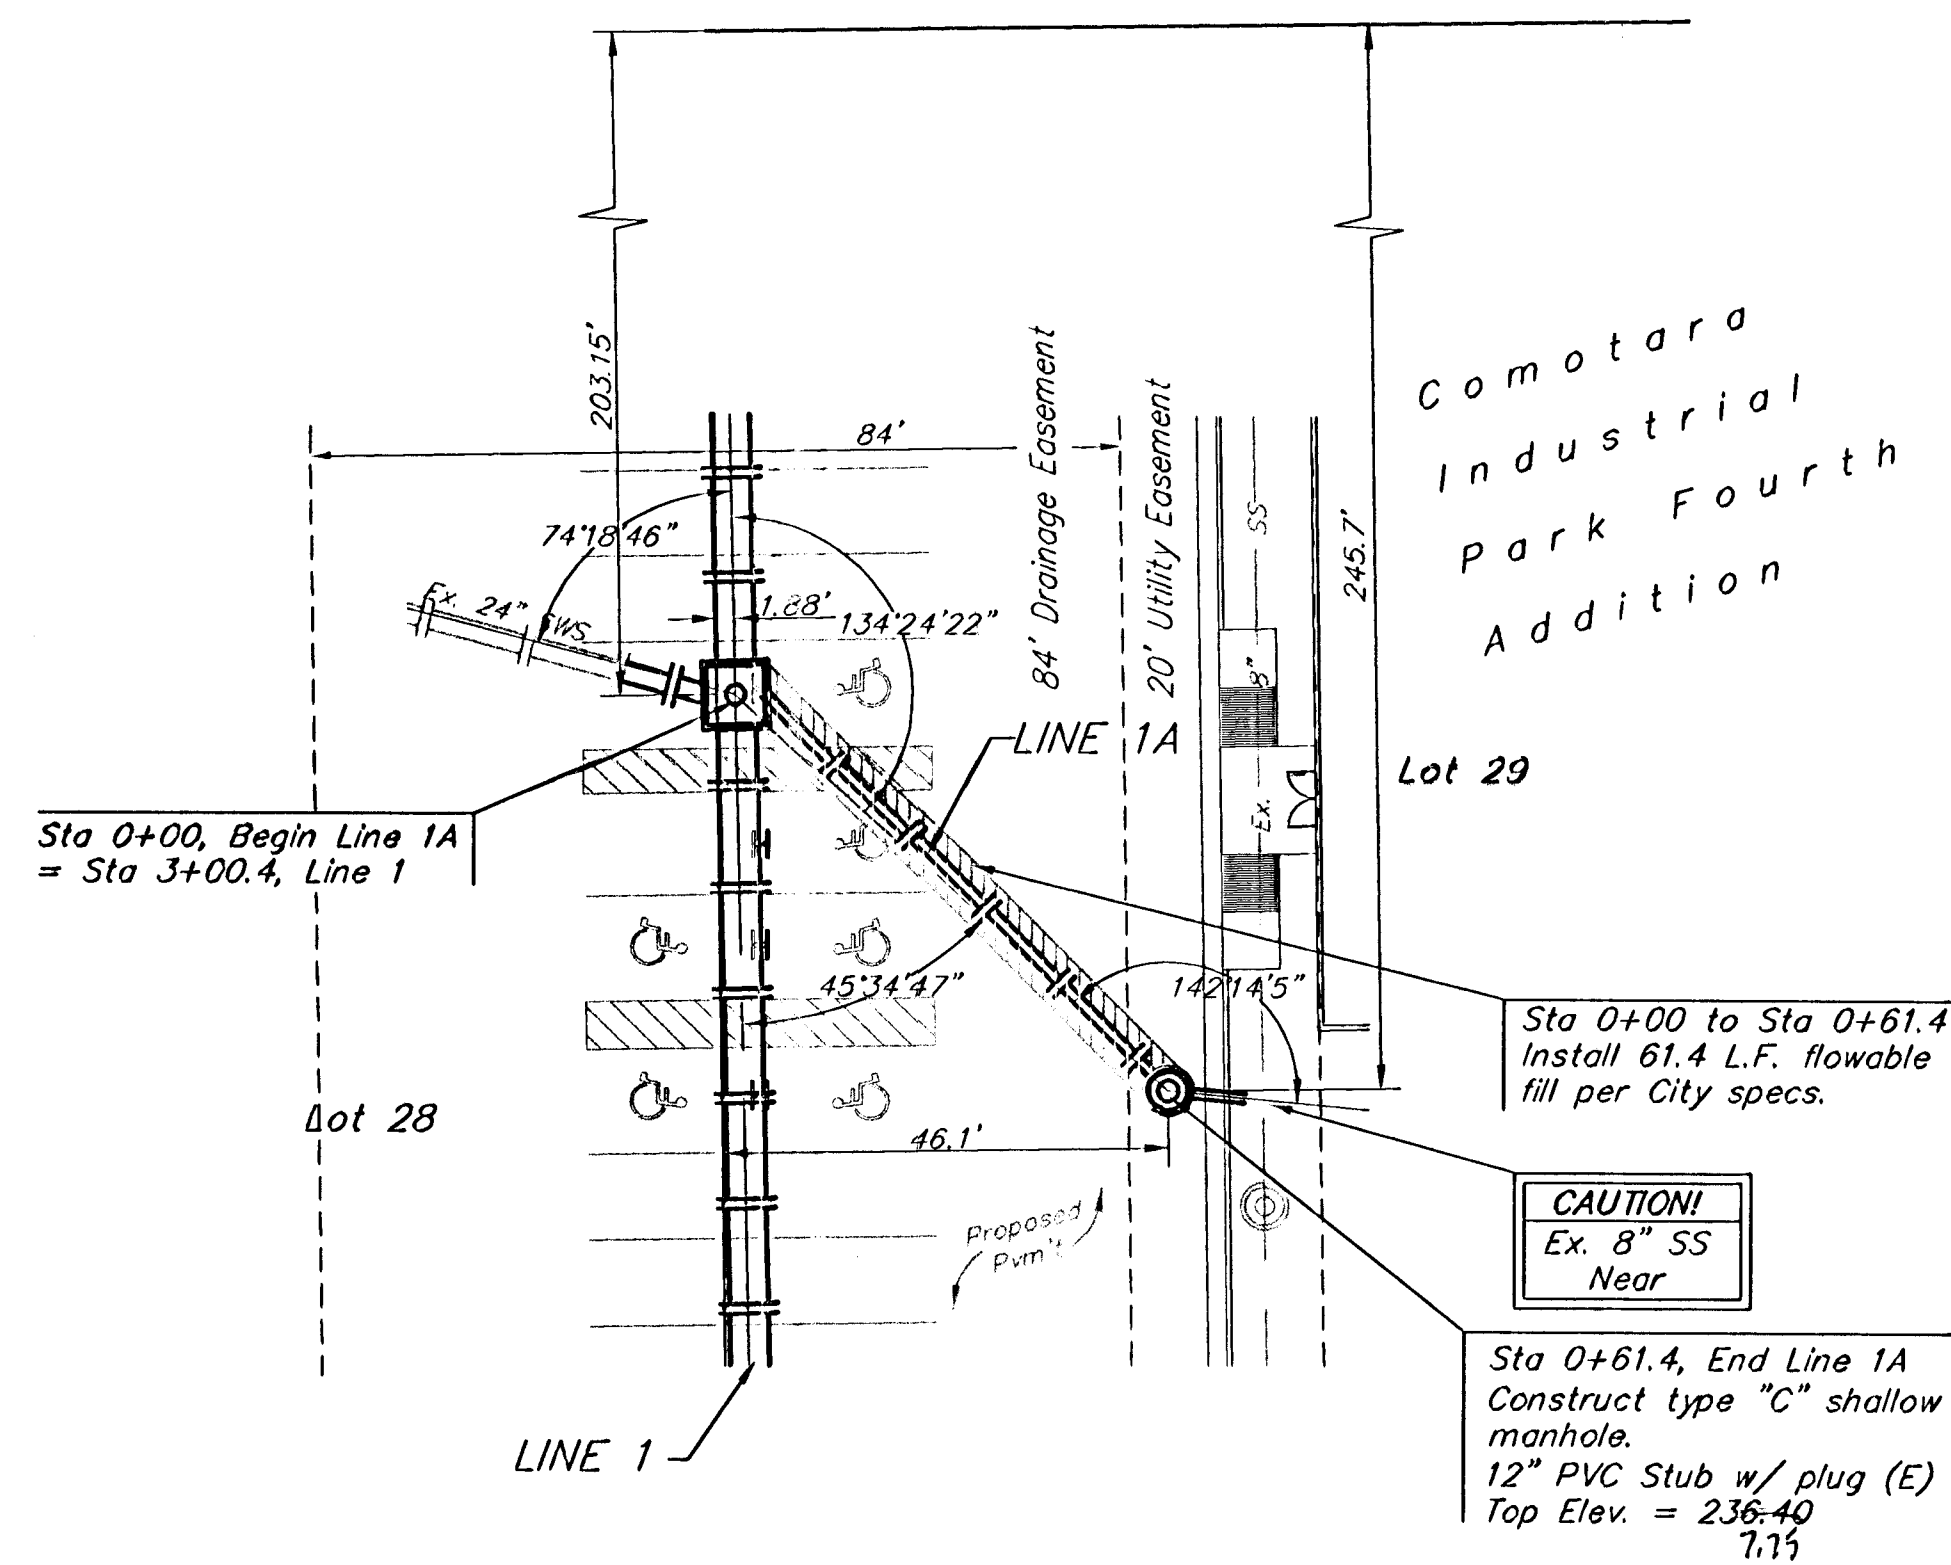

Scale: 1" = 20' Horizontal  
1" = 5' Vertical  
• = Iron

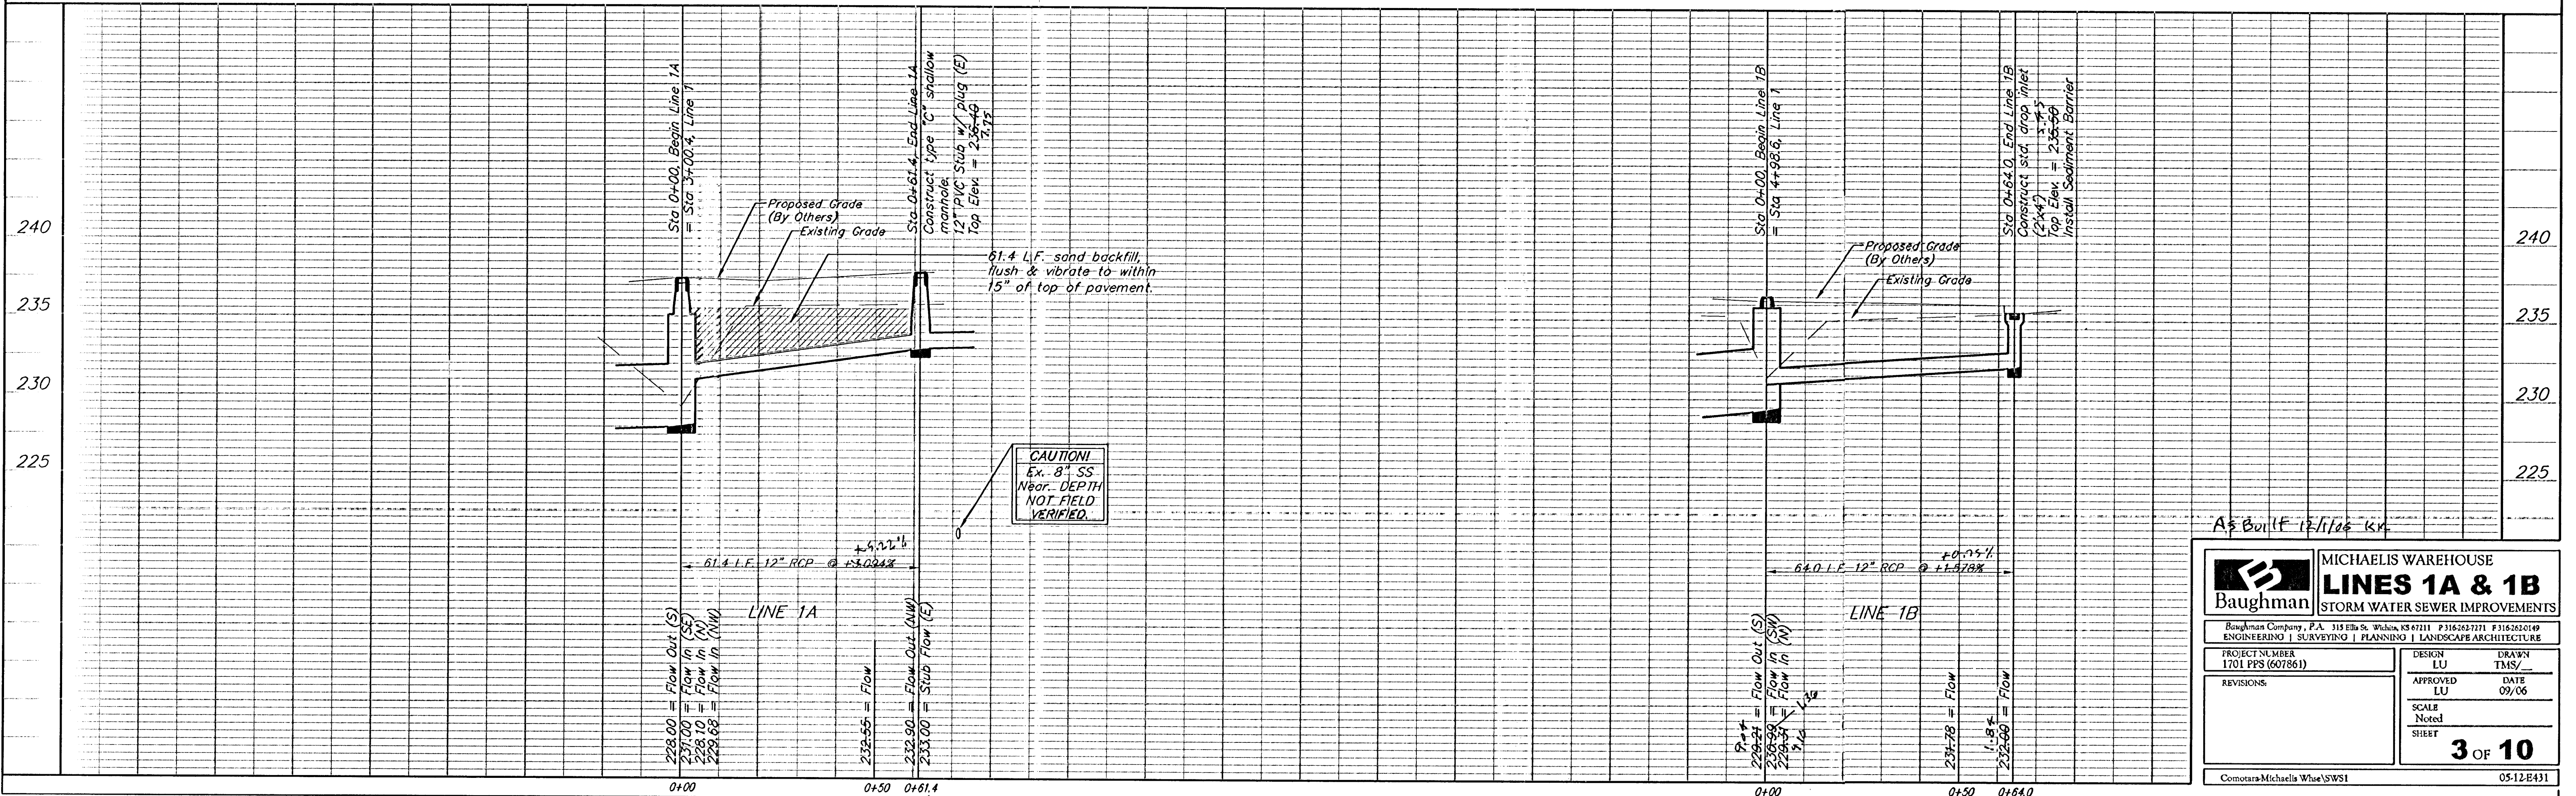

A5 B011F 12/1/06 KS

**Baughman** MICHAELIS WAREHOUSE  
**LINES 1A & 1B**  
STORM WATER SEWER IMPROVEMENTS

Baughman Company, P.A. 315 Ellis St. Wichita, KS 67211 P3163237211 P3163237211  
ENGINEERING | SURVEYING | PLANNING | LANDSCAPE ARCHITECTURE

PROJECT NUMBER  
1701 PPS (607861)

DESIGN  
LU

DRAWN  
TMS/

APPROVED  
LU

DATE  
09/06

SCALE  
Noted

SHEET  
3 OF 10

Comotara-Michaelis Wuse/SWS1 05-12-E431