
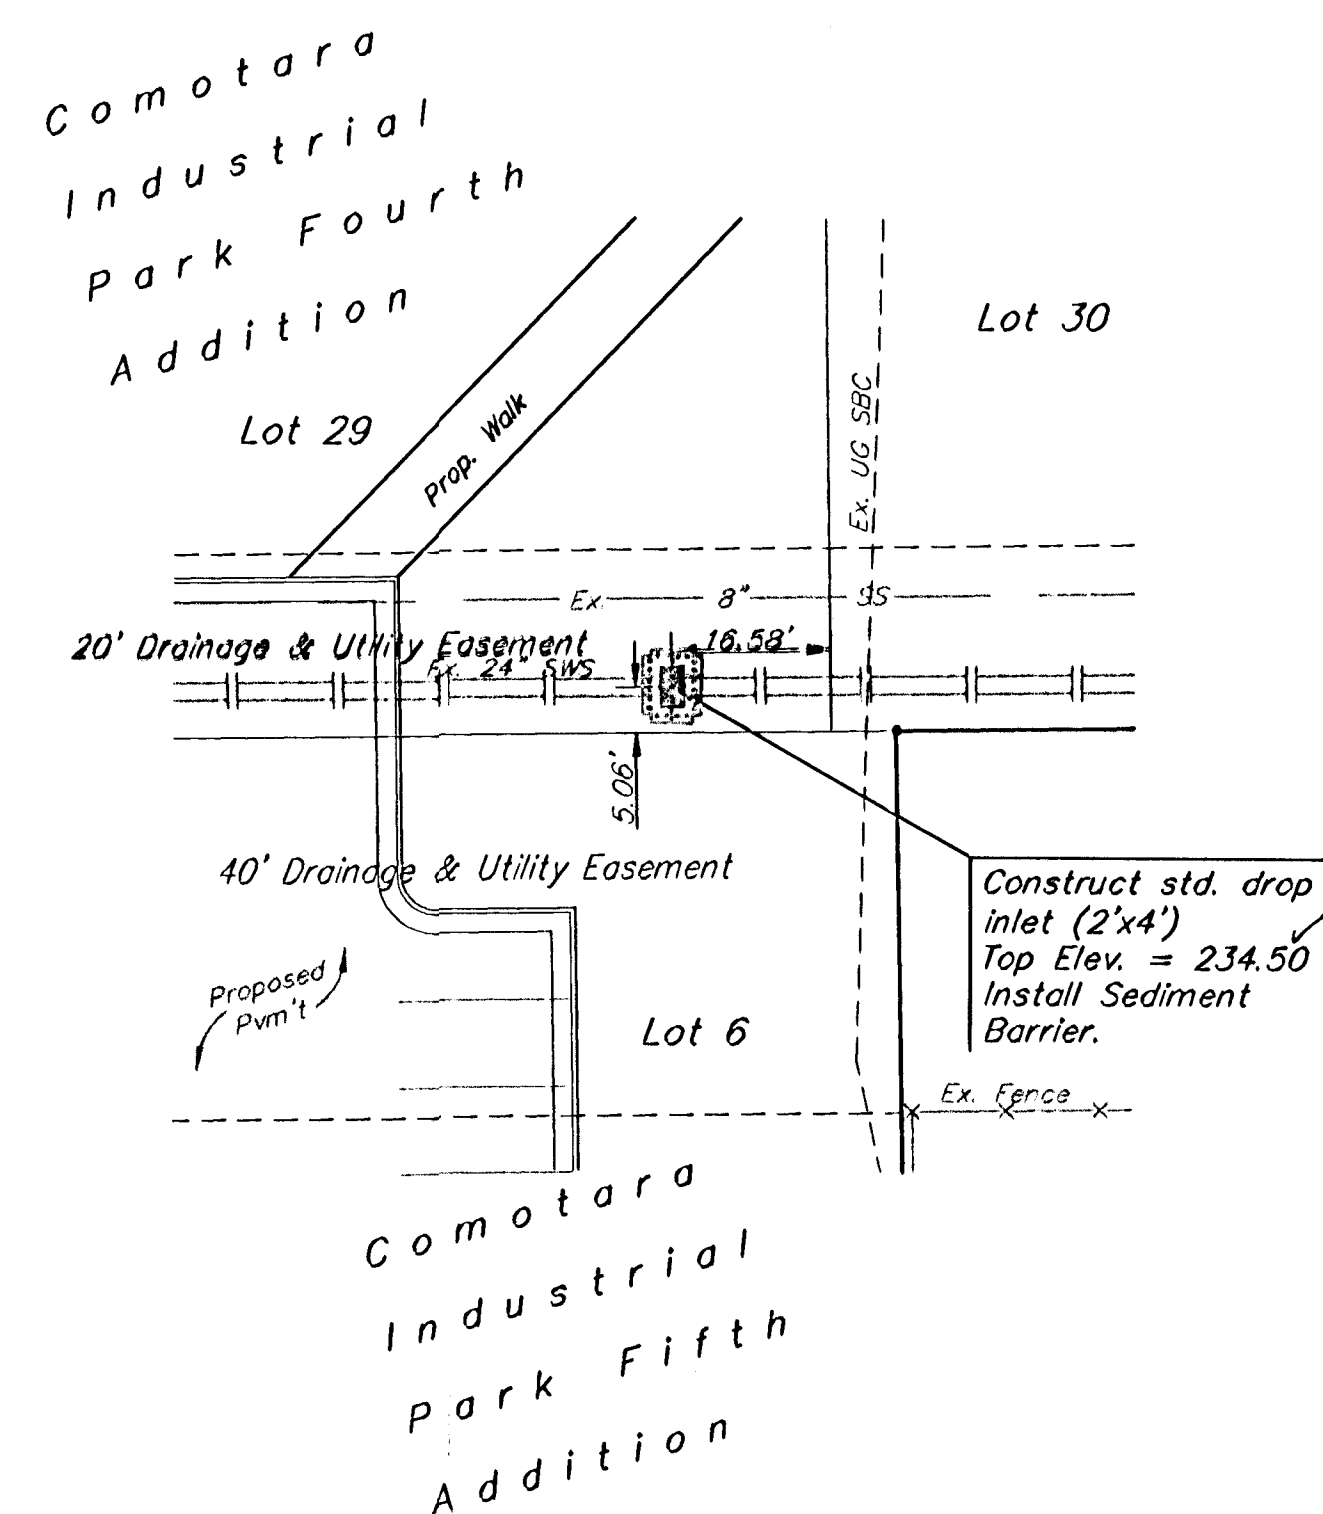


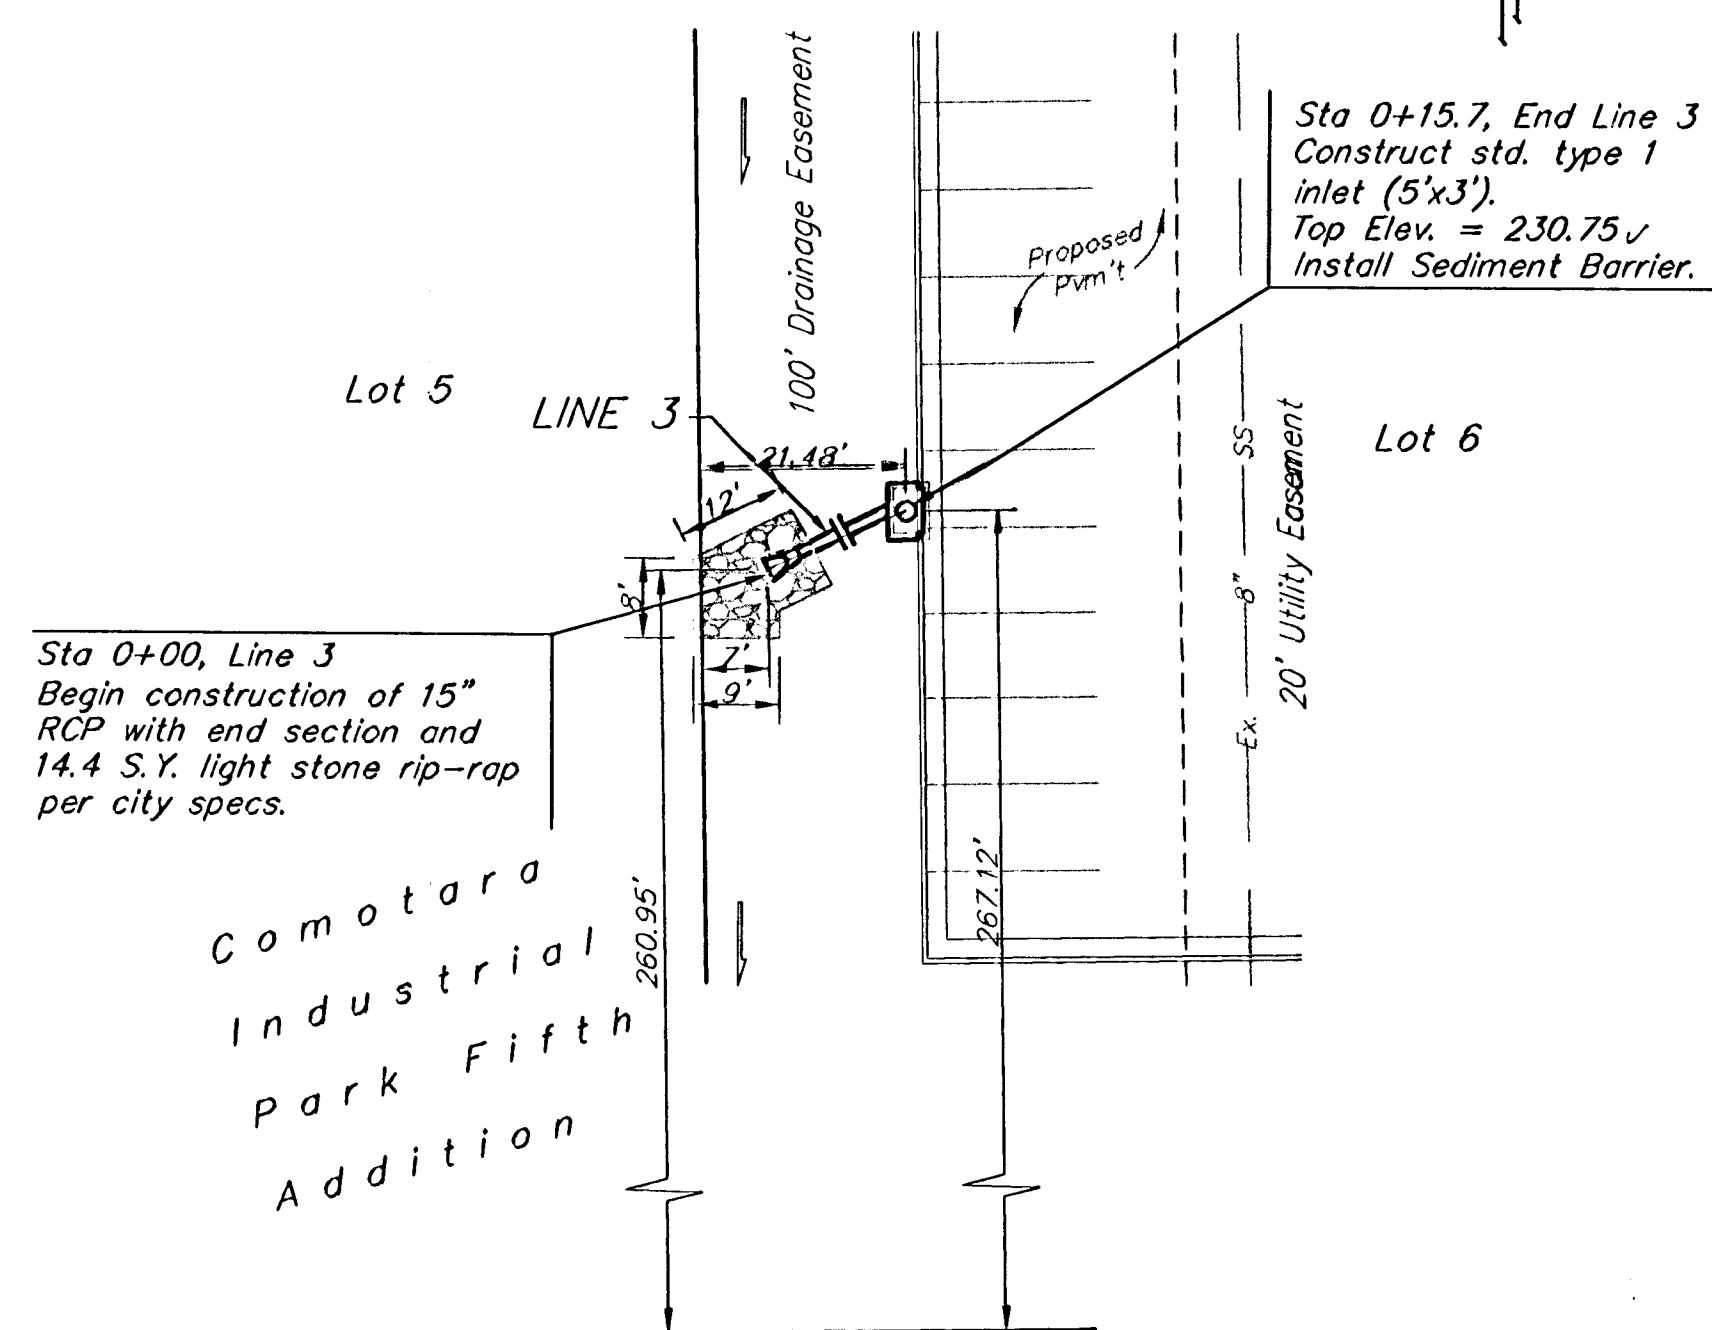

Scale: 1" = 20' Horizontal
1" = 5' Vertical
• = Iron

BENCHMARK:

#1 City of Wichita Bench
Mark at Webb Road and 37th
Street North, Northwest corner
of intersection. 53.00 Ft.
North of center line and 38.00
Ft. West of center line.
Elev. = 1414.92 M.S.L.
Elev. = 227.52 City Datum

#2 Railroad Spike Set In The
South Face of Power Pole,
80.60' West and 7.13 North of
Northwest Corner of Lot 6,
Comotara Industrial Park 4th
Addition, Wichita, Sedgwick
County, Kansas.
Elev. = 1424.69 M.S.L.
Elev. = 237.29 City Datum

