


BENCHMARK:

#1 City of Wichita Bench Mark at Webb Road and 37th Street North, Northwest corner of intersection. 53.00 Ft. North of center line and 38.00 Ft. West of center line.
Elev. = 1414.92 M.S.L.
Elev. = 227.52 City Datum



#2 Railroad Spike Set In The South Face of Power Pole, 80.60' West and 7.13' North of Northwest Corner of Lot 6, Comotara Industrial Park 4th Addition, Wichita, Sedgwick County, Kansas.
Elev. = 1424.69 M.S.L.
Elev. = 237.29 City Datum

Contractor to grade at 1:1 slope around manholes. Cost of dirt, labor, equipment, etc. to be incidental to cost of manhole.

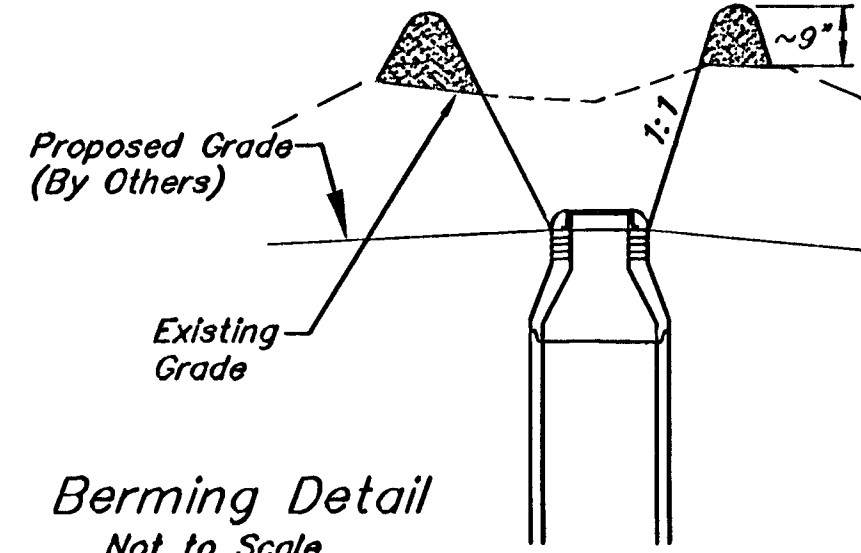

Berming Detail
Not to Scale

Scale: 1" = 20' Horizontal
1" = 5' Vertical
• = Iron

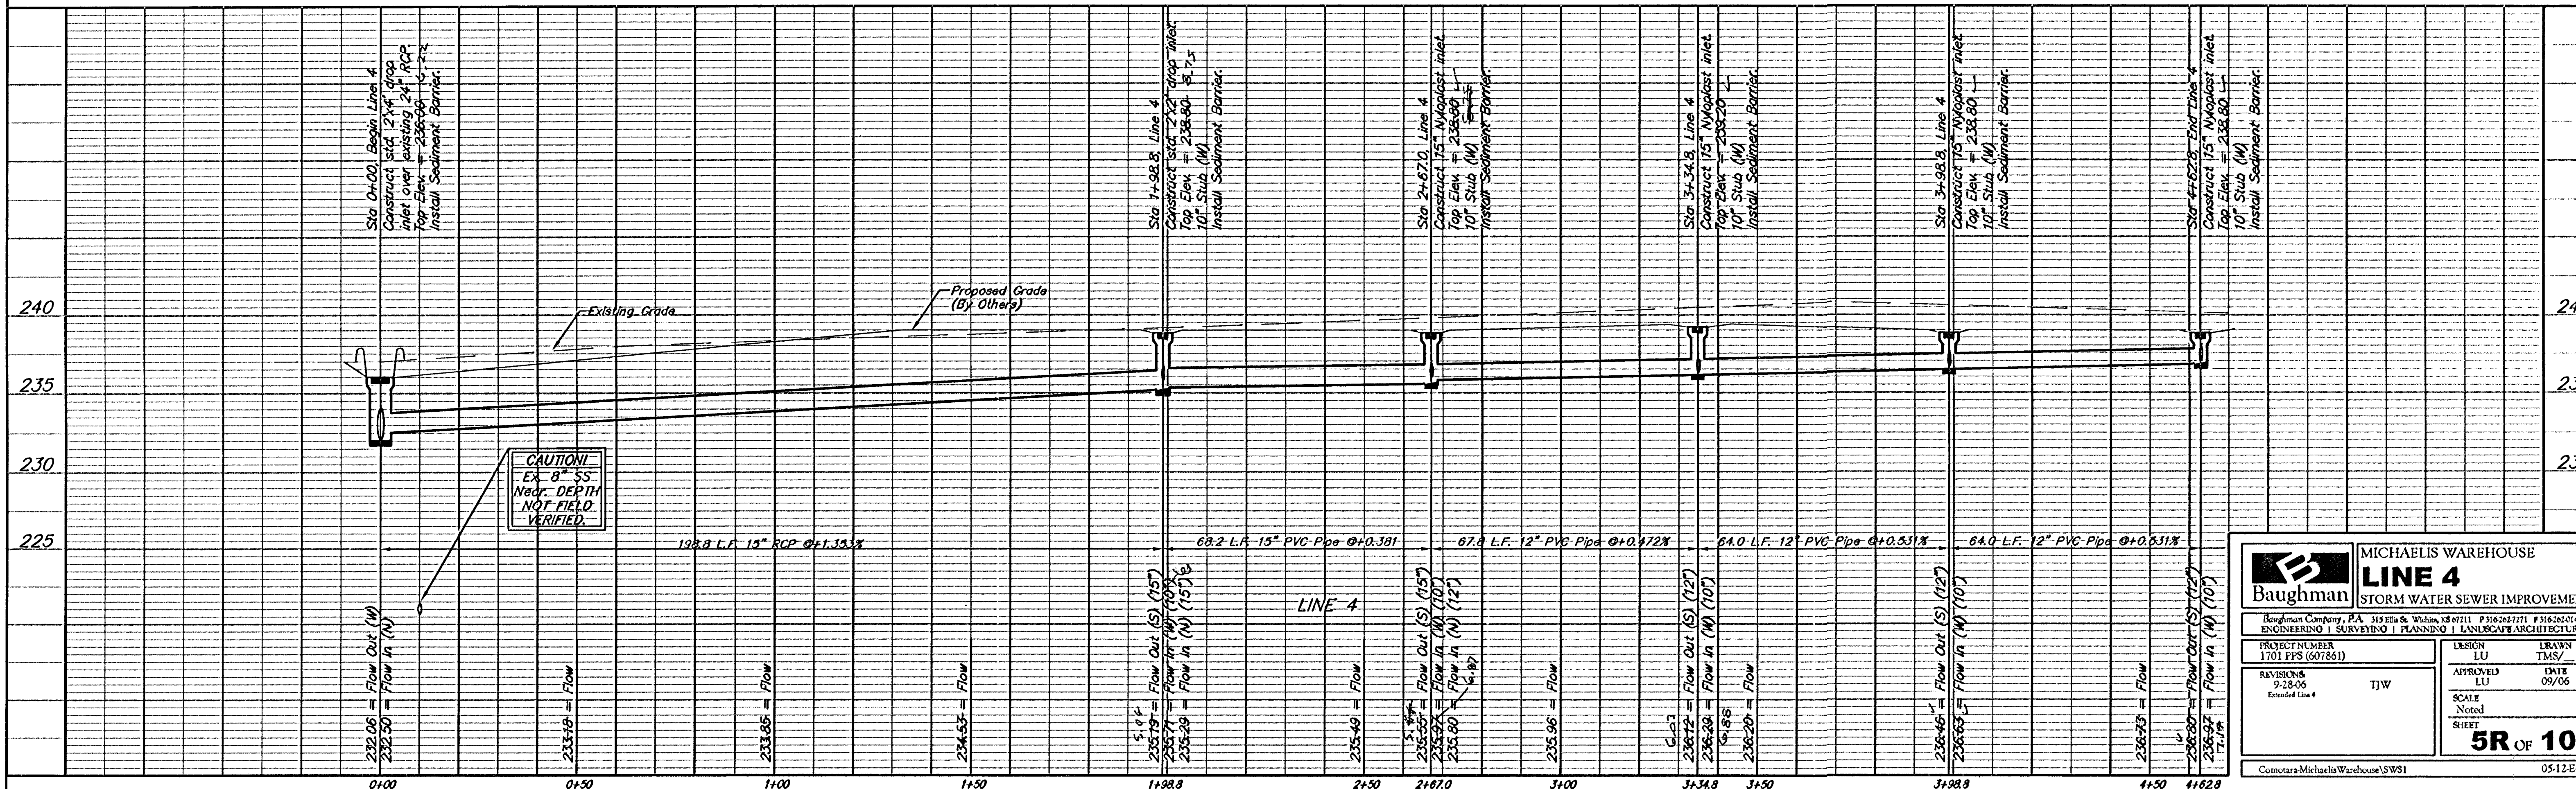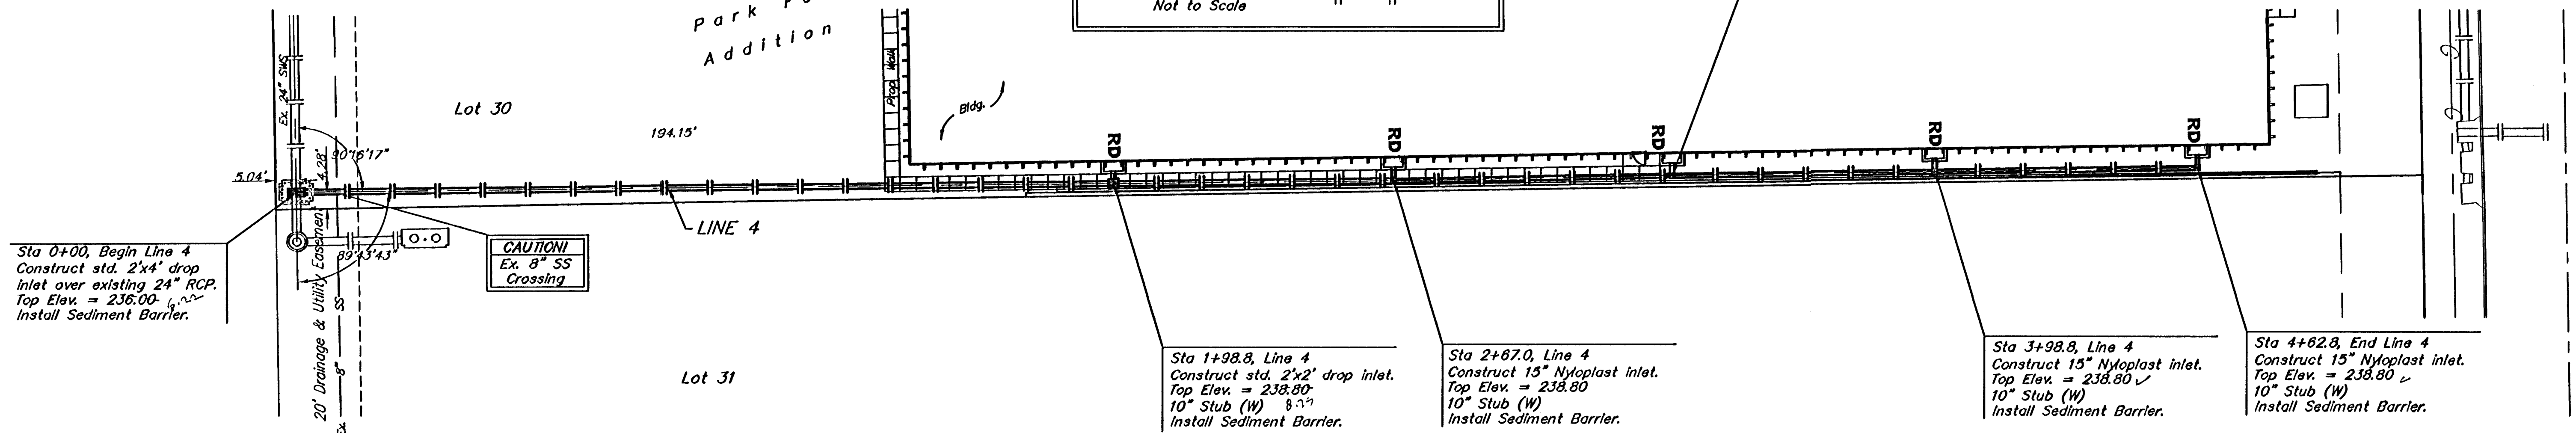

Baughman

PROJECT NUMBER
1701 FPS (607861)

REVISIONS
9-28-06
Extended Line 4

DESIGN
LU

APPROVED
LU

SCALE
Noted
SHEET

DATE
09/06

5R OF 10

MICHAELIS WAREHOUSE

LINE 4

STORM WATER SEWER IMPROVEMENTS

Comotara-MichaelisWarehouse\SW51