
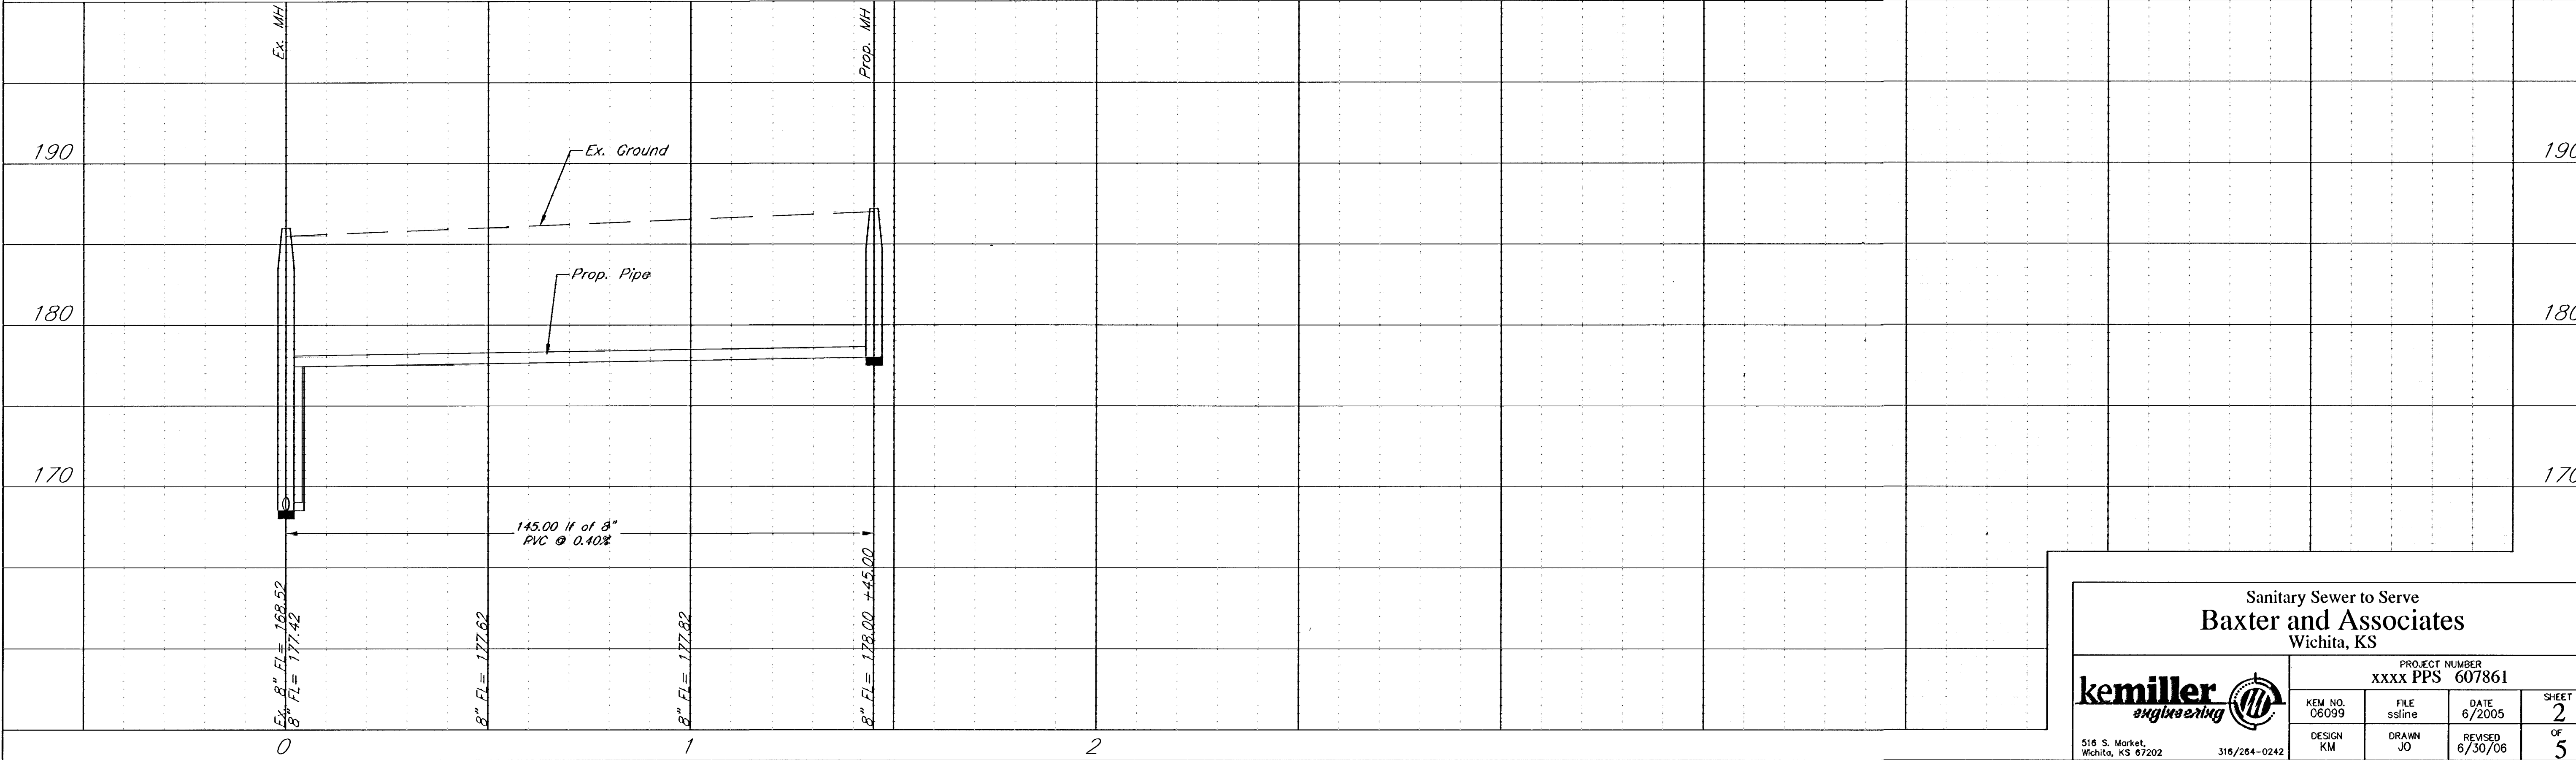


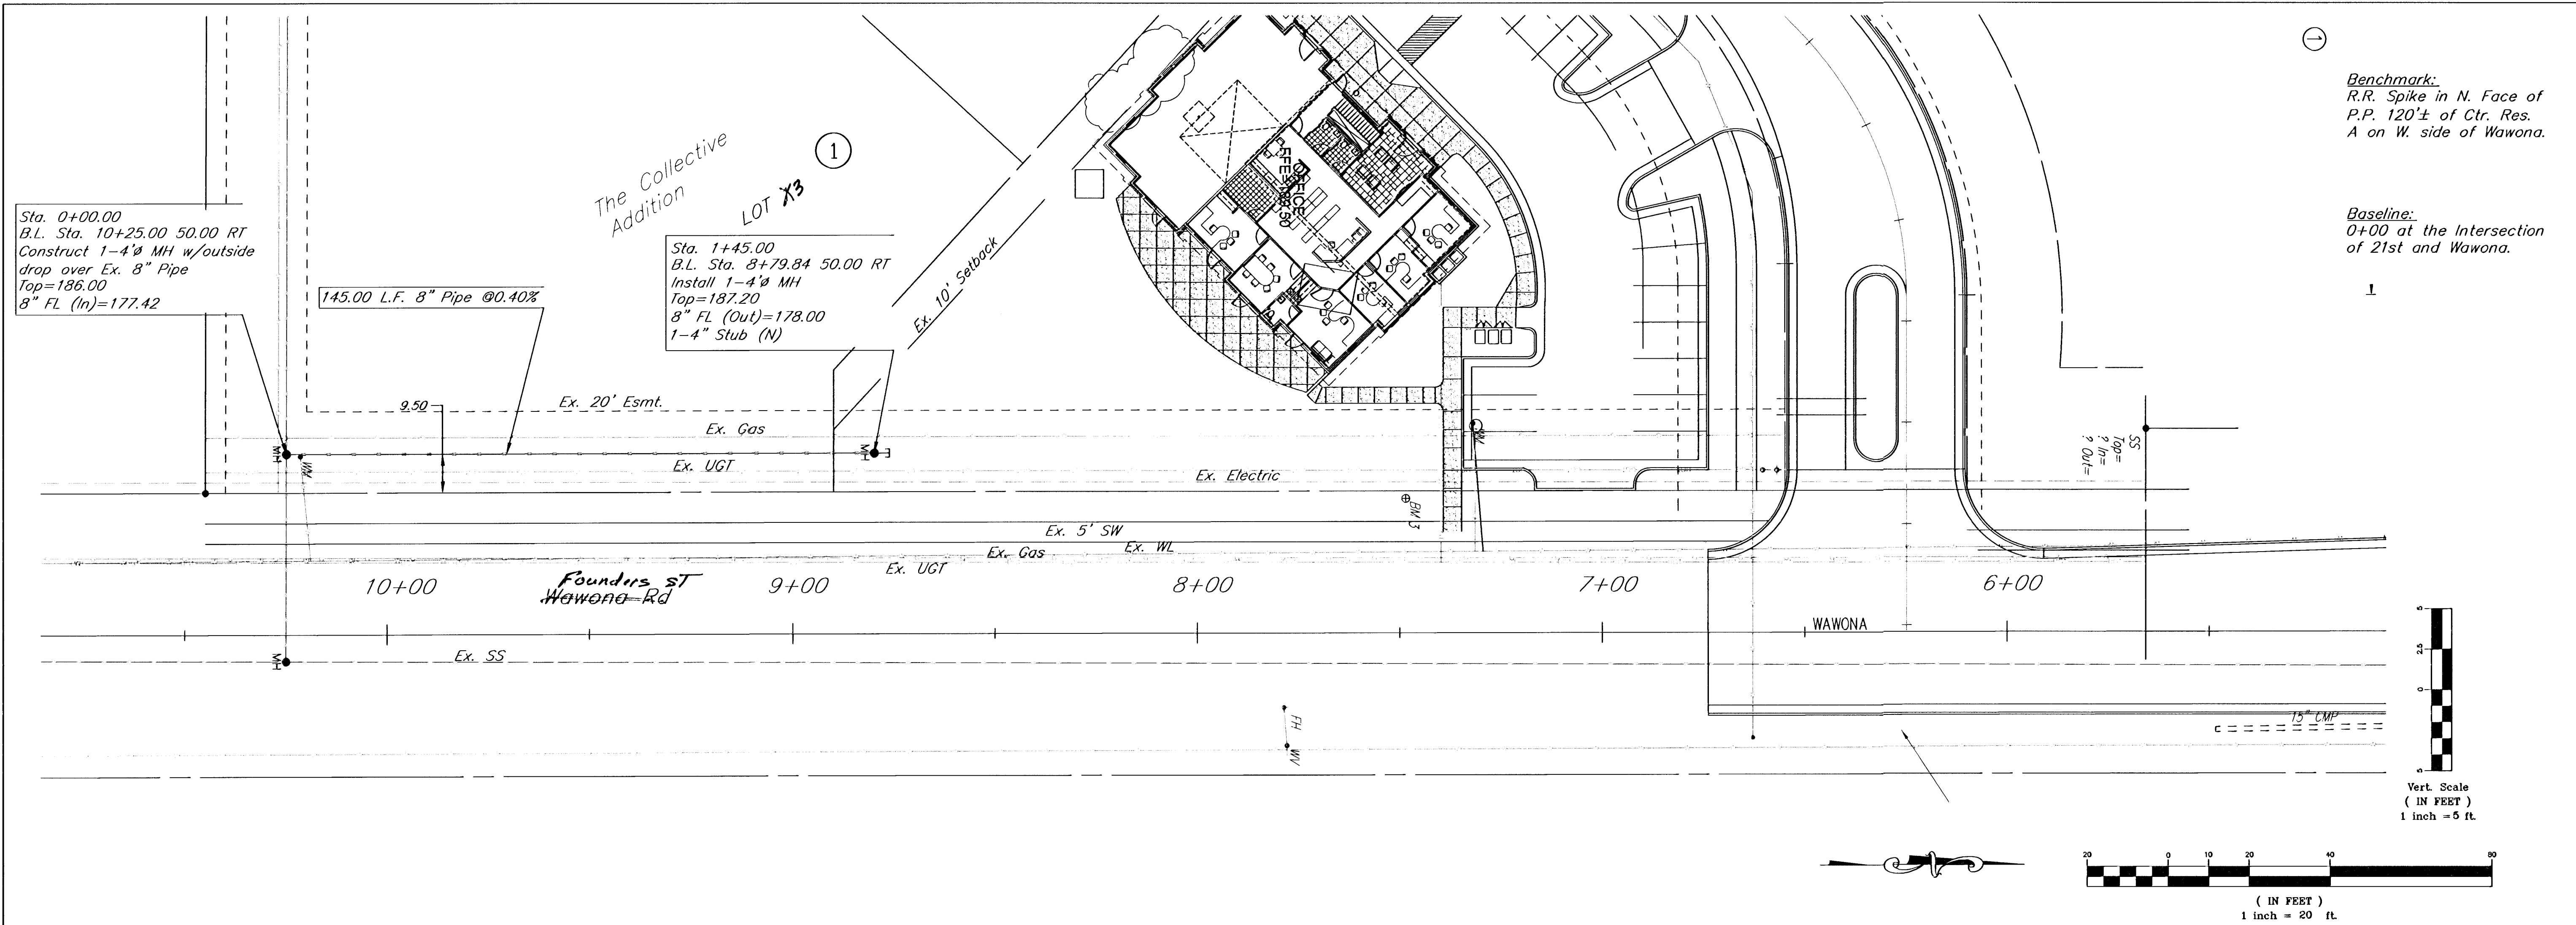

**Sanitary Sewer to Serve
Baxter and Associates
Wichita, KS**

kemiller engineering		PROJECT NUMBER XXXX PPS 607861	
KEM NO. 06099	FILE ssline	DATE 6/2005	SHEET 2
DESIGN KM	DRAWN JO	REVISED 6/30/06	OF 5

516 S. Market,
Wichita, KS 67202

316/284-0242