

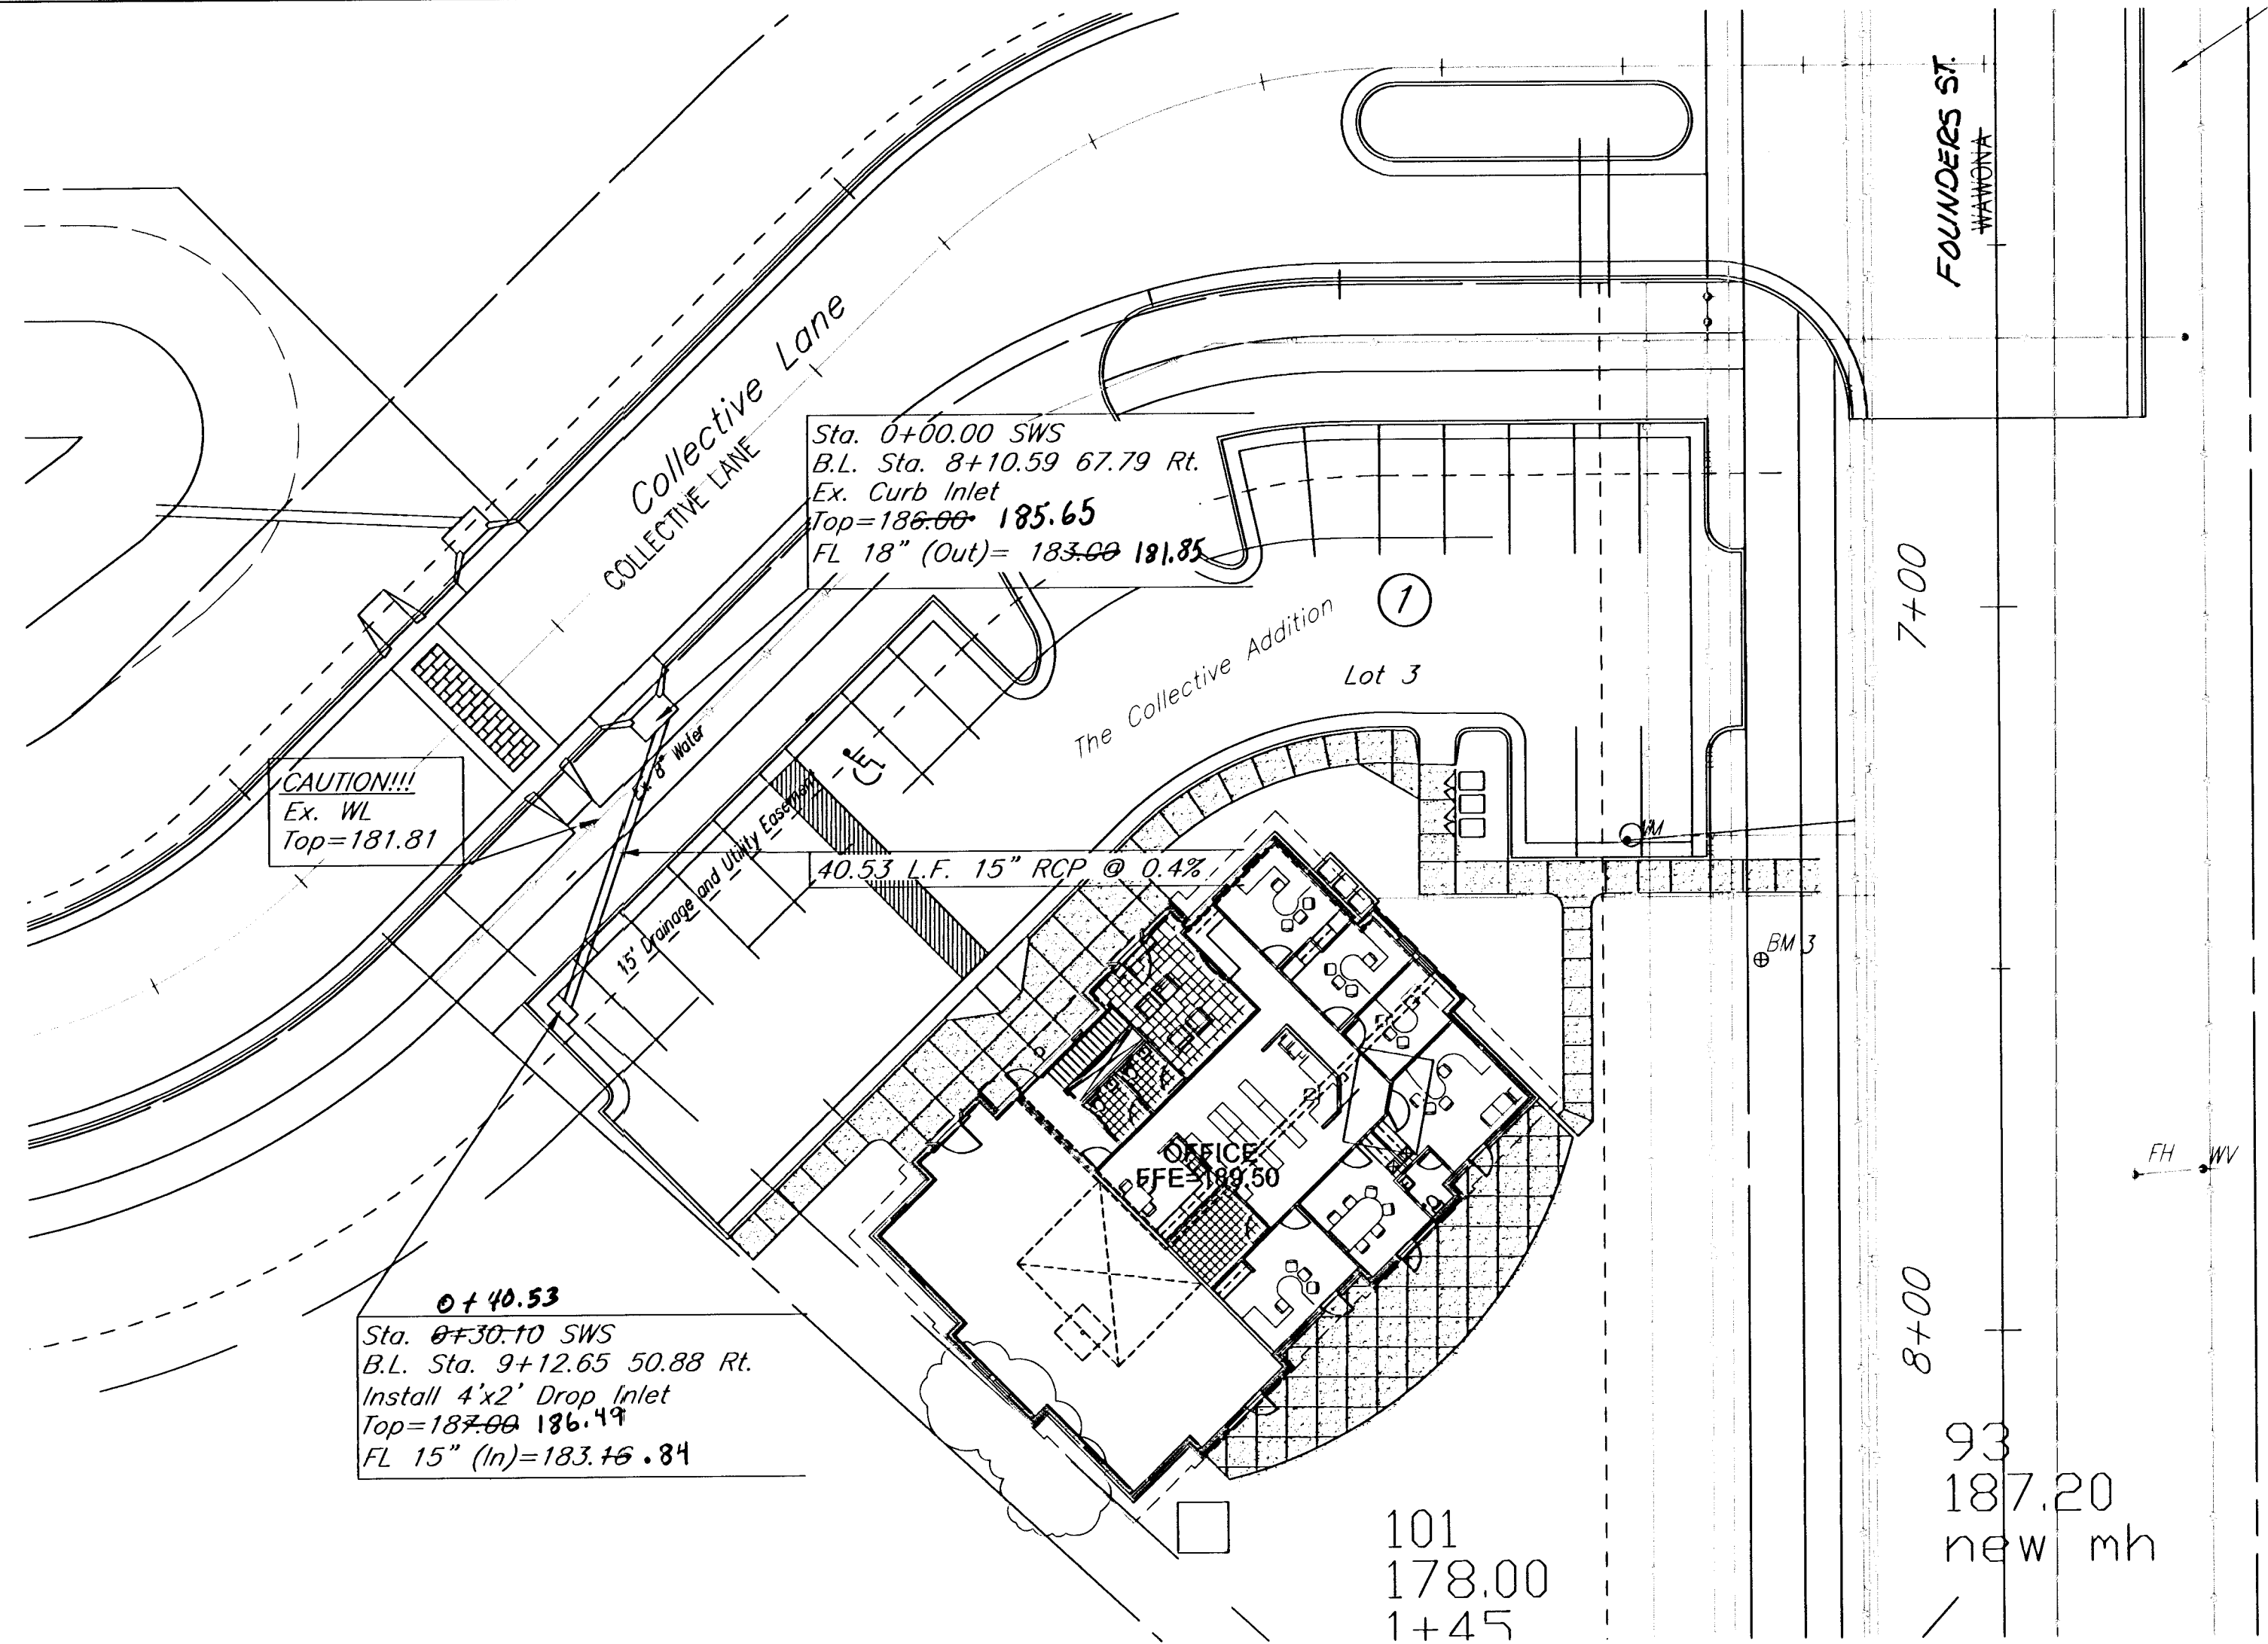


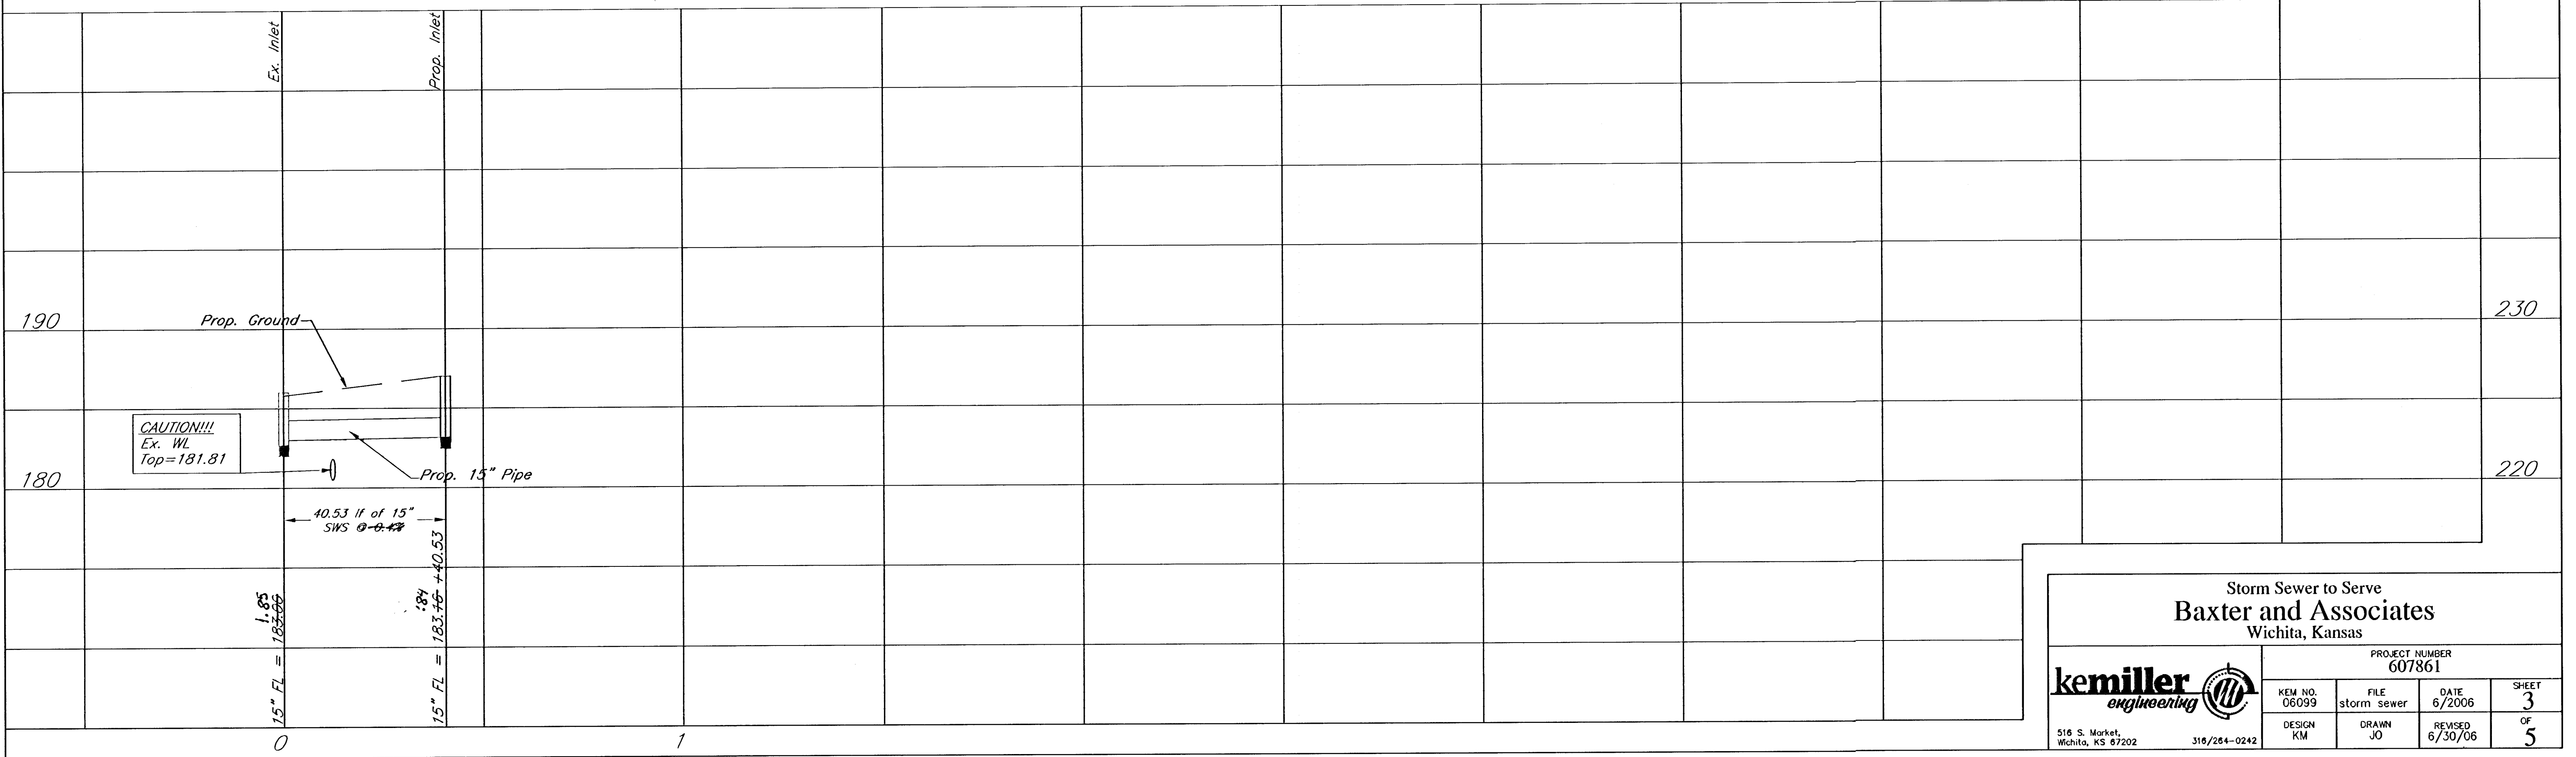

Benchmark:
R.R. Spike in N. Face of
P.P. 120 $\pm$ of Ctr. Res.
A on W. side of Wawona.

Baseline:
0+00 at the Intersection
of 21st and Wawona.

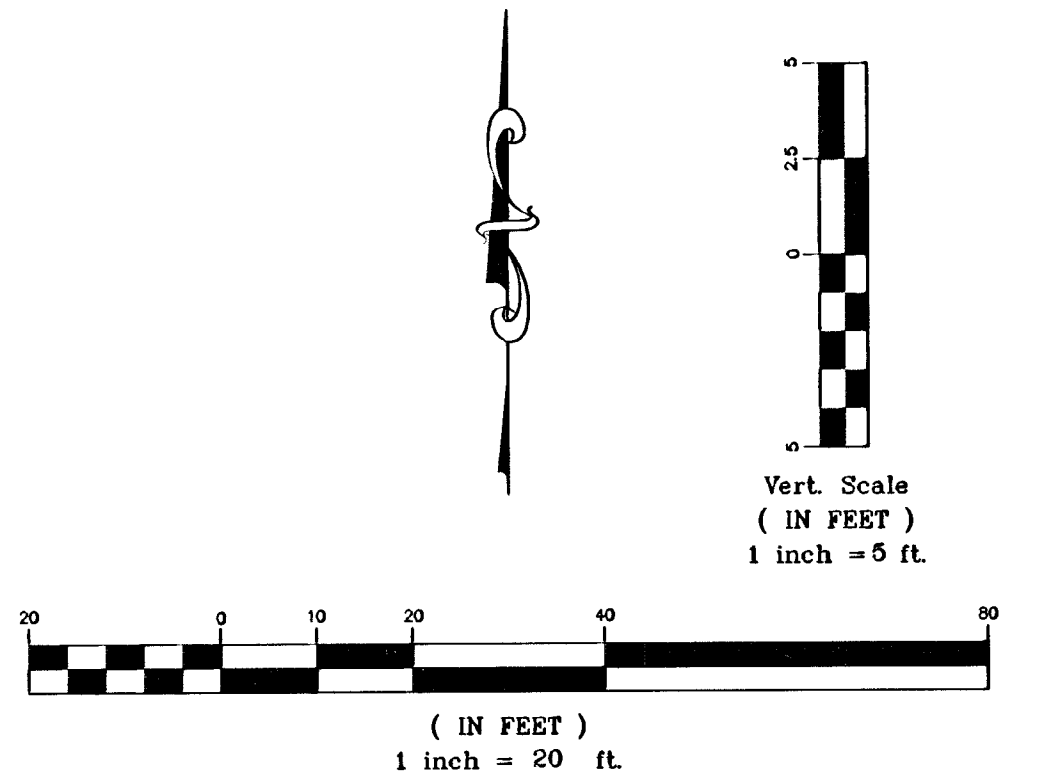

Storm Sewer to Serve Baxter and Associates Wichita, Kansas				
PROJECT NUMBER 607861				
	KEM NO. 06099	FILE storm sewer	DATE 6/2006	SHEET 3
	DESIGN KM	DRAWN JO	REVISED 6/30/06	OF 5
516 S. Market, Wichita, KS 67202		316/264-0242		