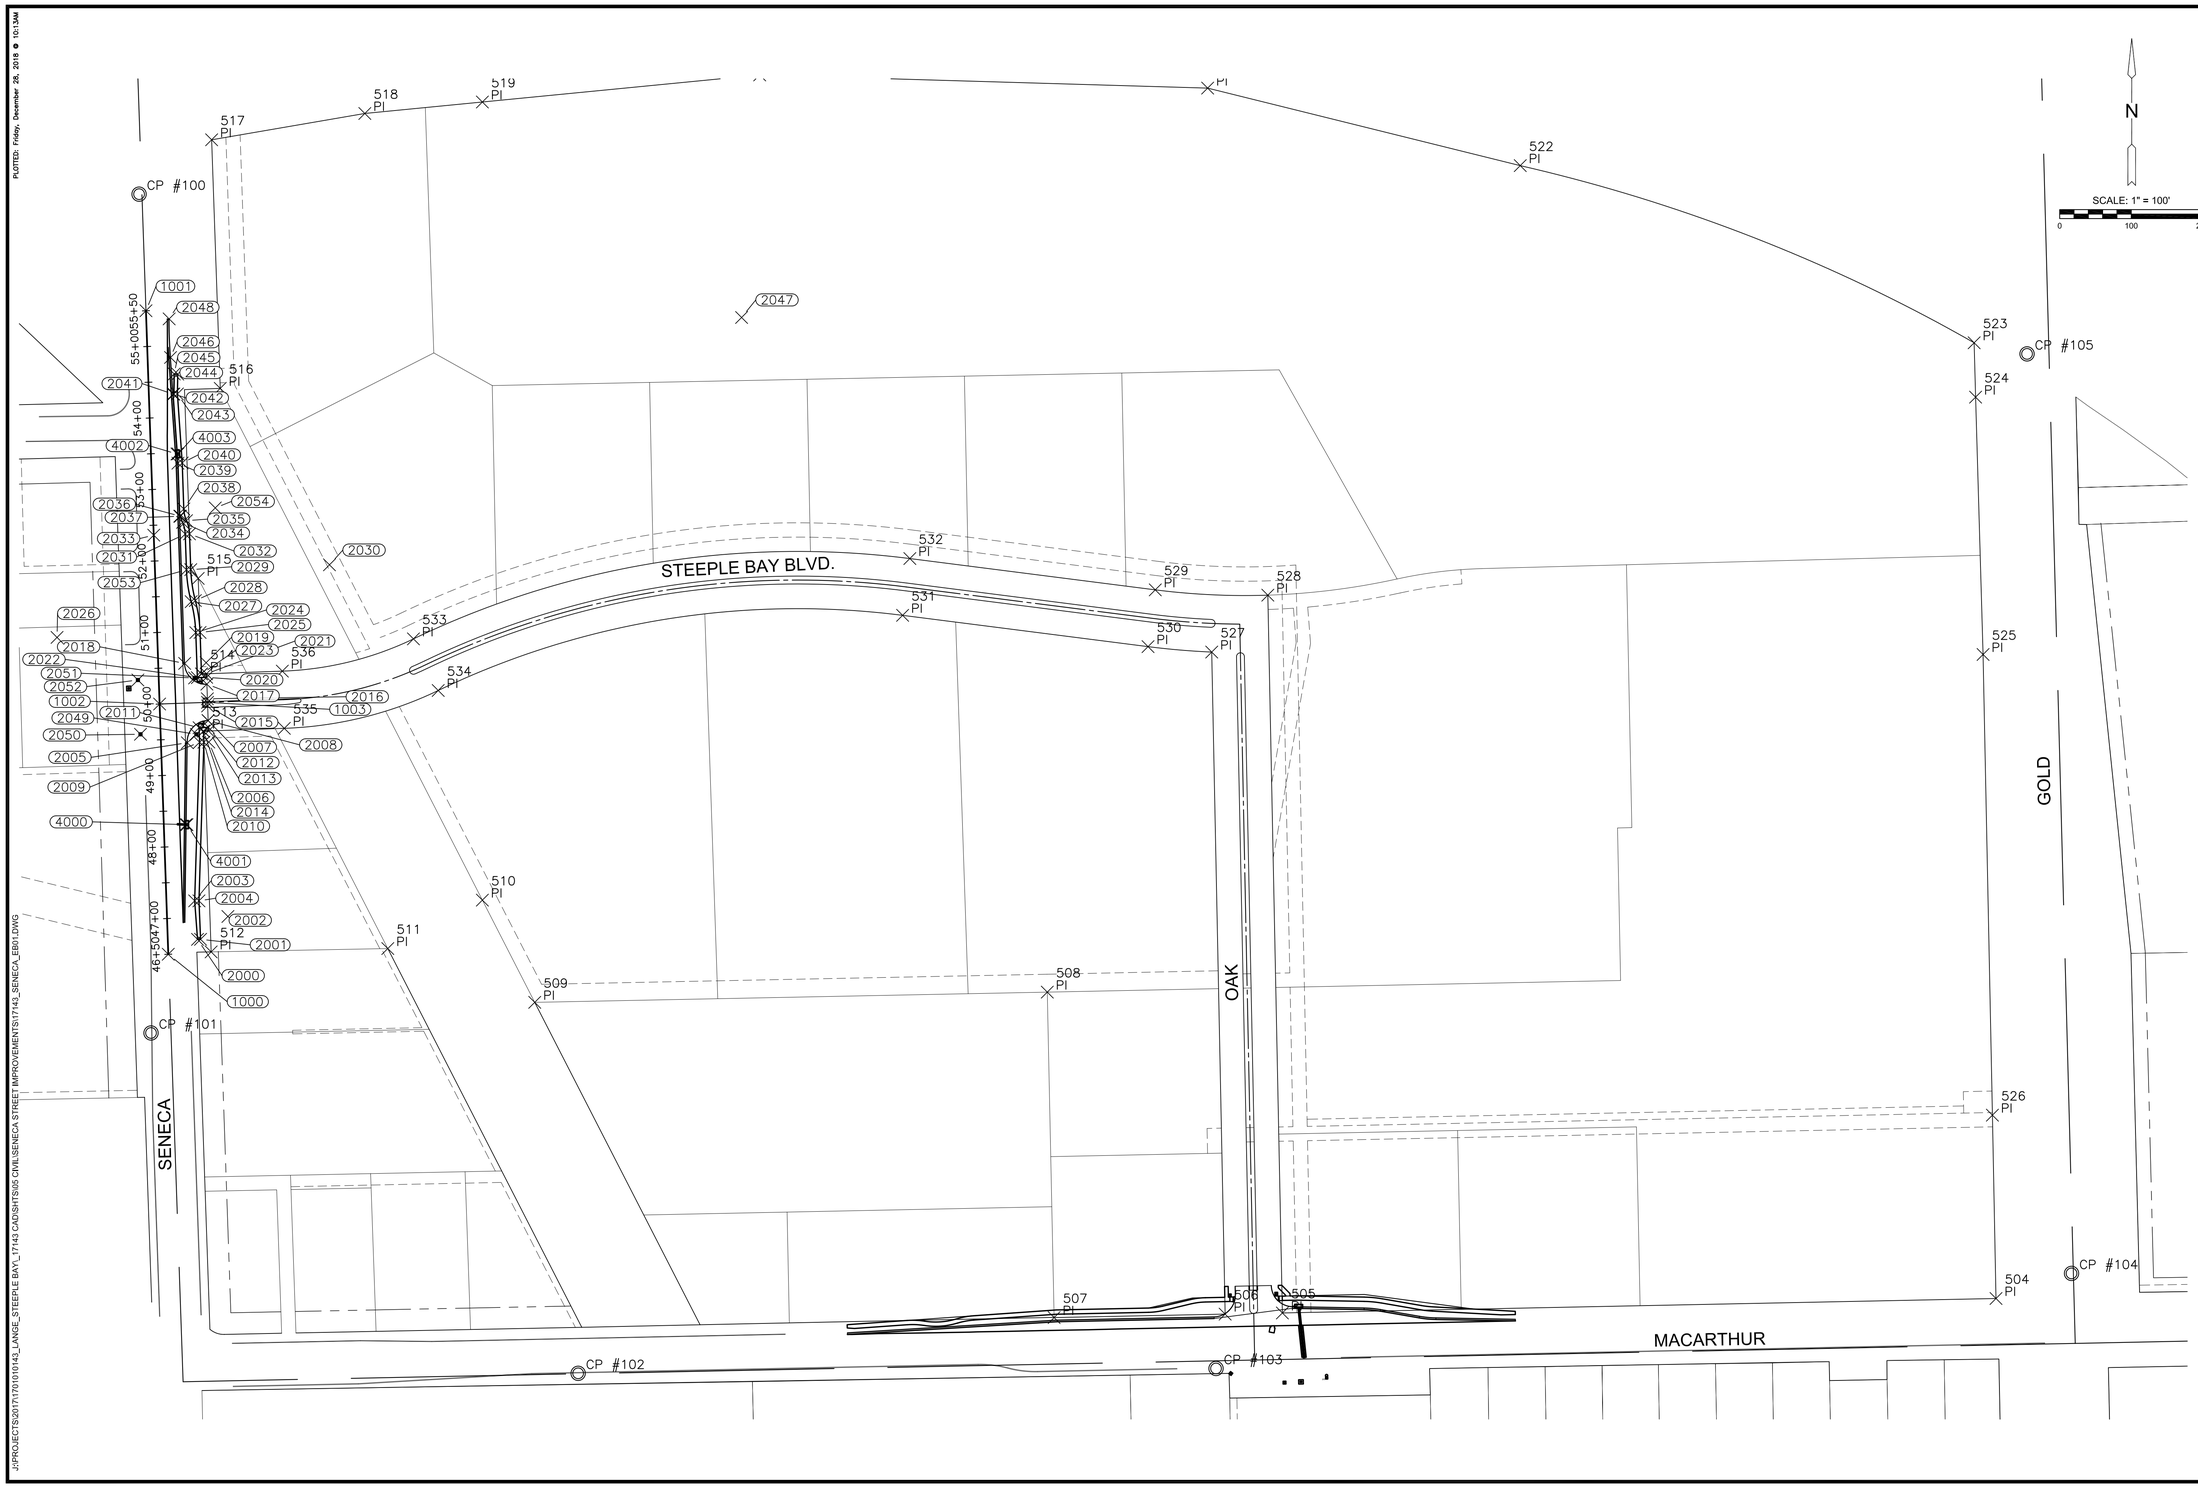


MKEC
Wichita, KS • 316-684-9600

SENECA STREET IMPROVEMENTS FOR

# STEEPLE BAY ADDITION

WICHITA, KANSAS

©2018
MKEC Engineering
All Rights Reserved
www.mkec.com
These drawings and their contents, including, but not limited to, all concepts, designs, & ideas are the exclusive property of MKEC Engineering (MKEC), and may not be used or reproduced in any way without the express consent of MKEC.

BUBBLE MAP

| | |
|---|---|
| PROJECT NO. | 472-85451 |
| DATE | 1/02/19 |
| SCALE | #"=#' |

| DESIGNED | DRAWN | CHECKED |
|---|---|---|
| XXX | XXX | XXX |

| NO. | REVISION | DATE |
|---|---|---|
| | | |

SHEET NO.

14 OF 37

PLOTTED: Friday, December 28, 2018 @ 10:13AM

J:\PROJECTS\2017\170101\43_LANGE_STEEPLE BAY_17143 CAD\SHTS\05 CIVIL\SENECA STREET IMPROVEMENTS\17143_SENECA_EB01.DWG