

PLOTTED: Wednesday, January 23, 2019 @ 01:28PM

J:\PROJECTS\2017\17010143_LANGE_STEEPLE BAY_17143_CADD\SHS\08_ELECTRICAL LIGHTING\2-03_ELECTRICAL PLANS.DWG



PART A: LIGHTING & LANDSCAPE PLANS FOR
STEEPLE BAY ADDITION
WICHITA, KANSAS



©2019 MKEC Engineering All Rights Reserved
www.mkec.com
These drawings and their contents, including, but not limited to, all concepts, designs, & ideas are the exclusive property of MKEC Engineering (MKEC), and may not be used or reproduced in any way without the express consent of MKEC.


ELECTRICAL PLANS

PROJECT NO.	472-85453	
DATE	DEC 2018	
SCALE	1"=40'-0"	
DESIGNED	DRAWN	CHECKED
CNG	ECW	JRBW

NO.	REVISION	DATE
1	REVISION 1	01/23/19

SHEET NO.
03 OF 07

- KEYED NOTES**
- PROVIDE AND INSTALL POLE BASE PER DETAIL 2/05.
 - ROUTE (2) 120V FEEDERS FROM PANEL 'B' TO SIGNAGE LOCATION. ROUTE EACH FEEDER WITH (2)-#12, (1)-#12 IN 1" C. PROVIDE FINAL CONNECTION TO SIGN. COORDINATE WITH SIGN VENDOR.
- FEEDER SCHEDULE**
- (A) (3)-#10, (1)-#10 GND IN 1" C. FOR ENTIRE CIRCUIT. CONDUCTORS UPSIZED FOR VOLTAGE DROP.

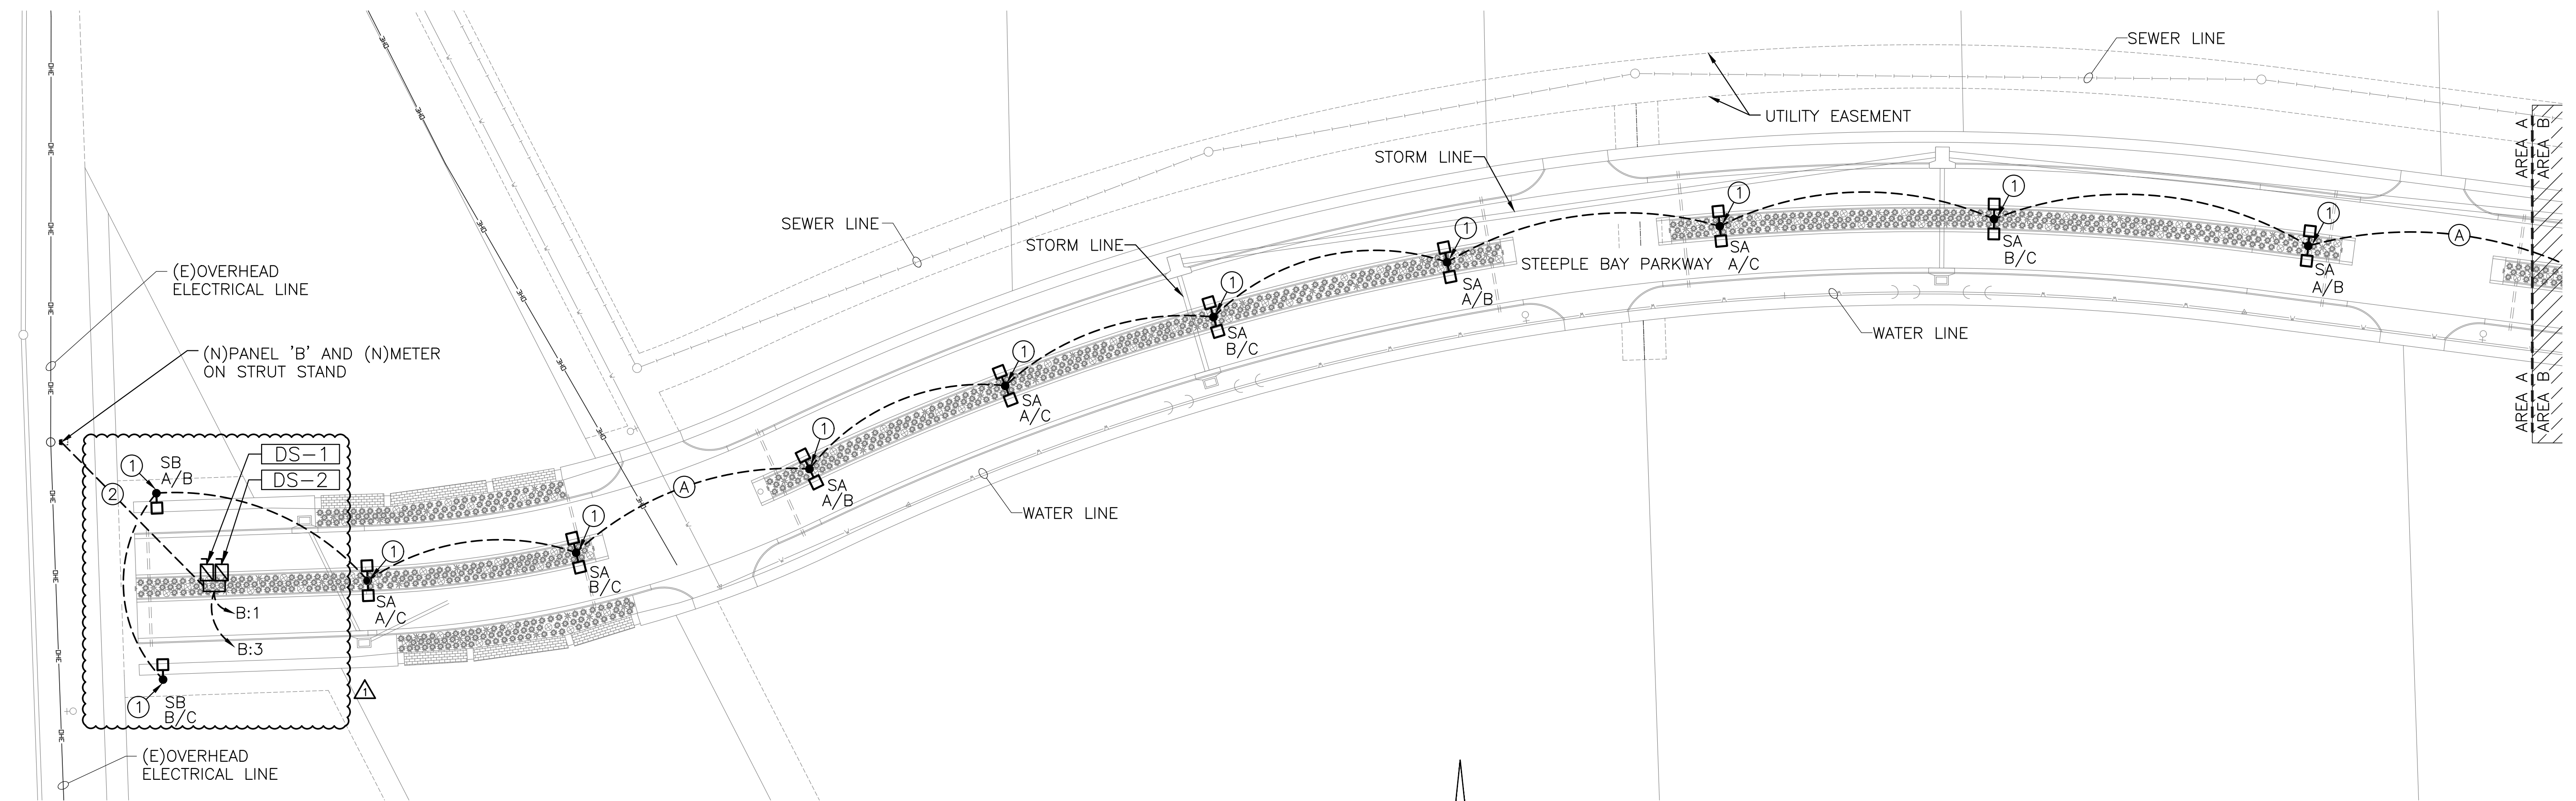

ELECTRICAL PLAN - AREA A
SCALE: 1"=40'
0 40 80

