



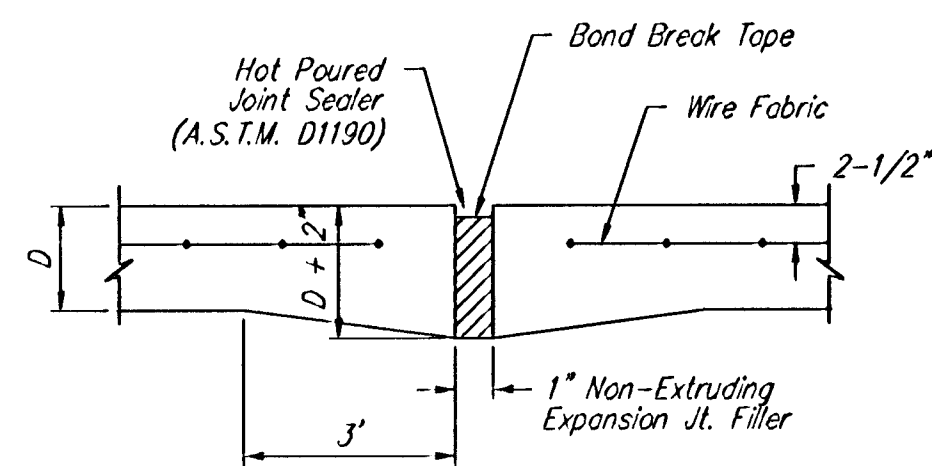


EXPANSION JOINT


NOTE: Extra Thickness to be Subsidiary to Price of Square Yards Pavement

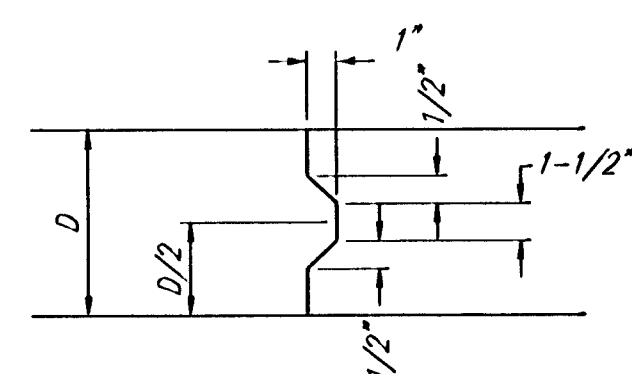


KEYWAY DETAIL

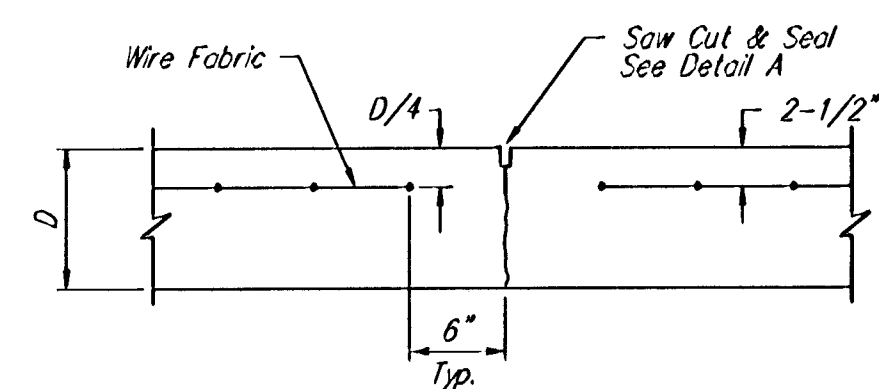


CONTRACTION JOINT DETAIL (C.J.)

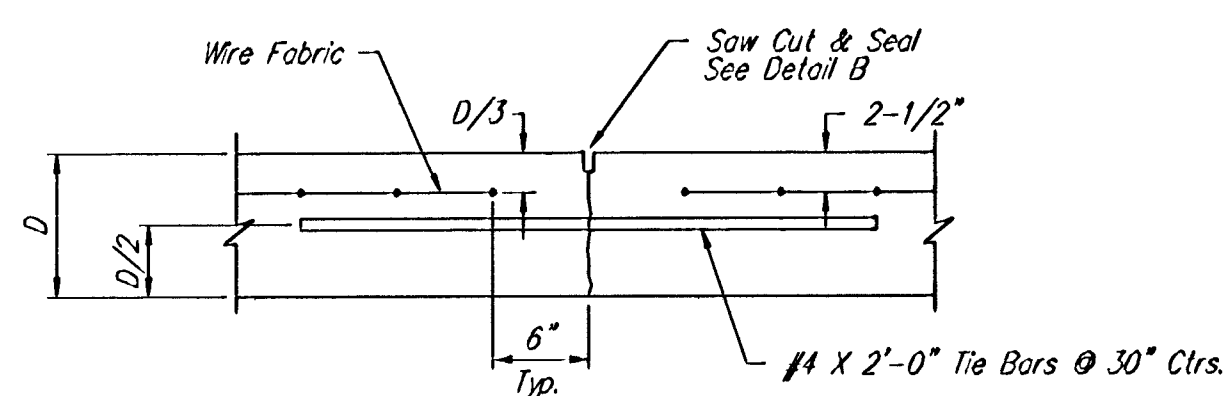

LONGITUDINAL JOINT DETAIL (L.J.)

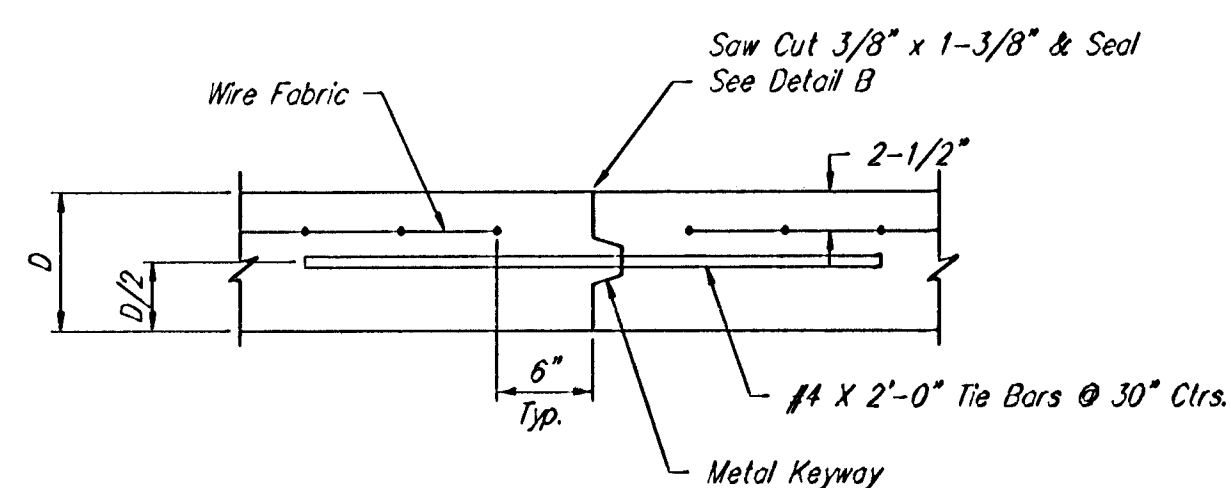


OPTIONAL LONGITUDINAL JOINT DETAIL (L.J.) (CONSTRUCTION JOINT)

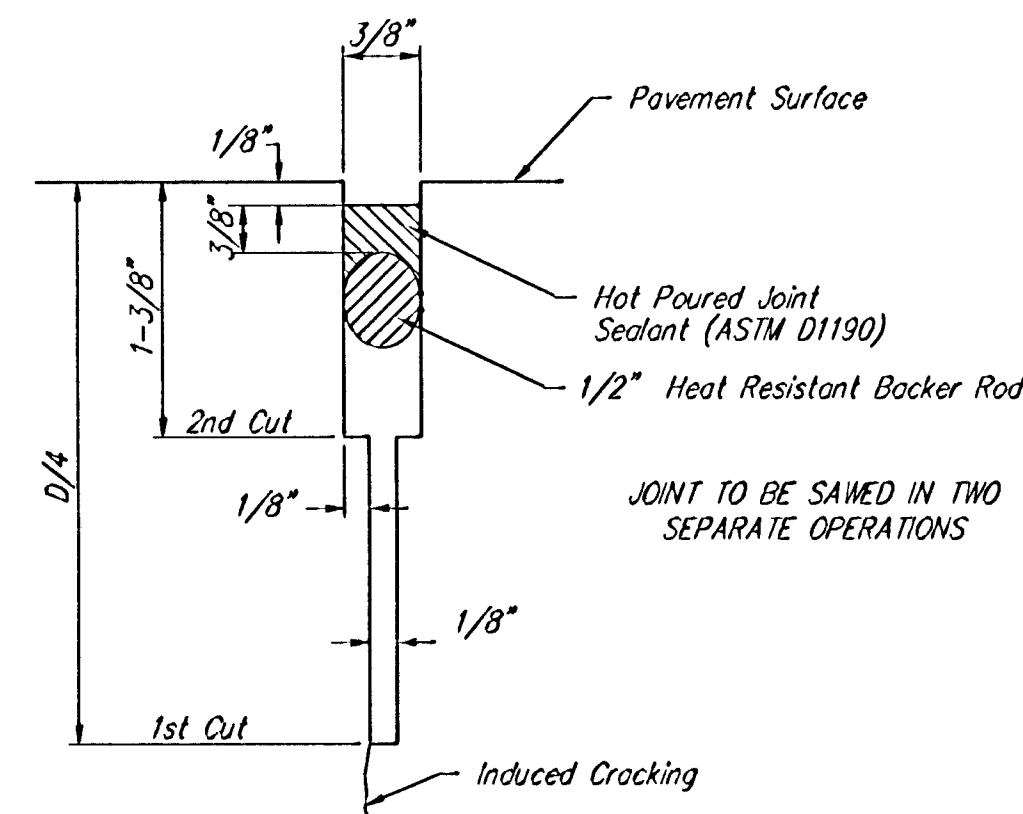


SAW JOINT DETAIL "A"


NOTE: 6" X 12" W4XW4 Wire Fabric Reinforcing Shall Be Placed So That The Wires With The 6" Spacing Will Run Parallel With The Longitudinal Joints.

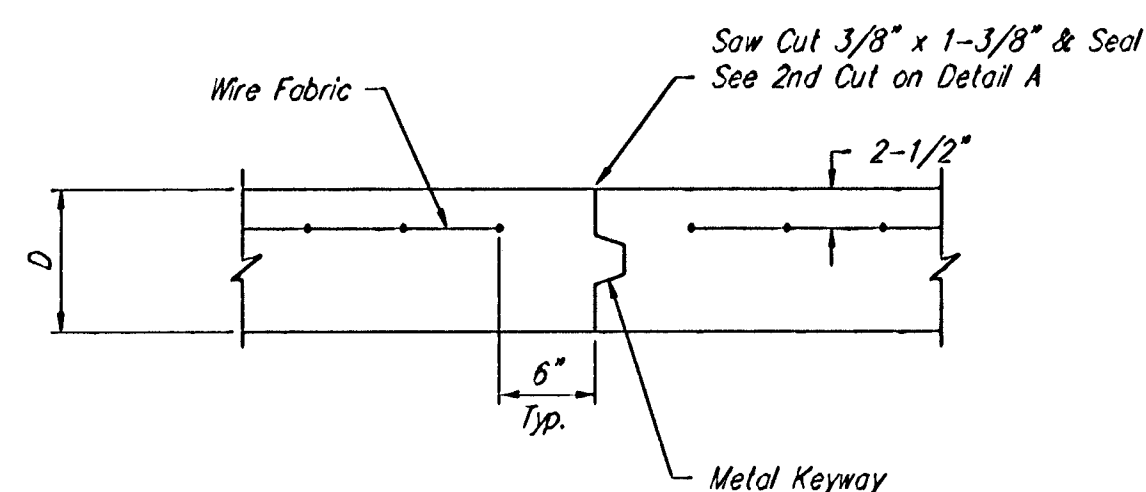



OPTIONAL CONTRACTION JOINT (CONSTRUCTION JOINT)

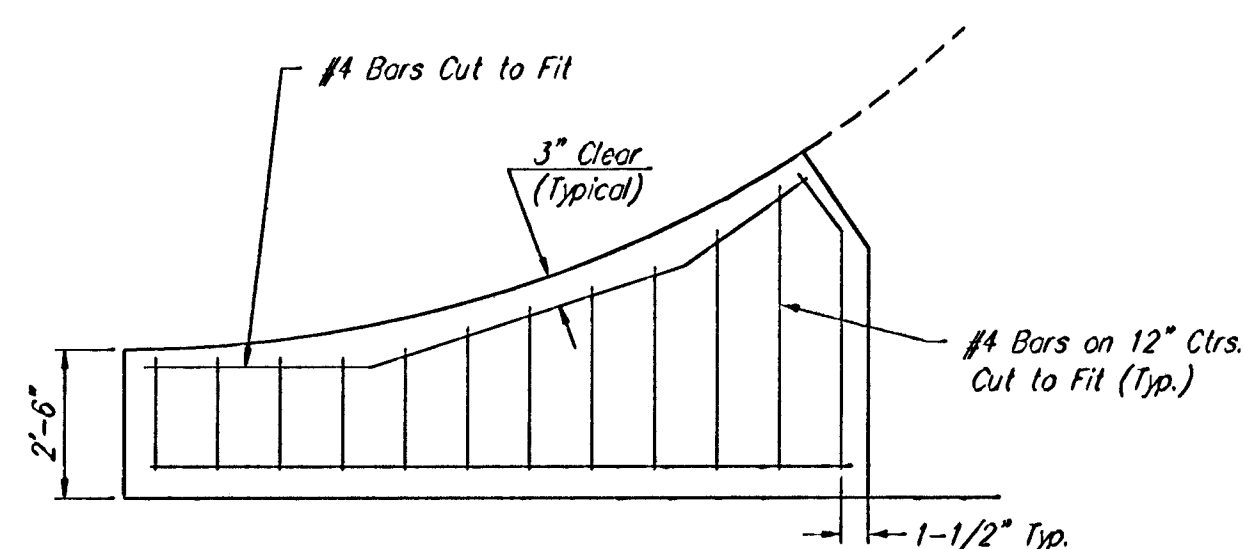

WING REINFORCING DETAIL

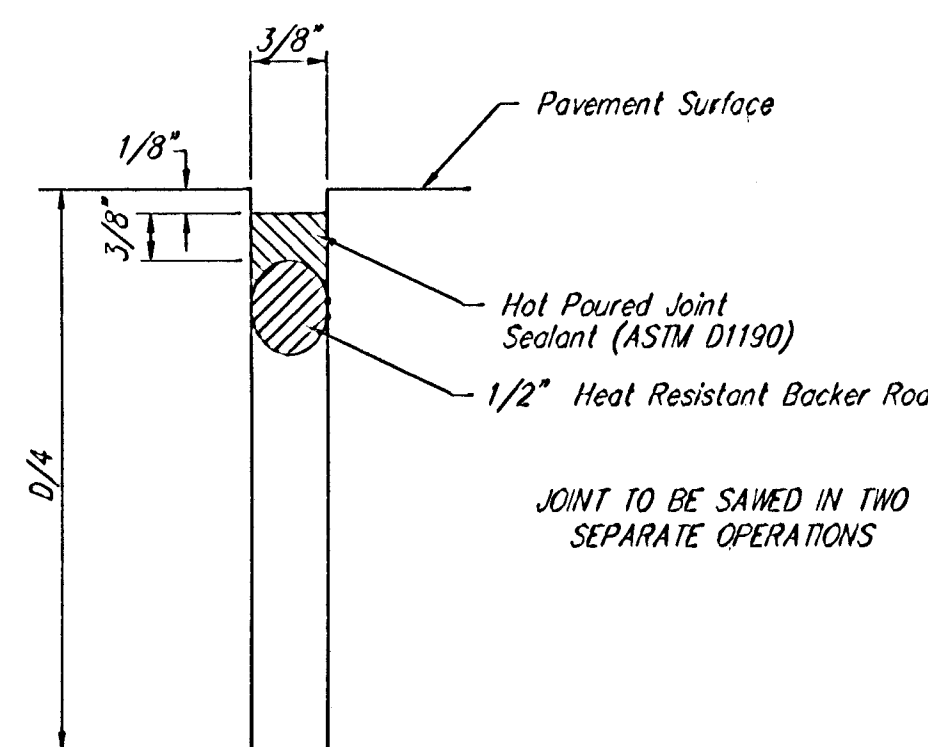

SAW JOINT DETAIL "B"

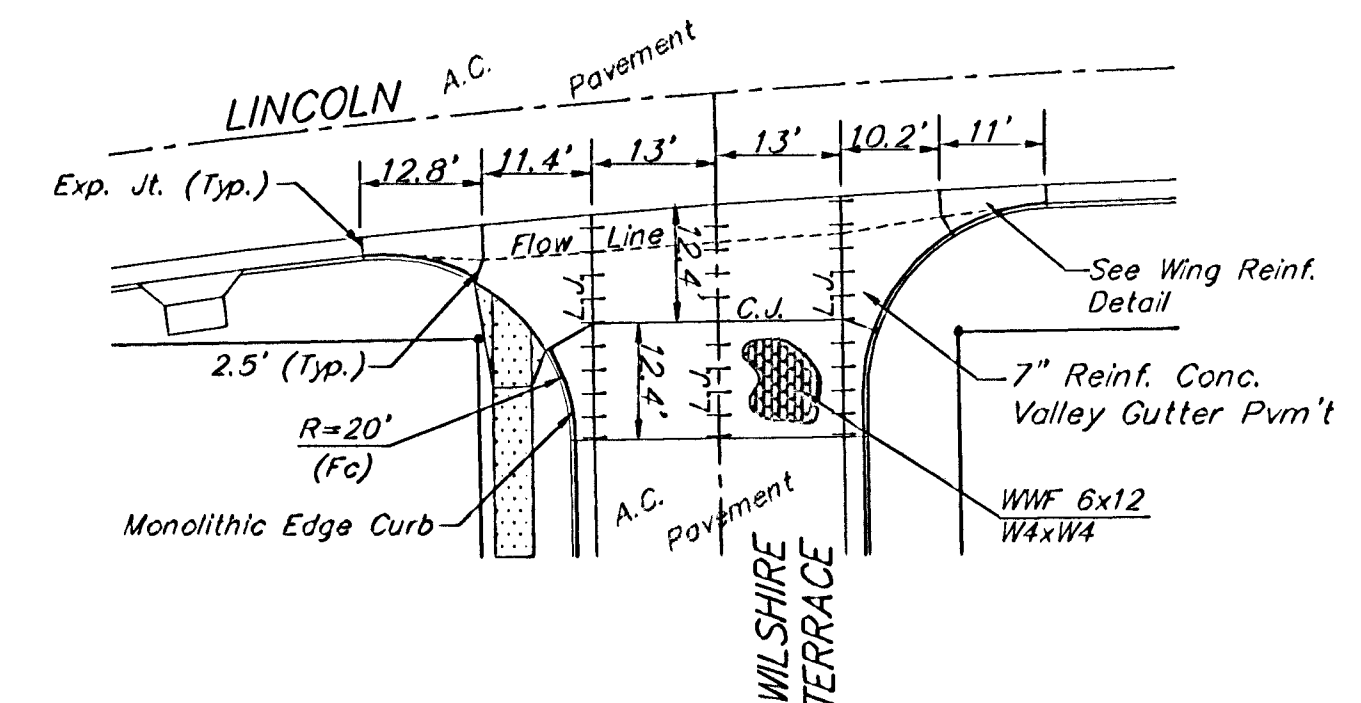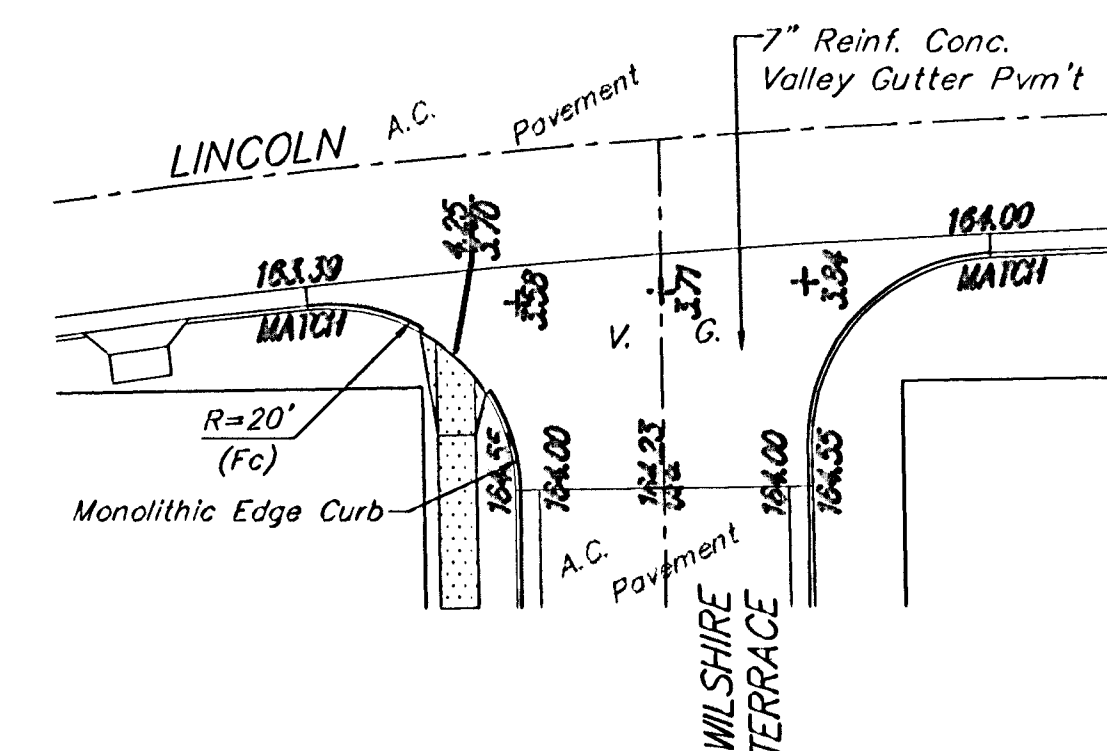

Scale: 1" = 20'

VALLEY GUTTER DETAILS					
BAUGHMAN COMPANY P.A.					
ENGINEERING, SURVEYING, & PLANNING					
318-262-7271 • 318 ELLIS • WICHITA, KANSAS 67211					
PROJECT NUMBER 472-63797					
DESIGN STAFF	DRAWN STAFF	APPROVED	DATE 06-03	SCALE NONE	SHEET 4 OF 13