

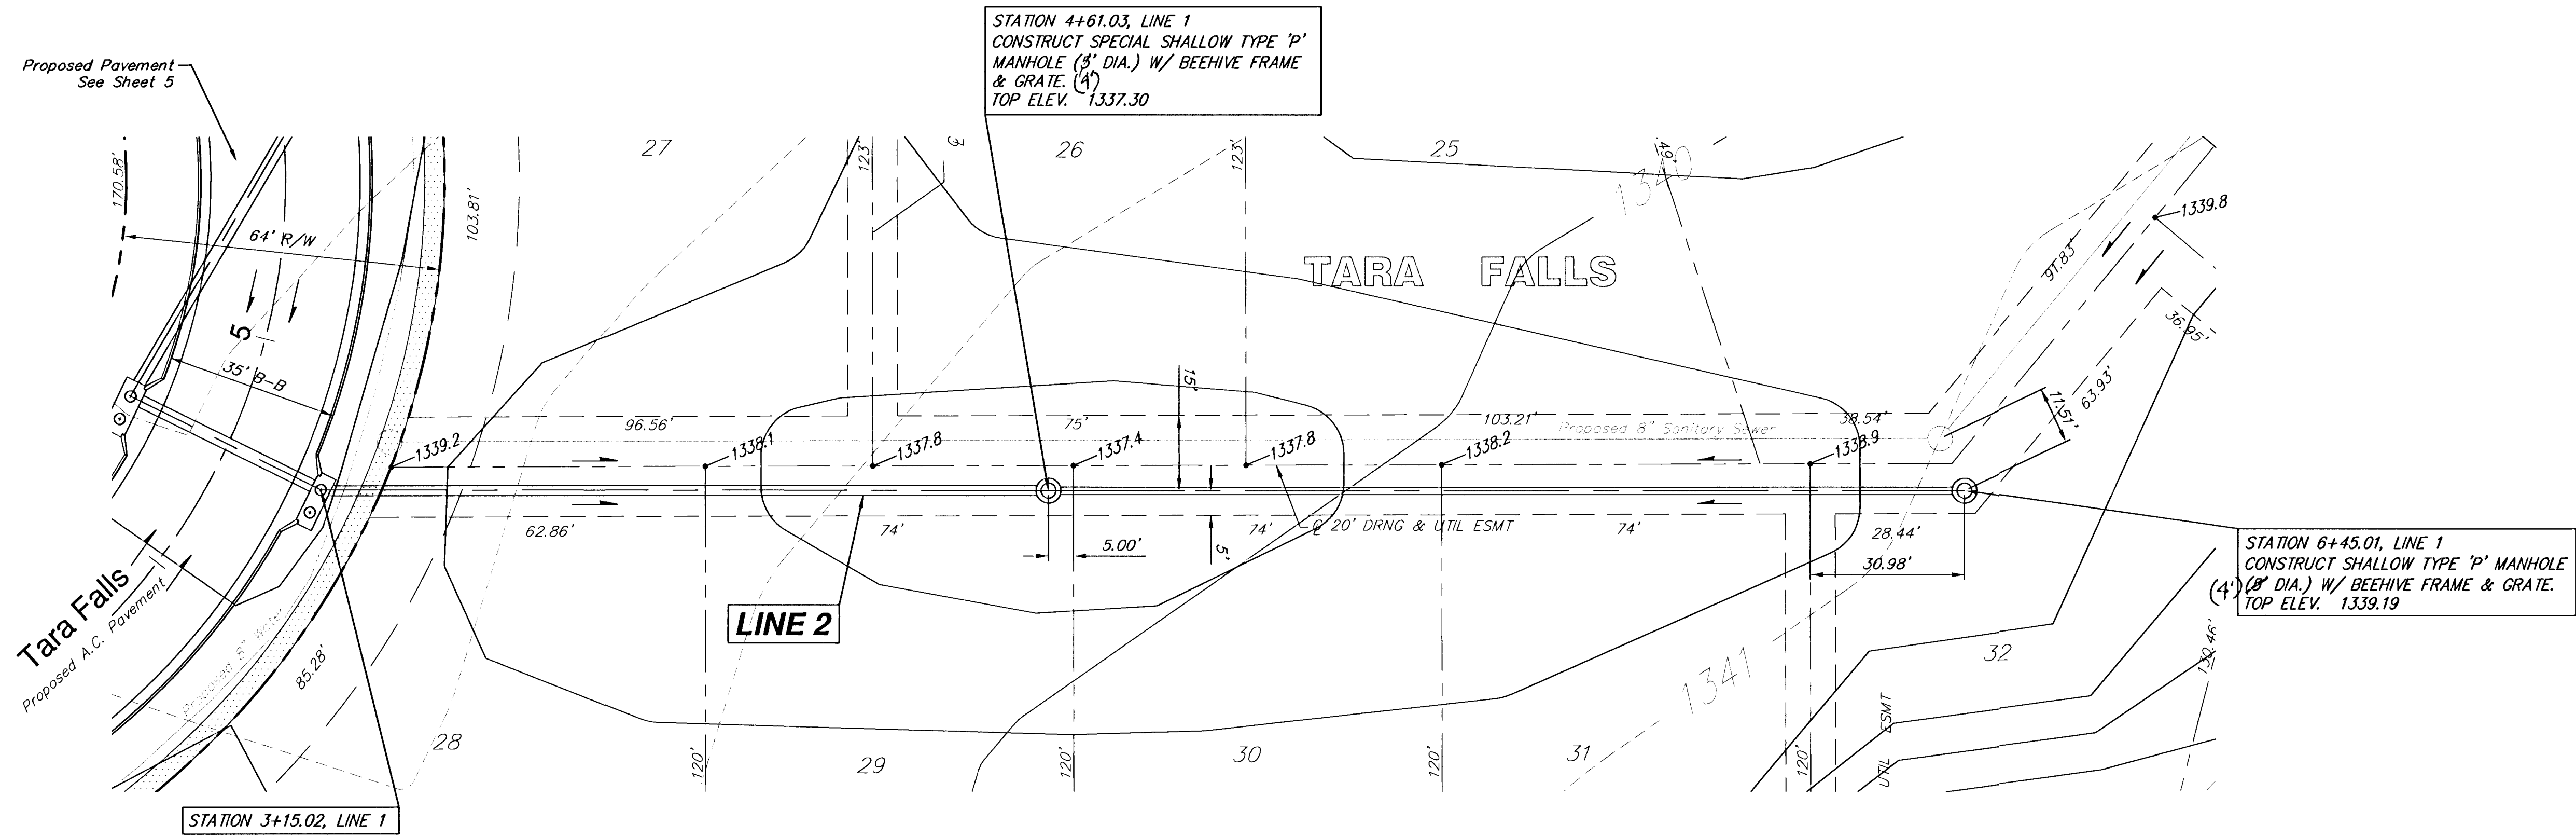


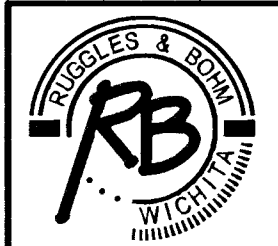

SCALE
1" = 20' Horiz. (Plan & Profile)
1" = 5' Vert. (Profile)

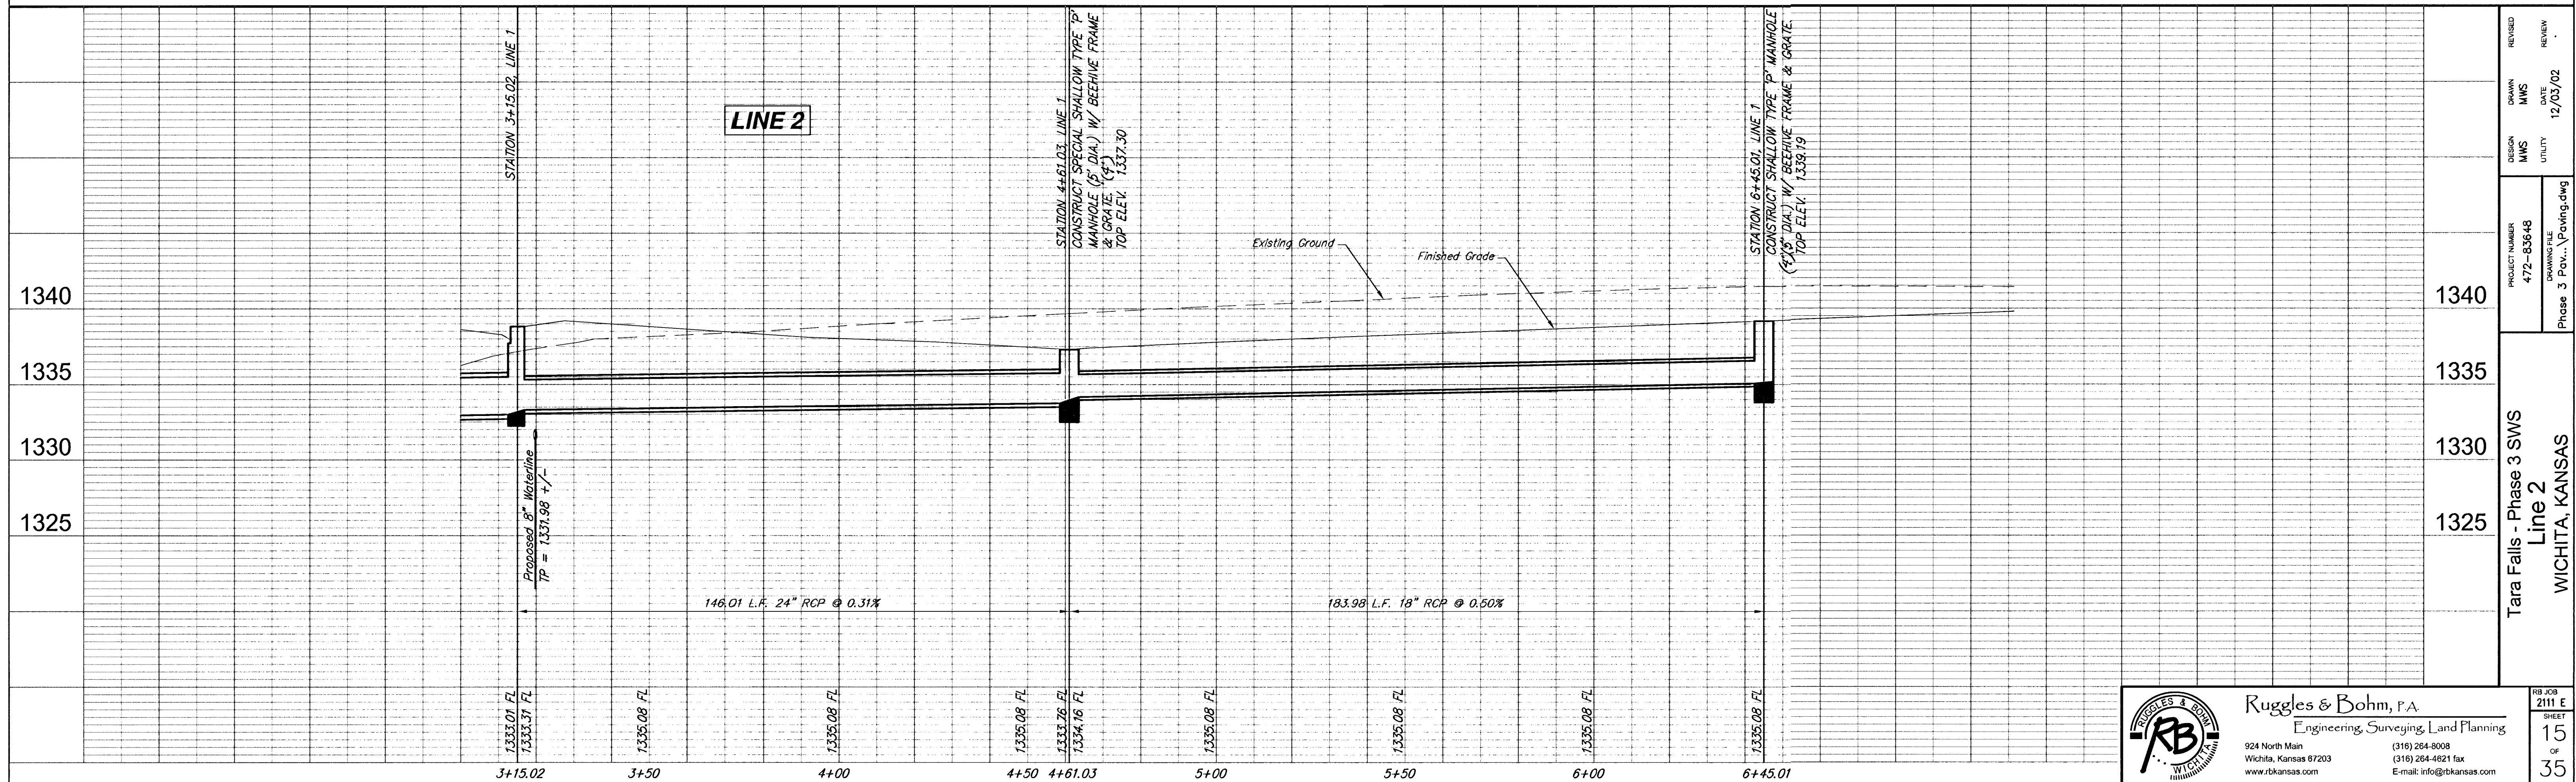

Ruggles & Bohm, P.A.
Engineering, Surveying, Land Planning
924 North Main
Wichita, Kansas 67203
www.rbkansas.com
(316) 264-9008
(316) 264-4621 fax
E-mail: info@rbkansas.com

REVISION	DATE	REVIEW
12/03/02		

DESIGN	DRAWN	PROJECT NUMBER	PHASE
MWS	MWS	472-83648	Phase 3 Pav...

UTILITY	FILE	DRAWING
UTILITY	FILE	Paving.dwg

Tara Falls - Phase 3 SWS	Line 2	WICHITA, KANSAS
--------------------------	--------	-----------------

JOB	SHEET
2111 E	15
	OF
	35