
PROJECT NO.	SHEET NO.	TOTAL SHEETS
472-83376	15	50

WATER VALVE BOX ELEVATIONS			
STREET	STATION	OFFSET	PROPOSED ELEVATION
CHURCHILL	45+21.72	20.0'Rt.	213.5
CHURCHILL	45+24.72	23.0'Rt.	213.5

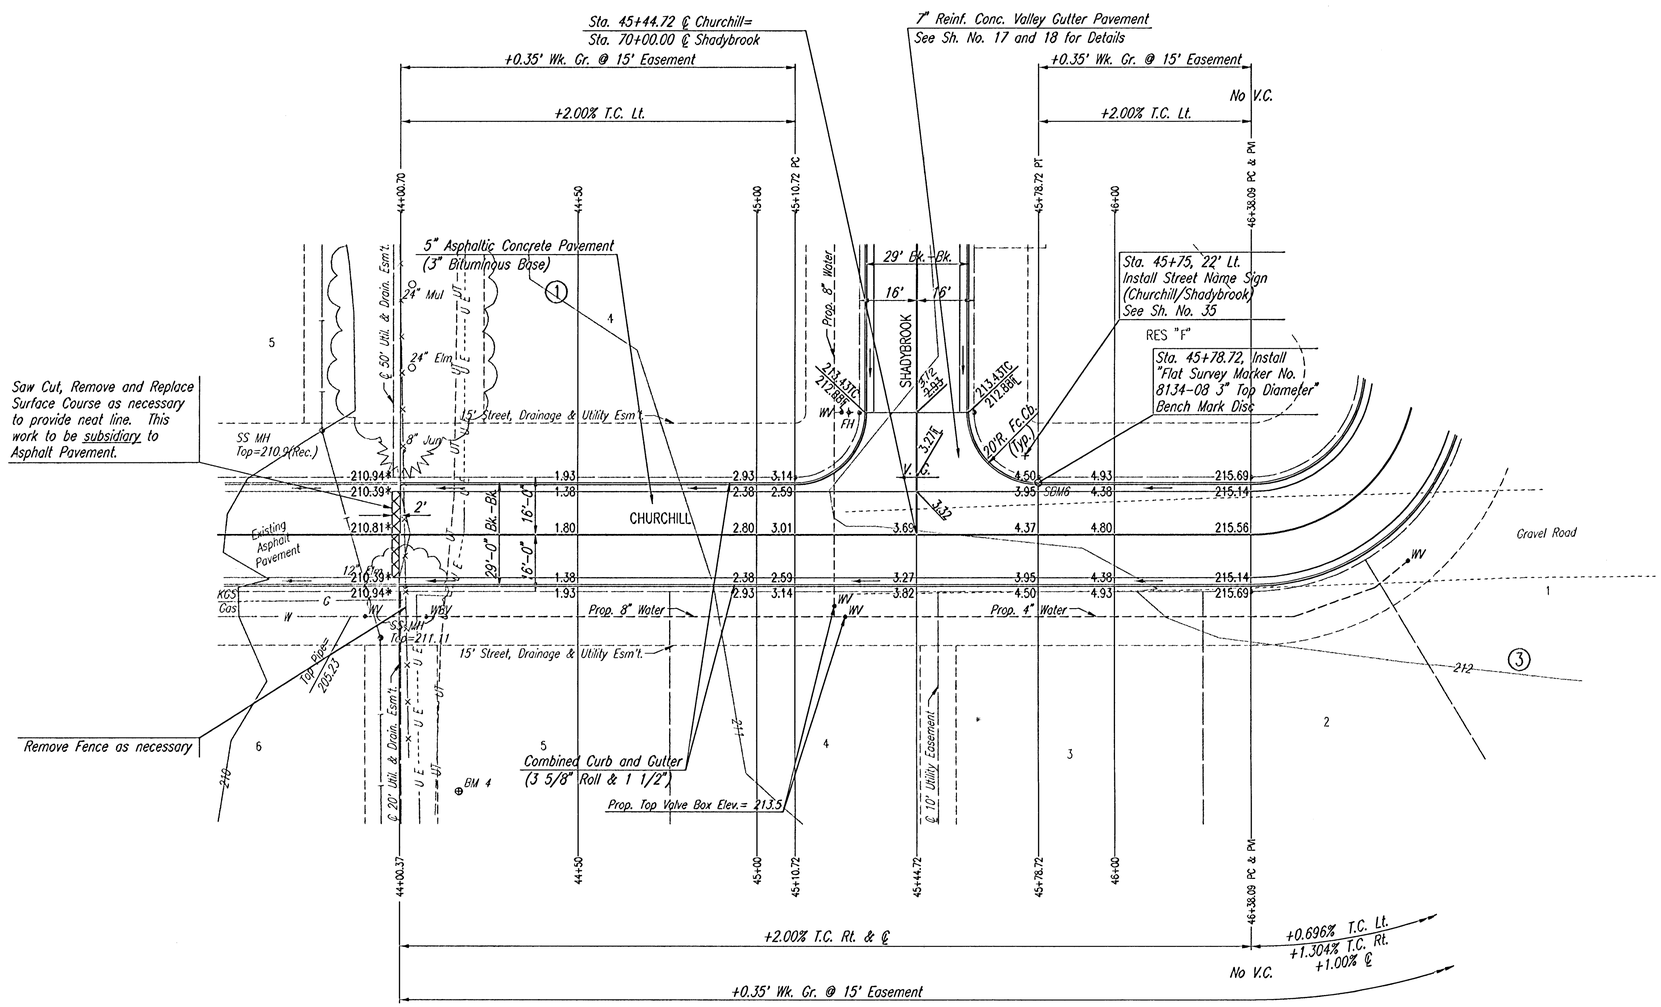

SCALE: 1"=20'

NOTE: THIS STREET TO BE CONSTRUCTED WITH ROLL-TYPE CURB. TOP OF CURB ELEVATIONS GIVEN ARE FOR FULL HEIGHT CURB.

* MATCH EXISTING

RECORD DRAWING
24 NOV 03

REMINGTON PLACE - PHASE 2

CHURCHILL
STA. 43+98.72 TO STA. 46+38.09

Professional Engineering Consultants, P.A.
303 S. TOPEKA • WICHITA, KANSAS 67202
316-262-2691 • FAX 316-262-3003

Designed by	BER	Checked by	
Drawn by	DEP	Date DEC., 2002	Job No. 02398

DSNR: DEP OPER: DEP SCALE: 1=20.00
Q:\2002\02398\000\CHURCHILLS1 12-03-2002 03:13:34 pm