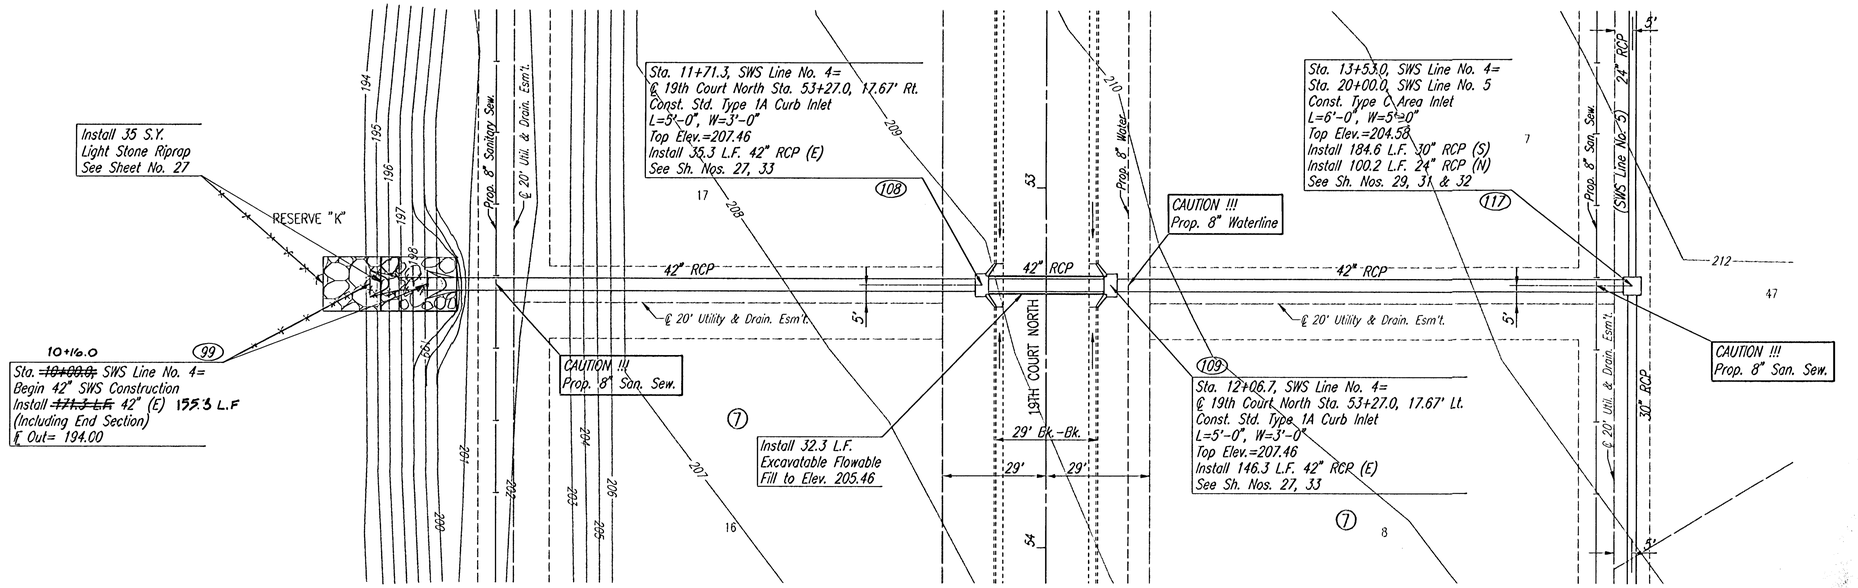

SCALE: 1"=20'

COORDINATE LIST		
POINT	NORTH	EAST
99	385,430.3083	2,370,558.1305
108	385,432.1759	2,370,728.1597
109	385,432.5642	2,370,763.4976
117	385,434.1721	2,370,909.8188

(117) = COORDINATE POINT NO.

RECORD DRAWING

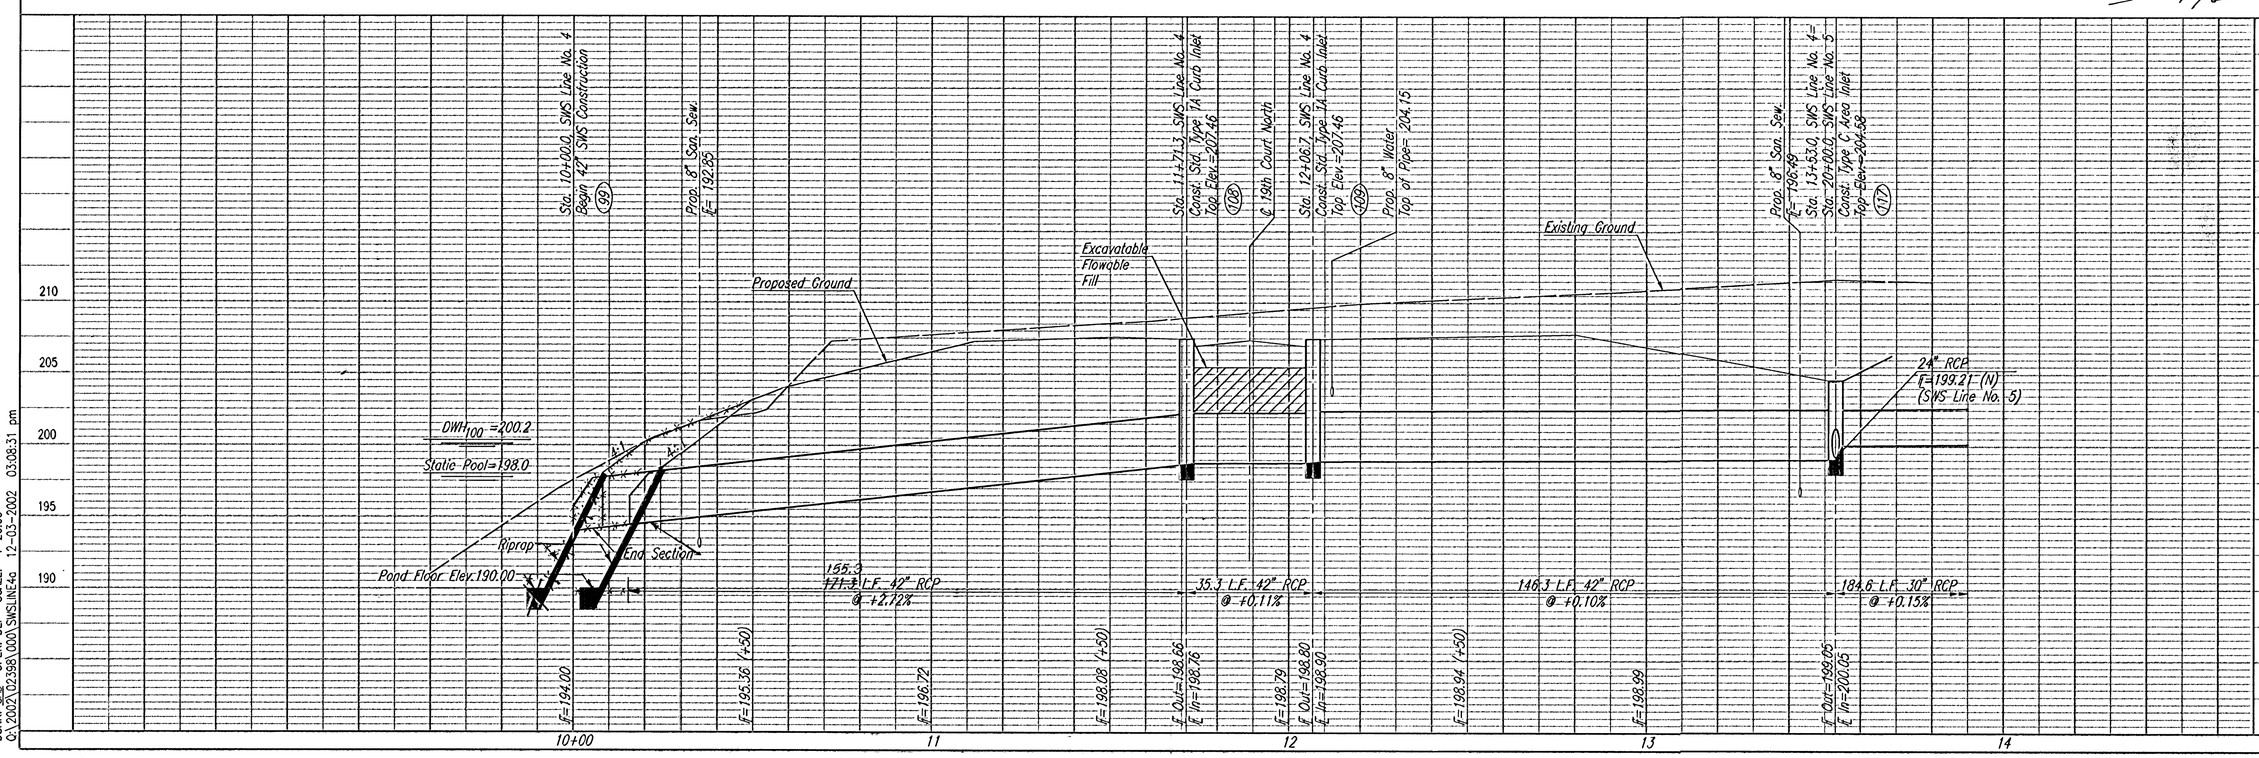

REMINGTON PLACE - PHASE 2

SWS LINE NO. 4
STA. 10+00.00 TO STA. 13+53.00

C.O.W. PROJ. NO. 472-83376

Professional Engineering Consultants, P.A.
303 S. TOPEKA • WICHITA, KANSAS 67202
316-262-2691 • FAX 316-262-3003

Job No. 02398
Date DEC., 2002
Designed by BER
Drawn by SAW

Sheet 24 of 50

DSNR: SAD OPER: DEP SCALE: 1=20.00
Q:\2002\02398\000\SWSLINE4a 12-03-2002 03:08:31 pm