




J:\PROJECTS\2018\1801010519\_COUNTRY HOLLOW 2ND. 18519 CAD\SHIT\505\_CIVIL\WTR\18519-05-200.DWG  
 PLOTTED: Monday, April 08, 2019 @ 10:23AM

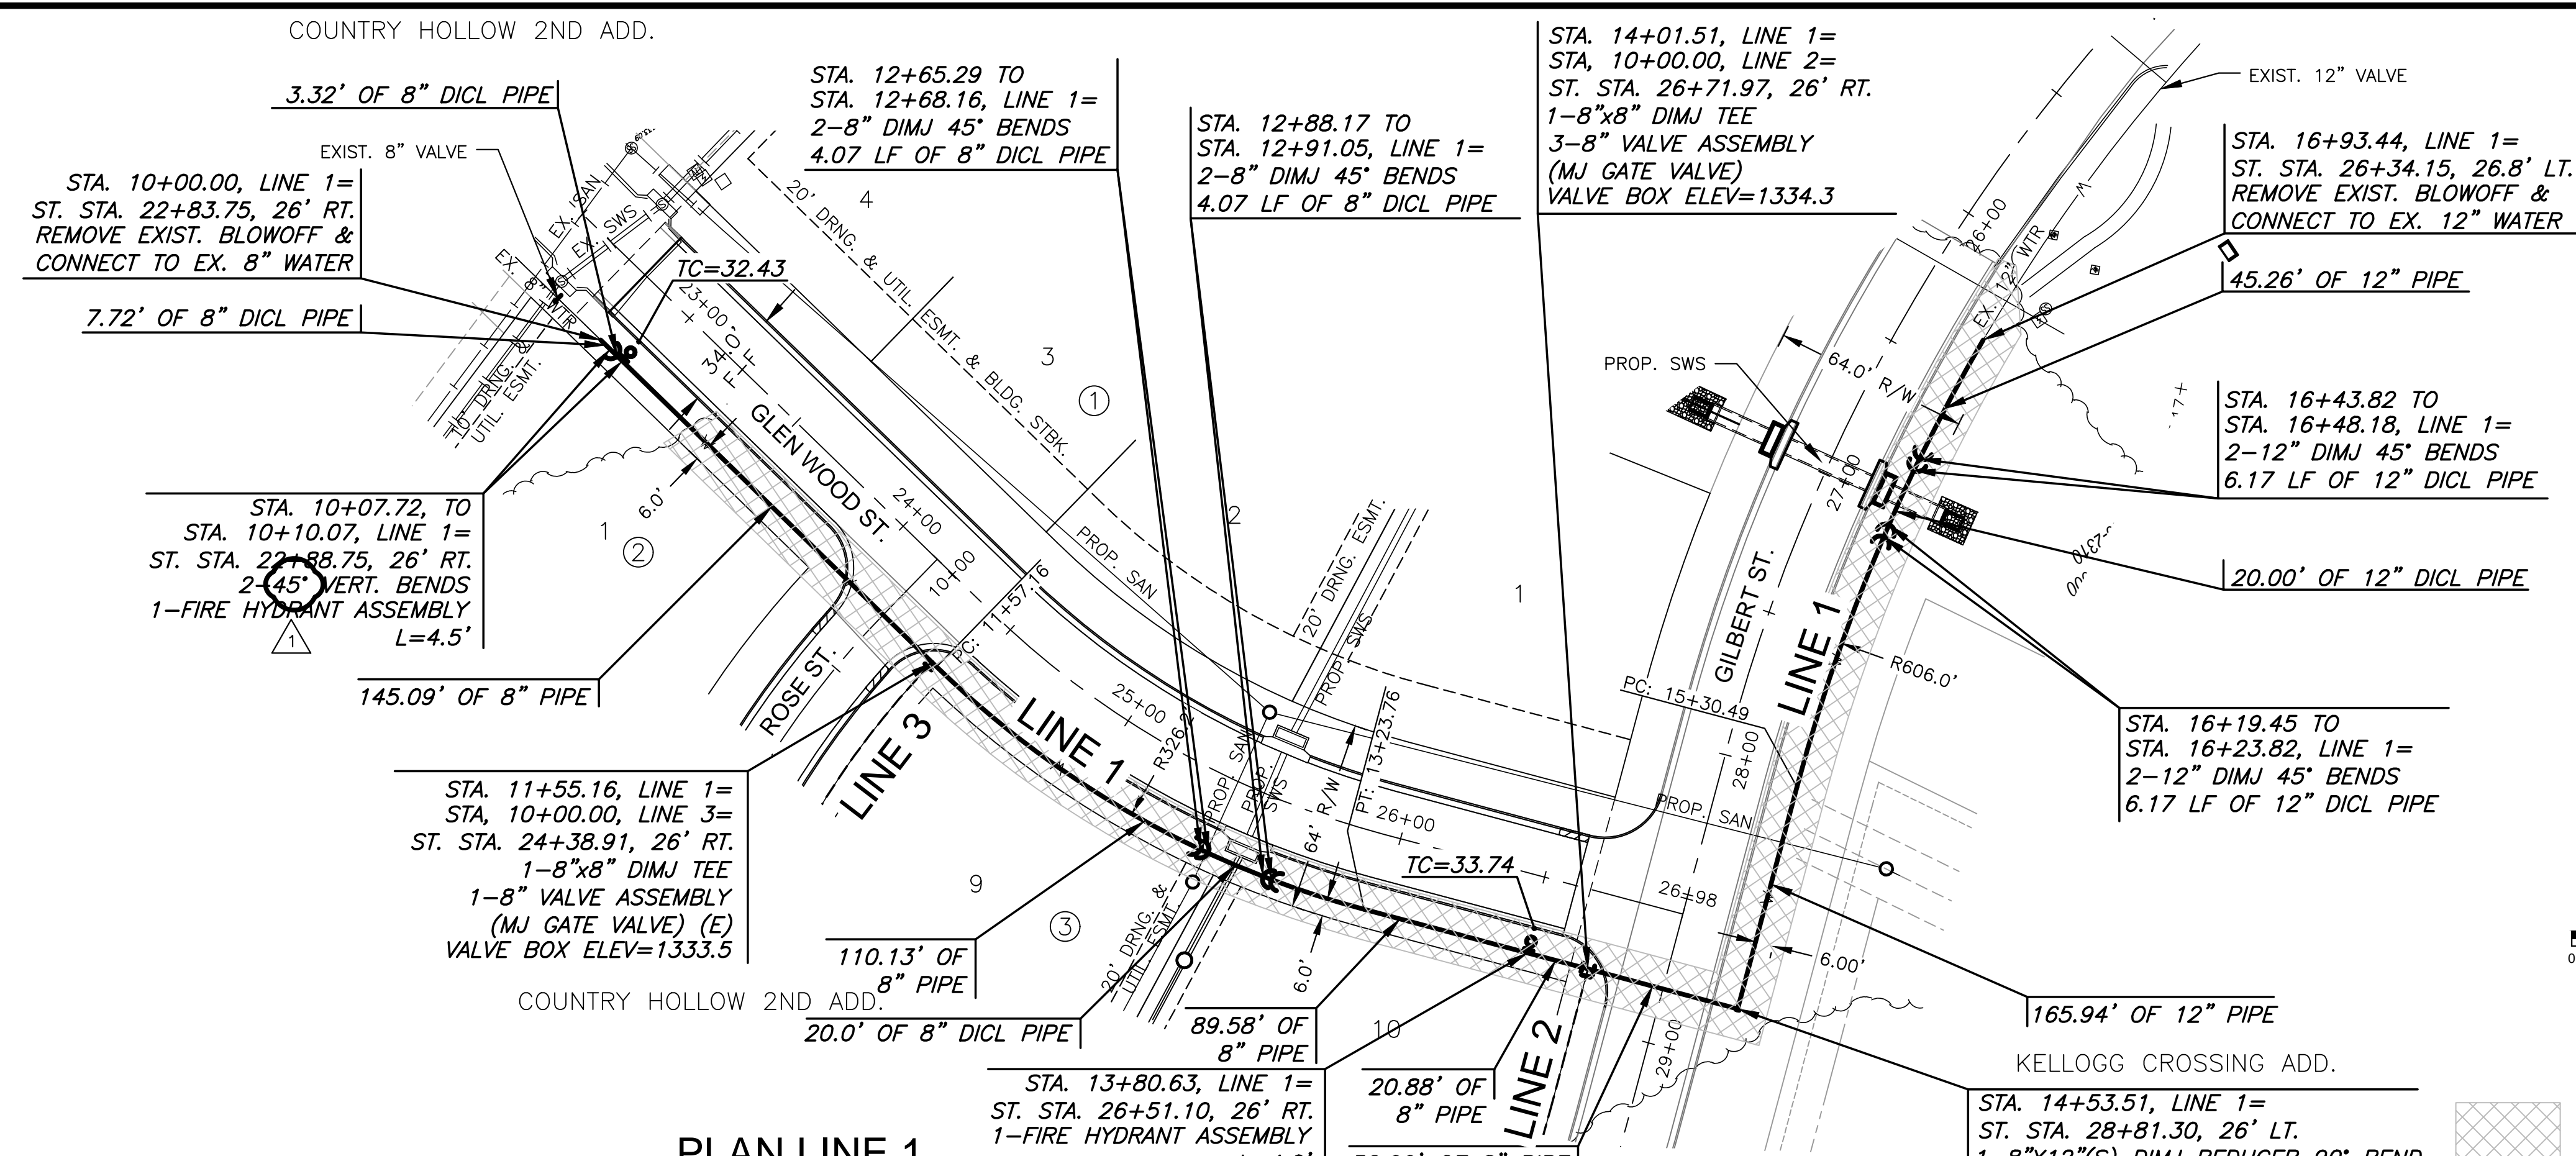

**NOTE:**  
CONTRACTOR TO VERIFY LOCATION AND ELEVATION OF EXISTING WATER LINE PRIOR TO CONSTRUCTION.

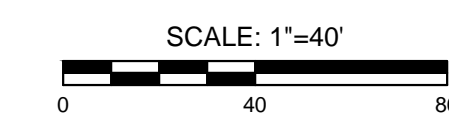

**PLAN LINE 1  
PROFILE LINE 1**

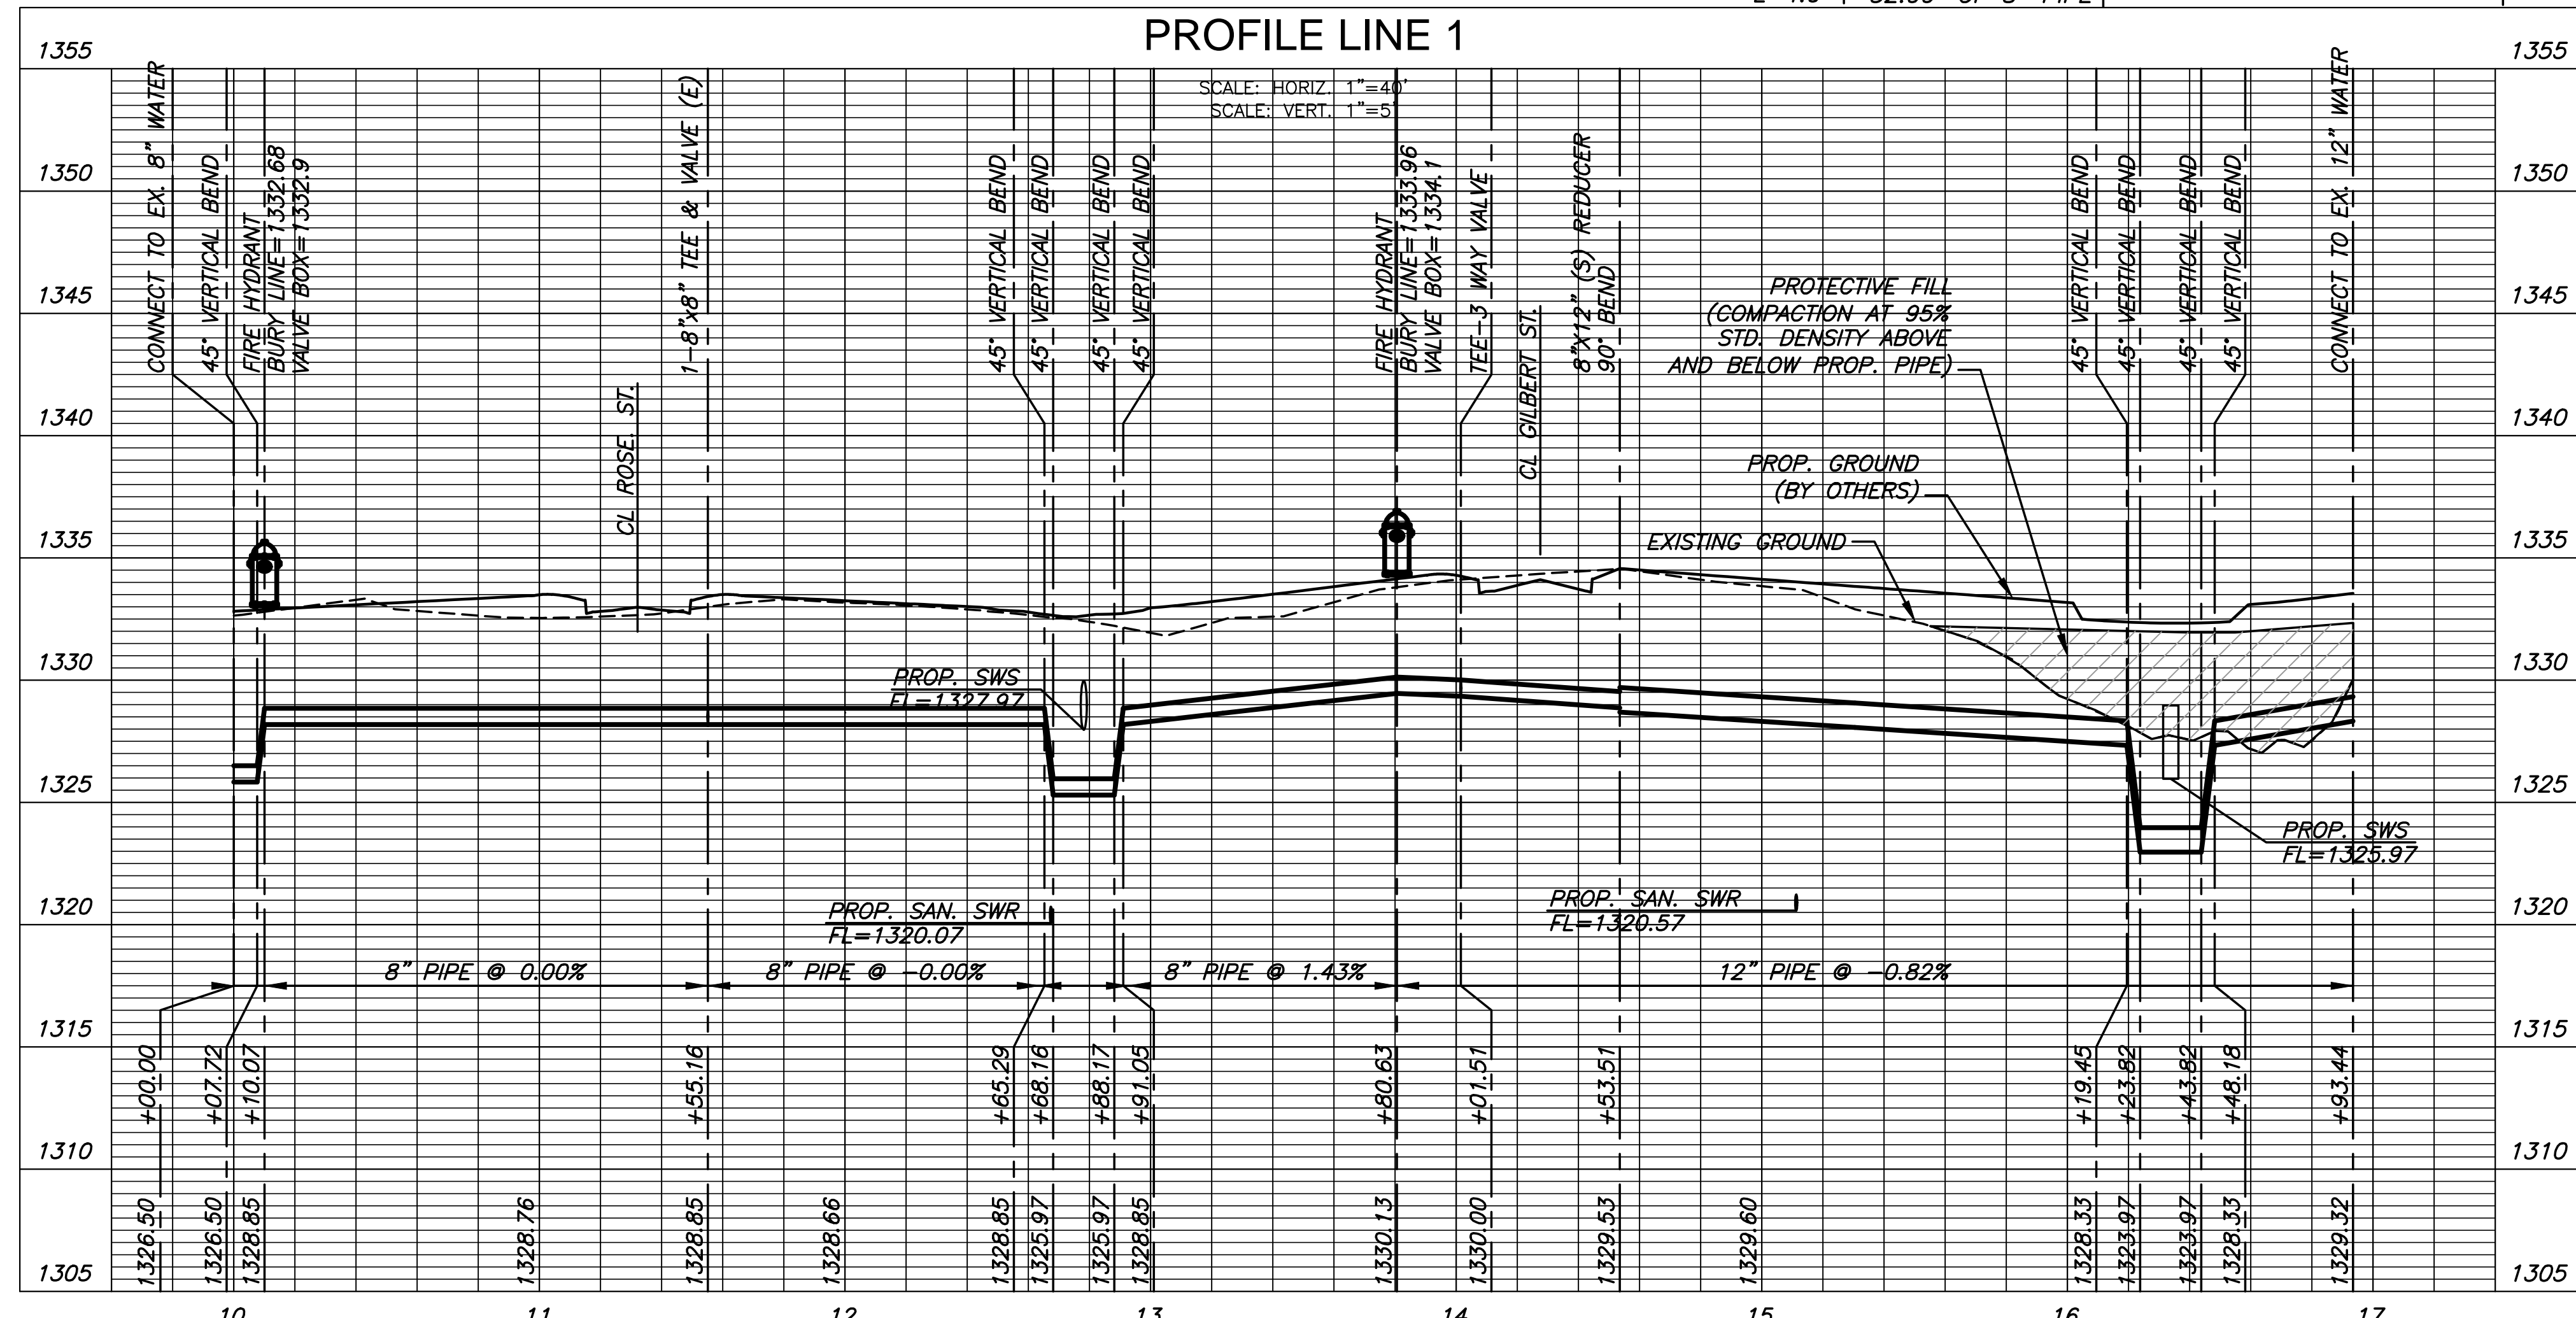

WATER DISTRIBUTION PLANS FOR  
**COUNTRY HOLLOW 2ND ADDITION**  
 PHASE 1

©2019 MKEC Engineering All Rights Reserved  
 These drawings and their contents, including, but not limited to, all concepts, designs, & ideas are the exclusive property of MKEC Engineering (MKEC), and may not be used or reproduced in any way without the express consent of MKEC.

|                          |               |
|--------------------------|---------------|
| <b>LINE 1</b>            |               |
| PROJECT NO.              | 448-90156     |
| DATE                     | MAR 2019      |
| SCALE                    | 1"=40'        |
| DESIGNED                 | DRAWN         |
| SLF                      | BKS           |
| CHECKED                  | SLF           |
| 1 BEND REVISION 04/08/19 |               |
| NO.                      | REVISION DATE |
| SHEET NO.                |               |
| 03 OF 12                 |               |