


IRONS				IRONS			
Point #	Northing	Eastng	Description	Point #	Northing	Eastng	Description
1	1,710,224.38	1,685,819.67	Iron	137	1,708,924.52	1,687,985.37	Iron
2	1,710,125.87	1,685,897.20	Iron	138	1,708,866.84	1,687,979.31	Iron
3	1,710,151.35	1,685,921.56	Iron	139	1,708,853.79	1,688,103.46	Iron
4	1,710,155.73	1,686,146.52	Iron	140	1,708,911.47	1,688,109.52	Iron
5	1,710,172.68	1,686,246.20	Iron	141	1,708,853.87	1,688,246.77	Iron
6	1,710,180.00	1,686,622.34	Iron	142	1,708,781.60	1,688,237.28	Iron
7	1,710,181.69	1,686,709.32	Iron	143	1,708,945.64	1,686,744.27	Iron
8	1,710,201.95	1,687,749.63	Iron	144	1,708,918.08	1,686,809.45	Iron
9	1,710,203.64	1,687,836.61	Iron	145	1,708,866.33	1,686,747.13	Iron
10	1,710,276.41	1,688,491.69	Iron	146	1,708,832.81	1,686,775.72	Iron
11	1,710,216.42	1,688,493.01	Iron	147	1,708,885.36	1,686,837.35	Iron
12	1,708,434.40	1,688,532.32	Iron	148	1,708,847.94	1,686,855.01	Iron
13	1,708,314.79	1,687,434.98	Iron	149	1,708,808.60	1,686,812.40	Iron
14	1,708,375.35	1,687,466.71	Iron	150	1,708,749.89	1,686,871.88	Iron
15	1,708,431.69	1,687,432.50	Iron	151	1,708,793.01	1,686,910.66	Iron
16	1,708,468.12	1,687,337.71	Iron	152	1,708,766.75	1,686,939.86	Iron
17	1,708,463.53	1,687,200.91	Iron	153	1,708,723.63	1,686,901.07	Iron
18	1,708,423.09	1,687,137.52	Iron	154	1,708,814.43	1,686,648.00	Iron
19	1,708,356.21	1,687,077.37	Iron	155	1,708,862.69	1,686,596.15	Iron
20	1,708,342.53	1,687,009.18	Iron	156	1,708,883.33	1,686,588.56	Iron
21	1,708,452.99	1,686,886.36	Iron	157	1,708,905.42	1,686,648.63	Iron
22	1,708,327.13	1,685,927.82	Iron	158	1,708,886.85	1,686,655.46	Iron
23	1,708,413.61	1,685,925.62	Iron	159	1,708,012.21	1,686,584.45	Iron
24	1,710,141.15	1,686,623.10	Iron	160	1,708,969.53	1,686,536.76	Iron
25	1,710,079.18	1,686,631.93	Iron	161	1,708,104.48	1,686,501.89	Iron
26	1,710,067.22	1,686,711.55	Iron	162	1,708,147.71	1,686,463.21	Iron
27	1,710,039.71	1,686,643.43	Iron	163	1,708,184.38	1,686,504.20	Iron
28	1,710,051.74	1,686,712.48	Iron	164	1,708,141.16	1,686,542.87	Iron
29	1,708,995.10	1,686,726.94	Iron	165	1,708,224.06	1,686,561.64	Iron
30	1,708,983.85	1,686,662.70	Iron	166	1,708,172.58	1,686,588.37	Iron
31	1,710,041.37	1,686,532.22	Iron	167	1,708,282.02	1,686,639.00	Iron
32	1,708,984.06	1,686,523.25	Iron	168	1,708,241.91	1,686,680.89	Iron
33	1,708,987.30	1,686,477.84	Iron	169	1,708,327.86	1,686,682.89	Iron
34	1,710,045.30	1,686,477.10	Iron	170	1,708,287.74	1,686,724.78	Iron
35	1,710,043.00	1,686,298.19	Iron	171	1,708,255.02	1,686,367.19	Iron
36	1,708,985.01	1,686,298.94	Iron	172	1,708,212.35	1,686,319.50	Iron
37	1,710,026.60	1,686,213.67	Iron	173	1,708,327.60	1,686,273.23	Iron
38	1,708,972.54	1,686,234.68	Iron	174	1,708,385.13	1,686,280.55	Iron
39	1,708,952.90	1,686,110.33	Iron	175	1,708,453.79	1,686,318.37	Iron
40	1,710,010.80	1,686,113.64	Iron	176	1,708,411.56	1,686,366.46	Iron
41	1,710,042.43	1,686,875.70	Iron	177	1,708,568.84	1,686,419.39	Iron
42	1,708,986.21	1,686,861.45	Iron	178	1,708,584.09	1,686,433.50	Iron
43	1,710,043.68	1,687,111.90	Iron	179	1,708,623.06	1,686,398.77	Iron
44	1,708,987.61	1,687,126.74	Iron	180	1,708,661.65	1,686,442.08	Iron
106	1,708,711.10	1,687,110.71	Iron	181	1,708,622.68	1,686,476.80	Iron
107	1,708,649.60	1,687,092.97	Iron	182	1,708,526.61	1,686,467.49	Iron
108	1,708,823.40	1,686,739.62	Iron	183	1,708,601.55	1,686,561.24	Iron
109	1,708,769.33	1,686,773.86	Iron	184	1,708,657.77	1,686,530.65	Iron
110	1,708,702.65	1,686,906.88	Iron	185	1,708,703.41	1,686,595.38	Iron
111	1,708,671.01	1,686,935.20	Iron	186	1,708,655.72	1,686,638.06	Iron
112	1,708,659.98	1,686,859.19	Iron	187	1,708,774.09	1,686,674.37	Iron
113	1,708,623.32	1,686,977.87	Iron	188	1,708,726.39	1,686,717.05	Iron
114	1,708,562.76	1,687,032.06	Iron	189	1,708,418.63	1,686,216.77	Iron
115	1,708,520.08	1,686,984.36	Iron	190	1,708,379.96	1,686,173.55	Iron
116	1,708,189.64	1,687,079.94	Iron	191	1,708,476.23	1,686,087.41	Iron
117	1,708,141.65	1,686,963.34	Iron	192	1,708,514.91	1,686,130.63	Iron
118	1,708,093.96	1,687,006.02	Iron	193	1,708,609.21	1,686,093.87	Iron
119	1,708,122.65	1,687,034.40	Iron	194	1,708,608.44	1,686,035.88	Iron
120	1,708,168.02	1,687,111.74	Iron	195	1,708,748.79	1,686,521.37	Iron
121	1,708,110.68	1,687,168.96	Iron	196	1,708,727.05	1,686,514.17	Iron
122	1,708,070.69	1,687,110.84	Iron	197	1,708,678.90	1,686,457.50	Iron
123	1,708,028.22	1,687,155.19	Iron	198	1,708,675.31	1,686,434.89	Iron
124	1,708,074.77	1,687,193.25	Iron	199	1,708,645.70	1,686,408.32	Iron
125	1,708,988.72	1,687,279.34	Iron	200	1,708,686.76	1,686,359.22	Iron
126	1,708,940.67	1,687,246.85	Iron	201	1,708,466.44	1,686,174.99	Iron
127	1,708,942.55	1,687,347.63	Iron	202	1,708,413.12	1,686,213.83	Iron
128	1,708,894.50	1,687,315.14	Iron	203	1,708,429.72	1,686,131.81	Iron
129	1,708,897.73	1,687,529.40	Iron	204	1,708,362.21	1,686,153.87	Iron
130	1,708,840.08	1,687,535.82	Iron	205	1,708,330.02	1,686,041.74	Iron
131	1,708,903.76	1,687,583.57	Iron	206	1,708,412.28	1,686,048.00	Iron
132	1,708,922.02	1,687,600.46	Iron	207	1,708,415.22	1,685,989.19	Iron
133	1,708,932.97	1,687,698.82	Iron				
134	1,708,918.87	1,687,719.31	Iron				
135	1,708,923.84	1,687,763.90	Iron				
136	1,708,886.20	1,687,770.32	Iron				

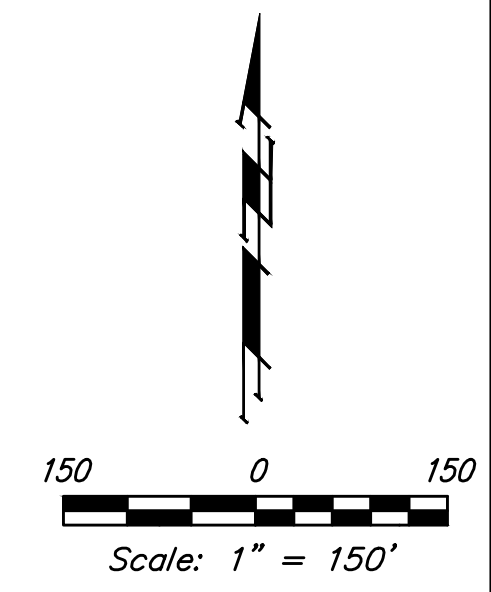

SWS POINTS			
Point #	Northing	Eastng	Description
7001	1,708,147.93	1,686,186.63	CL RCBC
7002	1,708,199.04	1,686,234.46	CL RCBC
7003	1,708,237.28	1,686,135.91	CEN I/S FC
7004	1,708,256.66	1,686,177.06	CEN I/S FC
7005	1,708,545.02	1,686,324.77	CL RCBC
7006	1,708,586.71	1,686,274.91	CL RCBC
7007	1,708,528.77	1,686,292.53	CL PIPE
7008	1,708,168.69	1,686,188.71	CL PIPE
7009	1,708,470.59	1,686,241.24	CEN I/S FC
7010	1,708,491.33	1,686,216.44	CEN I/S FC

Brookfield Addition

## COORDINATES

Baughman Company, P.A. 315 Ellis St. Wichita, KS 67211 P 316-262-7271 F 316-262-0149  
 ENGINEERING | SURVEYING | PLANNING | LANDSCAPE ARCHITECTURE

PROJECT NUMBER  
472-85349

REVISIONS:

DESIGN  
AEG

APPROVED

SCALE  
Noted

SHEET  
**23 OF 25**

DRAWN  
JAK

DATE  
4/02/19