

EAST LYNNE ADDITION

LOT 5


CONTRACTOR TO PROTECT
TREES DURING CONSTRUCTION

MH TOP=1332.01
FL IN=1310.64
FL OUT=1310.54

WOODLAND LAKES
ESTATES THIRD

54
⑤

STA. 15+91.8, LINE 1
CONST. 6'x6' REINF.
CONC. MANHOLE
W/ DEETER FRAME &
GRATE NO. 1927 OR
APPROVED EQUAL
PROVIDE SEDIMENT
BARRIER

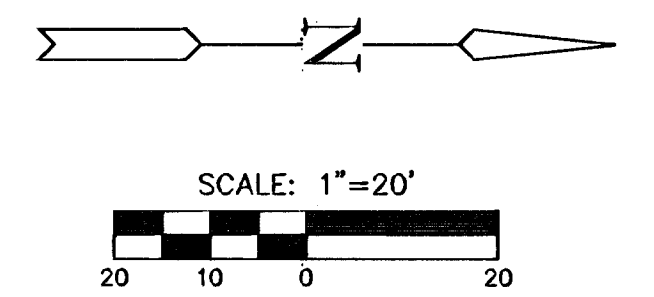

EAST LYNNE ADDITION

LOT 6

PLAN LINE 1

PROFILE LINE 1

SCALE: HORIZ. 1"=20'
SCALE: VERT. 1"=5'

STA. 15+91.8, LINE 1
CONST. 6'x6' REINF.
CONC. MANHOLE
TOP=1331.0

EXIST. GROUND
ON CL OF PIPE

SS SERVICE LINE
FL=1309.4

SS SERVICE LINE
FL=1310.0

50.5 L.F. OF DITCH
GRADING @ 0.50%
(SEE DETAIL)


173.2 L.F. OF 36" RCP @ 2.80%

319.7 L.F. OF 36" RCP @ 1.30%

EX. 36" SAN.
FL=1302.6

STA. 10+98.9, LINE 1
INSTALL 36" END SECTION

41.7 SY OF HEAVY STONE
RIP RAP W/GROUTED
TOEWALL (15'x4'x2')

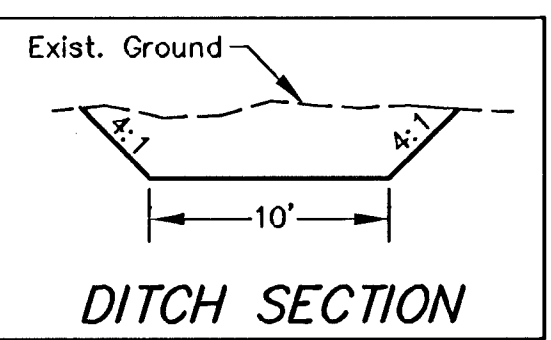

FOR INFORMATION ONLY:
ESMT. GRADING: LINE 1

CUT.....	26 C.Y.
FILL.....	0 C.Y.

MH TOP=1318.07
FL IN=1308.54
FL IN=1305.78
FL IN=1302.78
FL OUT=1302.58

EAST
LYNNE
AVENUE

EXIST. 8" SANITARY SEWER
GRAVEL DRIVE

LINE 1 36" RCP

STA. 12+72.1, LINE 1
CONST. 6'x6' REINF.
CONC. MANHOLE

REMOVE & REPLACE
23 L.F. OF ASPHALT ROAD

90.9'
GRAVEL DRIVE

MH TOP=1327.54
FL IN=1309.60
FL IN=1309.60
FL OUT=1309.50

S.S. SERVICE LINE

LINE 1 36" RCP

LANE

EXIST. 8" SANITARY SEWER

PROF. SANITARY SEWER
20' Drng. & Util. Esmt.