WOODLAND LAKES ESTATES THIRD ADD. - ZELTA PHASE
PROJ. NO. 468-83593

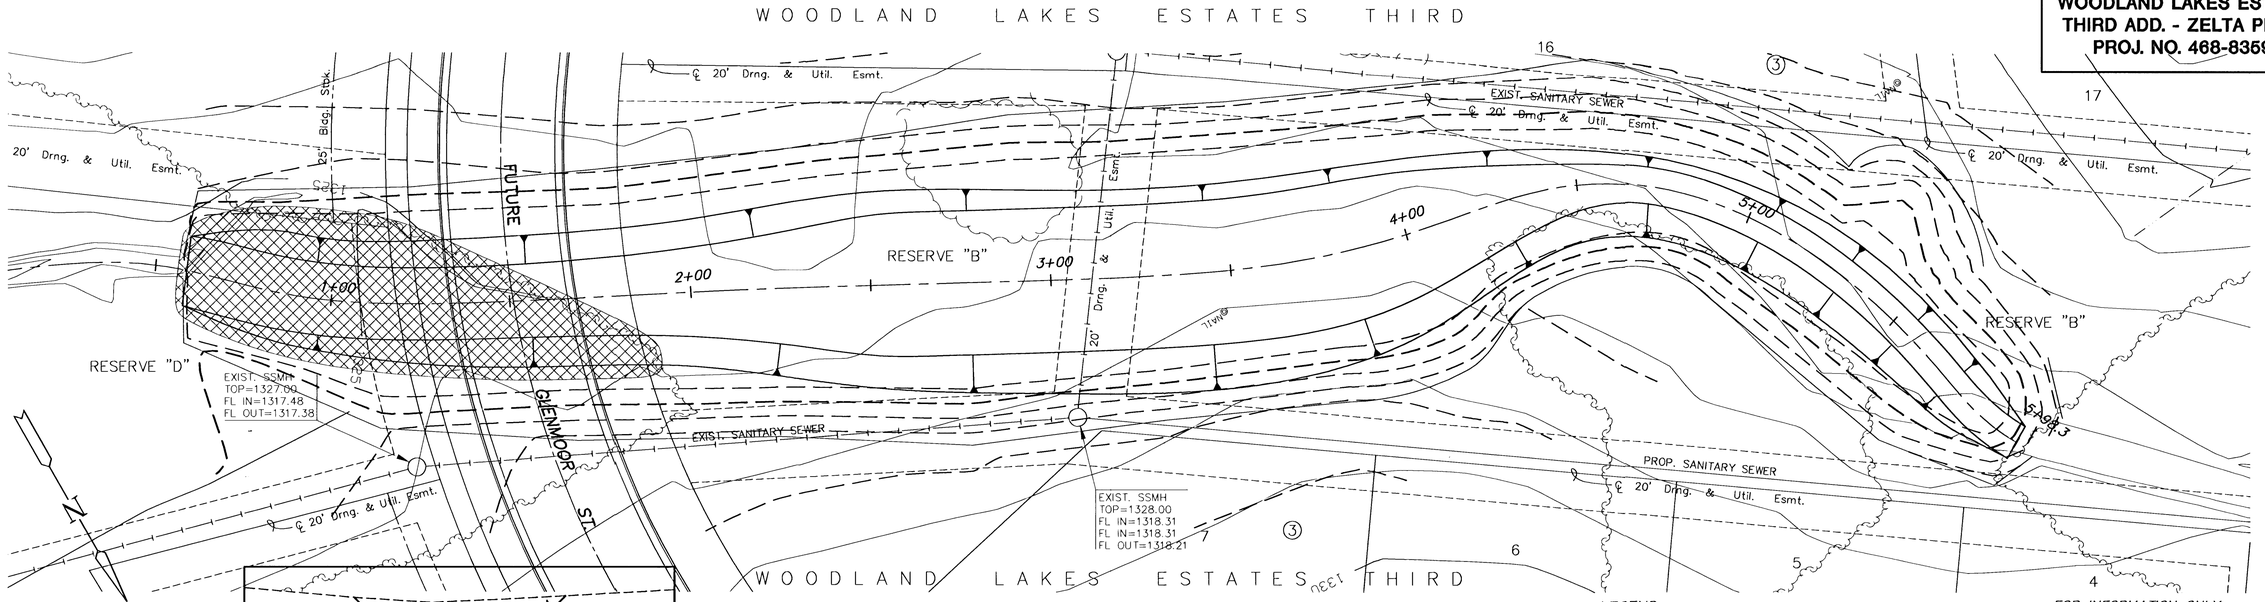

TYP. DITCH SECTION

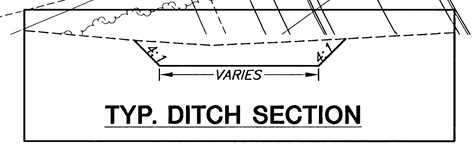

DITCH GRADING

LEGEND

- =LIMIT OF TREE REMOVAL
- =PROPOSED WETLANDS MITIGATION (SEE DETAIL ON SHEET 2)
- =NORMAL POOL
- =LIMITS OF GRADING
- 1355 =EXIST. CONTOUR
- 1355 =PROP. CONTOUR
- 1355 =AS-BUILT CONTOUR
- x 1355 =AS-BUILT SPOT ELV.

FOR INFORMATION ONLY:

DITCH GRADING:	
CUT	1070 C.Y.
FILL	0 C.Y.

AS-BUILT FEBRUARY 2004

DITCH GRADING

SCALE: HORIZ. 1"=20'
SCALE: VERT. 1"=5'

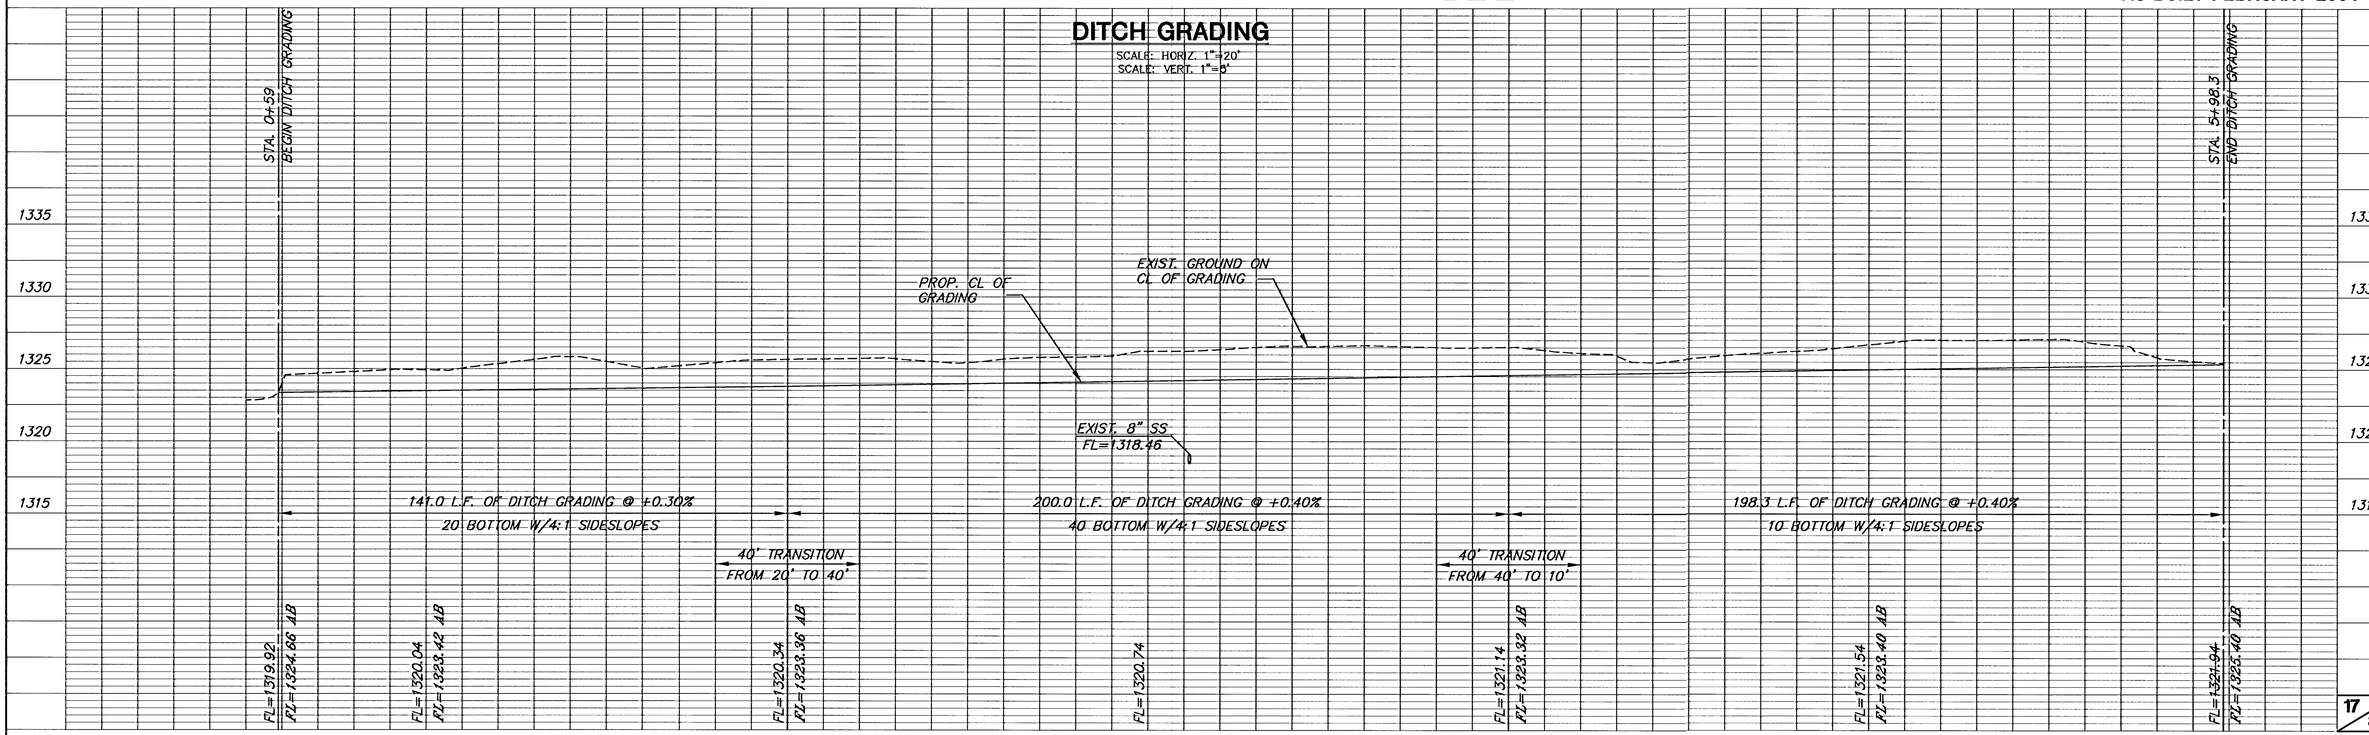

H:\CIVIL\95058\02172\DWG\SWS\ZELTA\AS-BUILT\02172_07