UNDERGROUND CONDUIT RECORD
ALL #2 PLOWS ON THIS RECORD WILL HAVE A MINIMUM 24" DEPTH UNLESS NOTED OTHERWISE

REVISED	
79	EST 67203 83
91	A601253 '92

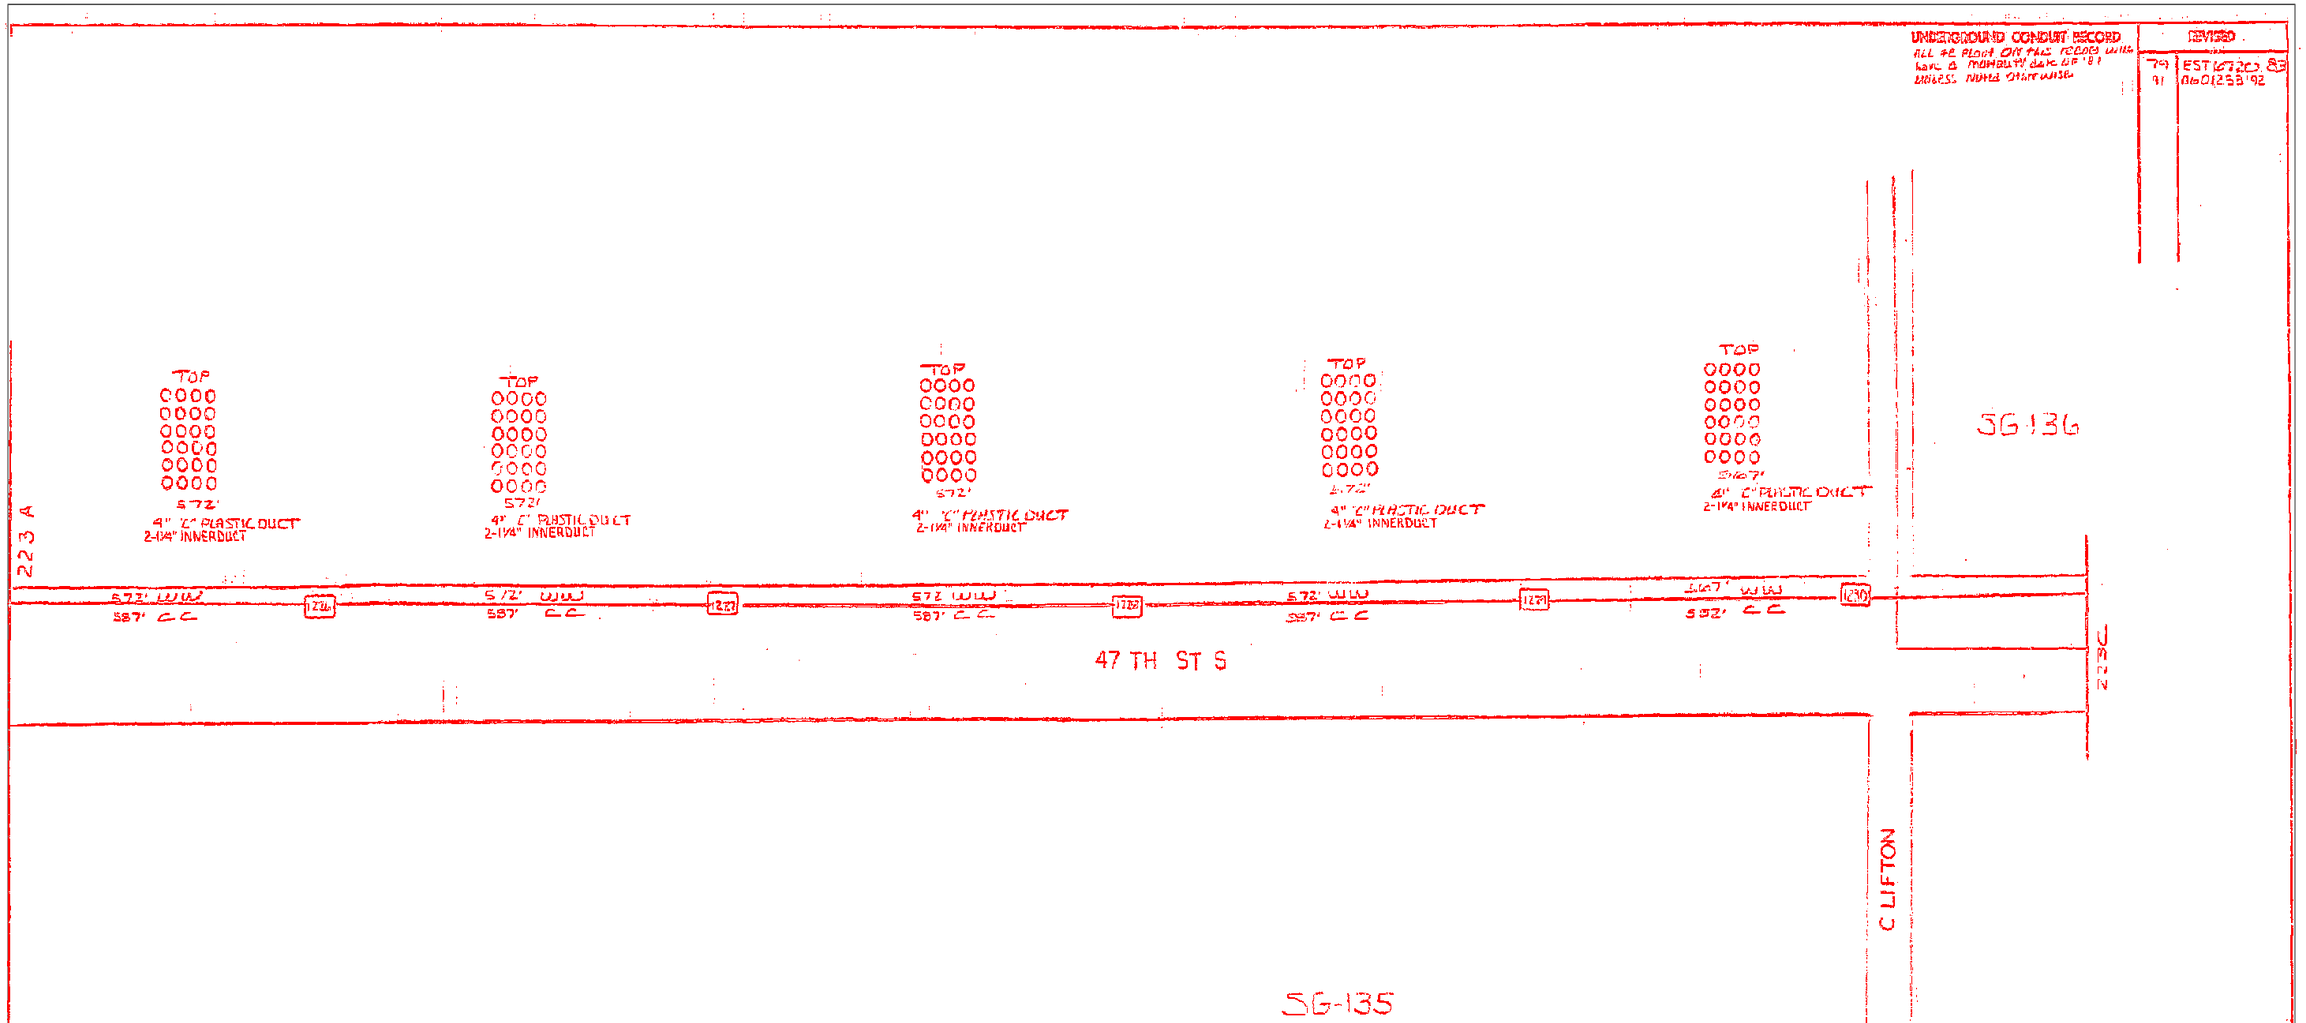

M.H.	INSIDE DIMENS. L W. NOM.	OTHER CHARACTERISTIC	TYPE	COVERING	MATERIAL WALLS	FLOOR	FLOOR	DEPTH EXCAV.	DATE	COMMENTS
1226	15' X 6' X 9'		PRECAST					12' 10"	1980	SUMP
1227	15' X 6' X 9'		PRECAST					12'	1980	SUMP
1228	15' X 6' X 9'		PRECAST					12' 10"	1980	SUMP
1229	15' X 6' X 9'		PRECAST					12' 1"	1980	SUMP
1230	15' X 6' X 9'		PRECAST					12' 1"	1980	SUMP

Southwestern Bell Telephone Company - OPTI-RECORDS

Map C-223-3
Market Area KANSAS CITY
NPA/NXX 816302 Exchange VICKETA JACKSON
Tax District 30130
Map Type CNB
Geo. Loc. KL8813
C-223-A
C-223-C

Scale NONE
Update 12/31/2000

SHEET 25 OF 31

Proprietary - Not for disclosure outside Southwestern Bell Telephone Company except under written agreement.