

Mayfield  
1st Add.

\* Concrete Header

Roll Type Monolithic  
Edge Curb

\* HANDFORMED Roll Type Curb & Gutter

Roll Type Combine  
Curb & Gutter.

Private Drive

Asphalt Pavt.  
By Others

8" Conc. Drive  
Pavement

Roll Type Monolithic  
Edge Curb

\* Concrete Header

\* Changes approved by Vicki Huang

Lot 1

1

57.00  
50' R/W

52.00

40' Bk-Bk

35' R/W

1/2 IP

8" A.C. Water Main

9+00

10+00

May St.

Ex. Asphalt  
Pavt.

4' Bk-Bk

69.94' M

1/2 IP

35' R/W

50' R/W

57.00

8" Conc. Drive  
Pavement

35' Drng. Esmt.


WL By Others

Drainage Ditch

Benchmark:  
BM 1 Temporary bench mark.  
SE corner of intersection of West St.  
and May St. Box cut in NE corner of  
concrete base of sign "May Central Park"  
Elev.=111.67

BM 2 COW Bench mark. NW  
corner of intersection of West St.  
and May St.. 65' W of centerline  
of West St. 50' N of centerline of  
May. 28.8' N of center of median.  
14.4' W of west face of sidewalk.  
2.5' N of back of curb. 2.2' W of  
west face of SWS inlet.  
Elev.=108.63

Baseline:  
10+00 at the Property  
Corner of Tracy and May.

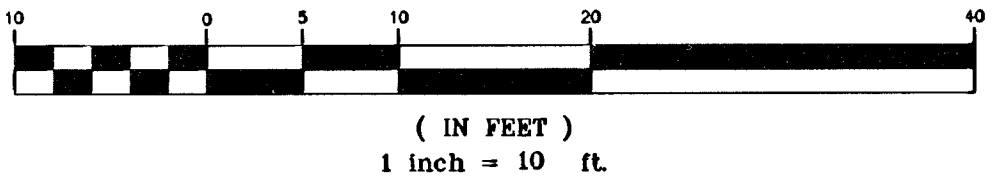

| Street Improvements<br>May Street<br>Wichita, KS |                  |                |                 |            |
|--------------------------------------------------|------------------|----------------|-----------------|------------|
| PROJECT NUMBER                                   |                  |                |                 |            |
| <b>kemiller</b><br>engineering                   | KEM NO.<br>05159 | FILE<br>paving | DATE<br>10/2006 | SHEET<br>2 |
|                                                  | DESIGN<br>KM     | DRAWN<br>JO    | REVISED         | OF<br>5    |

516 S. Market,  
Wichita, KS 67202

316/264-0242