
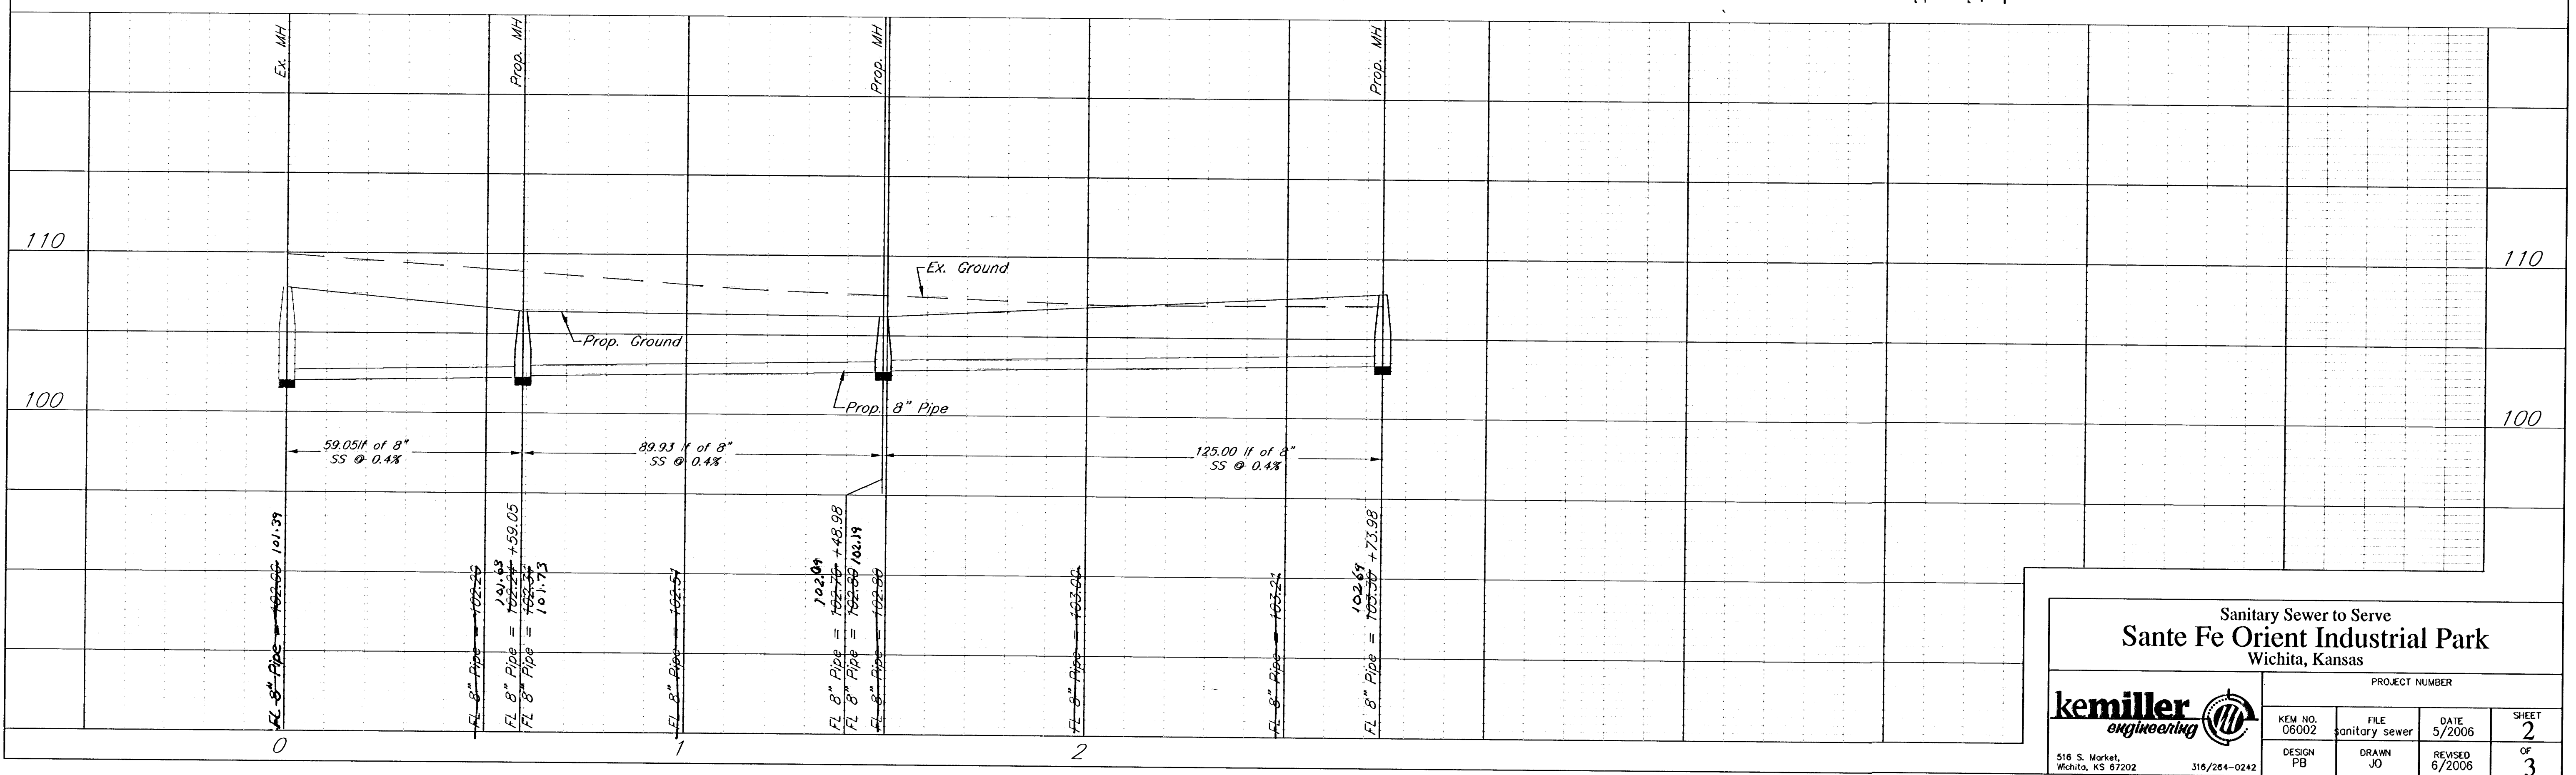
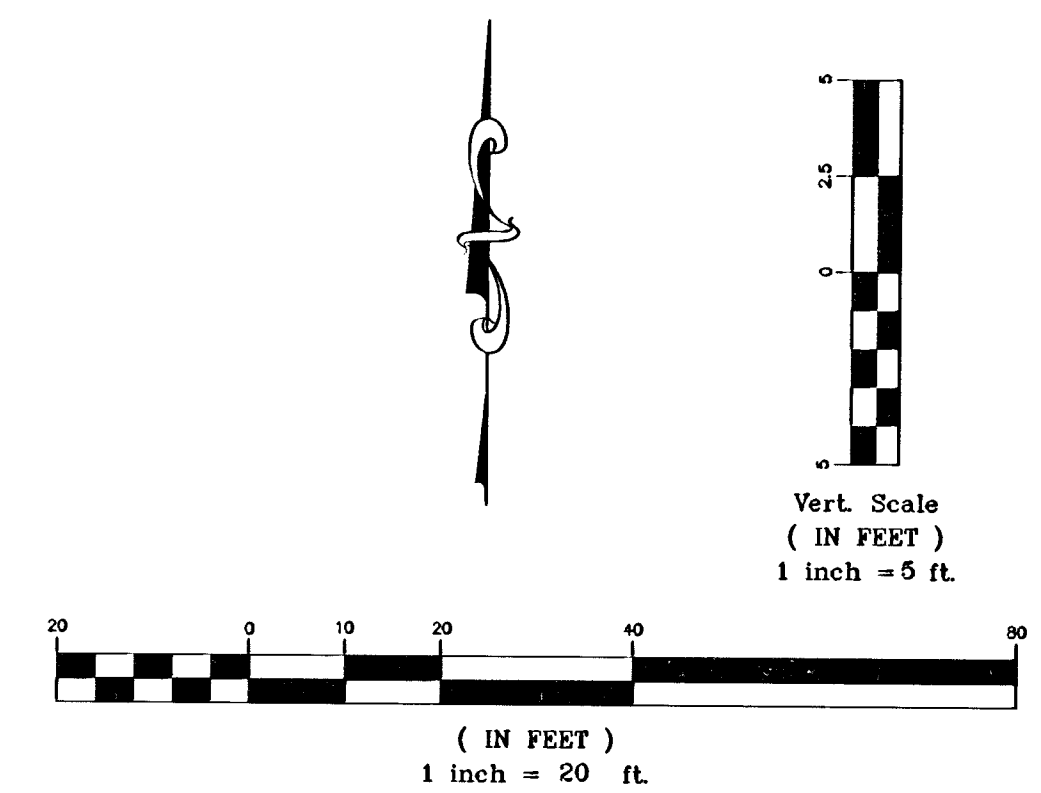


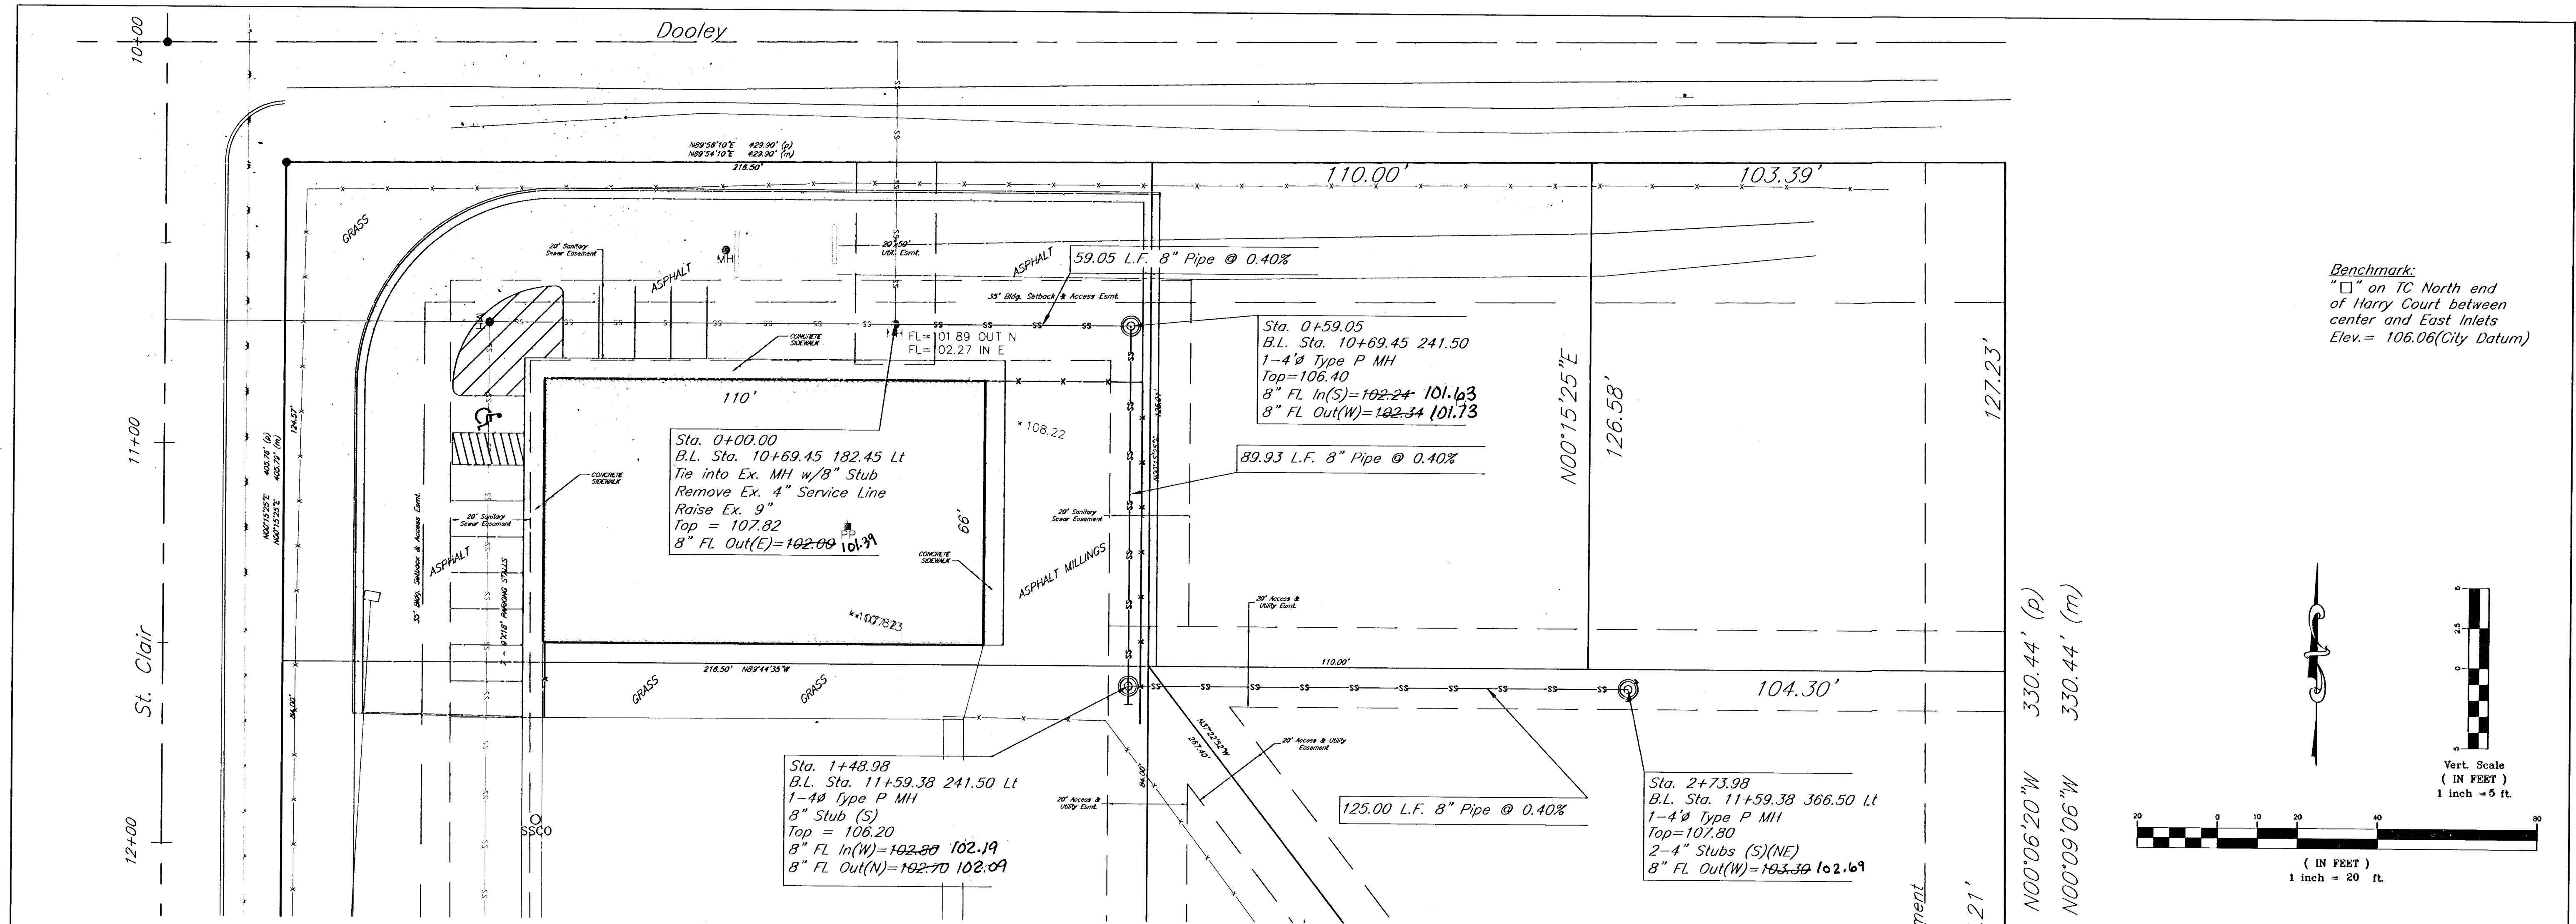

Sanitary Sewer to Serve
Sante Fe Orient Industrial Park
 Wichita, Kansas

PROJECT NUMBER			
kemiller engineering	KEM NO. 06002	FILE sanitary sewer	DATE 5/2006
DESIGN PB	DRAWN JO	REVISED 6/2006	SHEET 2 OF 3

516 S. Market, Wichita, KS 67202 316/264-0242