BENCHMARK:
HOOVER ROAD AND 35TH STREET SOUTH
CITY OF WICHITA – BENCHMARK DISC.
NE CORNER OF DECK ON R.C.B.C. ON
35TH ST. S., 100.00 FEET WEST OF HOOVER RD.
ELEV. = 1297.24 NGVD29

Ex. San.Sewer Manhole
RIM ELEV. = 1293.41
INV ELEV. = 1288.76 (City Record)

Concrete Encase 20 L.F. of
Ex. 12" Sanitary Sewer Main from
Ex. MH 5' South to 15' North

4" KIES NATURAL GAS PIPELINE

WEST RIGHT-OF-WAY LINE
HOOVER ROAD

50' Private
Access Easement

120' Drainage &
Utility Easement

Concrete Encase
Sanitary Sewer

Proposed
8" Wtr Line
Crossing

Line #1A
See Sheet 4 for Profile

Line #1B
See Sheet 4 for Profile

ECCO INDUSTRIAL 2ND
ADDITION

℄ ENTRANCE ROAD = Baseline

Line 1

90°00'00"

180°00'00"

Sta. 0+00.0, Line 1
Const. Standard Shallow Manhole
Over Ex. 12" Sanitary Sewer Main
Top Elev. = 1293.22 ~~1296.93~~
N: 4376.99 E: 9990.71

Sta. 4+00.0, Line 1
Const. Standard Shallow Manhole
Top Elev. = 1295.20 ~~1298.93~~ 1295.71
Assy. w/ 105.0 L.F. 8" Pipe (S) w/cap
N: 4376.97 E: 9590.71


Sta. 8+00.0, Line 1
Const.0 Standard Manhole
Top Elev. = 1297.90 ~~1301.63~~ 8.03
Assy. w/ 105.0 L.F. 8" Pipe (S) w/cap
N: 4376.95 E: 9190.71

20' Utility Easement
20' Building Setback

Ex. 12" San.Sewer

Scale: 1" = 40' Horizontal
1" = 5' Vertical

As Built 3/12/07 LK

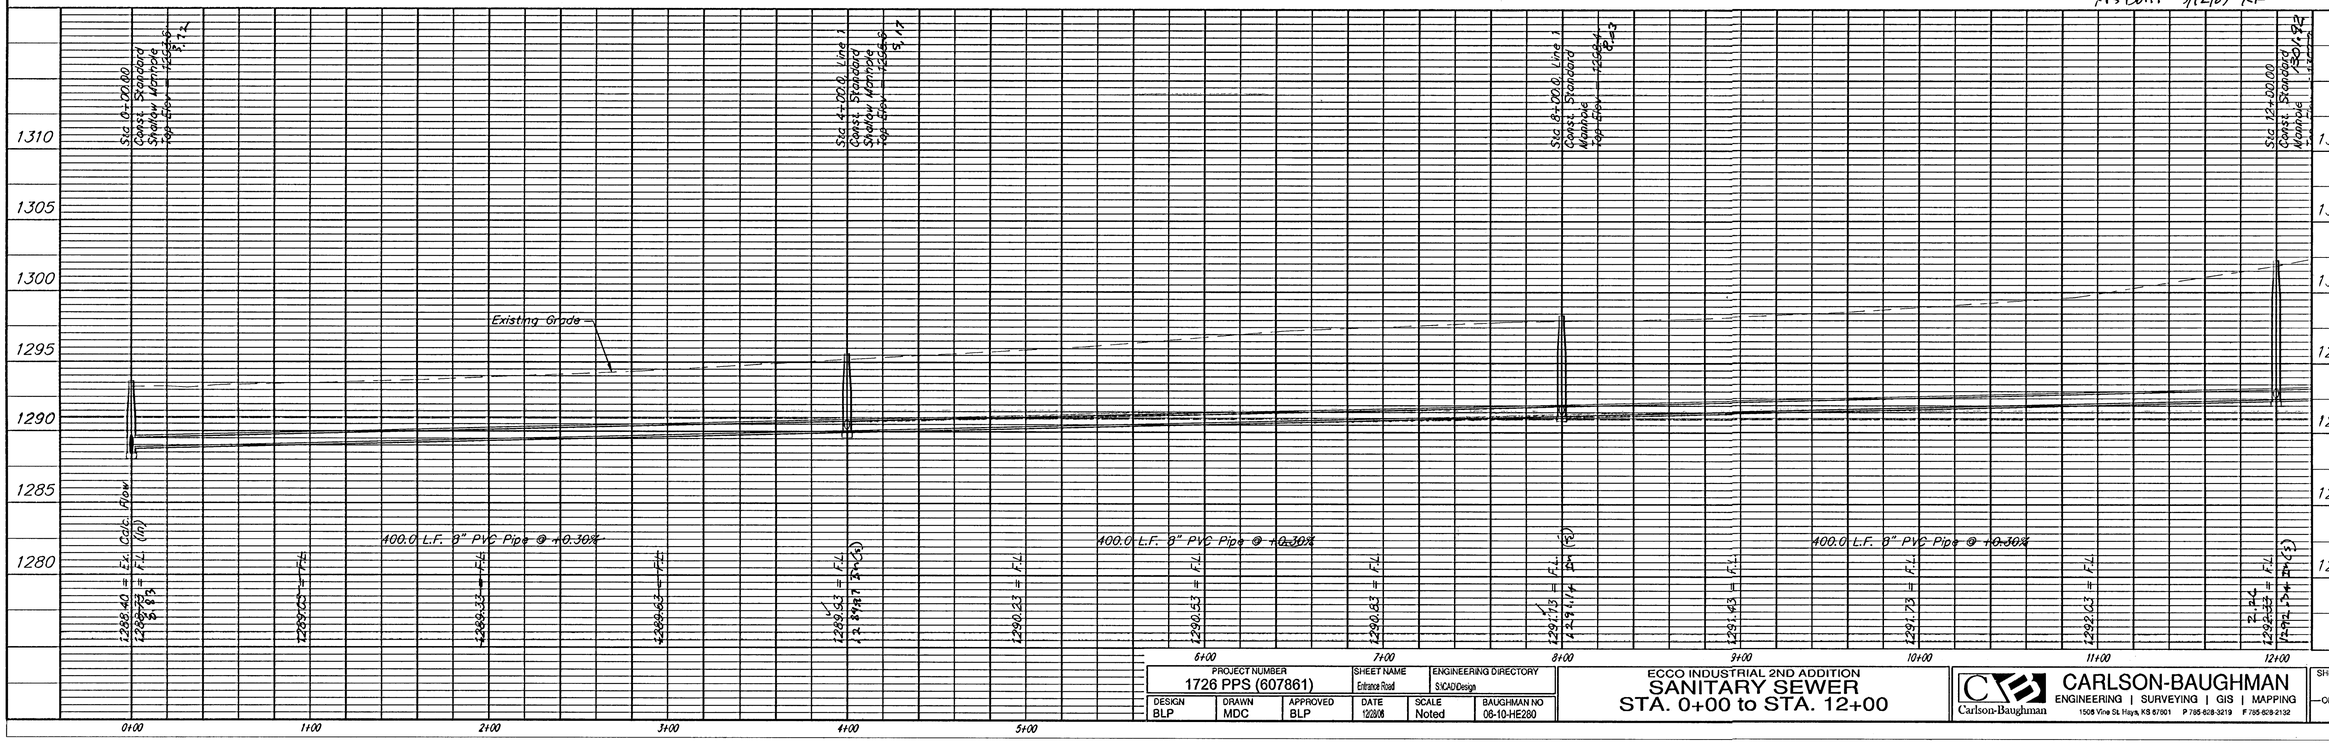


| PROJECT NUMBER | SHEET NAME | ENGINEERING DIRECTORY |
|---|---|---|
| 1726 PPS (607861) | Entrance Road | S:\CAD\Design |

| DESIGN | DRAWN | APPROVED | DATE | SCALE | BAUGHMAN NO |
|---|---|---|---|---|---|
| BLP | MDC | BLP | 12/2006 | Noted | 06-10-HE280 |

ECCO INDUSTRIAL 2ND ADDITION
SANITARY SEWER
STA. 0+00 to STA. 12+00


CARLSON-BAUGHMAN
ENGINEERING | SURVEYING | GIS | MAPPING
1508 Vine St. Hays, KS 67601 P 785-628-3219 F 785-628-2132


SHEET 2 OF 7