

PLAN	CHECKED	DATE

PROFILE	CHECKED	DATE

Saved: 10-30-2006 10:35:53 AM by C.S.
 Plot Scale: 1"=40'-0" (10'-0"=400'-0")
 Q:\2006\06572\001\06572-001-C-SSP01.CHANGECORDER.01

N-386,302.2185, E-2,373,465.5770
 Sta. 0+00.0
 Core existing concrete MH wall and
 install new 8" pipe. Seal new 8" pipe
 to MH with an approved waterstop
 gasket and non-shrink grout.
 Construct a minimum of 3' Reinforced
 Concrete Encasement from MH wall.
 Reshape MH floor to provide smooth
 flow. This work shall be considered
 subsidiary to the price bid for pipe in
 place.

CAUTION !!!
 Irrigation Well to remain in place.
 Maintain 10' separation between the
 irrigation well and sanitary sewer main.
 Center one full length pipe section of
 8" PVC pipe adjacent to the irrigation well.


N-388,078.2073, E-2,373,498.8476
 N-385,973.2193, E-2,373,496.5229
 Sta. 3+30.3 Sta. 2+25.0
 Const. MH 1
 Standard-MH Shallow MH Type "P"
 (with gasketed ball-down cover)

N-385,990.9168, E-2,373,468.1818
 Sta. 3+14.7
 Construct Cleanout #2
 See detail, sheet no. 11

N-385,508.7539, E-2,373,219.9989
 Existing Precast Concrete MH.
 Install 6" Sanitary Sewer Service Riser.
 See Sheet 10 for Sewer Service
 Schedule and details.

SCALE:
 PLAN: LAT. & LONG. 0 40 80
 PROFILE: HORIZ. SAME AS ABOVE
 VERT. 0 5

①
 ②
 DENOTES SEWER SERVICE
 SEE SHEET NO. 10 FOR SEWER
 SERVICE SCHEDULE AND DETAILS

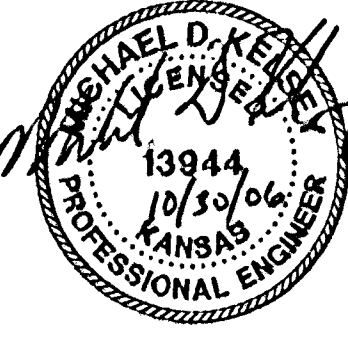

SANITARY SEWER LINE NO. 1

SEWER SERVICE TO EXISTING MH

