



BENCHMARKS:
Maize Road and 21st Street North, City of
Wichita Benchmark Disc on the Southeast
Corner of Intersection. 64' East and 99'
South of Centerline both.
Elevation = 164.30 (per City record)

"□" Cut in Centerline Headwall of R.C.B.C.,
East side of Maize Road. 600' +/- South
of 21st Street North
Elevation = 164.93 (City Datum)

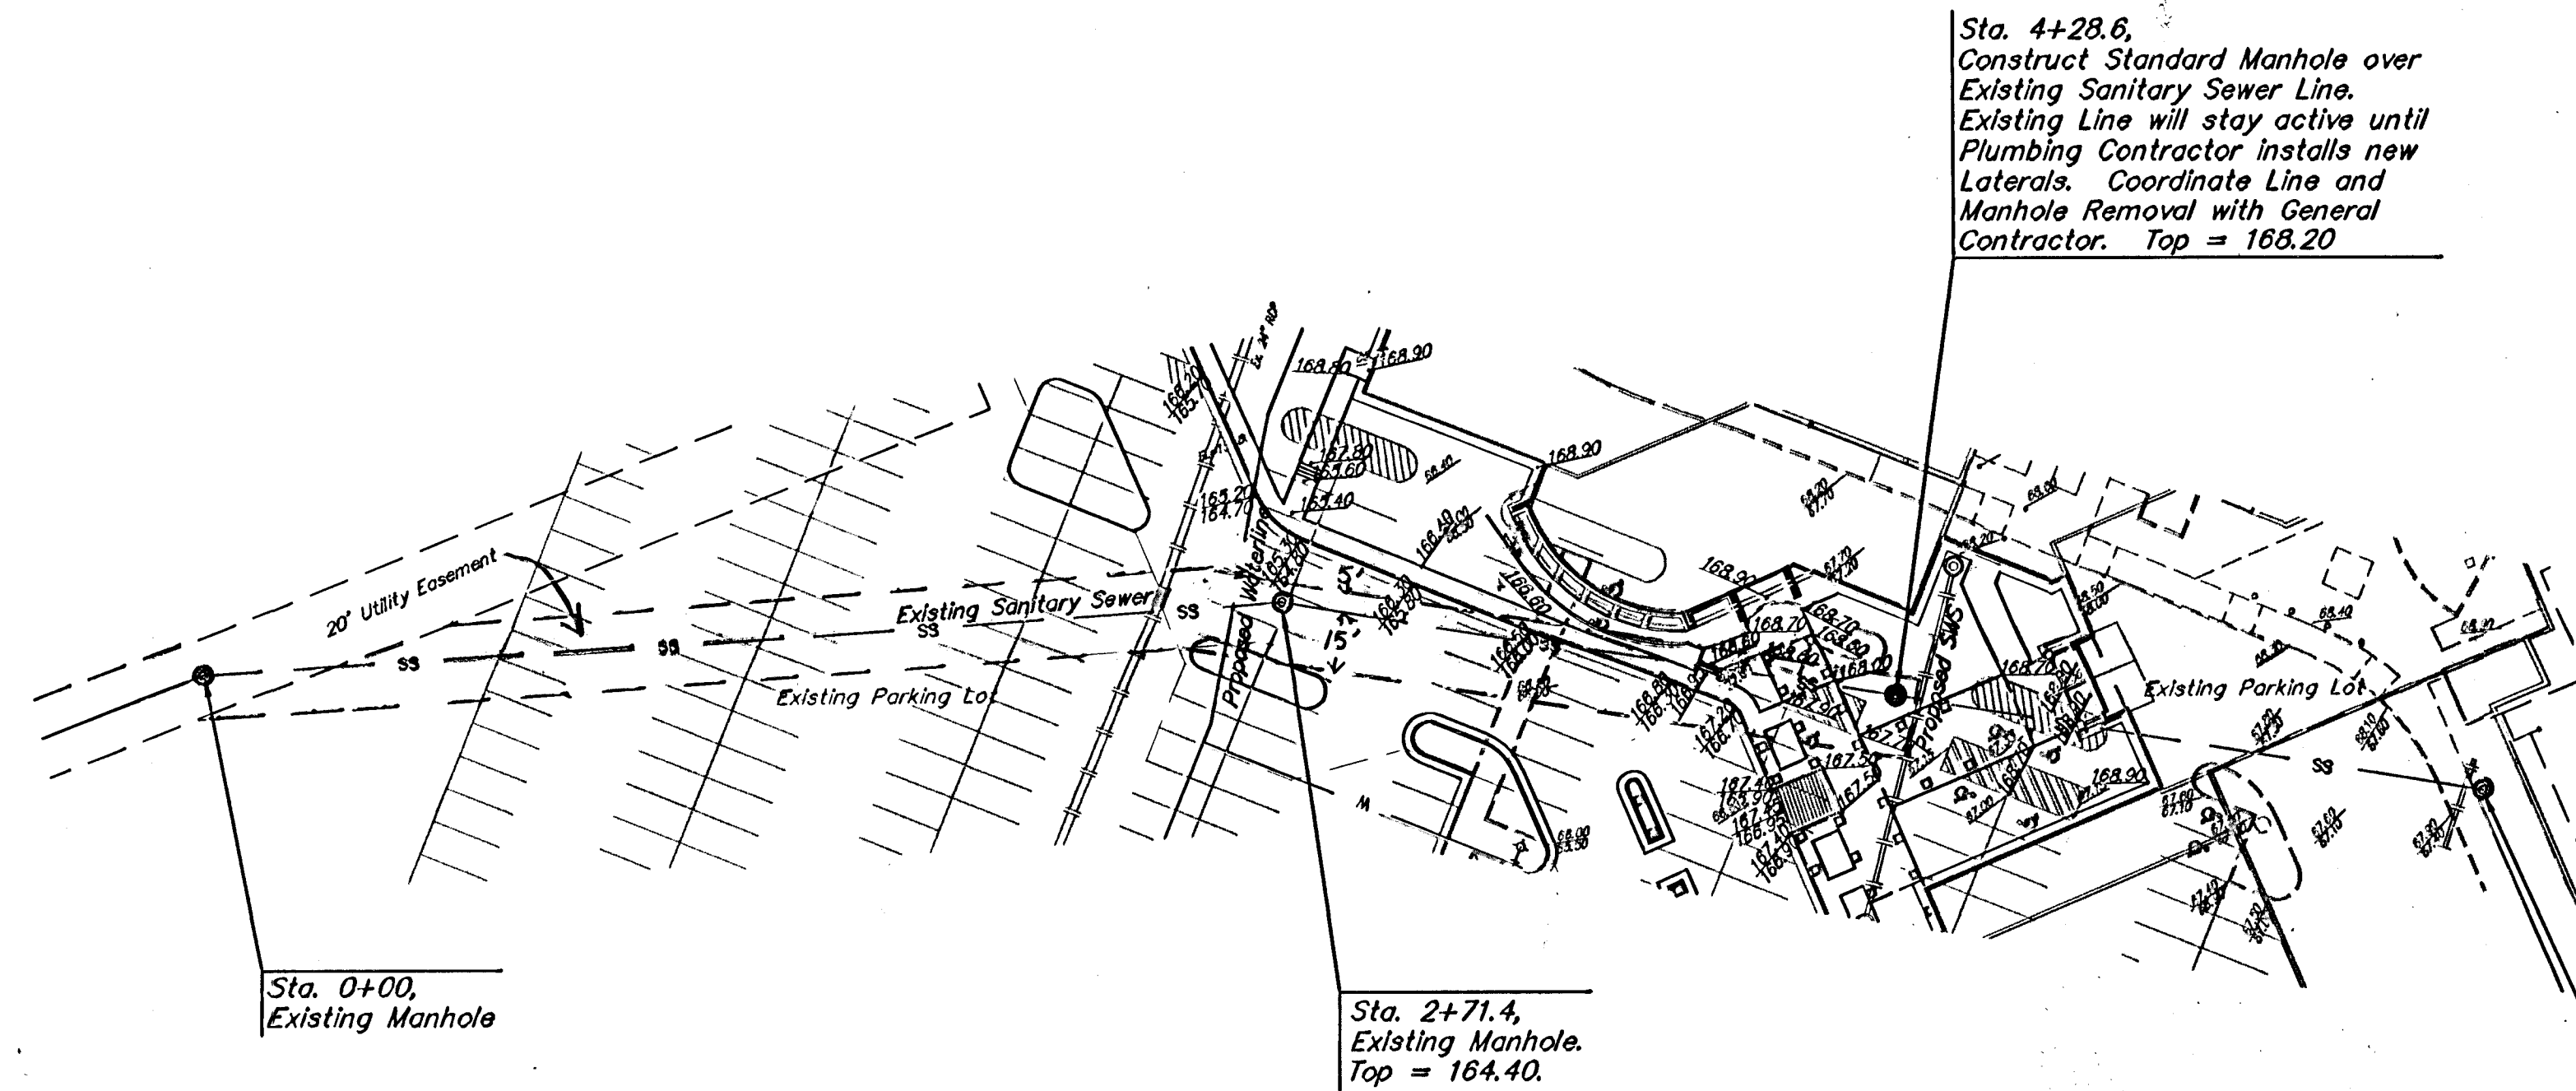

Note: 99' easement from
Sta. 4+32.6 to southeasterly
and to be vacated.
Book P, Page 217 amended.

Sta. 5+79.1,
Existing Manhole. Remove
Structure as needed during
construction. Coordinate
with General Contractor.

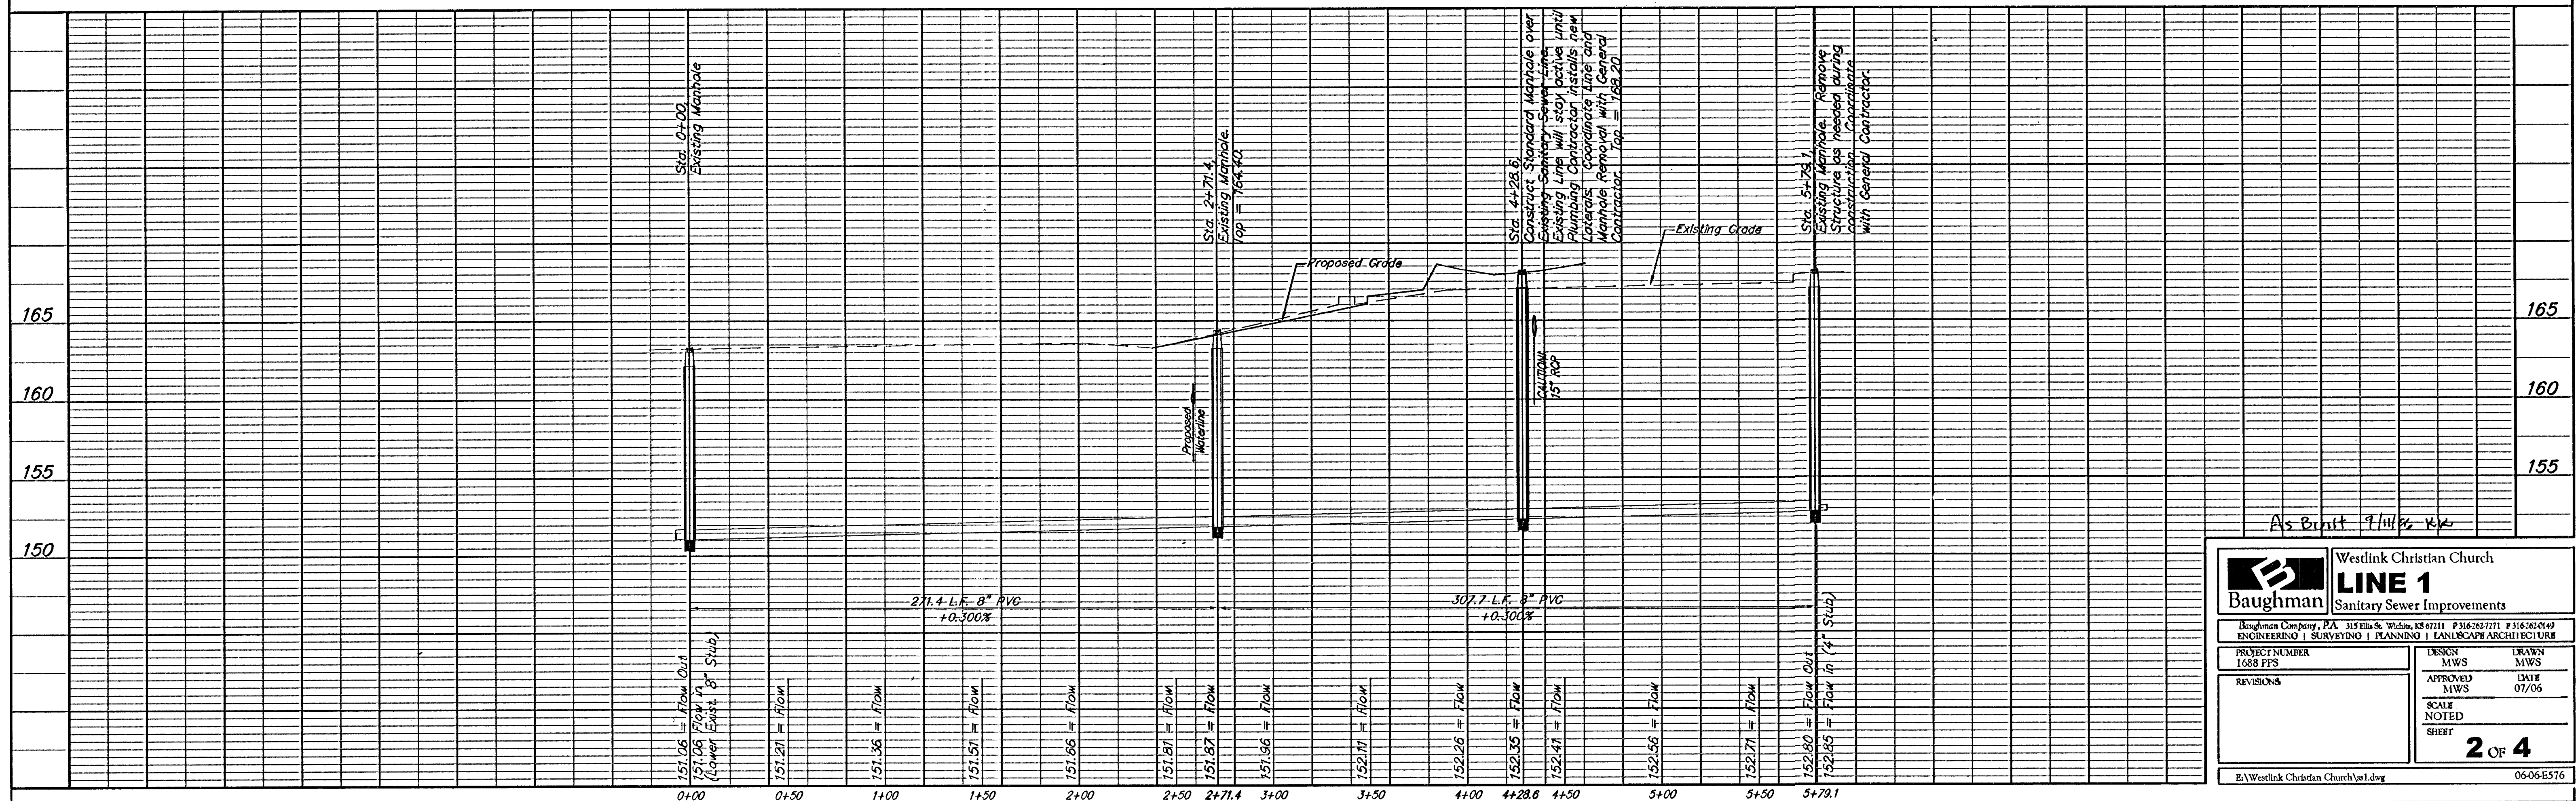

As Buit 9/11/20 K2

Baughman		Westlink Christian Church	
LINE 1		Sanitary Sewer Improvements	
Baughman Company, P.A. 315 Ellis & W. 11th, P.O. Box 202771, F3162620149 ENGINEERING SURVEYING PLANNING LANDSCAPE ARCHITECTURE			
PROJECT NUMBER 1688 EFS		DESIGN MWS	DRAWN MWS
REVISIONS		APPROVED MWS	DATE 07/06
		SCALE NOTED	SHEET 2 OF 4
E:\Westlink Christian Church\w1.dwg		06-06-E576	