
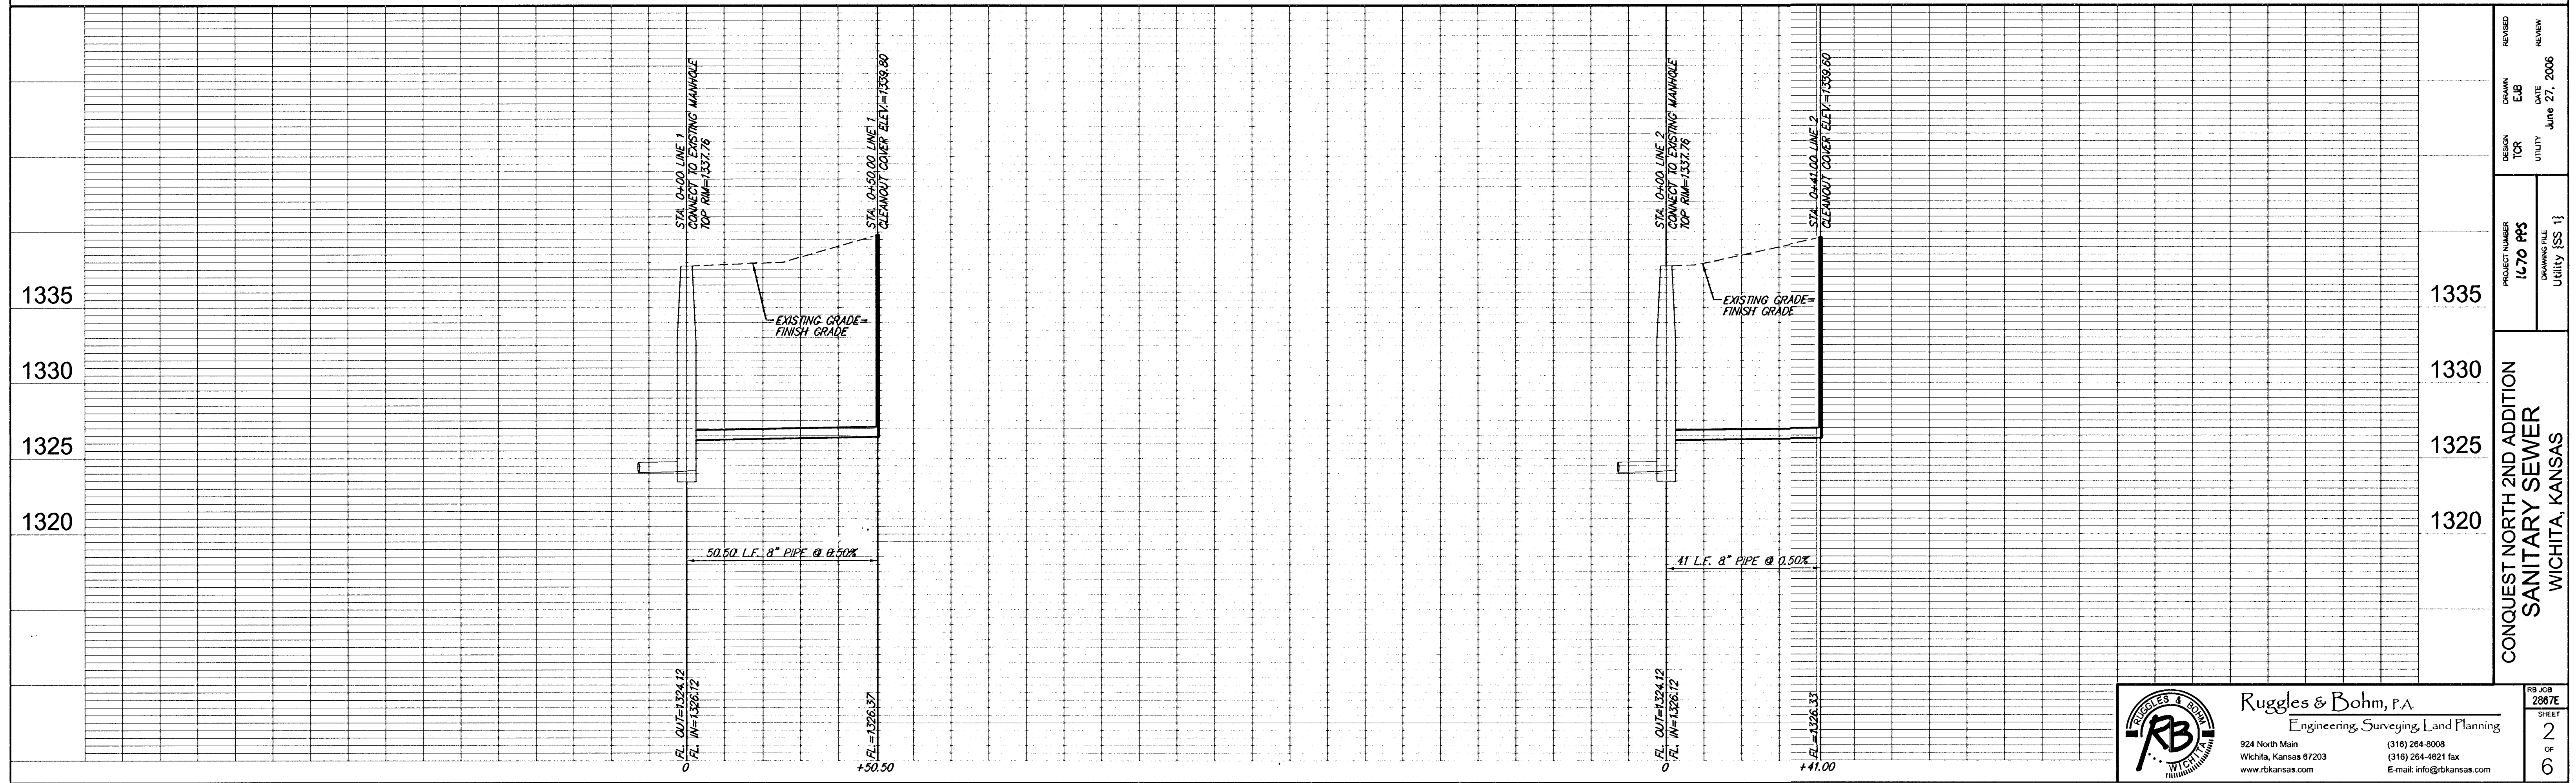
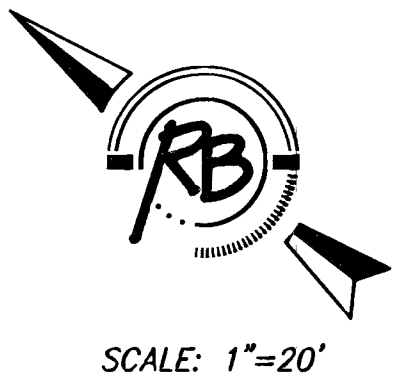
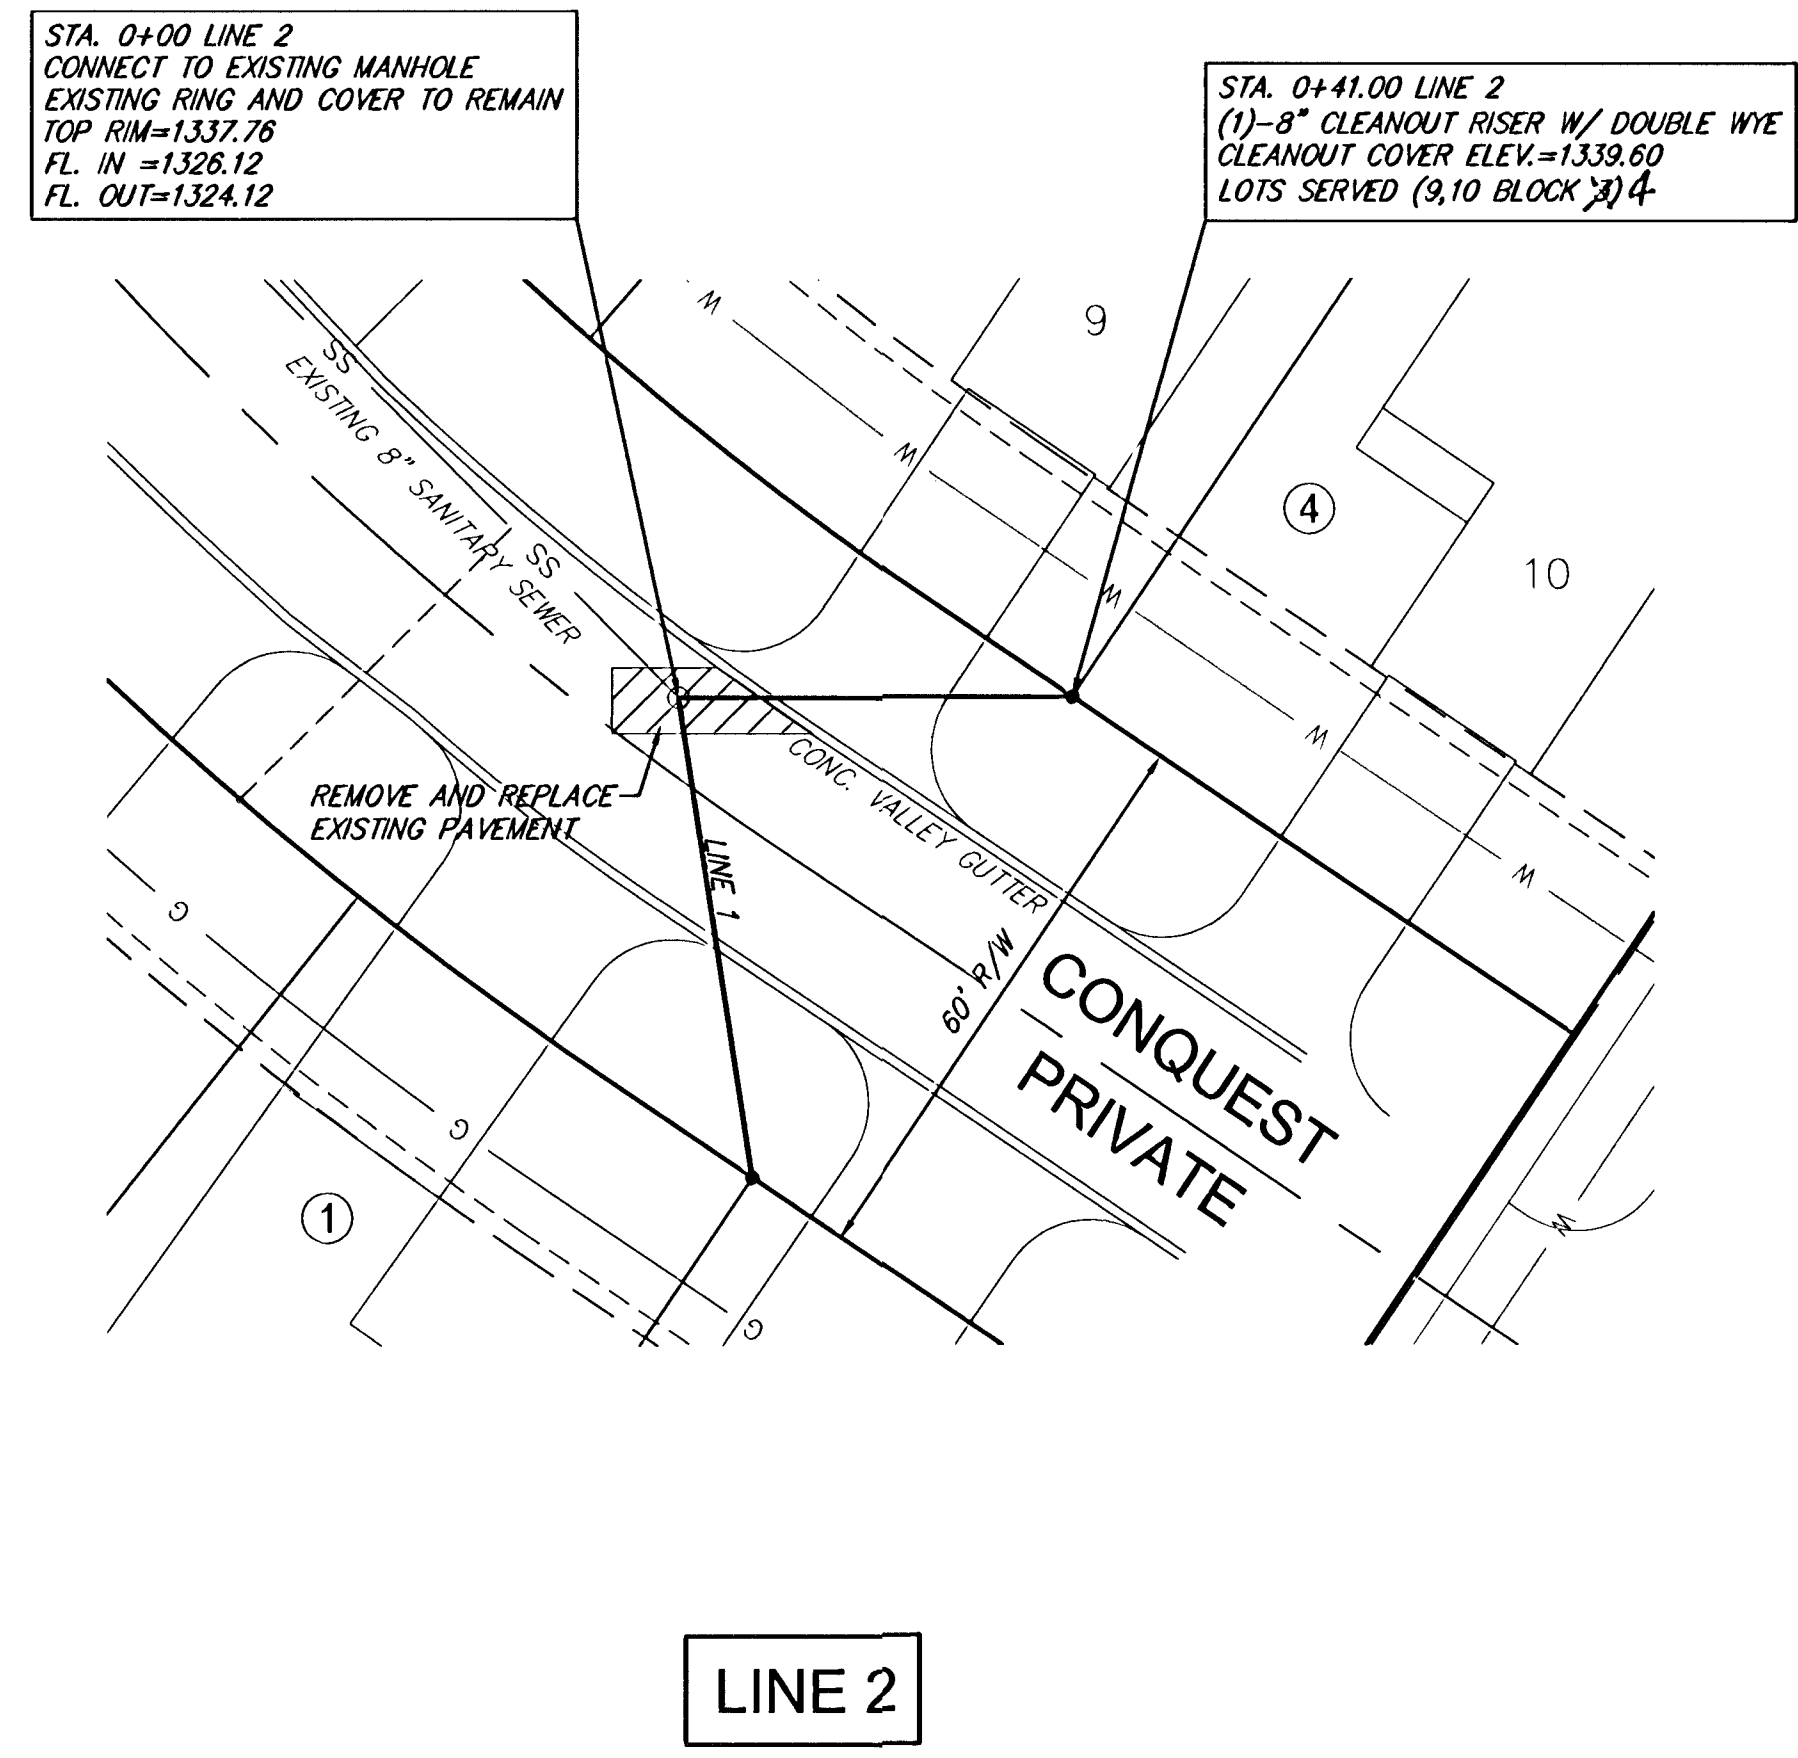


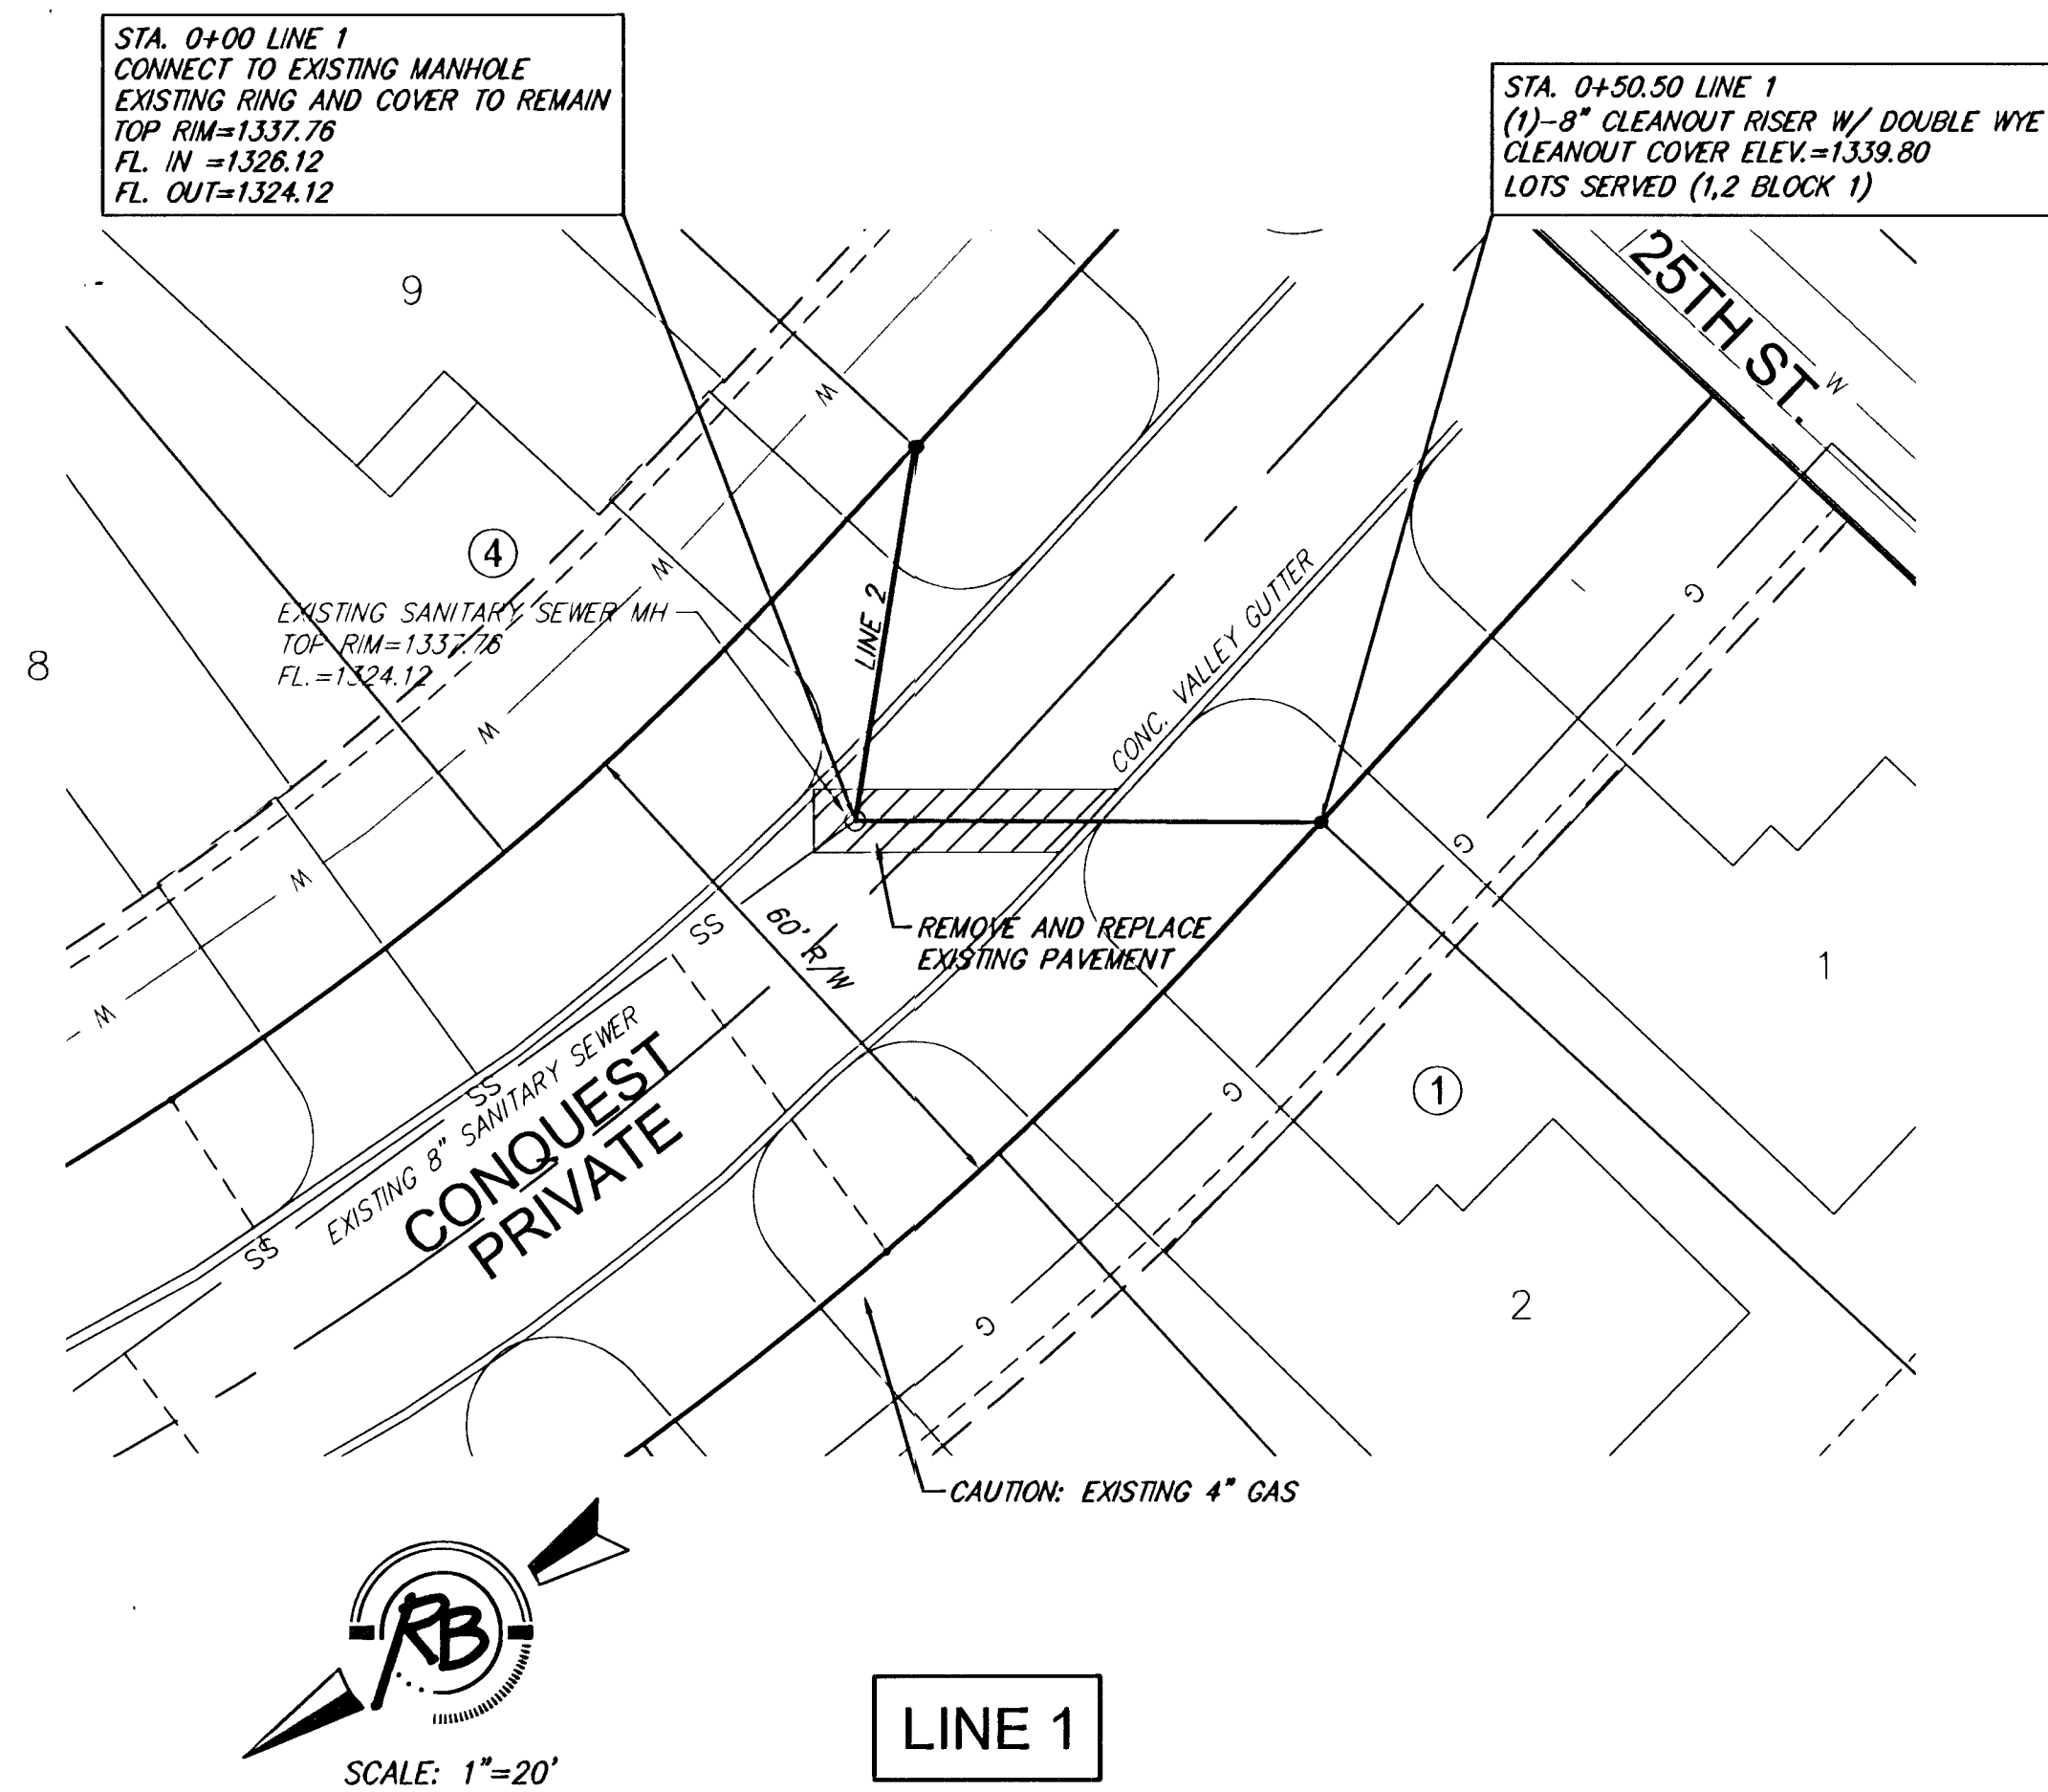

Ruggles & Bohm, P.A.
Engineering, Surveying, Land Planning

324 North Main
Wichita, Kansas 67203
www.rbkansas.com

(316) 264-8008
(316) 264-4921 fax
E-mail: info@rbkansas.com

RB JOB
2887E
SHEET

2

OF

0

CONQUEST NORTH 2ND ADDITION SANITARY SEWER WICHITA, KANSAS	DESIGN	DRAWN	REVISED
	TCR	EJB	DATE
	UTILITY	JUNE 27, 2006	REVIEW
PROJECT NUMBER	DRAWING FILE	DATE	REVIEW
1470 PPS	Utility [S] 13	JUNE 27, 2006	REVIEW