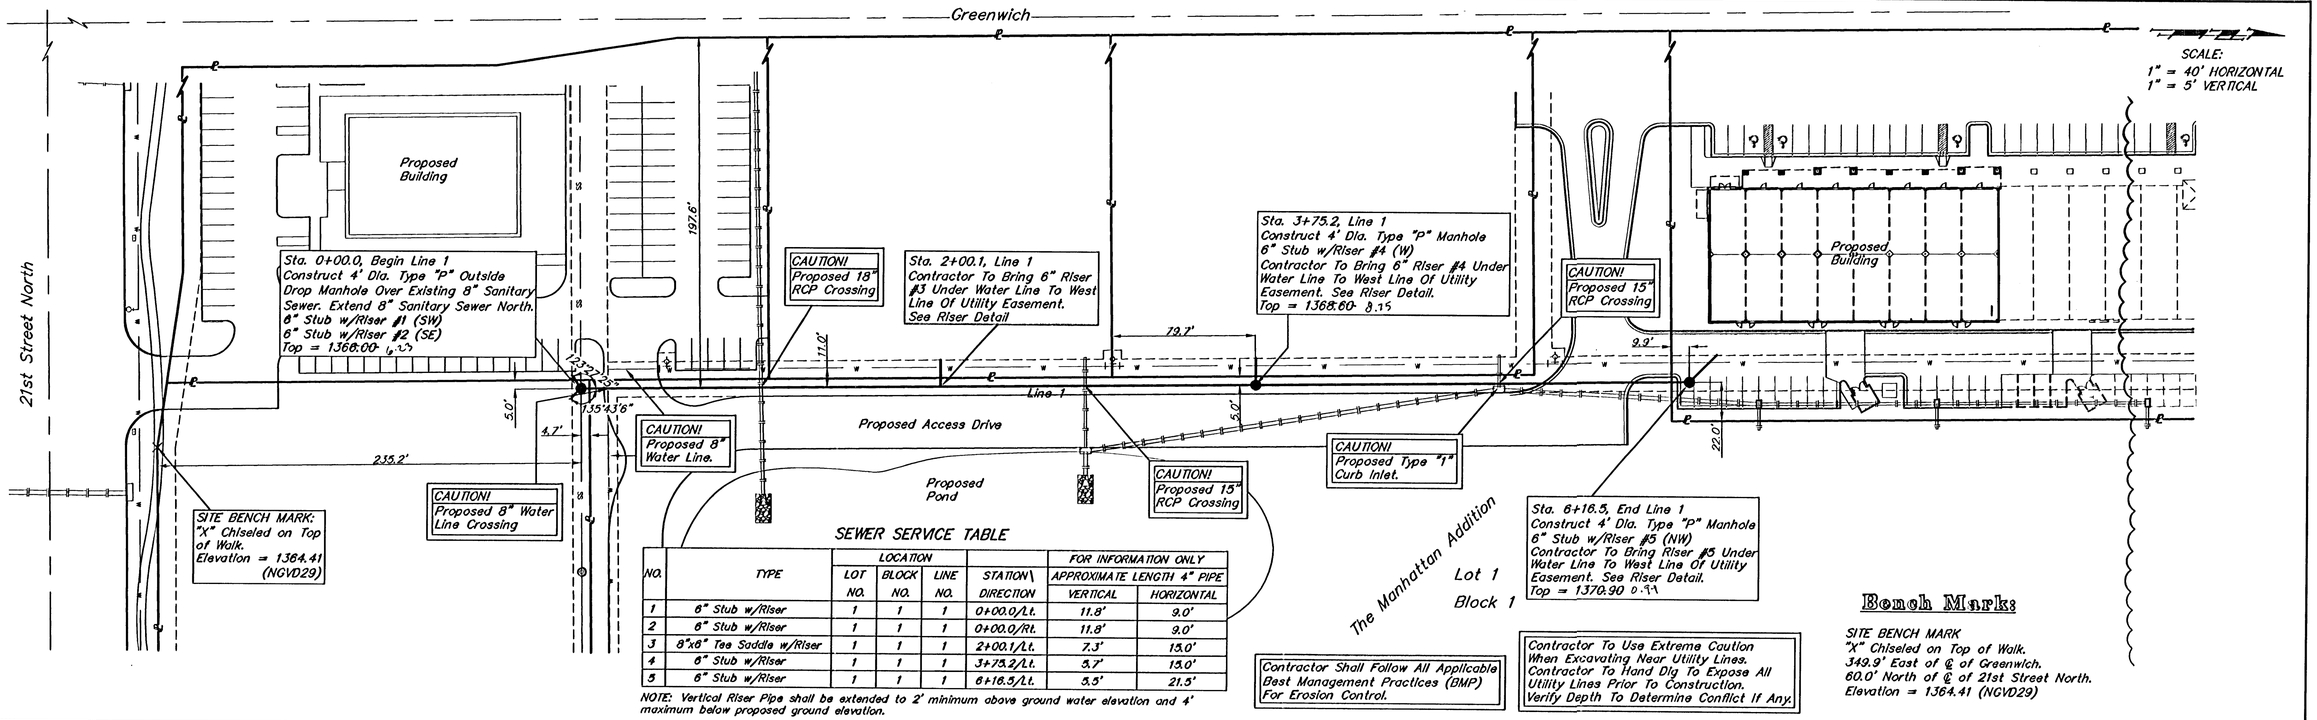

SEWER SERVICE TABLE

NO.	TYPE	LOCATION			STATION\ DIRECTION	FOR INFORMATION ONLY	
		LOT NO.	BLOCK NO.	LINE NO.		APPROXIMATE LENGTH 4" PIPE	
						VERTICAL	HORIZONTAL
1	6" Stub w/Riser	1	1	1	0+00.0/Lt.	11.8'	9.0'
2	6" Stub w/Riser	1	1	1	0+00.0/Rt.	11.8'	9.0'
3	8"x6" Tee Saddle w/Riser	1	1	1	2+00.1/Lt.	7.3'	15.0'
4	6" Stub w/Riser	1	1	1	3+75.2/Lt.	5.7'	15.0'
5	6" Stub w/Riser	1	1	1	6+16.5/Lt.	5.5'	21.5'

NOTE: Vertical Riser Pipe shall be extended to 2' minimum above ground water elevation and 4' maximum below proposed ground elevation.

Baughman

Sanitary Sewer To Serve
The Manhattan Addition
Lot 1, Block 1

Baughman Company, P.A. 315 Ella St. Wichita, KS 67211 P 316.262.2771 F 316.262.0149
ENGINEERING | SURVEYING | PLANNING | LANDSCAPE ARCHITECTURE

PROJECT NUMBER 1681 PFS (607861)	DESIGN LU	DRAWN LU
REVISIONS	APPROVED LU	DATE 9/06
	SCALE Noted	
	SHEET 2 OF 4	

Village at Greenwich\SS-1R 05-11-E406