

BENCHMARK:  
CITY OF WICHITA DISC - MAIZE RD. &  
STERLING, (2400 BLOCK N.), TOP OF  
CURB, WEST END OF MEDIAN ON C OF  
STERLING.  
61' E. OF C OF MAIZE RD.  
ELEV. = 1353.57 NGVD29

SMALL RAILROAD SPIKE IN E. FACE  
OF POWER POLE, 34.6' S. & 6.9' W.  
OF THE NW COR. OF LOT 2, BLOCK A.  
ELEV. = 1351.99 NGVD29

Manhole Adjustment  
Exist. elev.=1353.20. Lower to NEW  
Elev.=1352.20

Sta. 0+00 to Sta. 2+07.2, Line 1  
Sanitary Sewer trench shall be  
sand backfilled and flushed.

Proposed  
Waterline  
Crossing

PROPOSED  
REST.

Sta 0+00.0, Begin Line 1  
Construct new manhole over existing  
sanitary sewer line. Extend 8" pipe  
northwest. Cut out, seal and grout  
around pipe. Cost of coring, sealing,  
grouting, reshaping, etc. to be  
incidental to cost of pipe.  
Top = 1352.65

CAUTION!  
Ex. Telephone  
Line Crossing

CAUTION!  
Ex. Undgd. Elec.  
Line Crossing

Sta 2+07.2, End Line 1  
Construct std. manhole.  
1 - 6" Stub (NW)  
Rim Elev. = 1353.40


Sta. 0+00 to Sta. 2+07.2, Line 1  
Sanitary Sewer trench shall be  
sand backfilled and flushed.

Existing Utilities on site should be  
disconnected prior to start of  
Construction. Contractor to verify and  
coordinate with General Contractor.

Contractor to remove trees, fence, signs,  
poles, etc. as needed for sanitary sewer  
construction. Removal of items shall be  
incidental to "Site Clearing and Restoration".



Scale: 1" = 40' Horizontal  
1" = 5' Vertical  
• = Iron

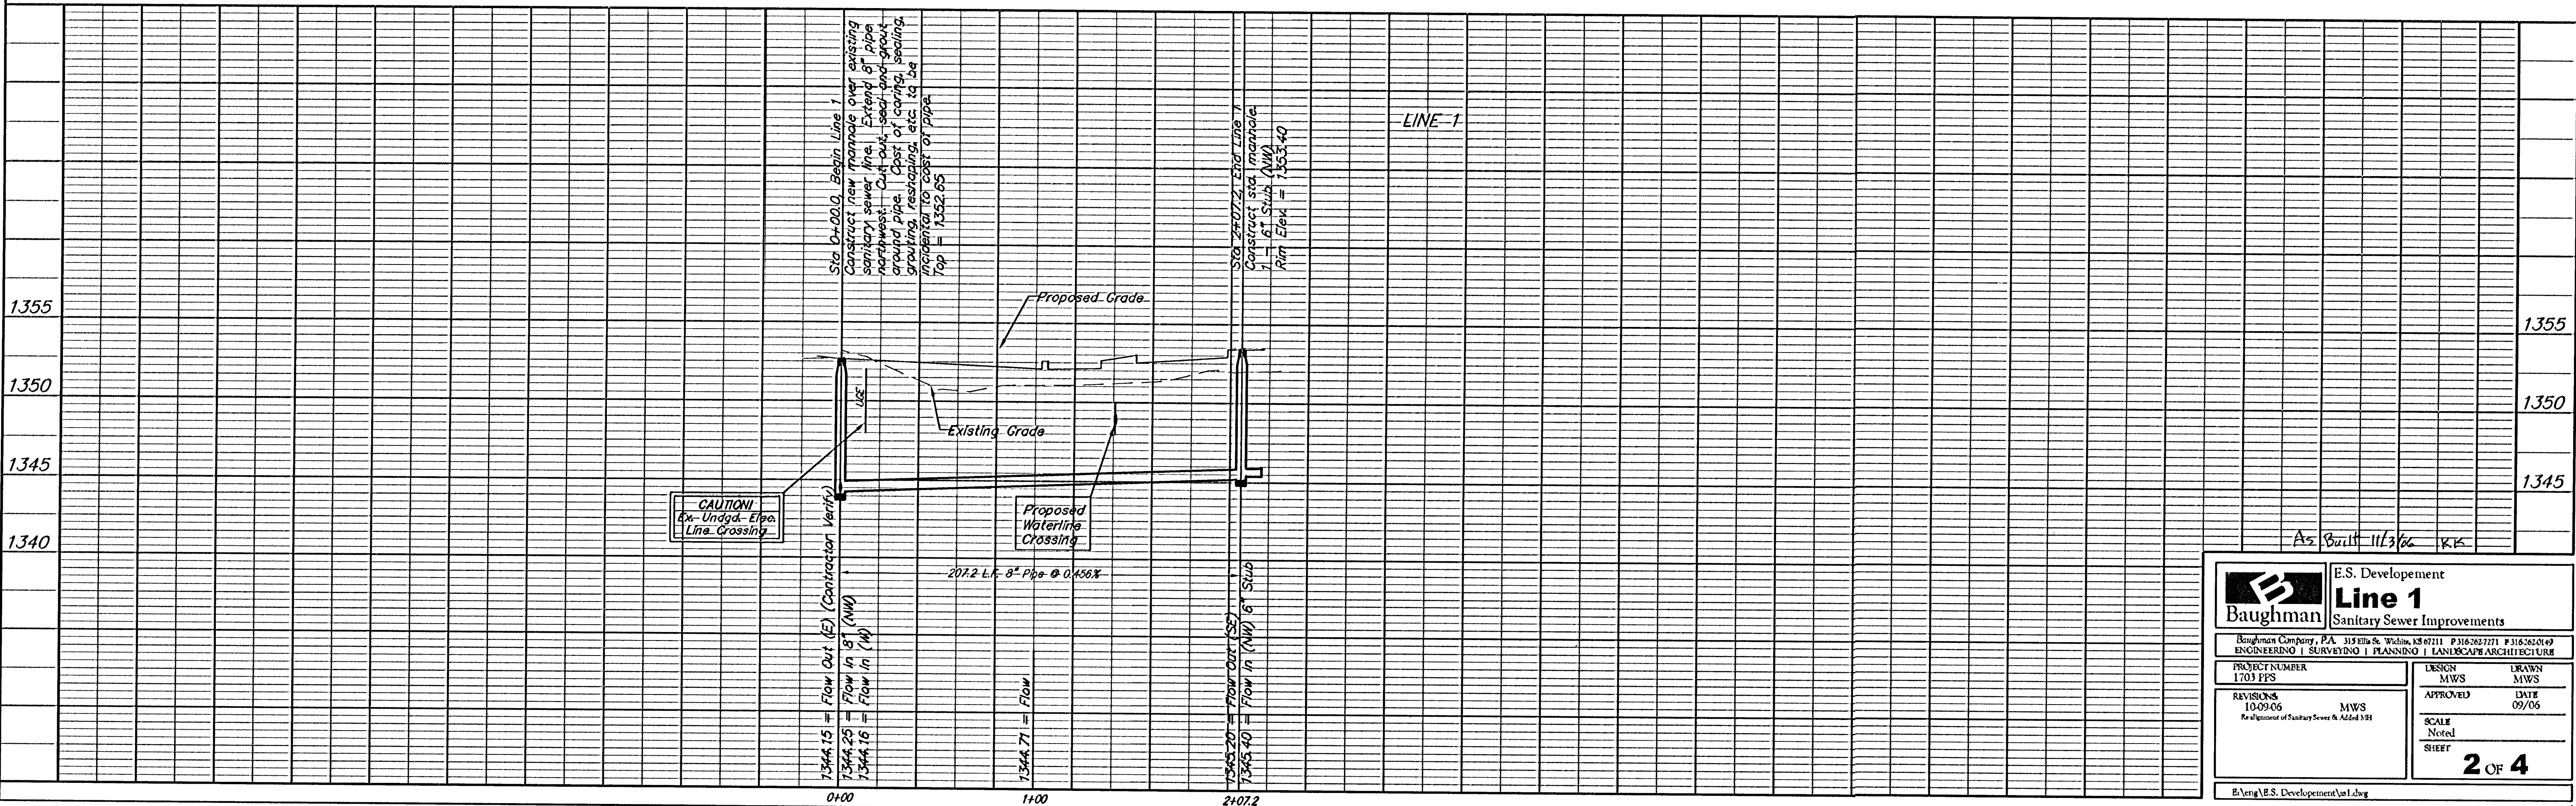



E.S. Development

**Line 1**

Sanitary Sewer Improvements

PROJECT NUMBER  
1703 FFS

REVISIONS  
10-09-06  
MWS  
The Alignment of Sanitary Sewer & Added S&S

DESIGN  
MWS

APPROVED  
DATE  
09/06

DRAWN  
MWS

SCALE  
Noted  
SHEET  
**2 OF 4**

Baughman Company, P.A. 315 Ellis St. Wichita, KS 67211 P 316-262-7271 F 316-262-0149

ENGINEERING | SURVEYING | PLANNING | LANDSCAPE ARCHITECTURE

B:\eng\ES.Development\ss1.dwg