


PART B: LIGHTING & LANDSCAPE PLANS FOR
STEEPLE BAY ADDITION
WICHITA, KANSAS

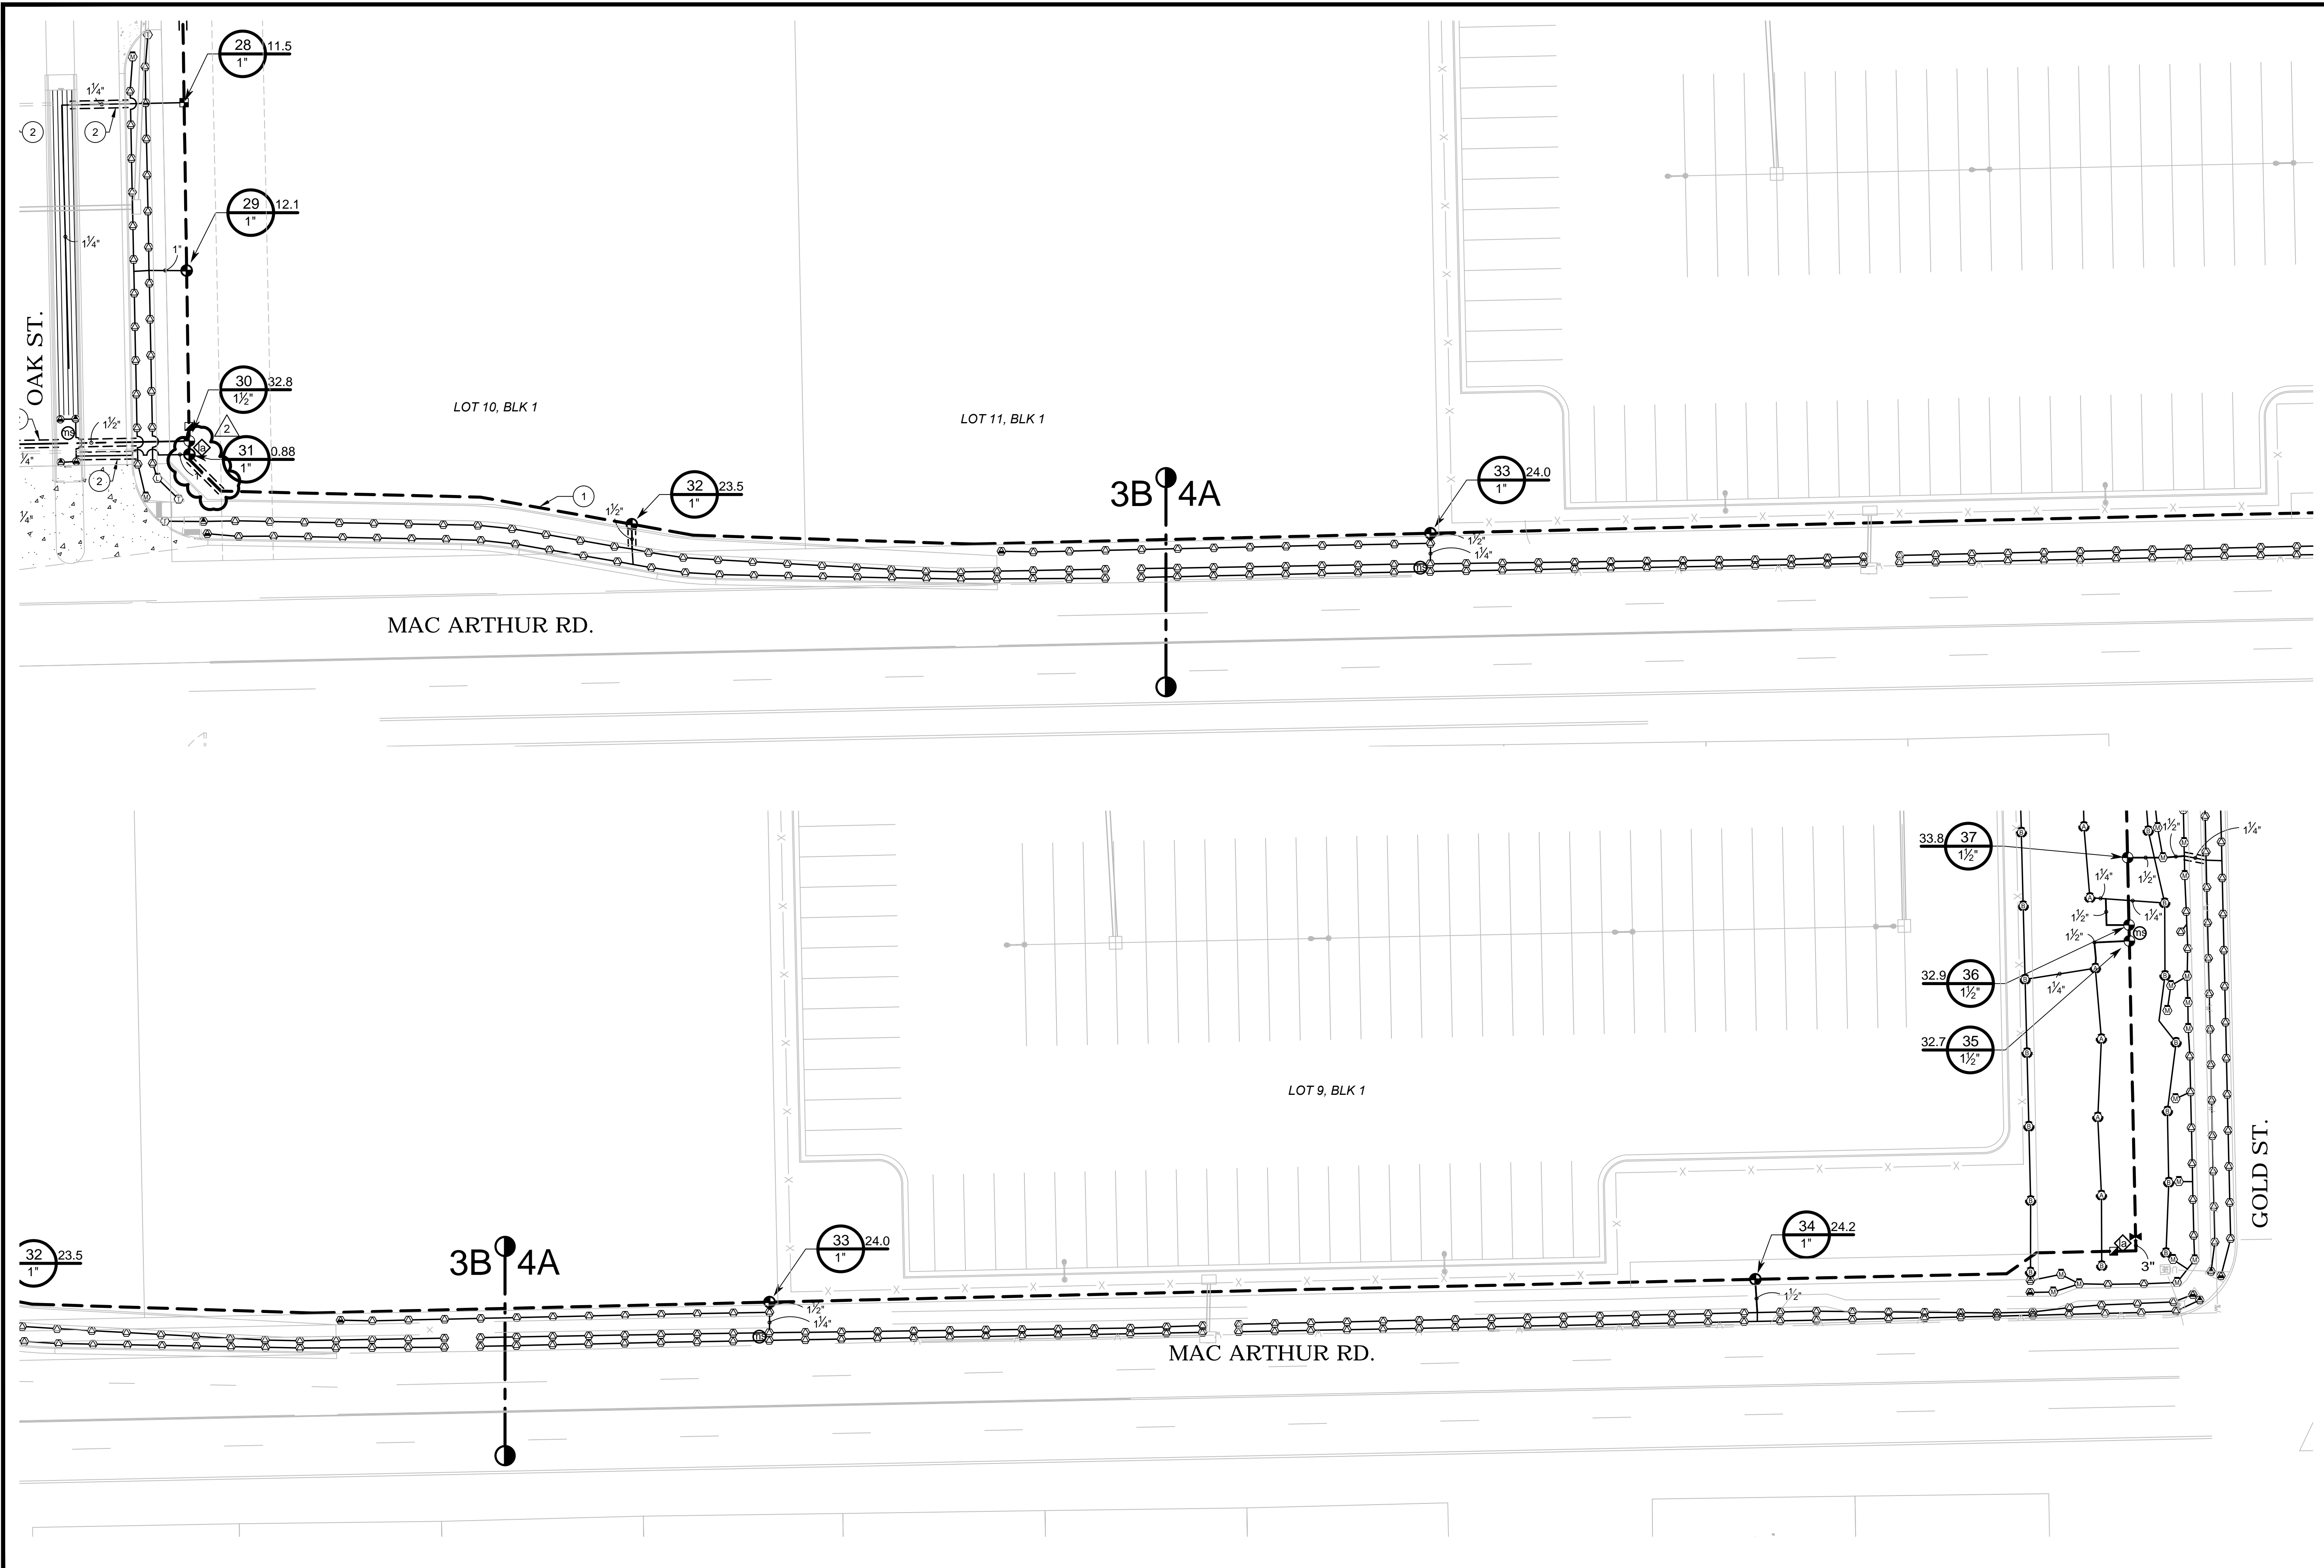

©2019
MKEC Engineering
All Rights Reserved
www.mkec.com
These drawings and their contents, including, but not limited to, all concepts, designs, & ideas are the exclusive property of MKEC Engineering (MKEC), and may not be used or reproduced in any way without the express consent of MKEC.

IRRIGATION PLAN

PROJECT NO.	1701010143	
DATE	MAY 2019	
SCALE	1" = 30'	
DESIGNED	DRAWN	CHECKED
JWR	JCM	JWR

NO.	REVISION	DATE
2	UPDATED SLEEVING	06.05.19