


Benchmark:
City Disc In T.C. Adj. to F.H.
38' South of Intersection of
Onewood and Auburn Hills.
Elev. = 178.48 (City Datum)



"□" cut in south curb of
Onewood 272' west of C.L.
Auburn Hills.
Elev. = 179.73 (City Datum)

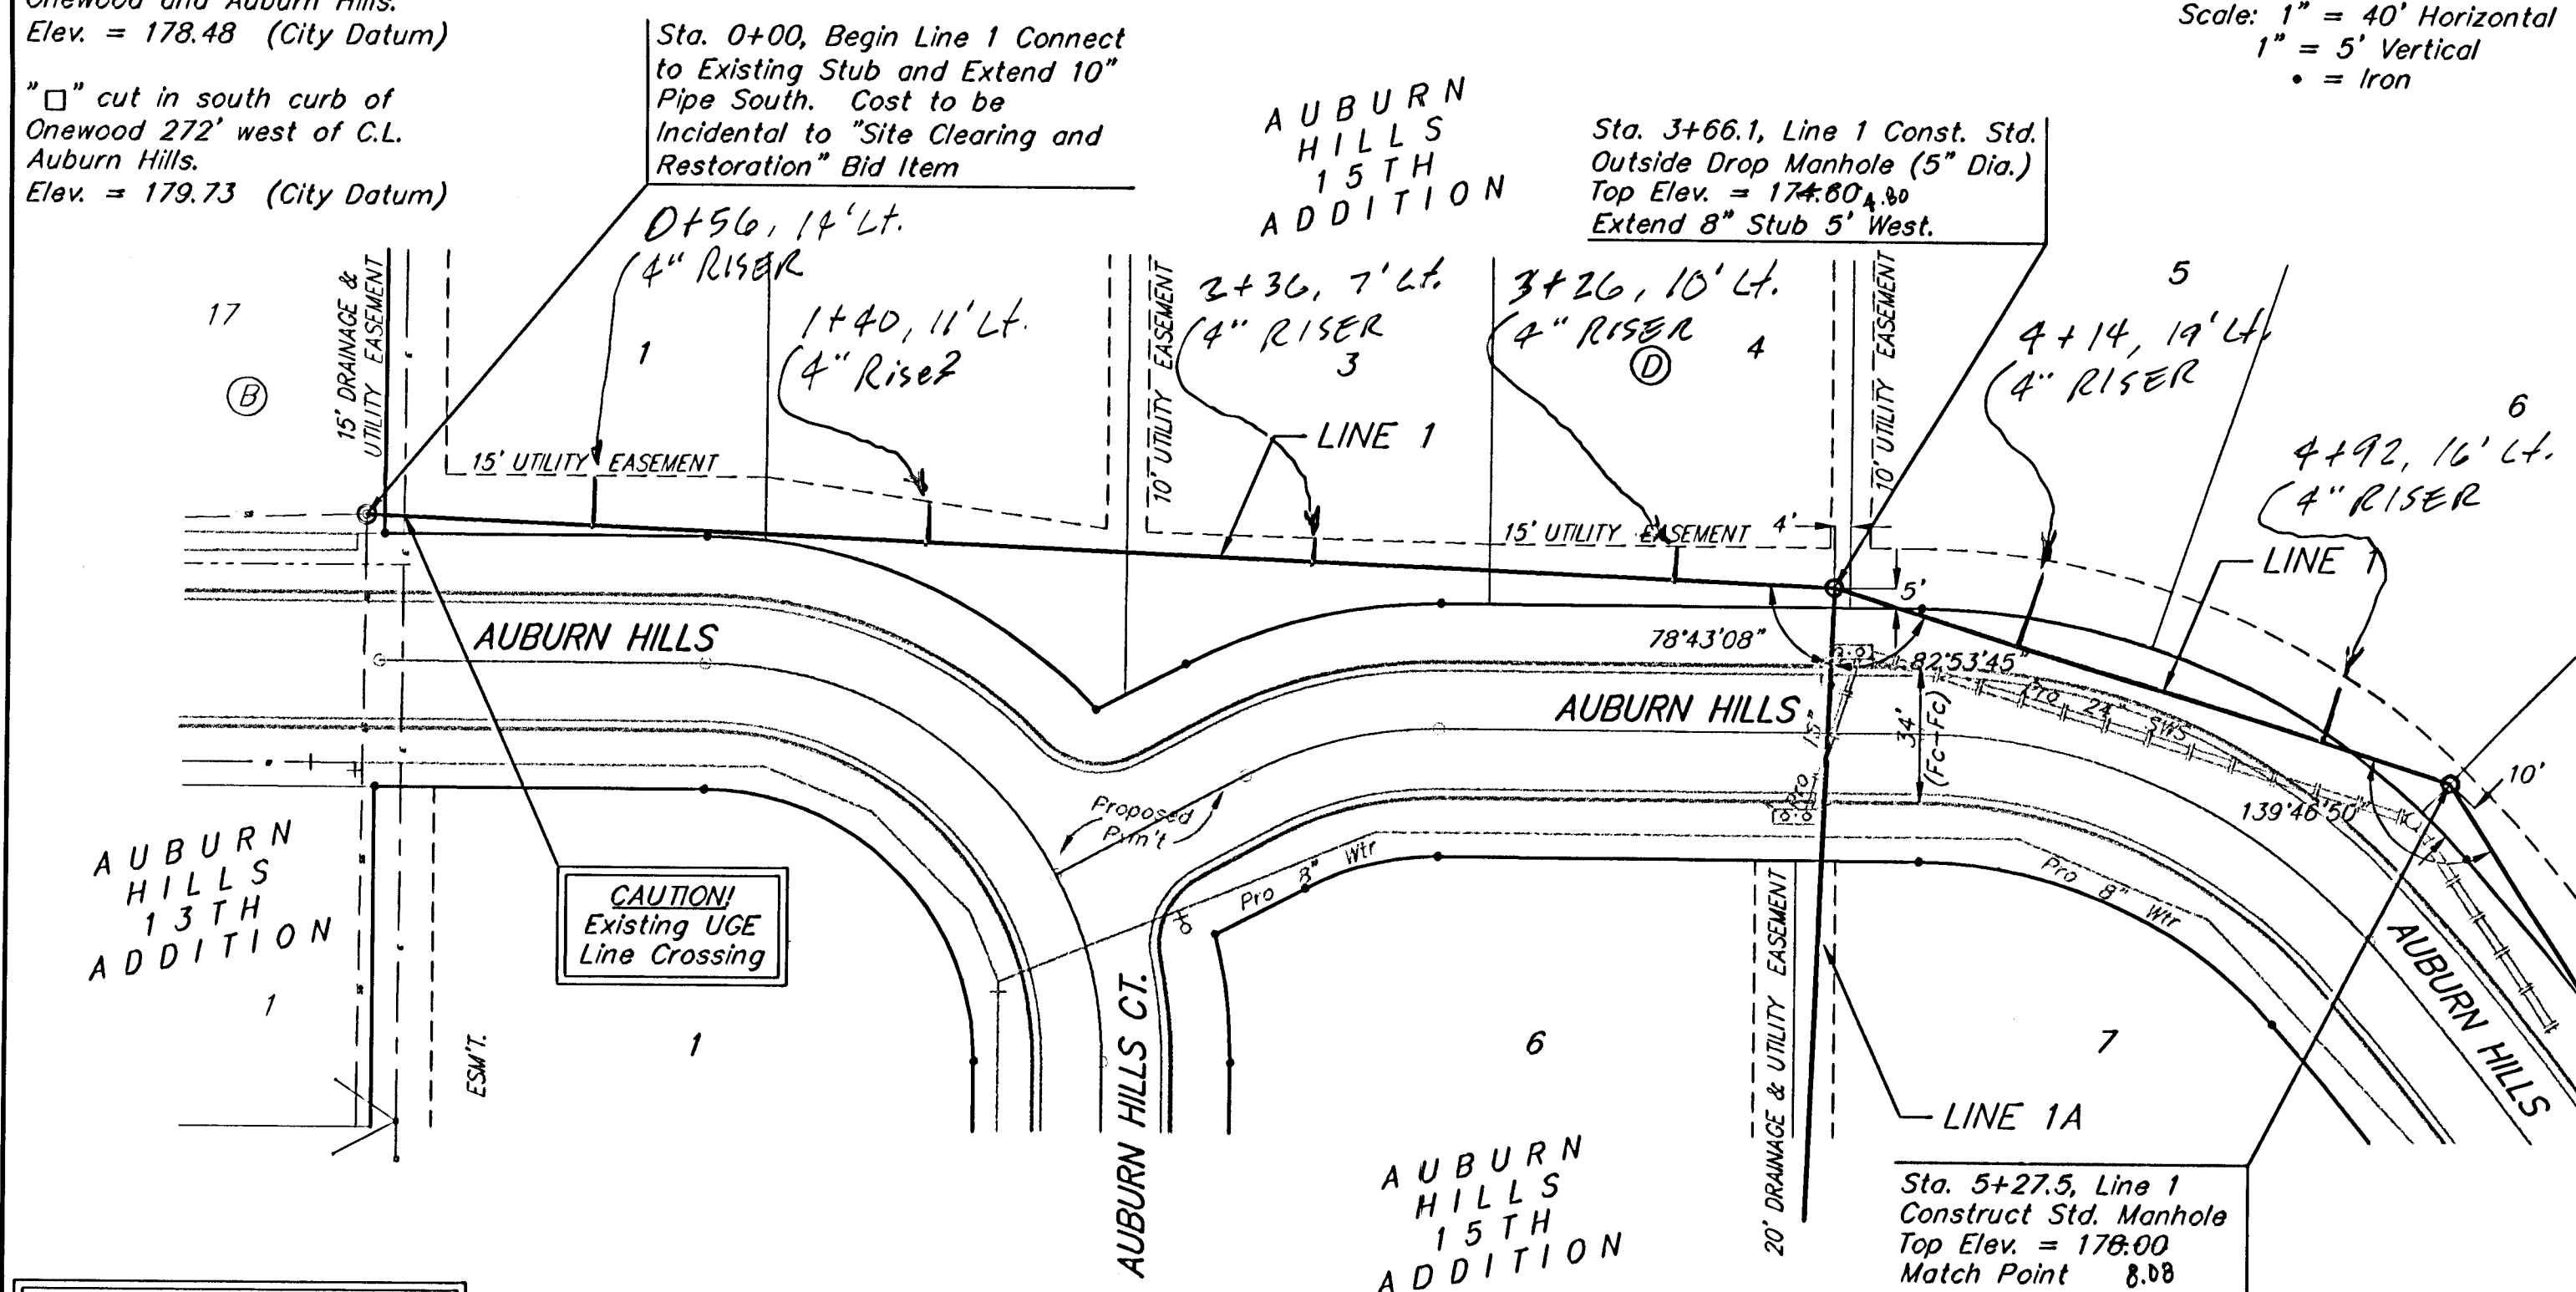

Remove trees ONLY as necessary for sanitary sewer construction. Cost of removal to be incidental to lump sum bid item "Site Clearing & Restoration".

The contractor shall be required to backfill trench with sand from Sta. 0+00 to Sta. 9+55.1, Line 1 excluding locations where flowable fill is called out. All costs shall be subsidiary to pipe cost.

Remove trees ONLY as necessary for sanitary sewer construction. Cost of removal to be incidental to lump sum bid item "Site Clearing & Restoration".

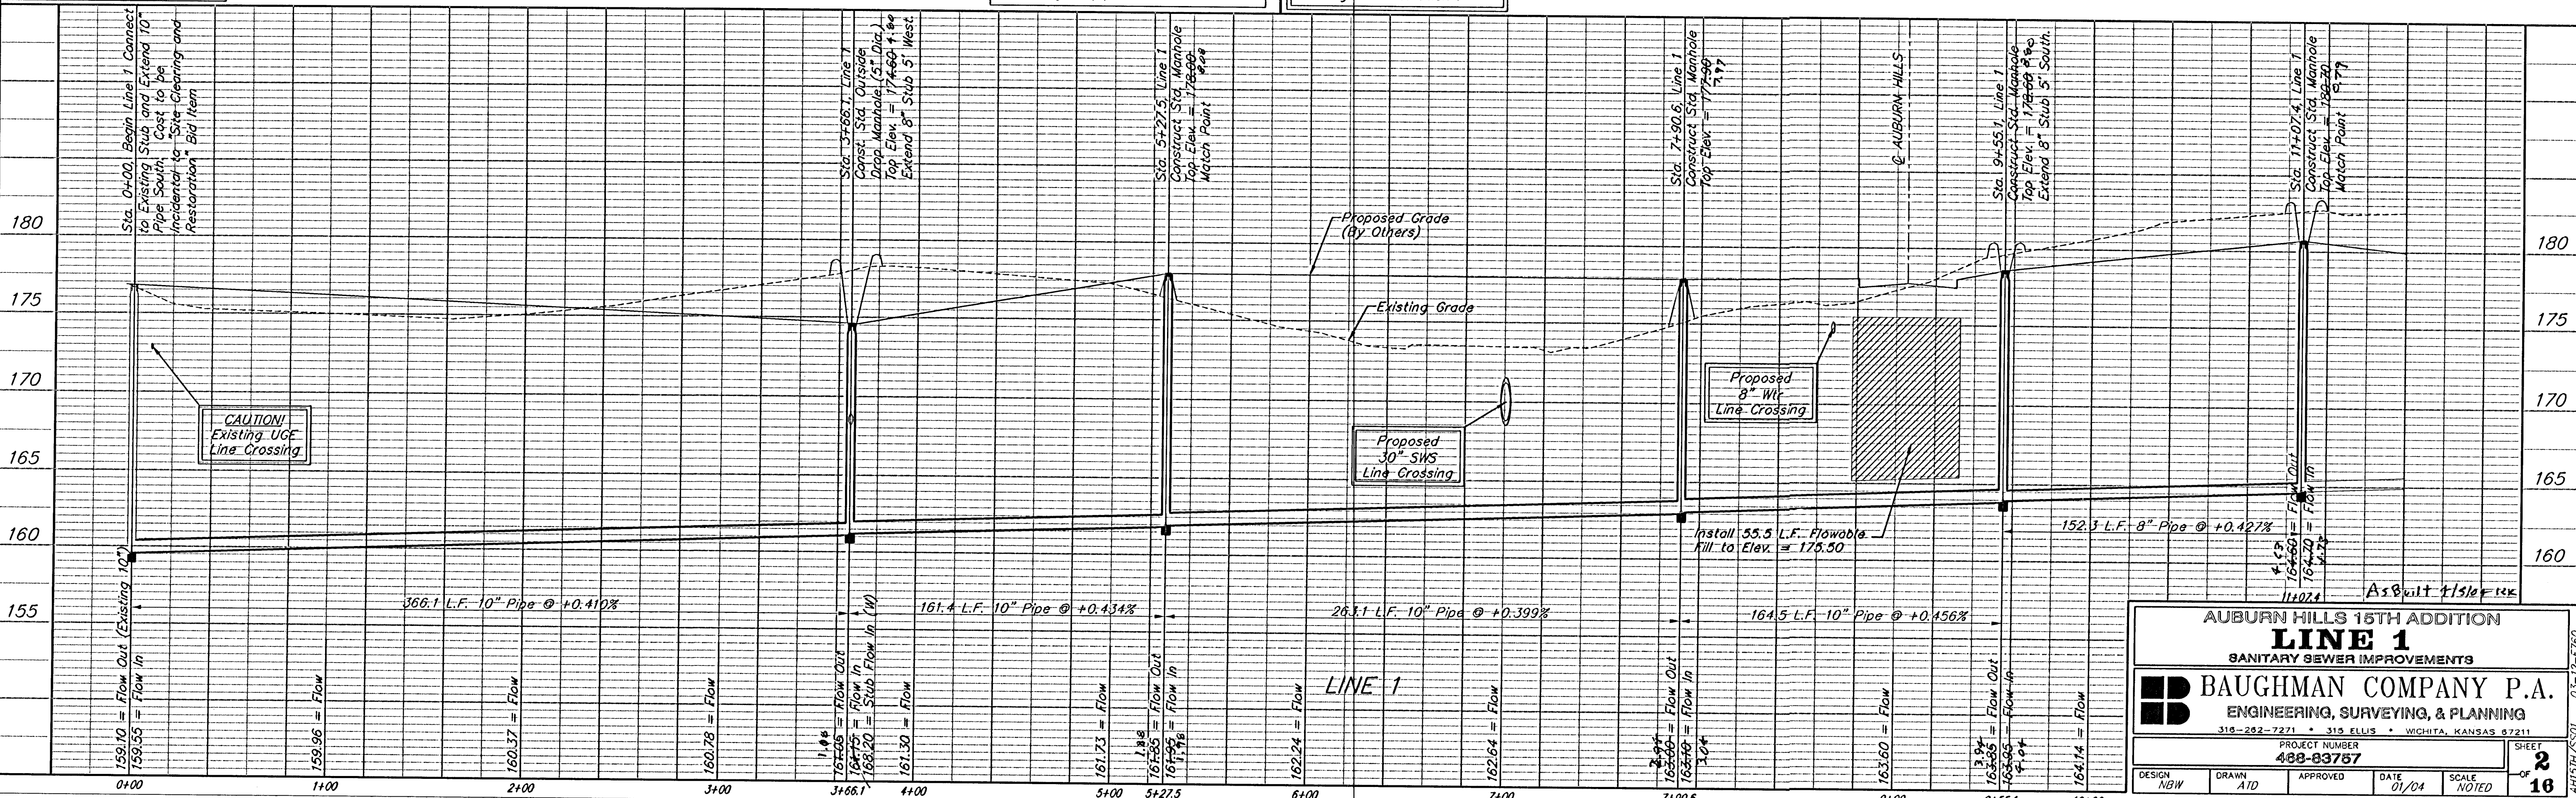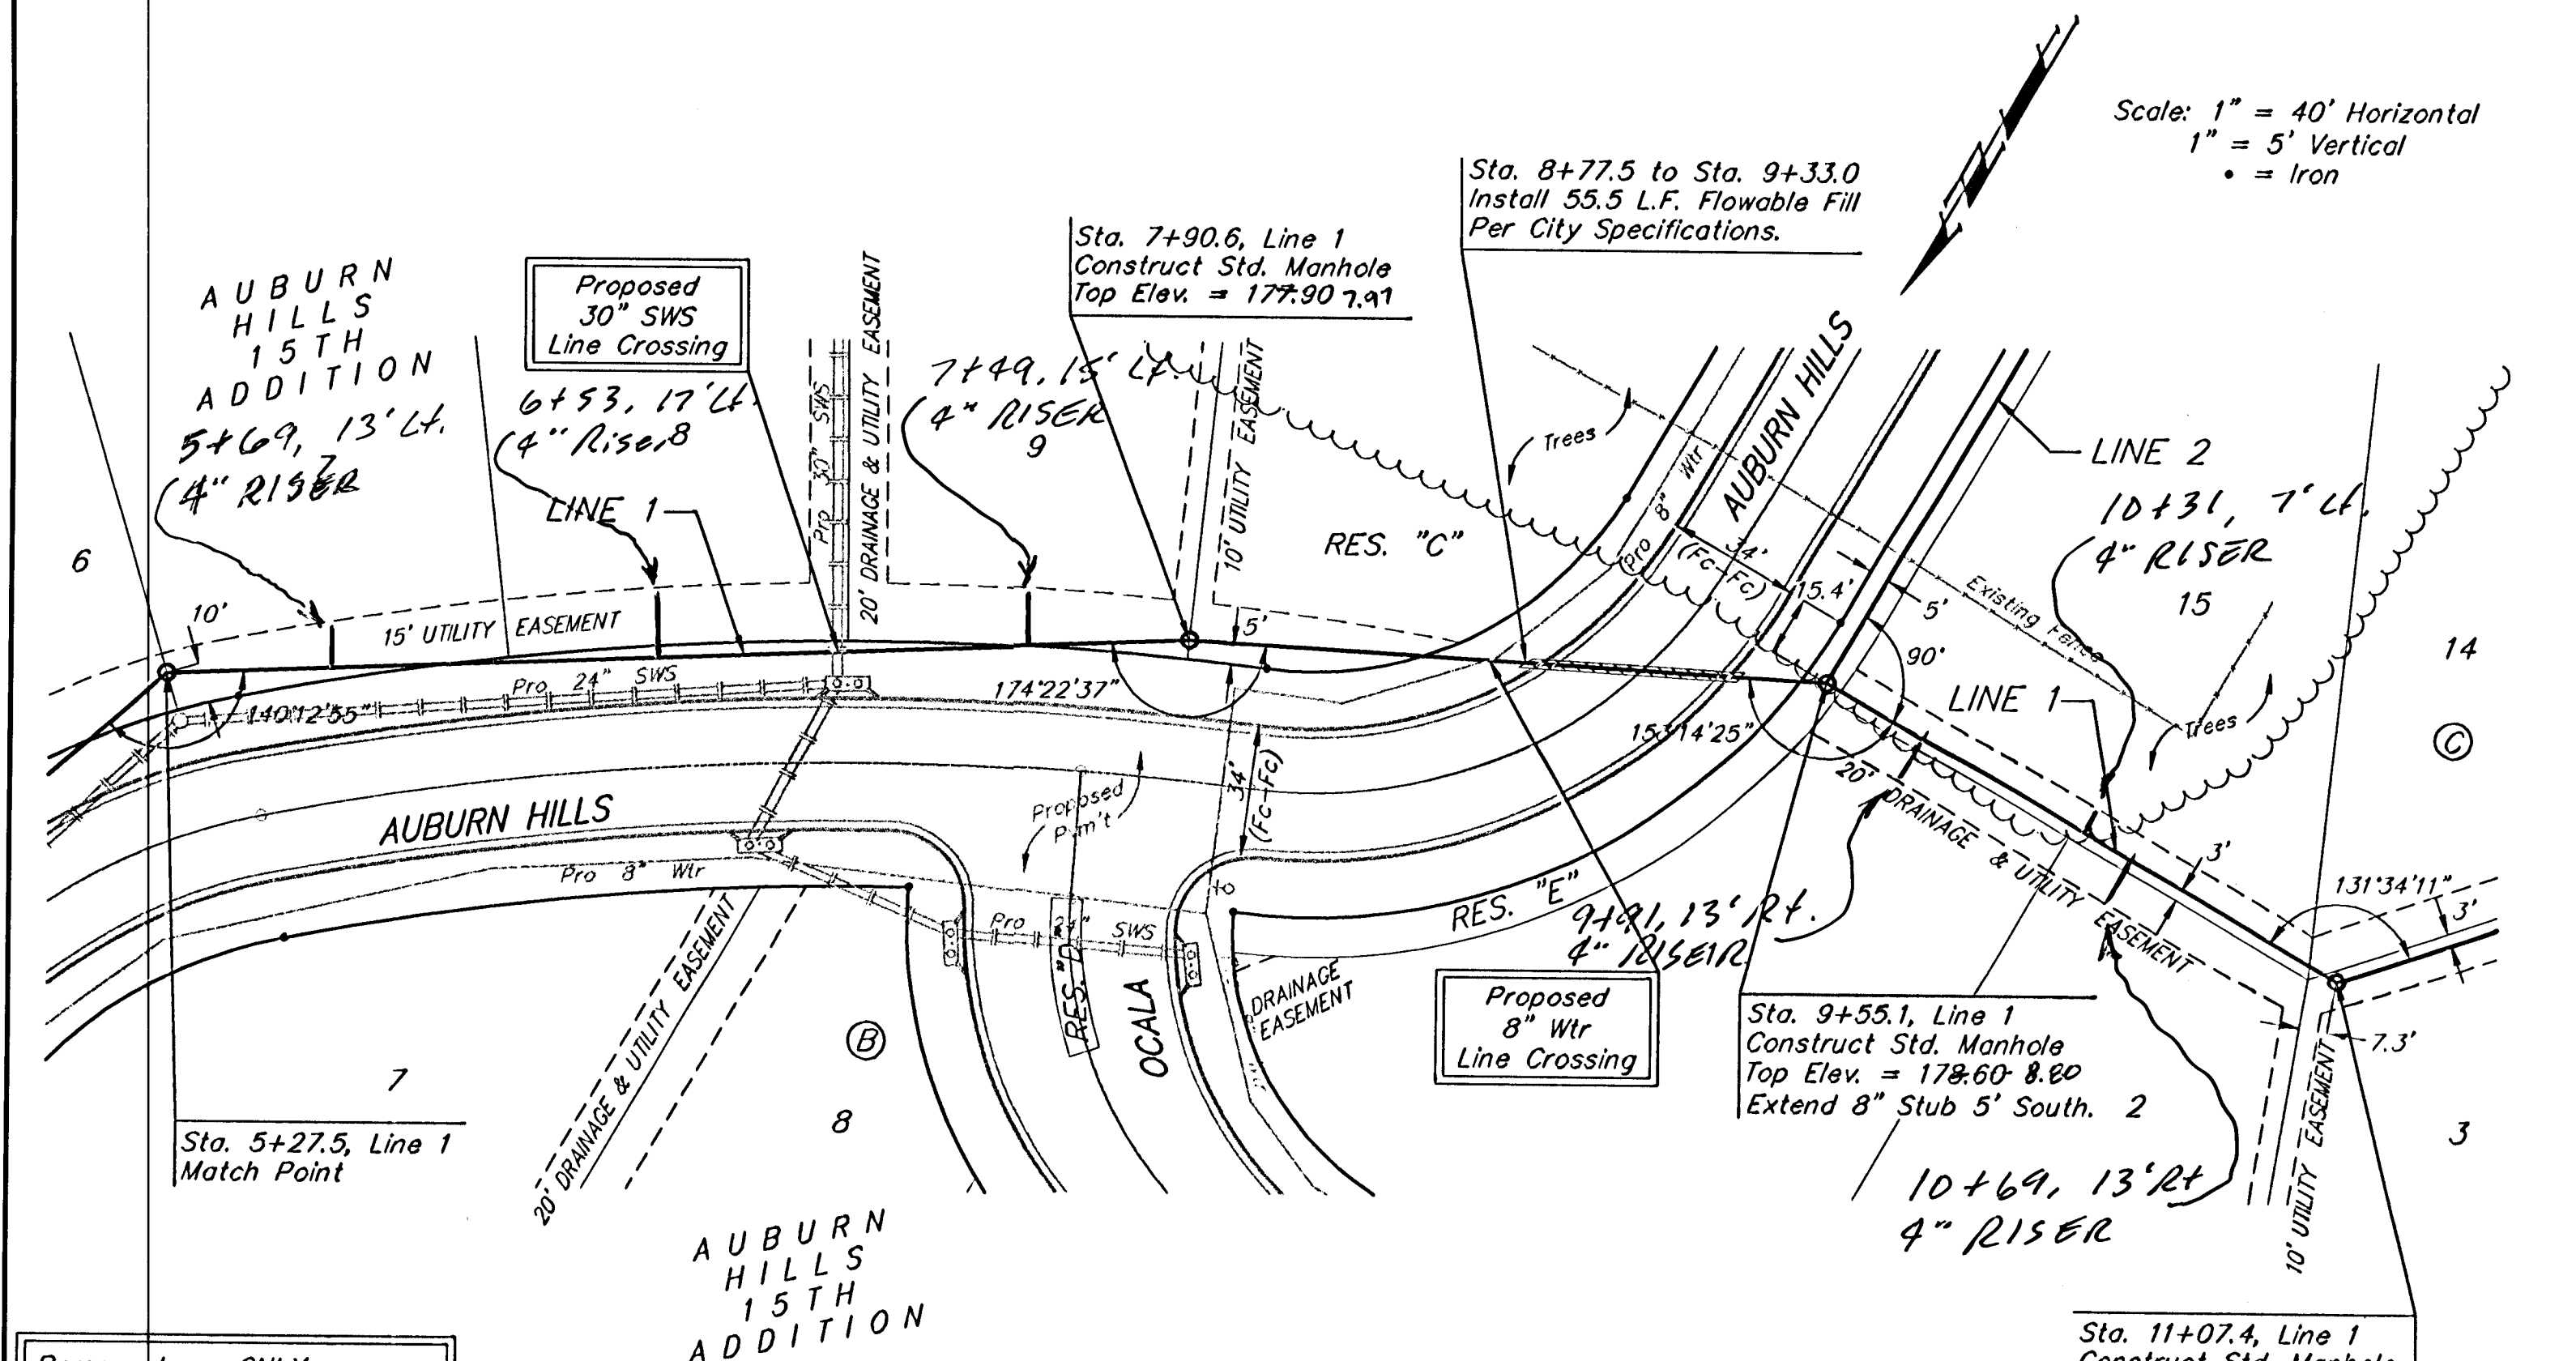

AUBURN HILLS 15TH ADDITION
LINE 1
SANITARY SEWER IMPROVEMENTS

BAUGHMAN COMPANY P.A.
ENGINEERING, SURVEYING, & PLANNING
318-282-7271 • 315 ELLIS • WICHITA, KANSAS 67211

PROJECT NUMBER
488-83787

DESIGN NBW DRAW ATD APPROVED DATE 01/04 SCALE NOTED

SHEET
2
OF
16