




Benchmark:
City Disc In T.C. Adj. to F.H.
38' South of intersection of
Onewood and Auburn Hills.
Elev. = 178.48 (City Datum)

"□" cut in south curb of
Onewood 272' west of C.L.
Auburn Hills.
Elev. = 179.73 (City Datum)

Scale: 1" = 40' Horizontal
1" = 5' Vertical
• = Iron

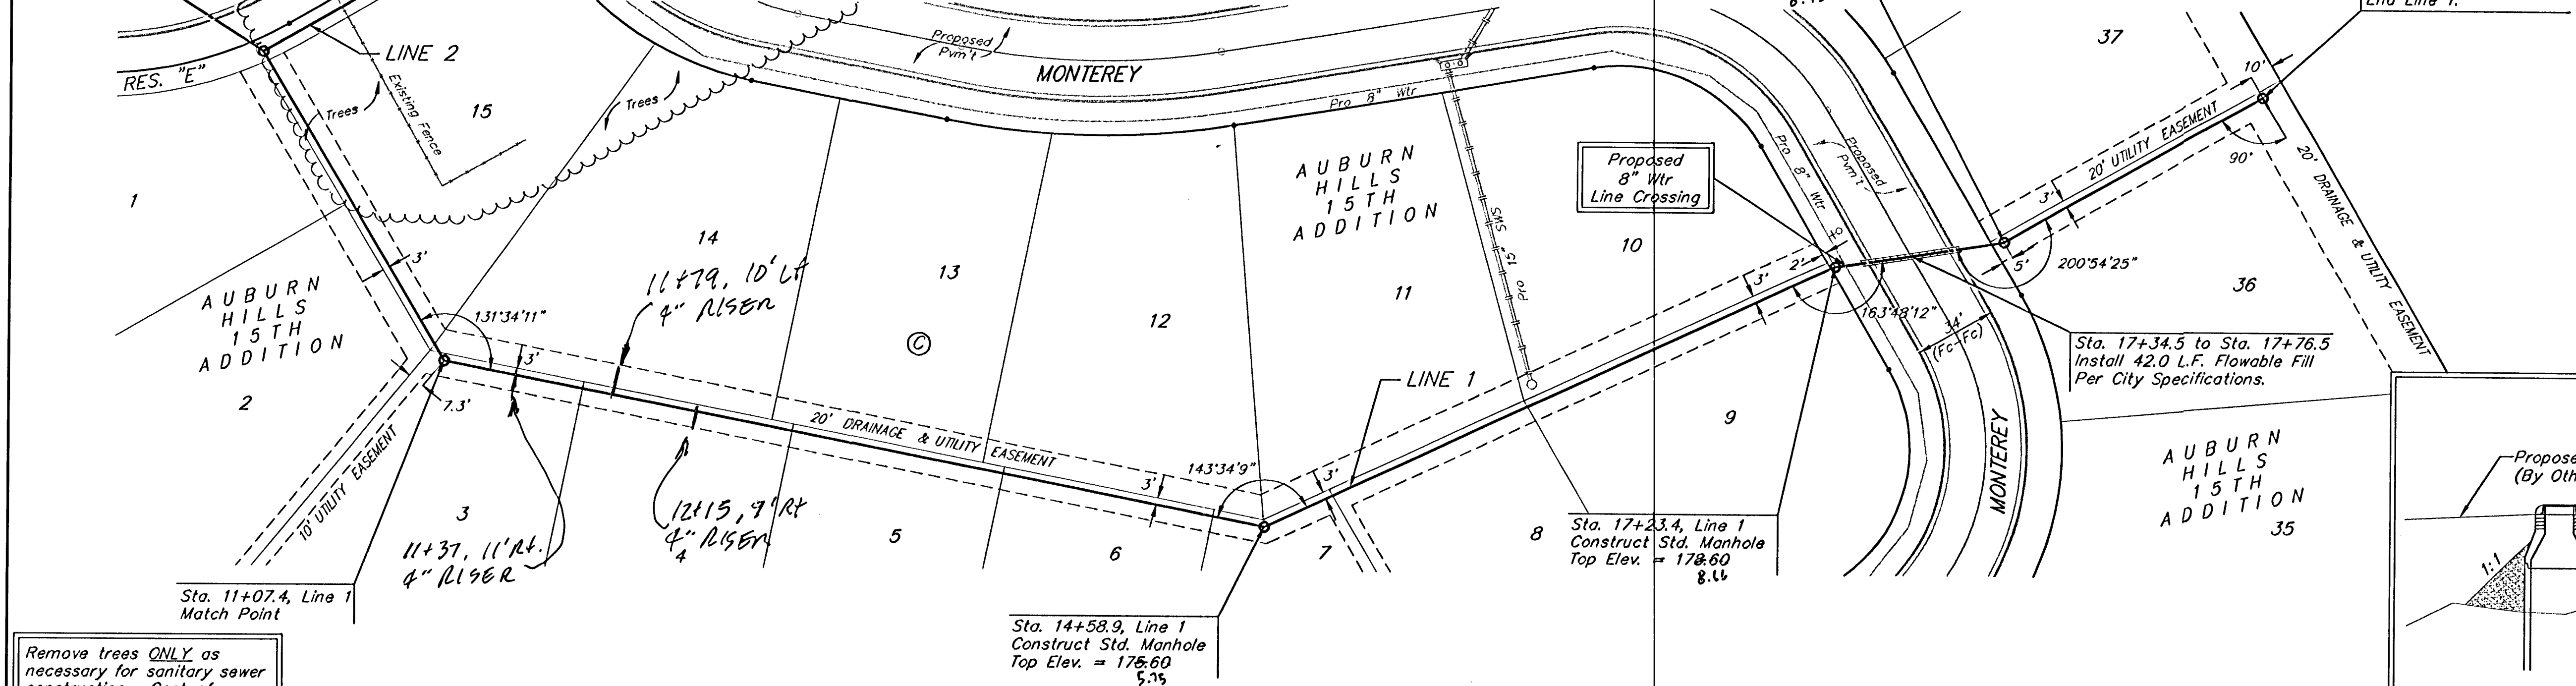

Remove trees ONLY as
necessary for sanitary sewer
construction. Cost of
removal to be incidental to
lump sum bid item "Site
Clearing & Restoration".

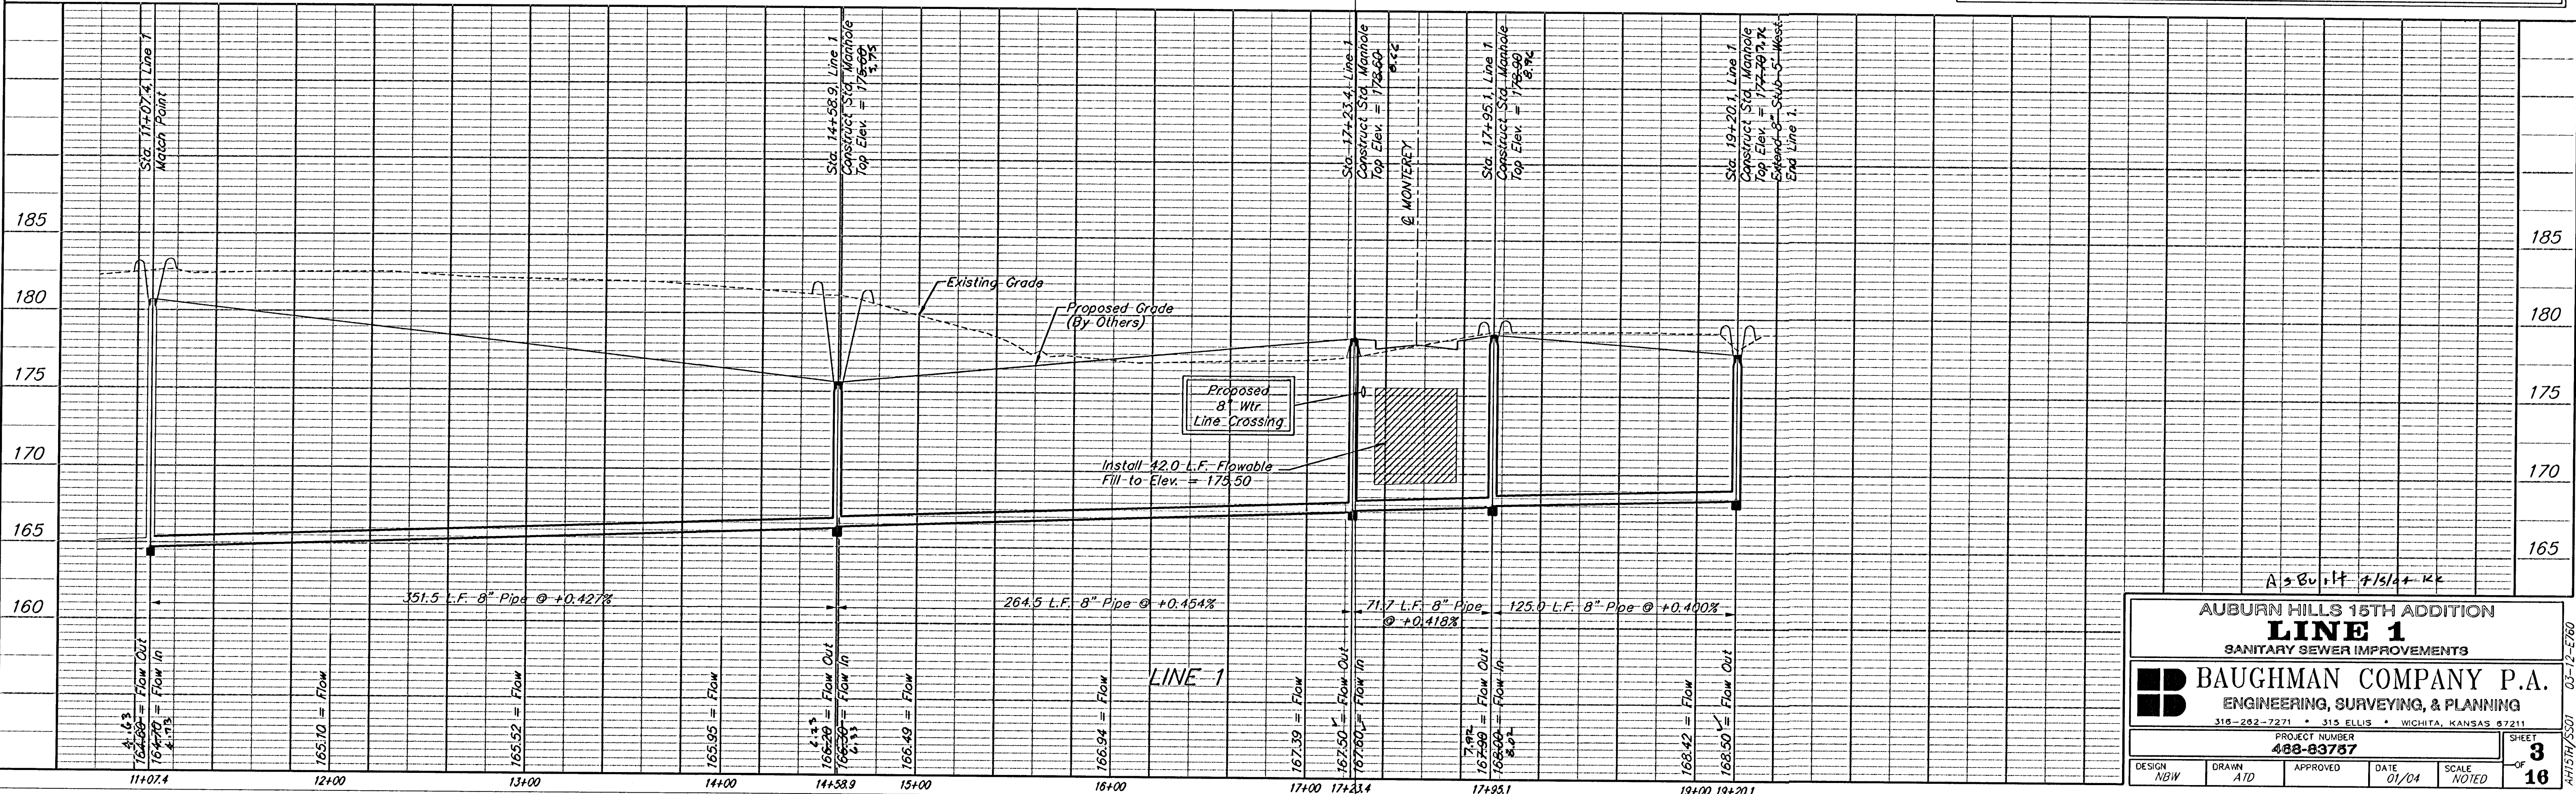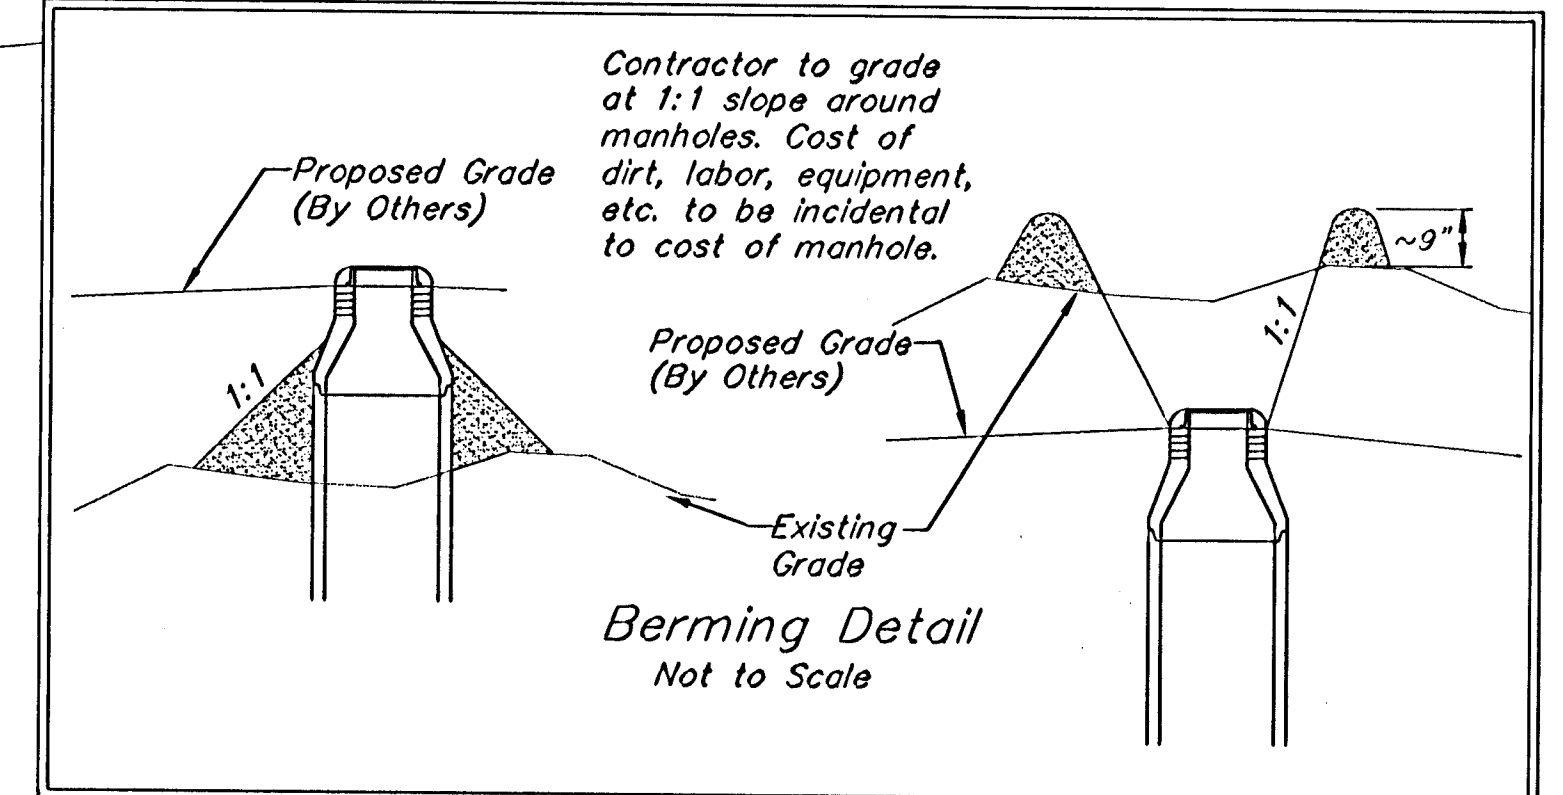

AUBURN HILLS 15TH ADDITION
LINE 1
SANITARY SEWER IMPROVEMENTS

BAUGHMAN COMPANY P.A.
ENGINEERING, SURVEYING, & PLANNING

PROJECT NUMBER
488-83757

DESIGN NBW DRAWN ATD APPROVED DATE 01/04 SCALE NOTED

SHEET **3** OF **16**