


Benchmark:  
City Disc In T.C. Adj. to F.H.  
38' South of intersection of  
Onewood and Auburn Hills.  
Elev. = 178.48 (City Datum)

"□" cut in south curb of  
Onewood 272' west of C.L.  
Auburn Hills.  
Elev. = 179.73 (City Datum)



Scale: 1" = 40' Horizontal  
1" = 5' Vertical  
• = Iron

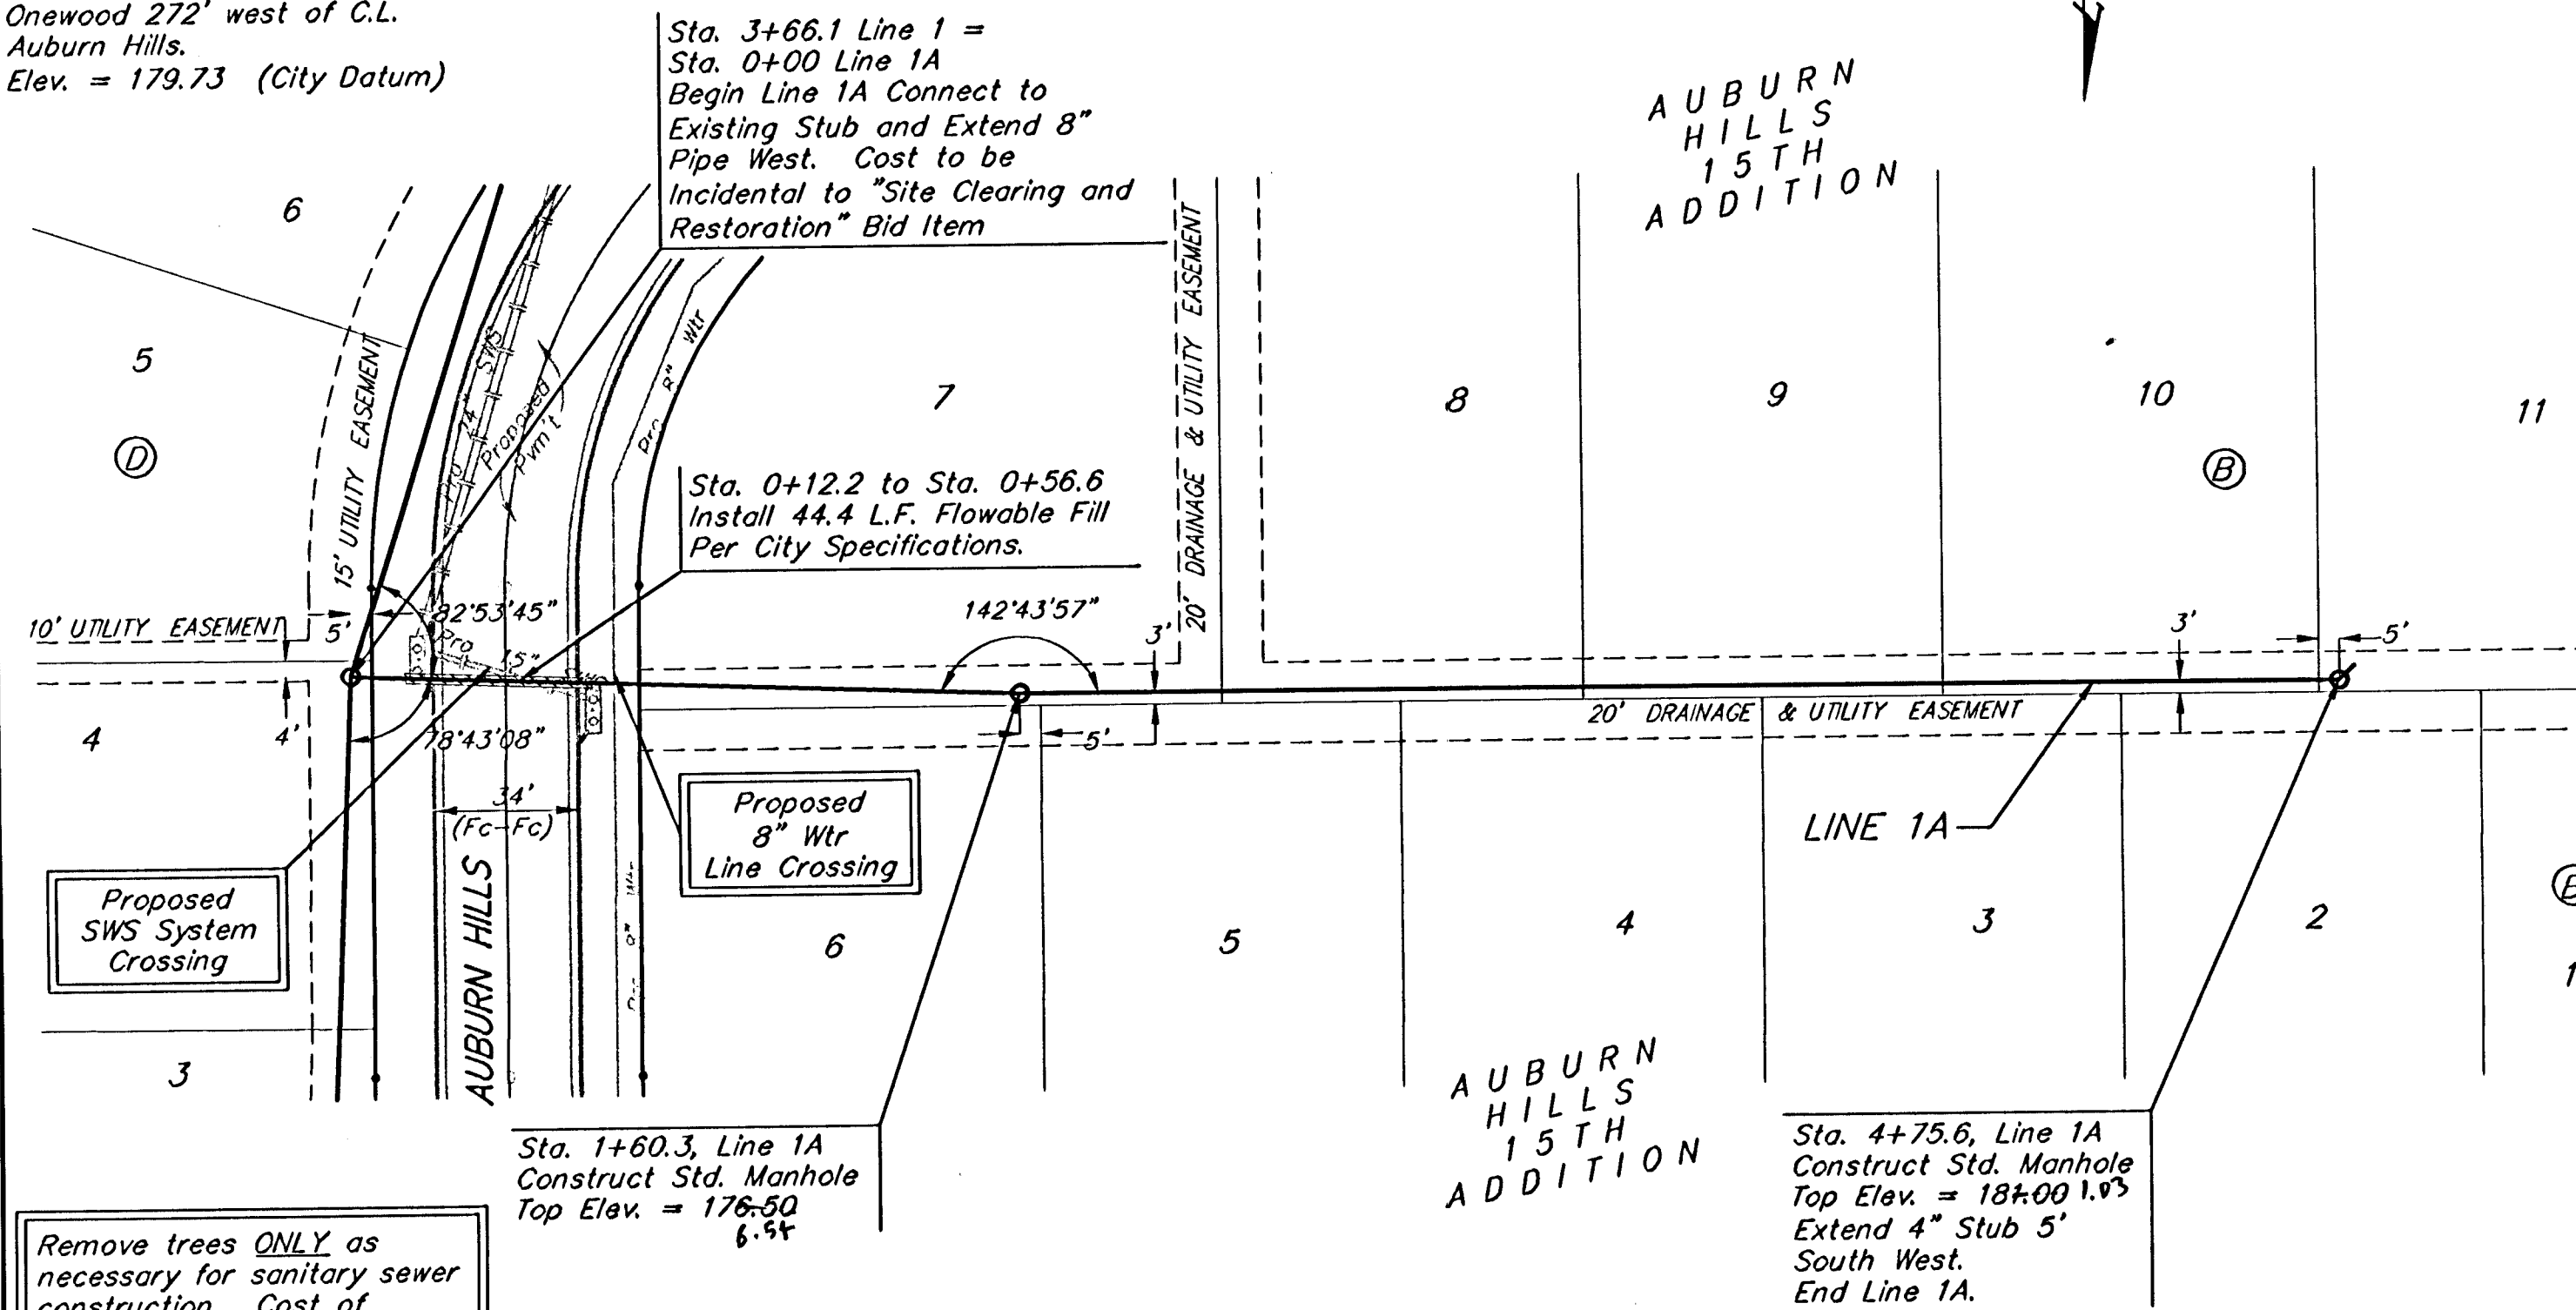

Remove trees ONLY as necessary for sanitary sewer construction. Cost of removal to be incidental to lump sum bid item "Site Clearing & Restoration".

Remove trees ONLY as necessary for sanitary sewer construction. Cost of removal to be incidental to lump sum bid item "Site Clearing & Restoration".

The contractor shall be required to backfill trench with sand from Sta. 0+00 to Sta. 3+20.0, Line 2 excluding locations where flowable fill is called out. All costs shall be subsidiary to pipe cost.

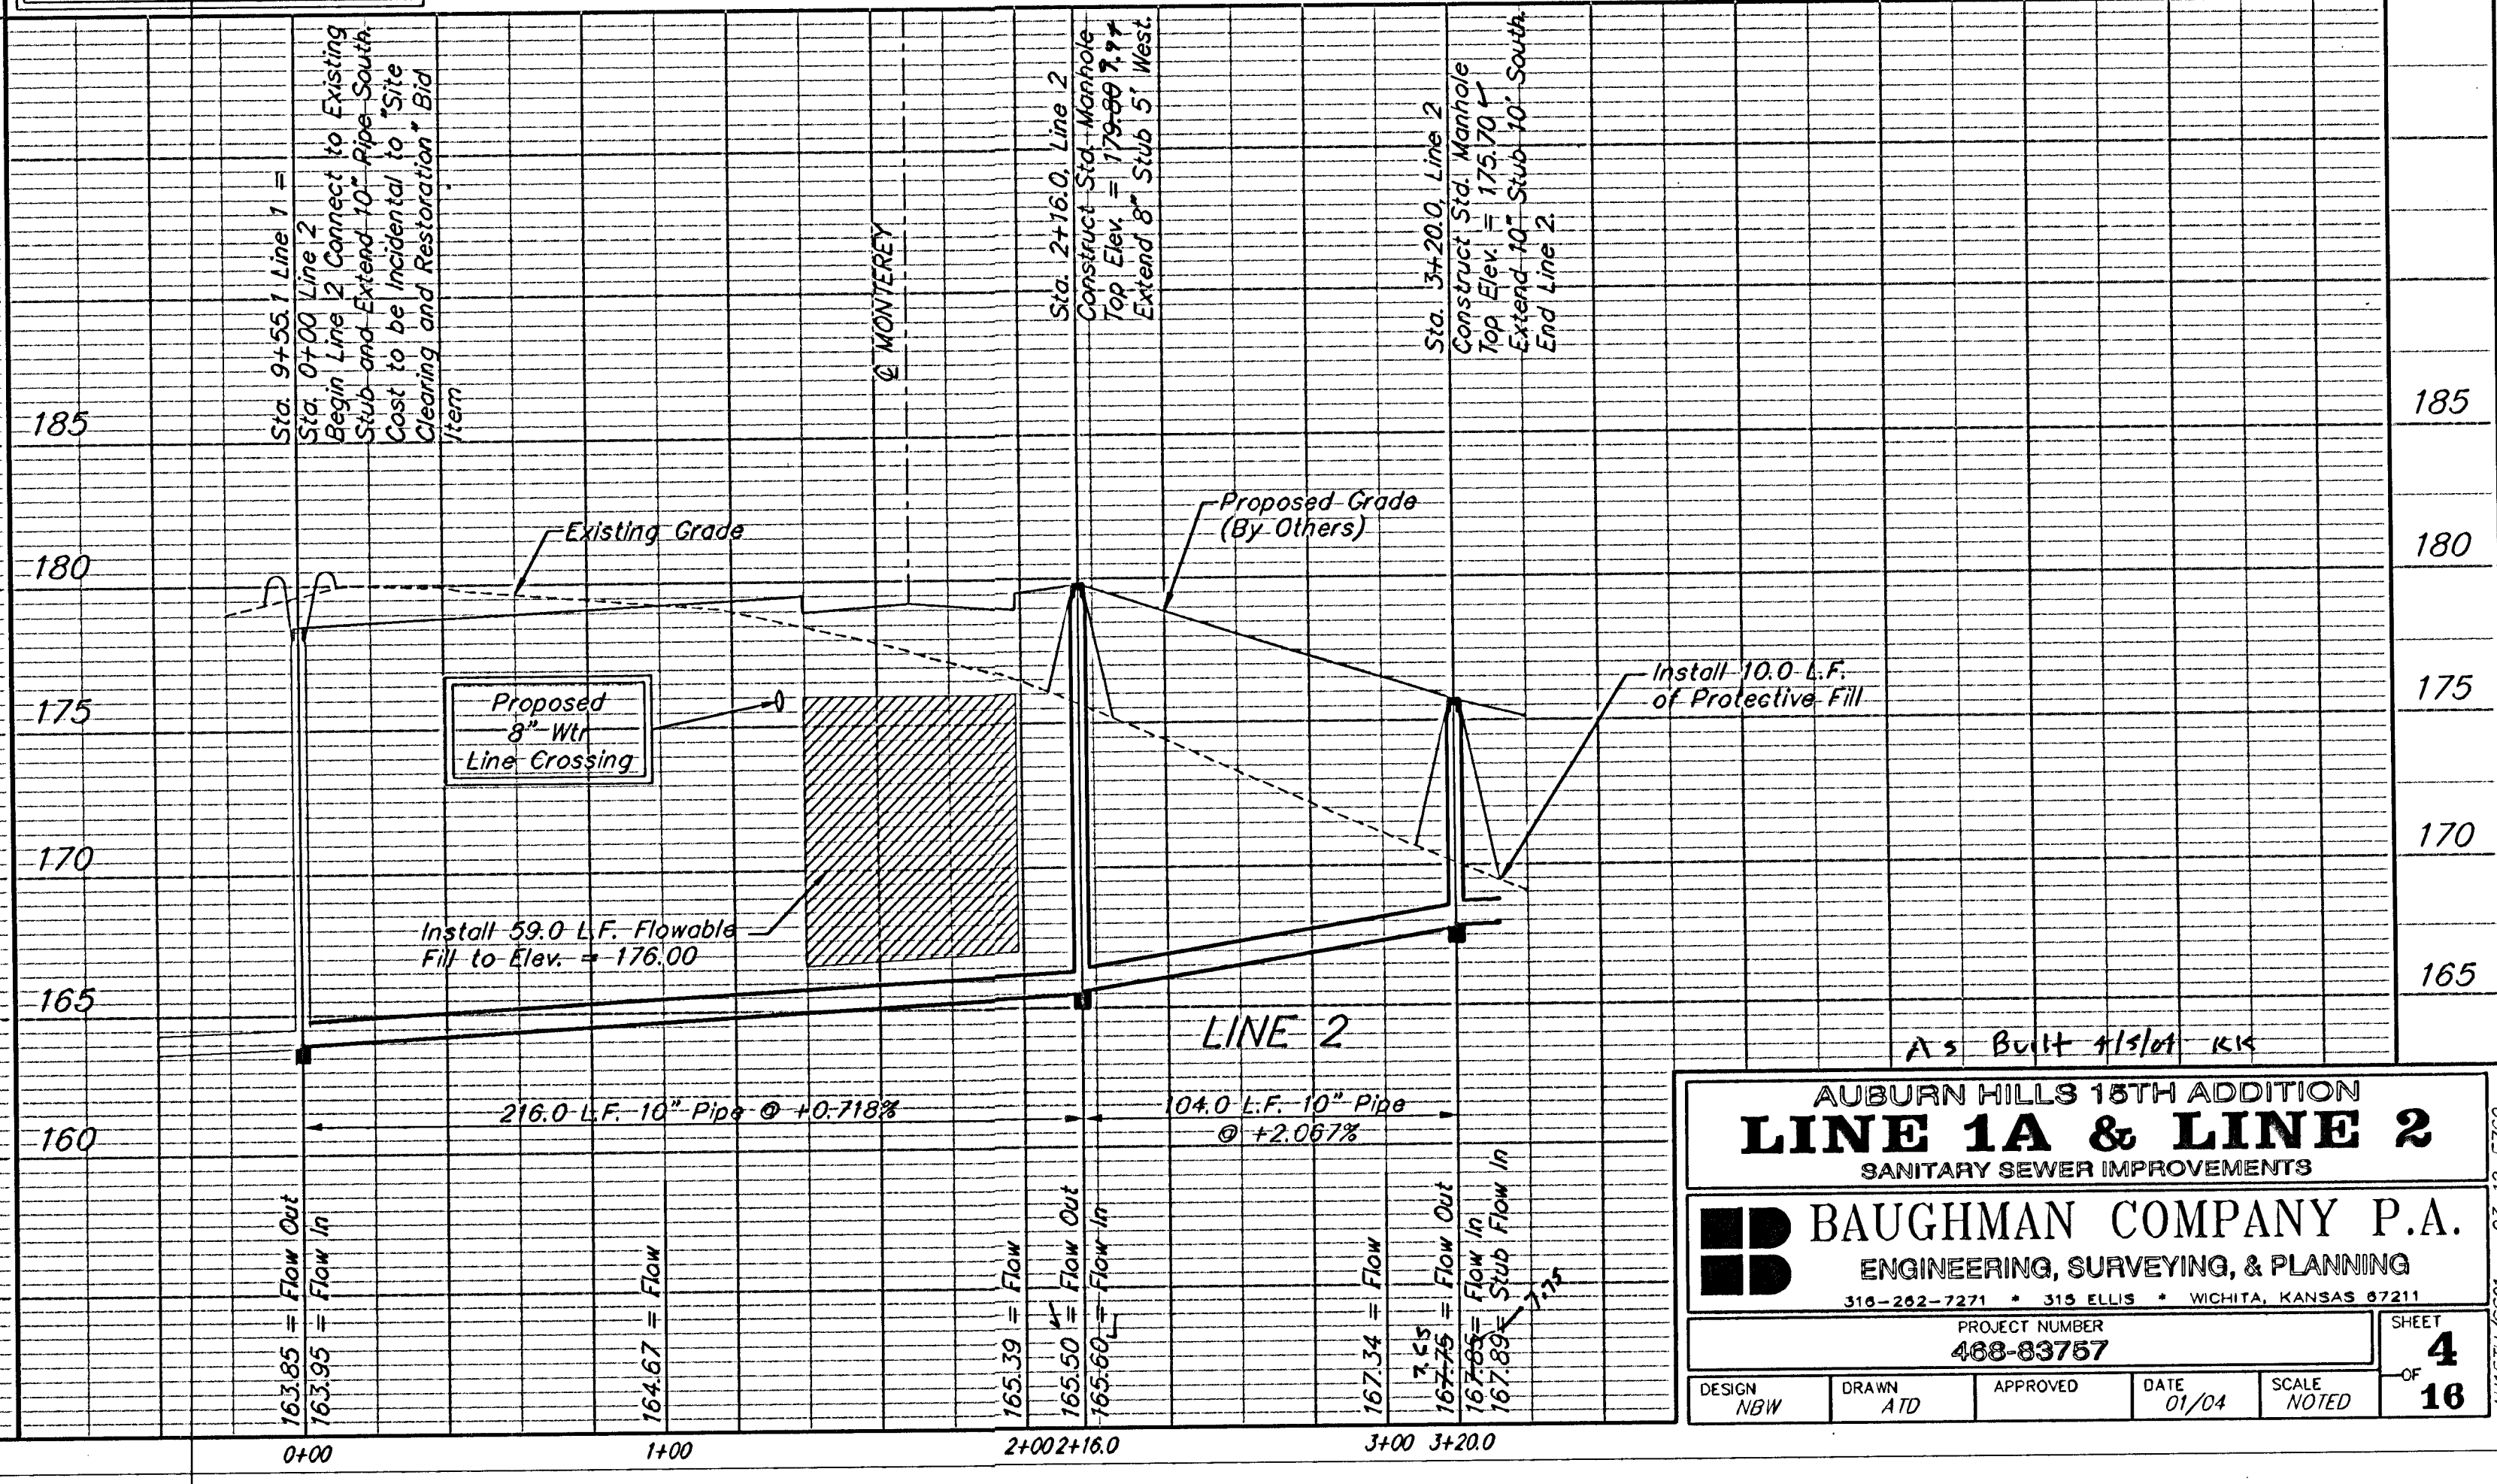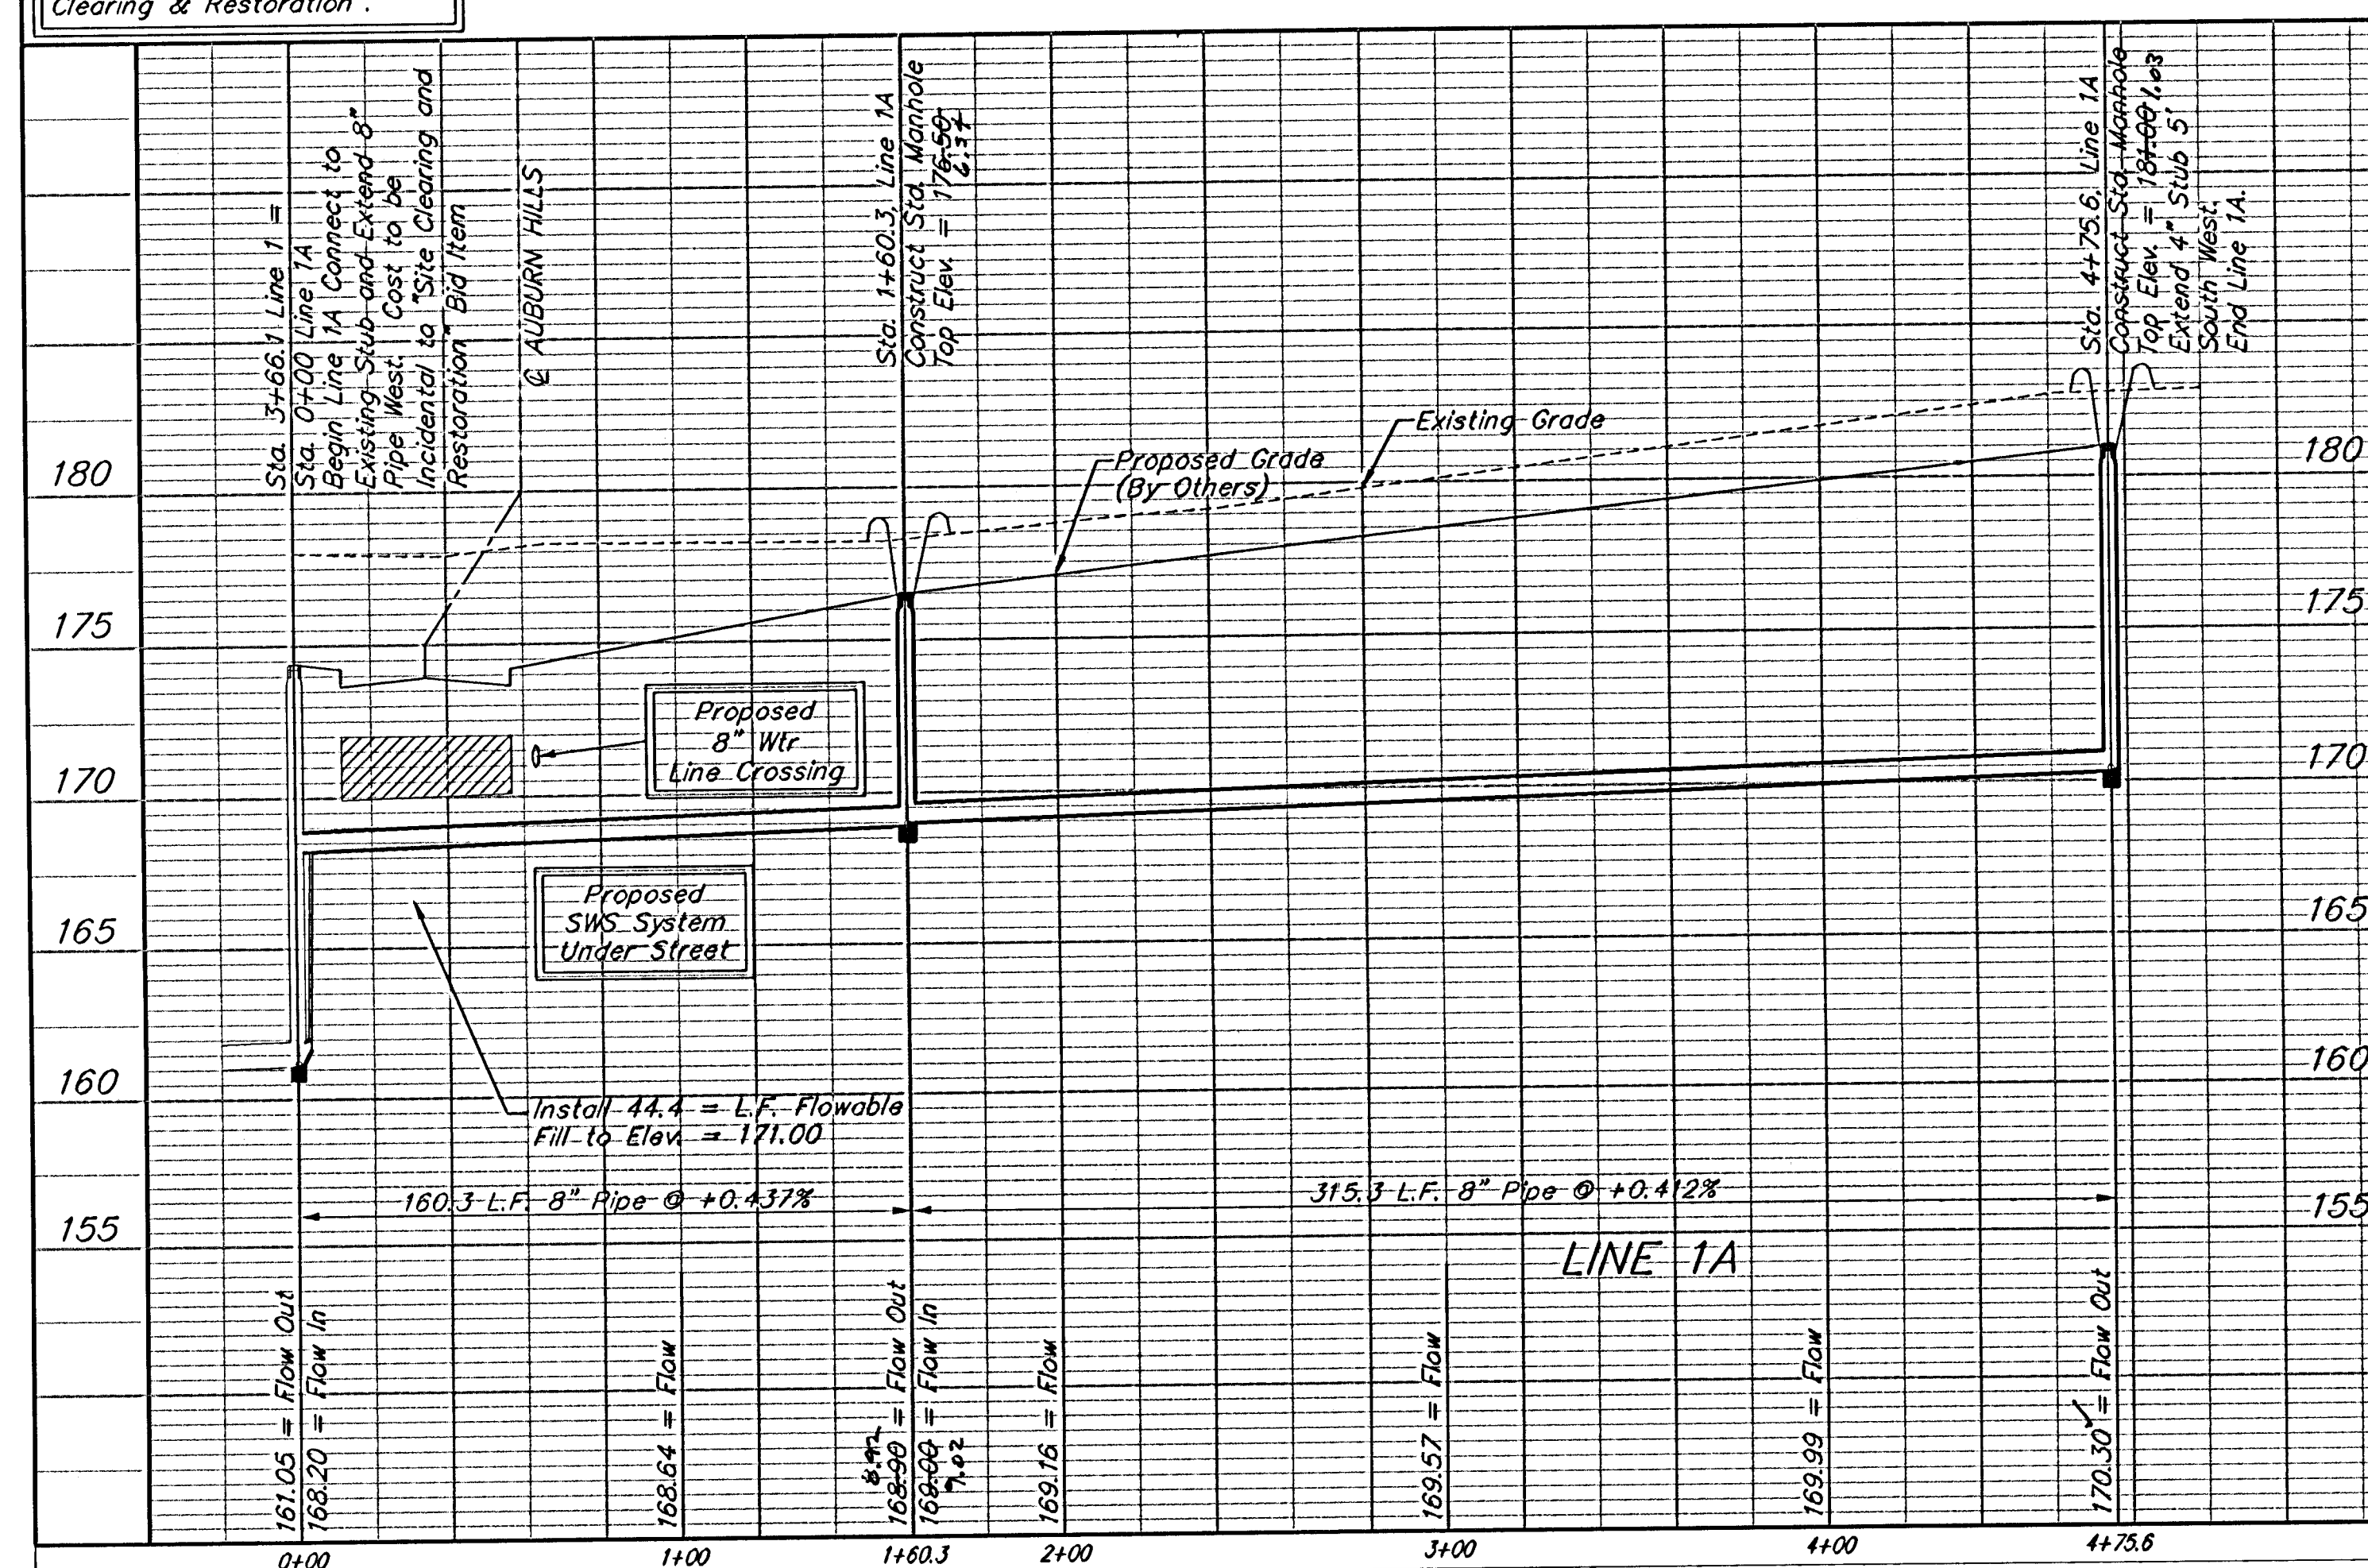

AUBURN HILLS 15TH ADDITION  
**LINE 1A & LINE 2**  
SANITARY SEWER IMPROVEMENTS

**BAUGHMAN COMPANY P.A.**  
ENGINEERING, SURVEYING, & PLANNING  

PROJECT NUMBER  

DESIGN NBW DRAWN ATD APPROVED DATE 01/04 SCALE NOTED

SHEET  
OF  
**4**  
16