


Benchmark:
City Disc In T.C. Adj. to F.H.
38' South of intersection of
Onewood and Auburn Hills.
Elev. = 178.48 (City Datum)

"□" cut in south curb of
Onewood 272' west of C.L.
Auburn Hills.
Elev. = 179.73 (City Datum)


Sta. 2+16.0 Line 2 =
Sta. 0+00 Line 2A
Begin Line 2A Connect to Existing
Stub and Extend 8" Pipe West.
Cost to be Incidental to "Site
Clearing and Restoration" Bid Item

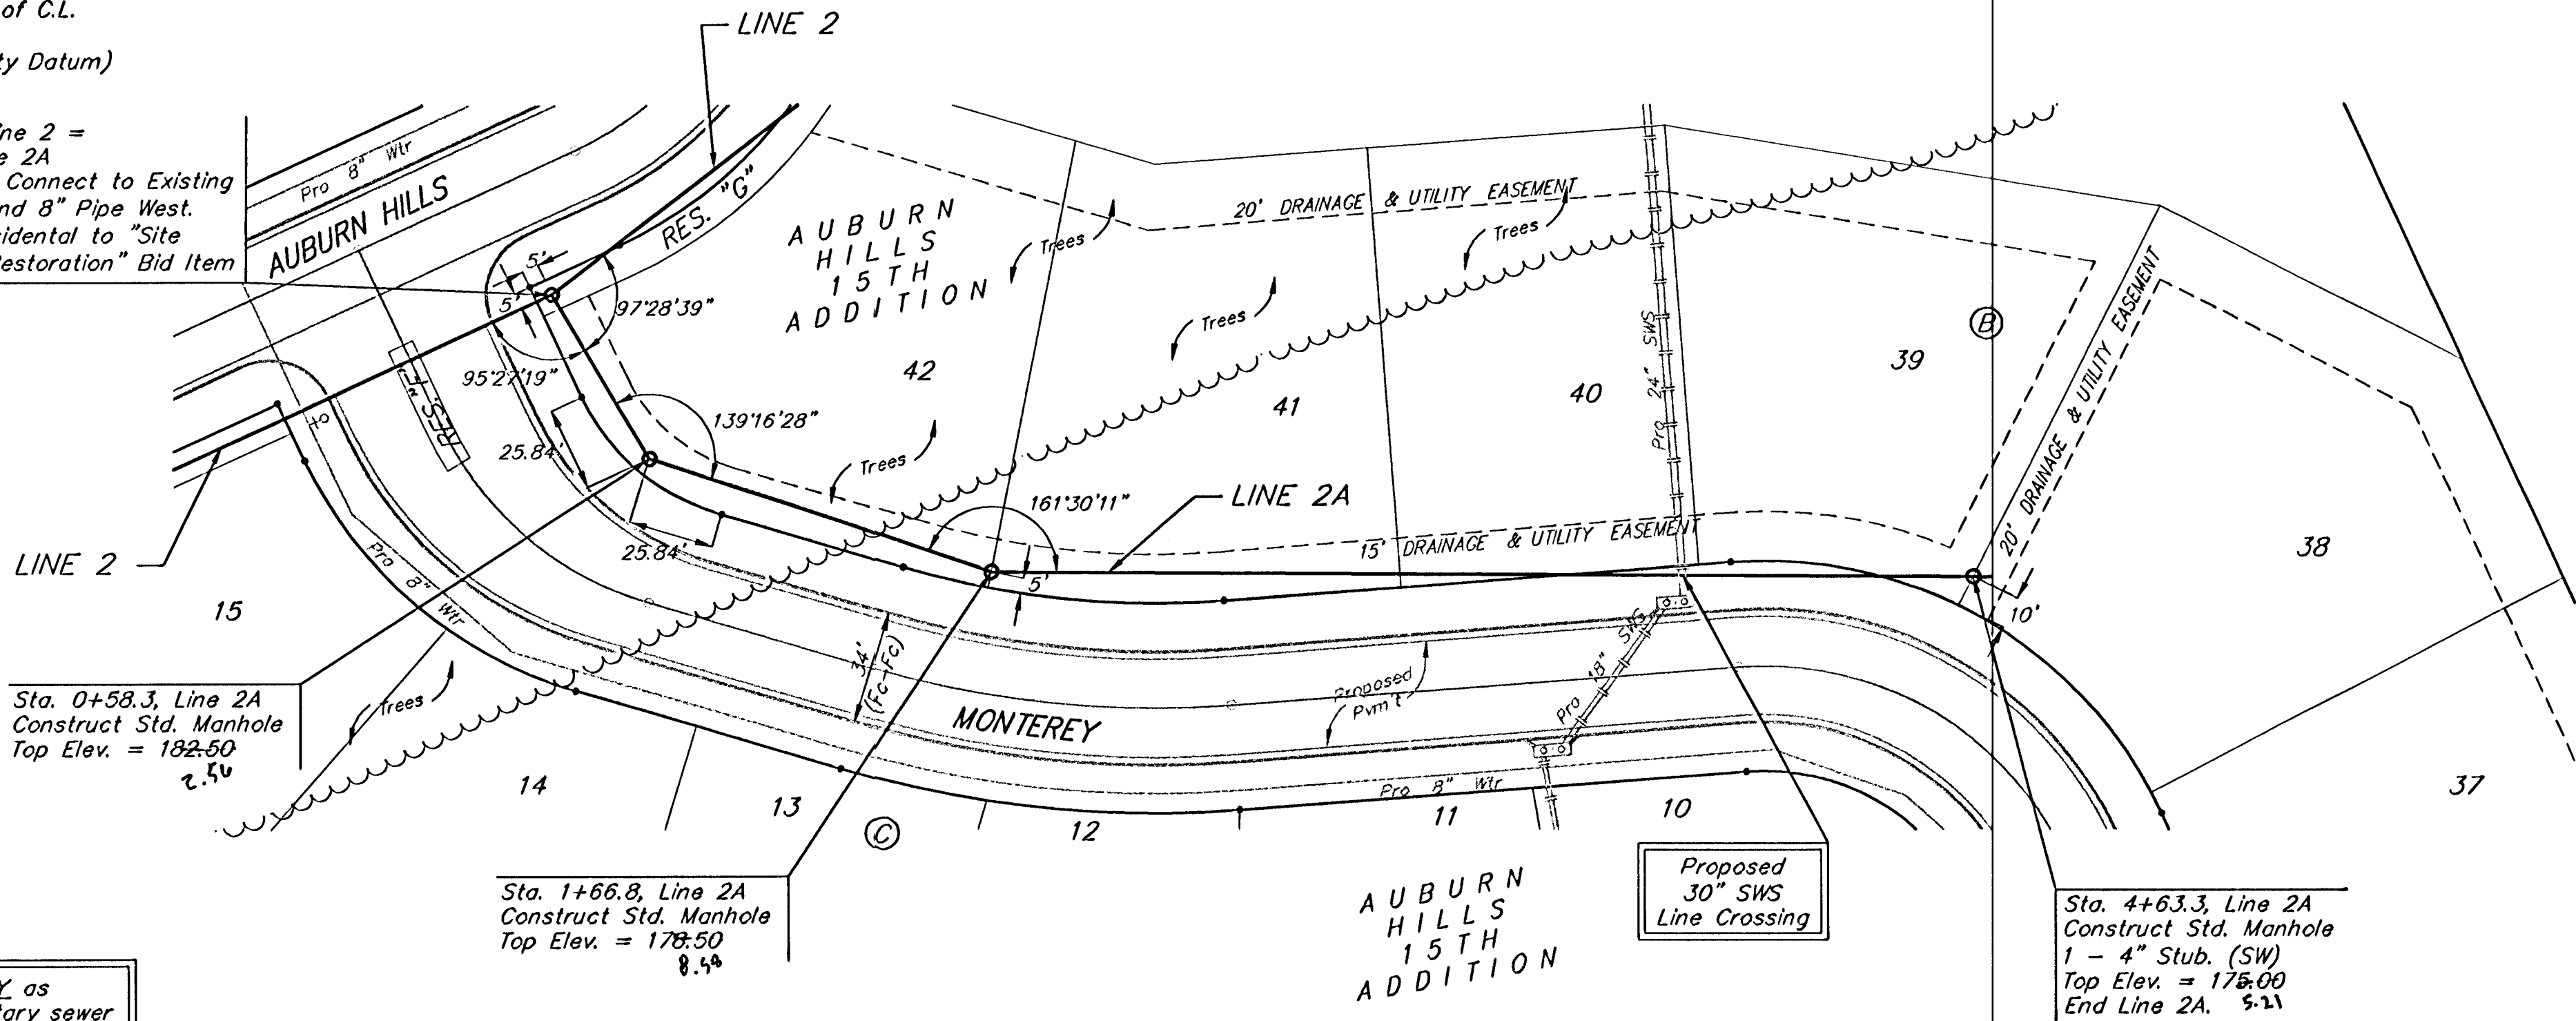


Remove trees ONLY as
necessary for sanitary sewer
construction. Cost of
removal to be incidental to
lump sum bid item "Site
Clearing & Restoration".

Scale: 1" = 40' Horizontal
1" = 5' Vertical
• = Iron

Scale: 1" = 40' Horizontal
1" = 5' Vertical
• = Iron

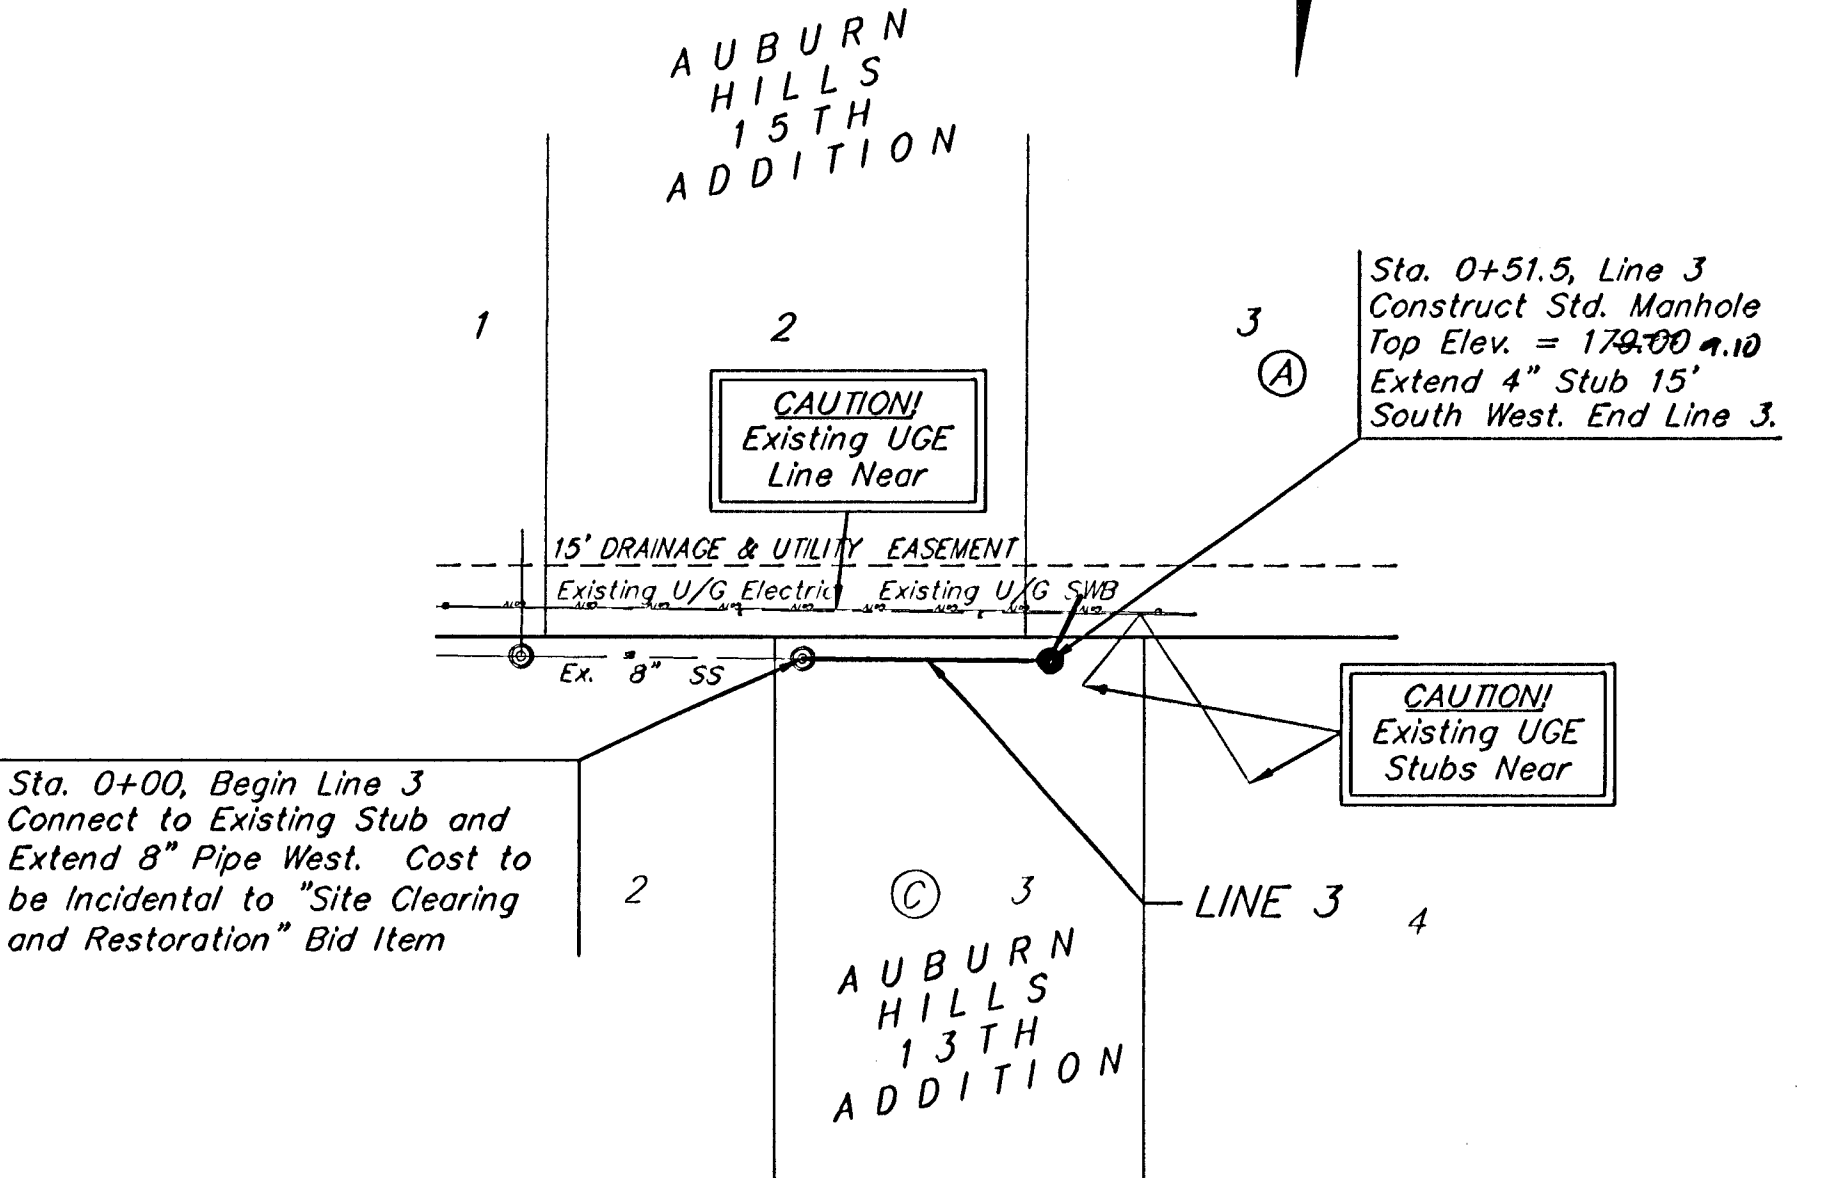

Remove trees ONLY as
necessary for sanitary sewer
construction. Cost of
removal to be incidental to
lump sum bid item "Site
Clearing & Restoration".

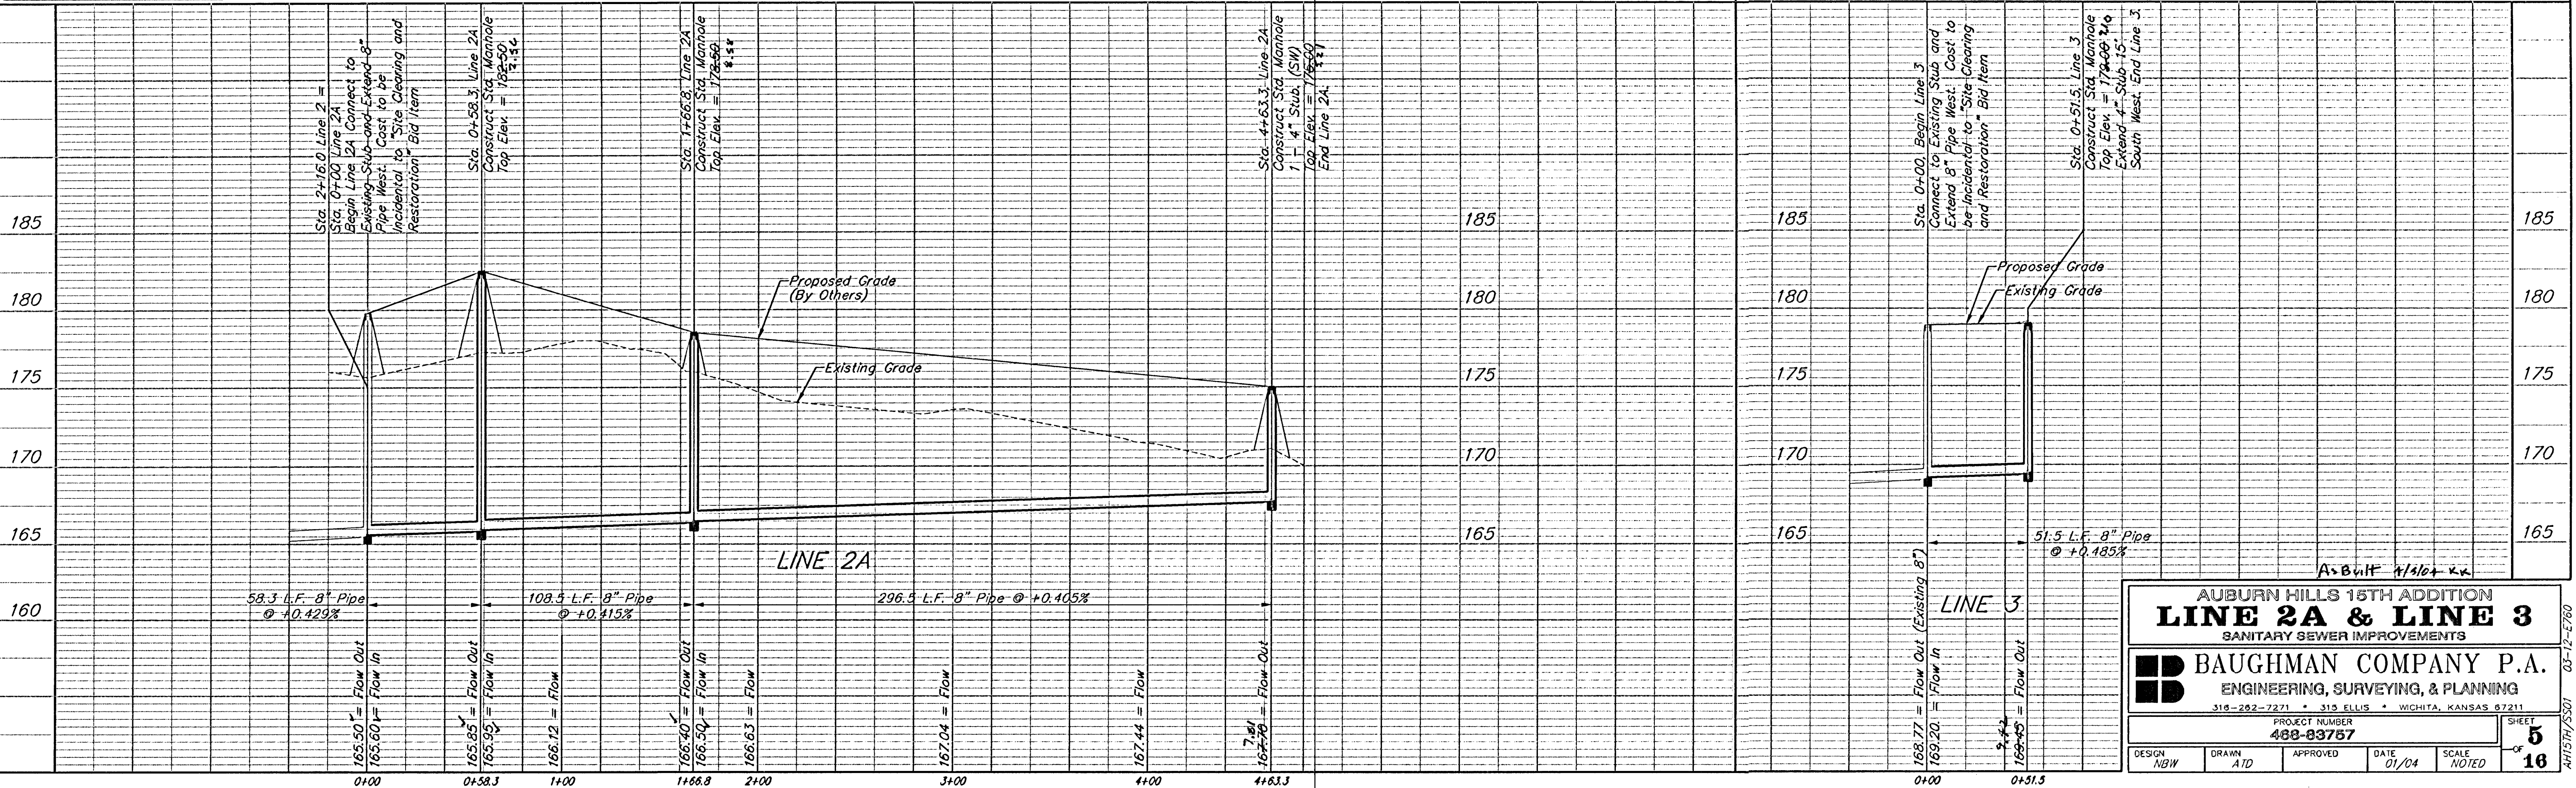

AUBURN HILLS 15TH ADDITION
LINE 2A & LINE 3
SANITARY SEWER IMPROVEMENTS

BAUGHMAN COMPANY P.A.
ENGINEERING, SURVEYING, & PLANNING
316-202-7221 • 313 ELLIS • WICHITA, KANSAS 67211

PROJECT NUMBER
488-03757

DESIGN NBW DRAW ATD APPROVED DATE 01/04 SCALE NOTED

SHEET
5
OF
16