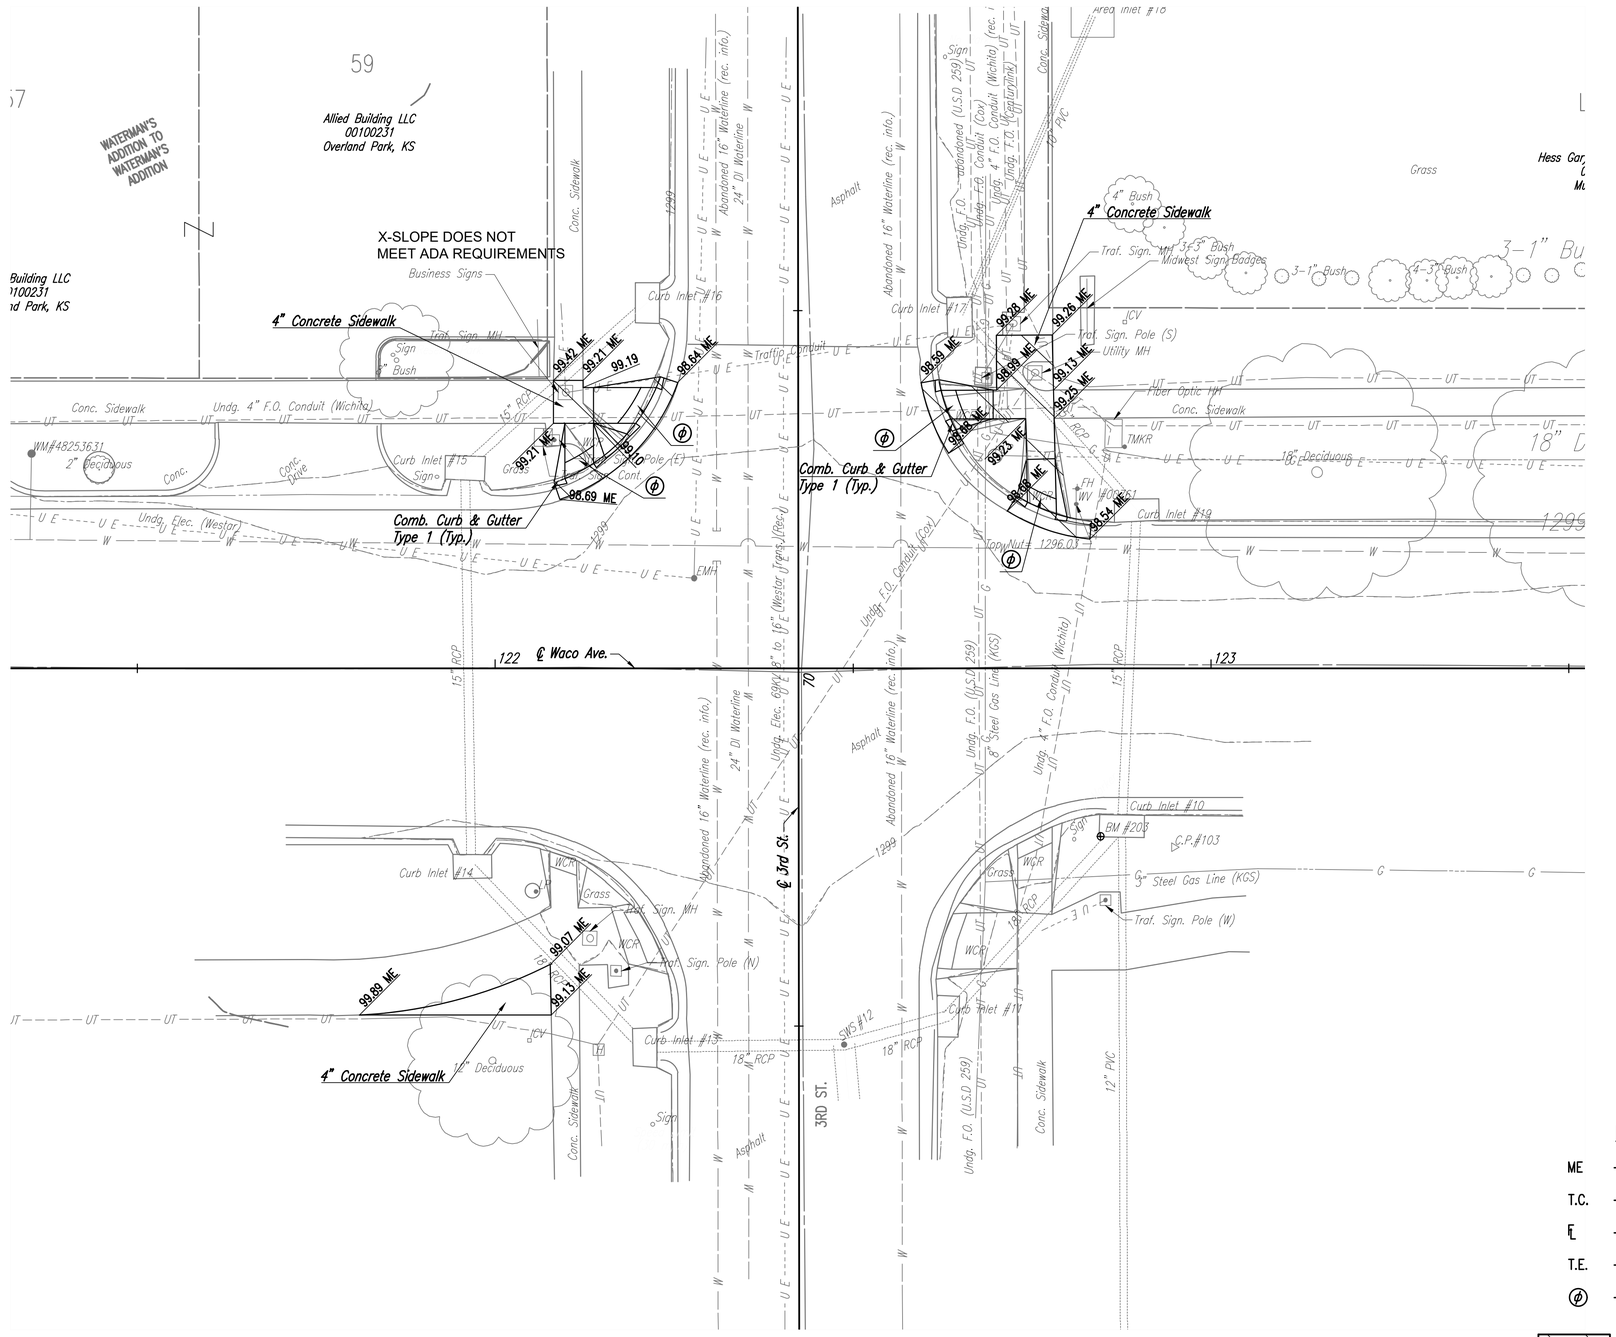

SCALE: 1" = 10'

LEGEND

ME	– Match Existing
T.C.	– Top of Curb
℄	– Flowline
T.E.	– Toe Elevation
⊕	– Wheelchair Ramp with Detectable Warning
	– Pavement Removal

PEC
PROFESSIONAL ENGINEERING CONSULTANTS
303 SOUTH TOPEKA
WICHITA, KS 67202
316-262-2691 www.pec1.com

RILEY J. SCHMITZ
LICENSED
24168
07/03/2019
KANSAS
PROFESSIONAL ENGINEER

PAVING IMPROVEMENTS

WACO AVENUE FROM DOUGLAS TO CENTRAL

GARY JANZEN, P.E. - CITY ENGINEER
CITY OF WICHITA PROJECT NO. 472-85496

Issue:

JOB NO.	187042-006
DATE	JUNE 2019
PM	BMM
DESIGNED BY	RJS, SAC
DRAWN BY	CP, BJS
CHECKED BY	BMM

WACO & THIRD & PLAN

10
10 OF 48

Saved 7-3-2019 1:35:53 PM by CP
Plotted on 7-3-2019 1:40:49 PM by CARLOS PEREZ
U:\Wichita-Civil\2018\187042\006\Muni-Frans\Drawings\187042-006-10C-PLAN THIRD