

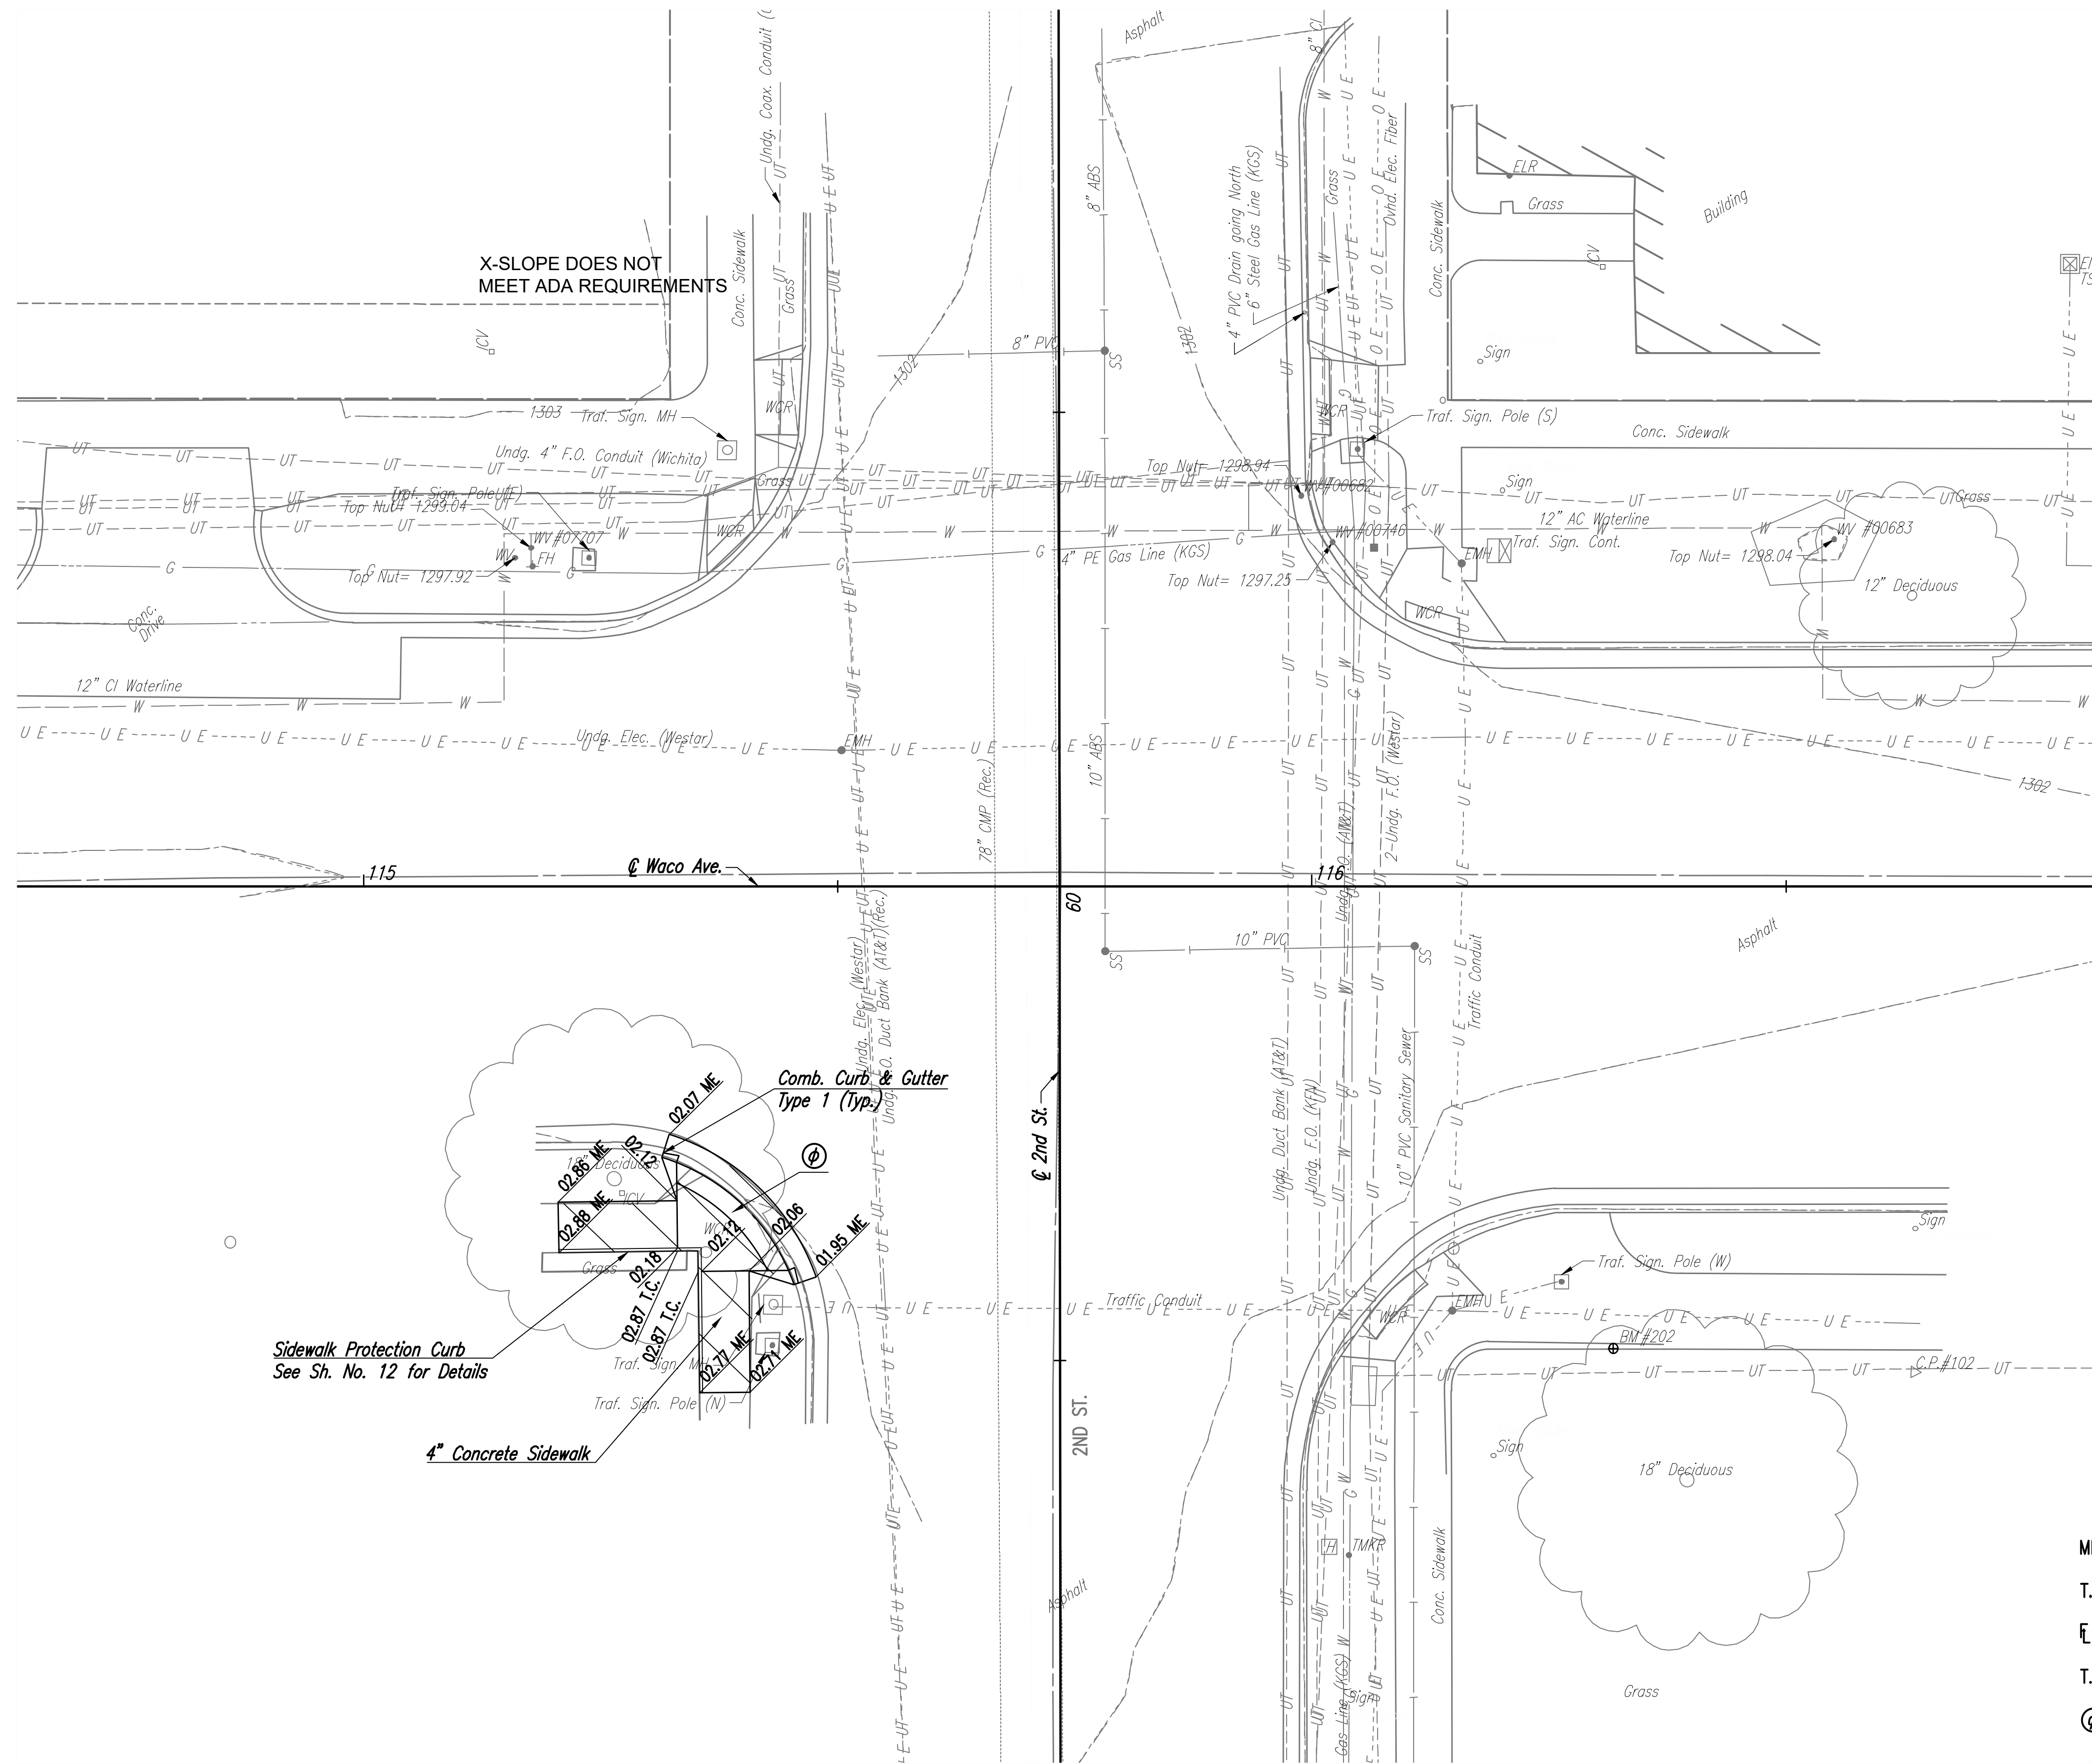
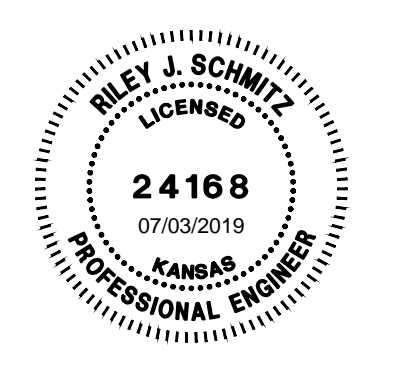


Saved 6/7/2019 8:18:16 AM by CP
 Plot Scale 1:1 7/3/2019 1:40:41 PM by CARLOS PEREZ
 U:\Wichita-Civil\01817042\006\Mun\Trans\Drawings\187042-006-09C-PLAN SECOND

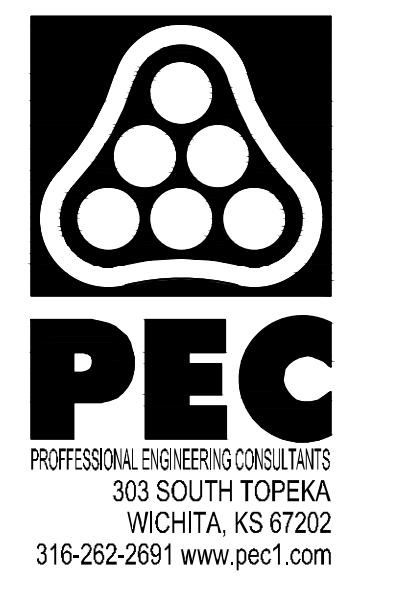

LEGEND

- ME - Match Existing
- T.C. - Top of Curb
- FL - Flowline
- T.E. - Toe Elevation
- ⊗ - Wheelchair Ramp with Detectable Warning
- ▨ - Pavement Removal

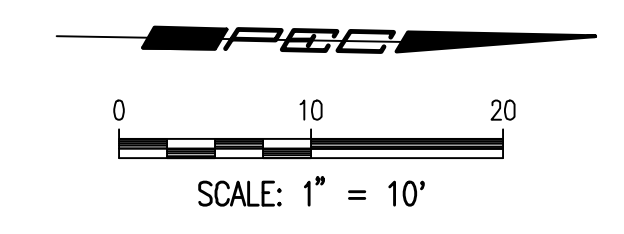

PAVING IMPROVEMENTS
WACO AVENUE FROM DOUGLAS TO CENTRAL
 GARY JANZEN, P.E. - CITY ENGINEER
 CITY OF WICHITA PROJECT NO. 472-85496

Issue:	
JOB NO.	187042-006
DATE	JUNE 2019
PM	BMM
DESIGNED BY	RJS, SAC
DRAWN BY	CP, BJS
CHECKED BY	BMM
WACO & SECOND ST. PLAN	