


Scale: 1" = 20' (1:200) 11/16/21 PM by CSI
 Plot Scale: 1/8" = 20' (1:160) 11/16/21 PM by CSI
 U:\Projects\2019\11-16-21\170551-001\Drawings\C105-GRADING PLAN - WEST

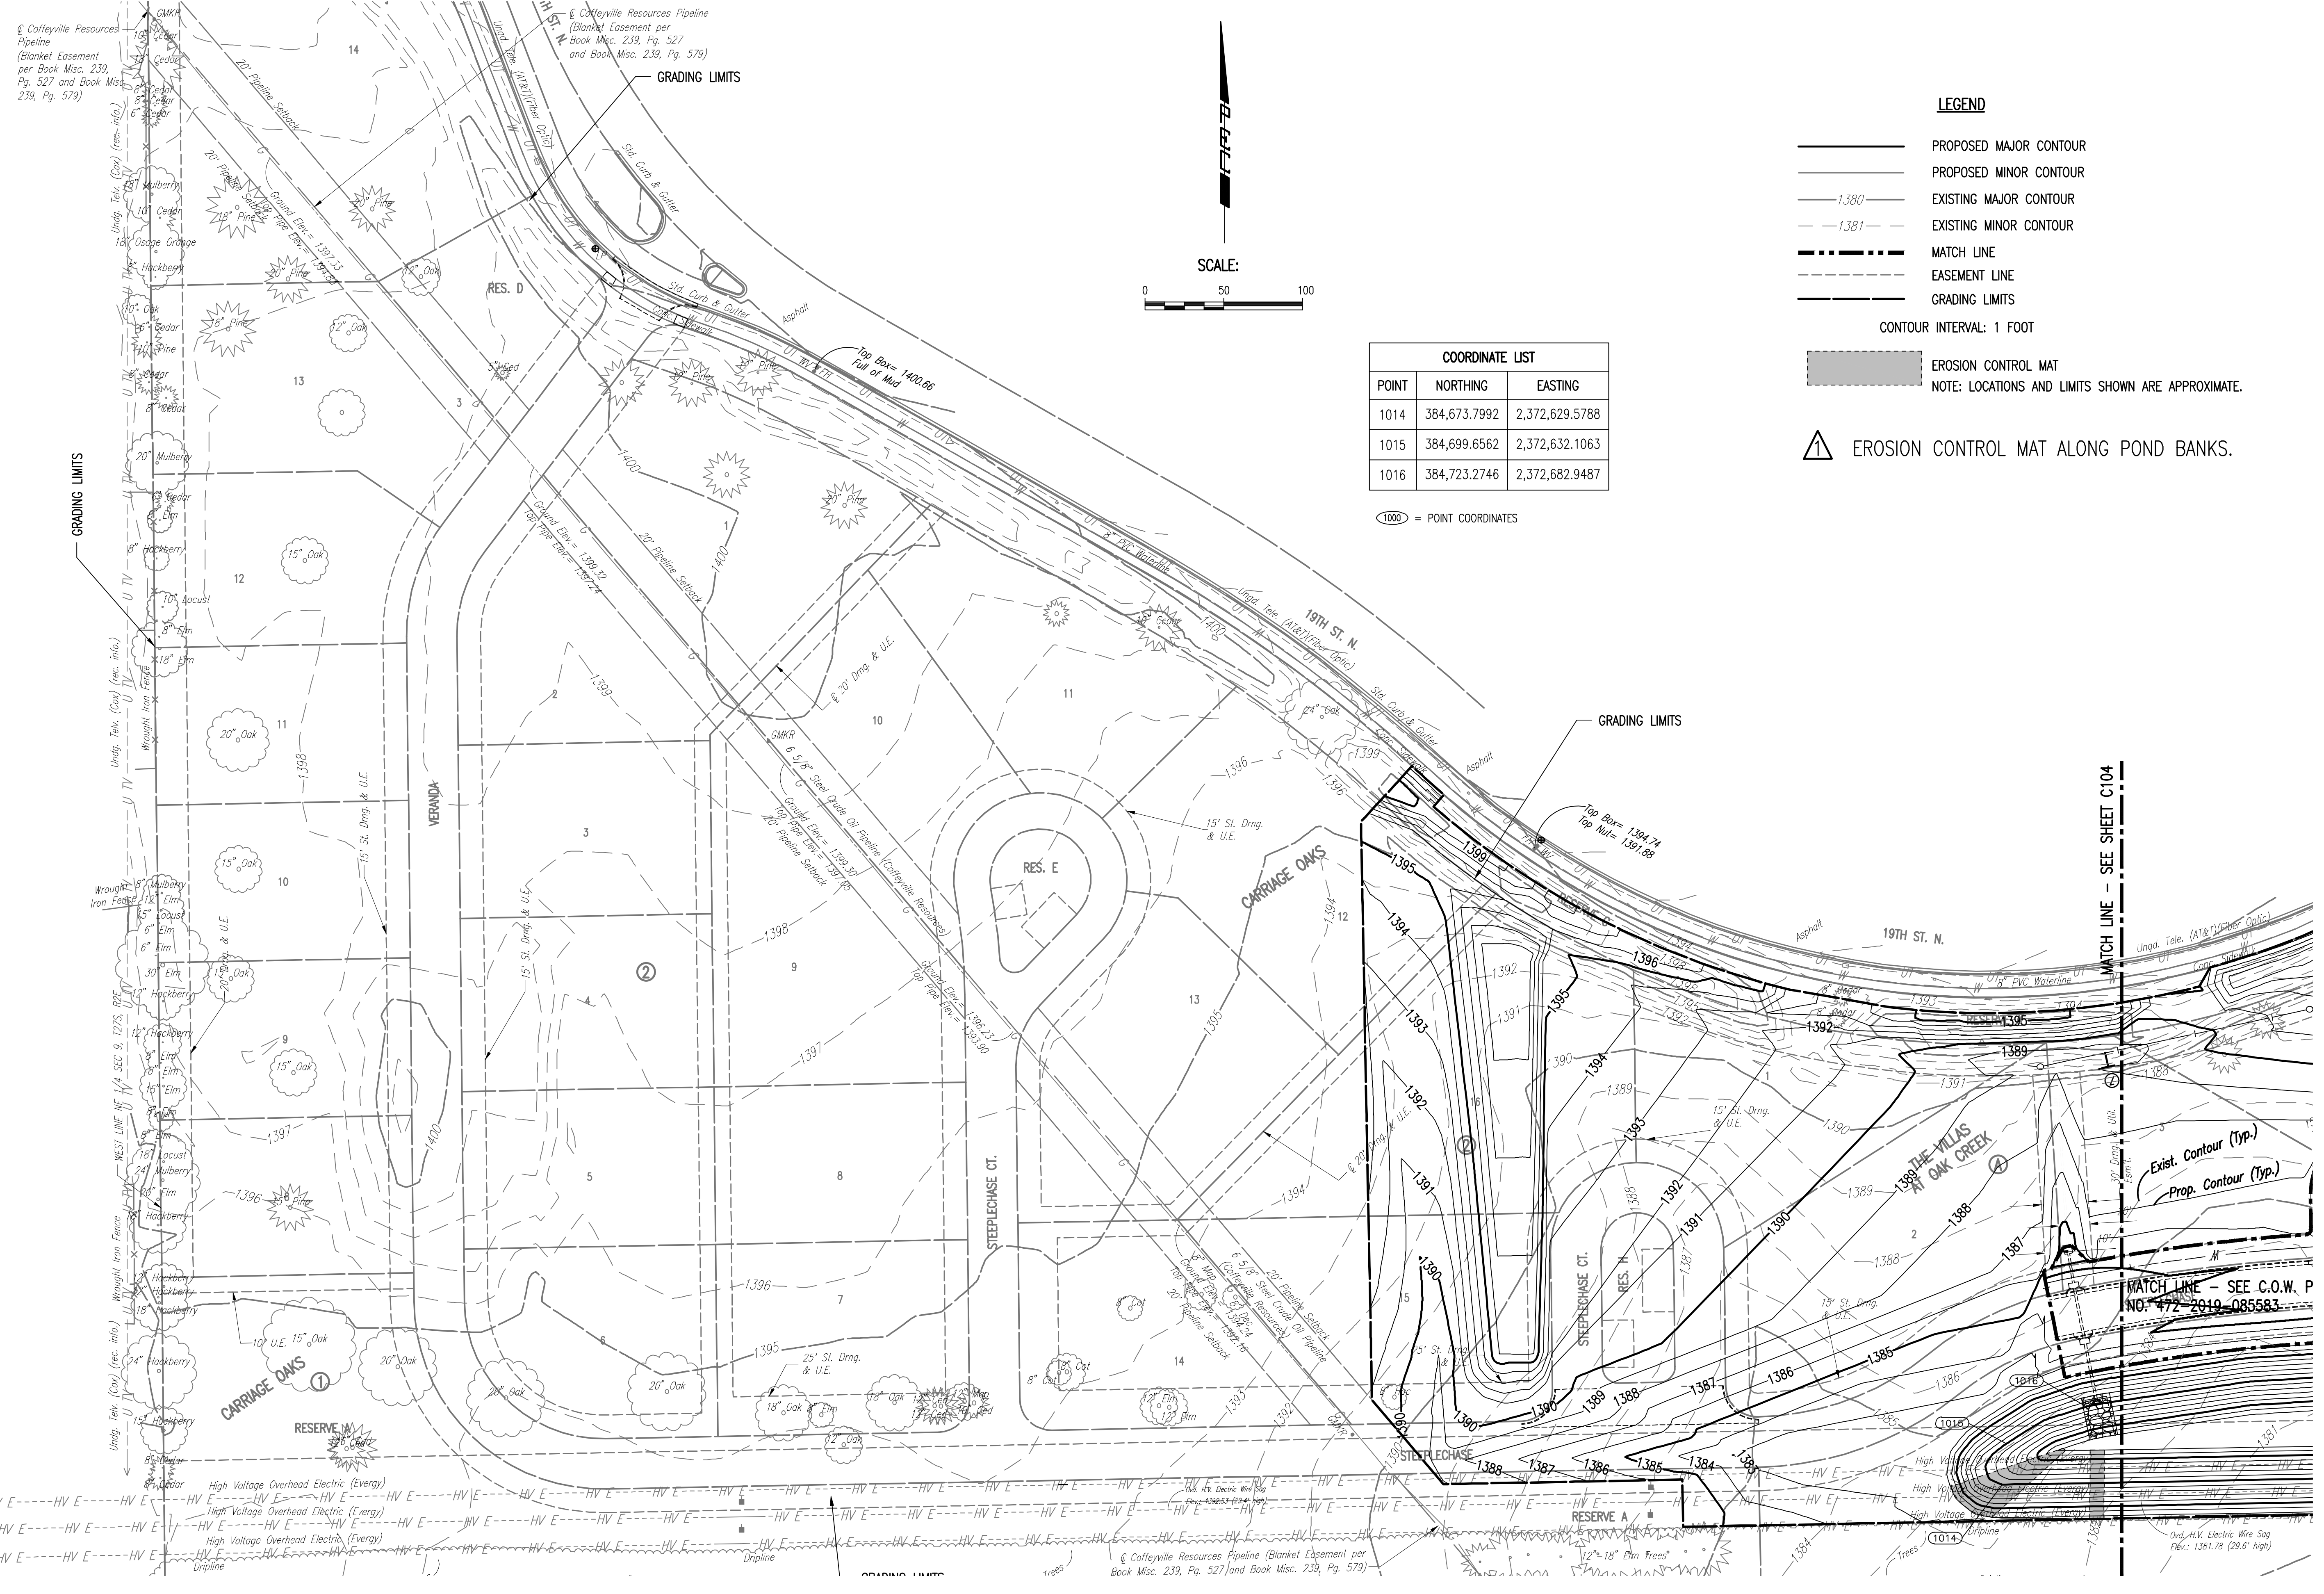


COORDINATE LIST

POINT	NORTHING	EASTING
1014	384,673.7992	2,372,629.5788
1015	384,699.6562	2,372,632.1063
1016	384,723.2746	2,372,682.9487

1000 = POINT COORDINATES

- LEGEND**
- PROPOSED MAJOR CONTOUR
 - PROPOSED MINOR CONTOUR
 - 1,380 — EXISTING MAJOR CONTOUR
 - 1,381 — EXISTING MINOR CONTOUR
 - - - MATCH LINE
 - - - EASEMENT LINE
 - - - GRADING LIMITS
- CONTOUR INTERVAL: 1 FOOT

- ▭ EROSION CONTROL MAT
 - ▲ EROSION CONTROL MAT ALONG POND BANKS.
- NOTE: LOCATIONS AND LIMITS SHOWN ARE APPROXIMATE.

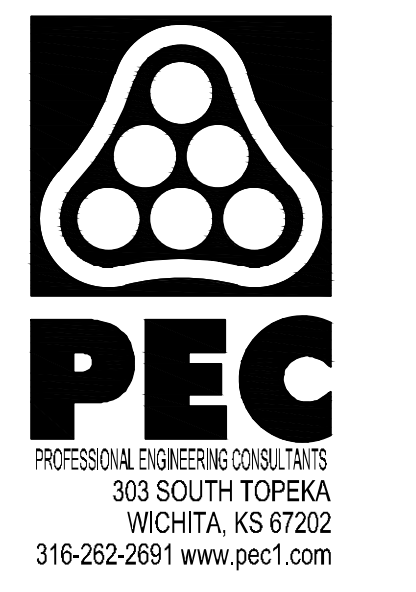

**STORM DRAIN NO. 463
 TO SERVE
 THE VILLAS AT OAK CREEK**

GARY JANZEN, P.E. - CITY ENGINEER
 CITY OF WICHITA PROJECT NO. 468-2019-085434

Issue:		
▲ PONDS		12/02/19
JOB NO.	35-170551-001-0042	
DATE	NOVEMBER 2019	
PM	JAG	
DESIGNED BY	JAG	
DRAWN BY	CSL, KTD	
CHECKED BY	CSB	

GRADING PLAN - WEST

C105