



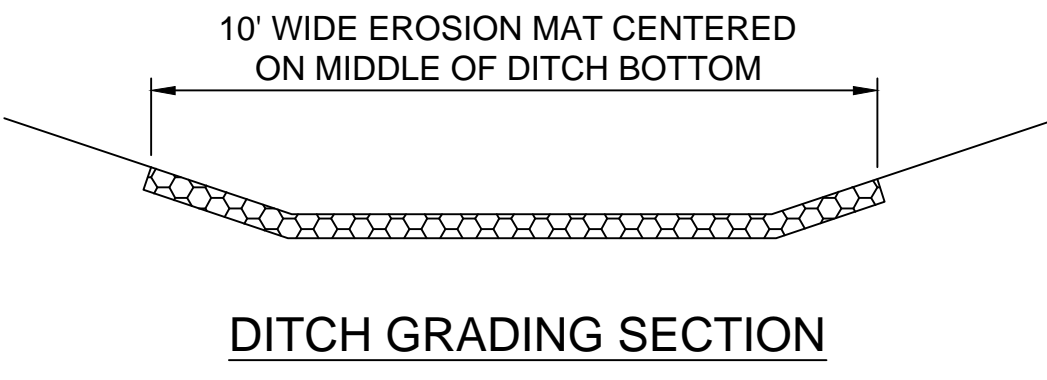

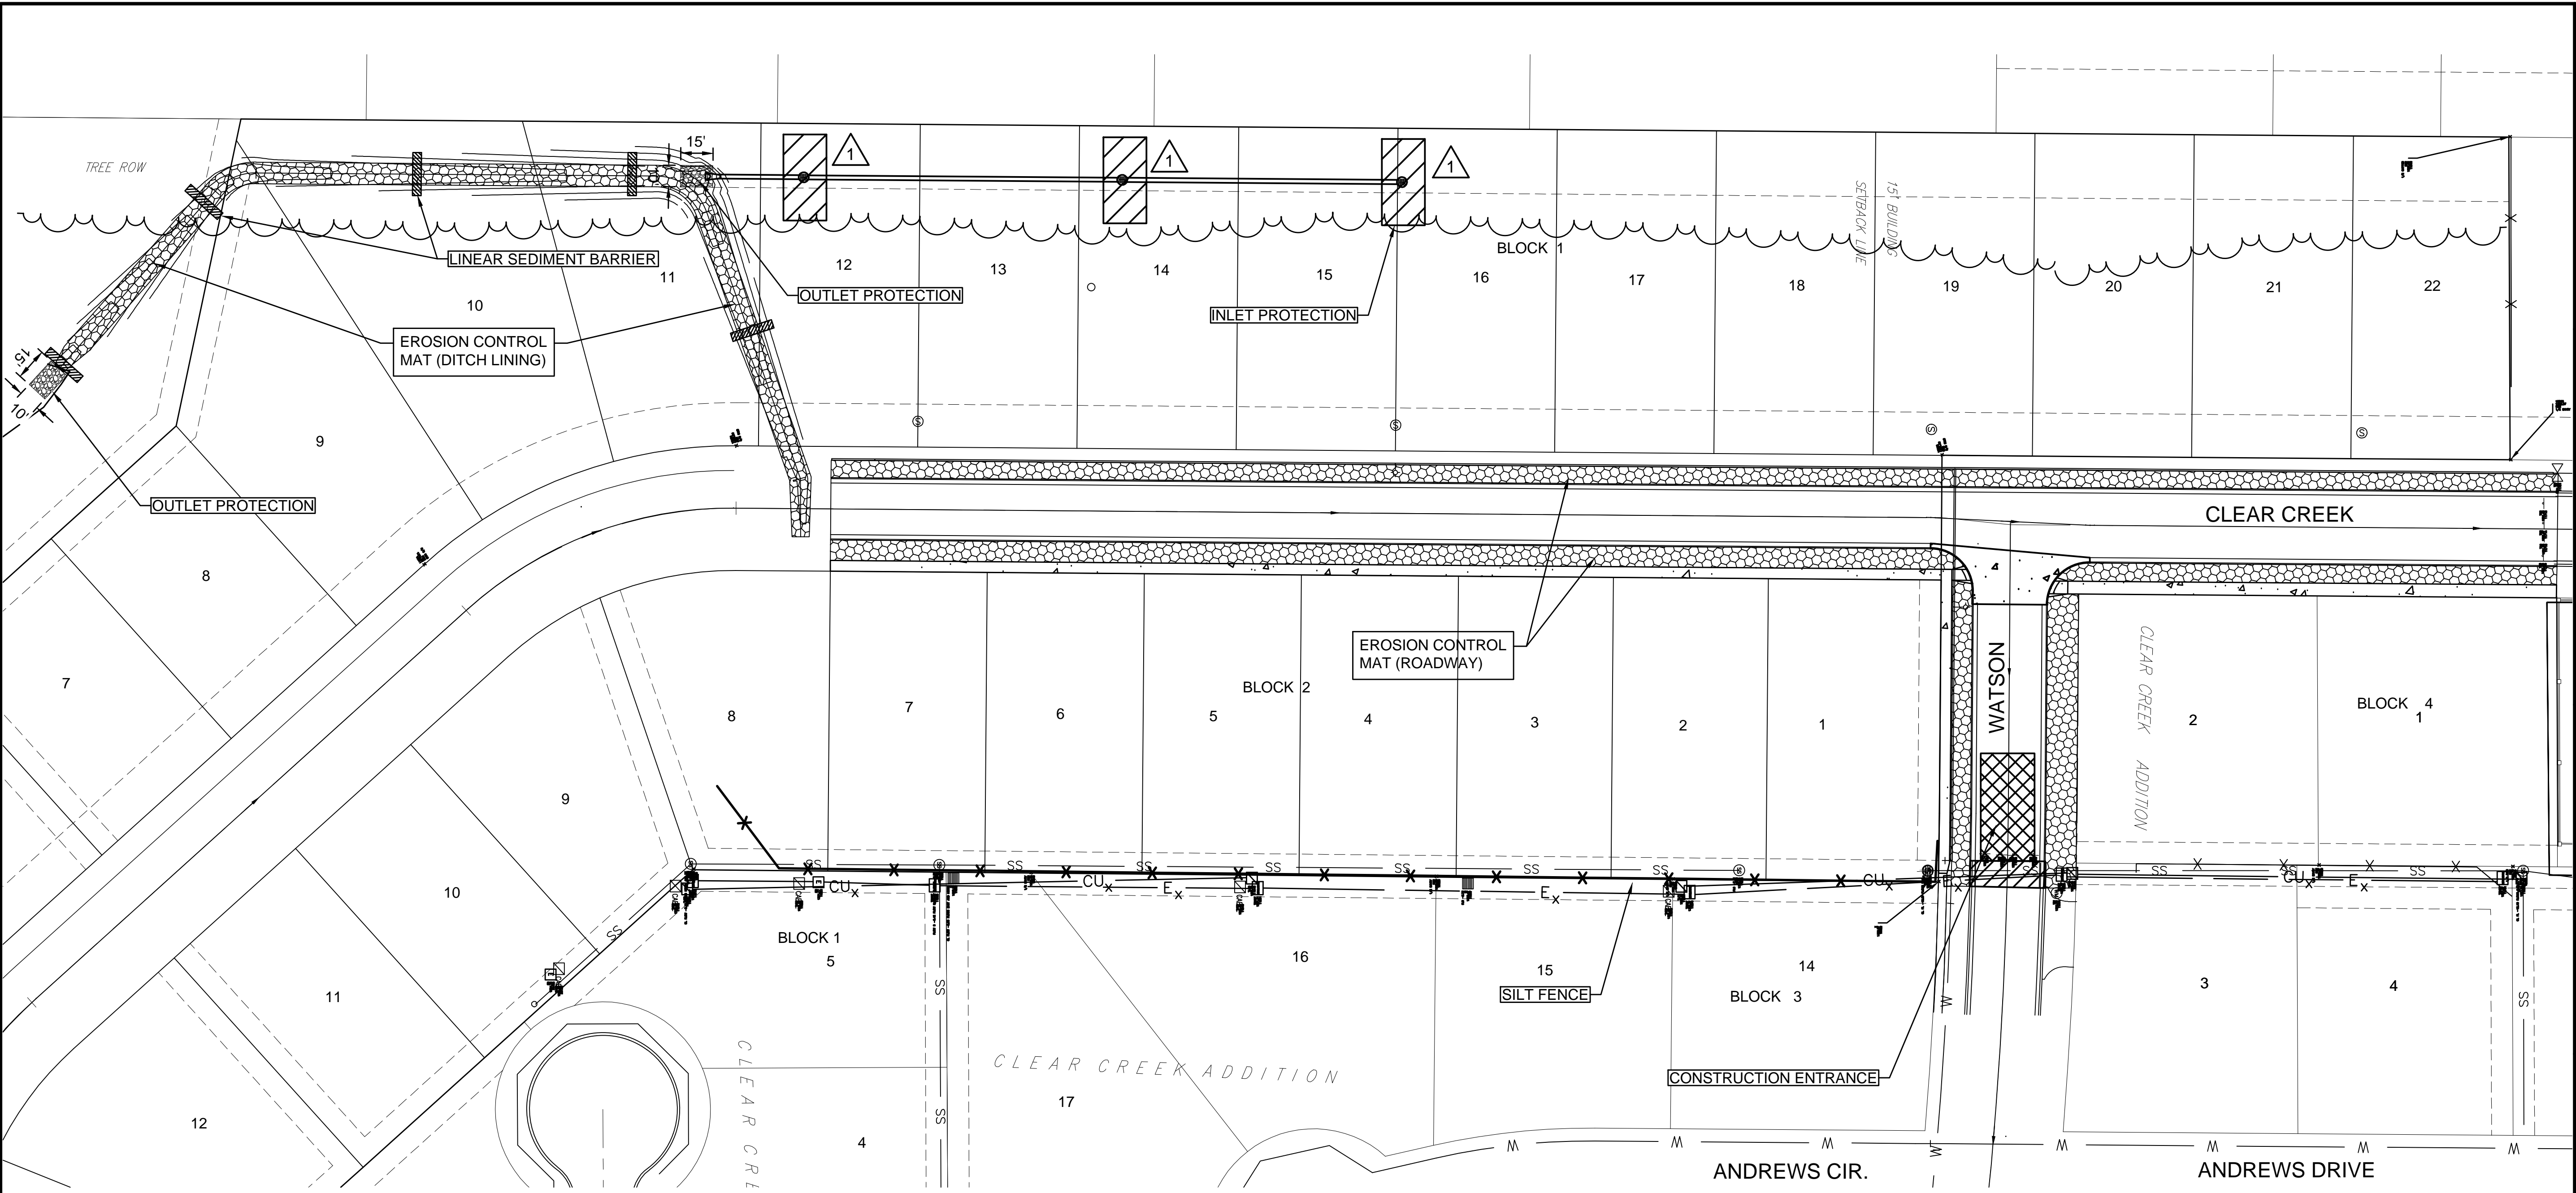

© 2019 GARVER, LLC  
 THIS DOCUMENT, ALONG WITH THE IDEAS AND DESIGNS CONVEYED HEREIN, SHALL BE CONSIDERED INSTRUMENTS OF PROFESSIONAL SERVICE AND ARE PROPERTY OF GARVER, LLC. ANY USE, REPRODUCTION, OR DISTRIBUTION OF THIS DOCUMENT, ALONG WITH THE IDEAS AND DESIGN CONTAINED HEREIN, IS PROHIBITED UNLESS AUTHORIZED IN WRITING BY GARVER, LLC OR EXPLICITLY ALLOWED IN THE GOVERNING PROFESSIONAL SERVICES AGREEMENT FOR THIS WORK.

8535 E. 21st Street N.  
 Wichita, KS 67206  
 (316) 264-8008



**LEGEND**

-  MAINTAIN CONSTRUCTION ENTRANCE (1 EACH)
-  INSTALL SILT FENCE ( 600 L.F.)
-  INSTALL INLET PROTECTION (3 EACH)
-  INSTALL LINEAR SEDIMENT BARRIER (DITCH CHECKS) ( 5 EACH)
-  INSTALL EROSION CONTROL MAT (CURLEX)  
 ROADWAY (1,849 SQ. YDS.)  
 DITCH LINING (555 SQ. YDS.)  
 TOTAL (2,404 SQ. YDS.)

File: L:\2018\18267009 - Clear Creek Ph 5 Engineering\Drawings\C3D\18267009-Erosion Control.dwg, Last Saved: 12/6/2019 6:20 AM, Last saved by: E.J.Glover  
 Last plotted by: Glover, Eric J., Plot Style: ---, Plot Scale: 1:2.5849, Plot Date: 12/9/2019 11:01 AM, Plotter used: None

REV.	DATE	DESCRIPTION	BY



CITY OF WICHITA  
 WICHITA, KANSAS  
 CLEAR CREEK  
 PHASE 5 - PAVING

**EROSION CONTROL PLAN**

JOB NO.: 18267009  
 DATE: DEC. 2019  
 DESIGNED BY: E.JG  
 DRAWN BY: DRS

BAR IS ONE INCH ON ORIGINAL DRAWING  
 IF NOT ONE INCH ON THIS SHEET, ADJUST SCALES ACCORDINGLY.

DRAWING NUMBER