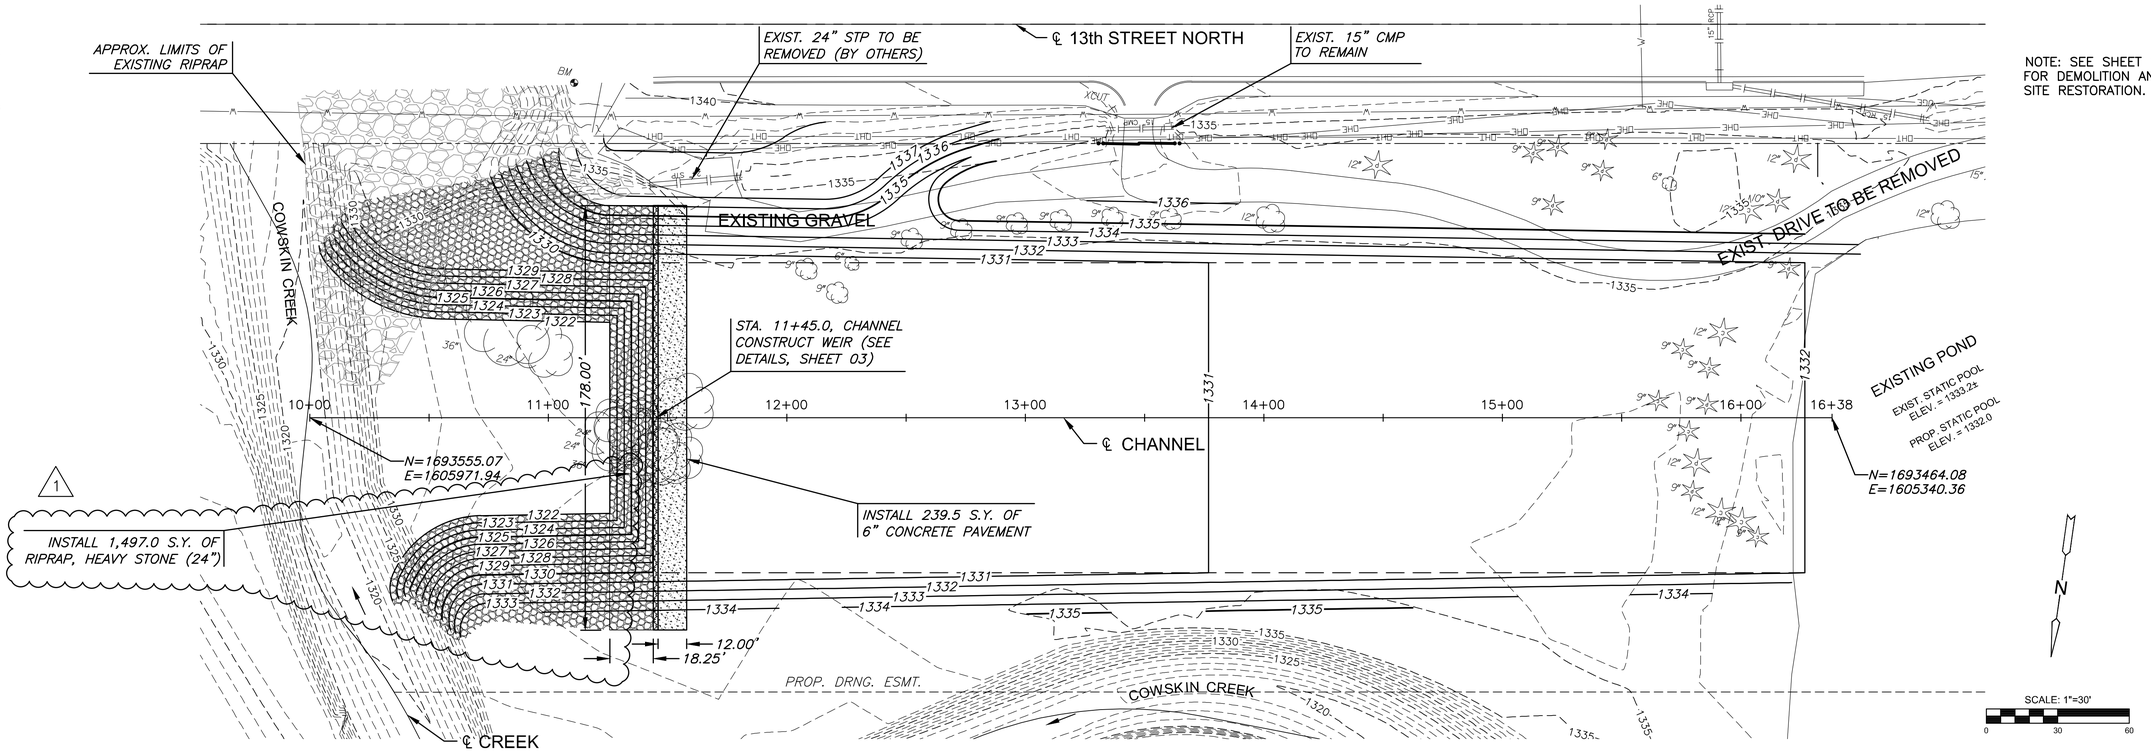

CHANNEL PLAN

CHANNEL PROFILE

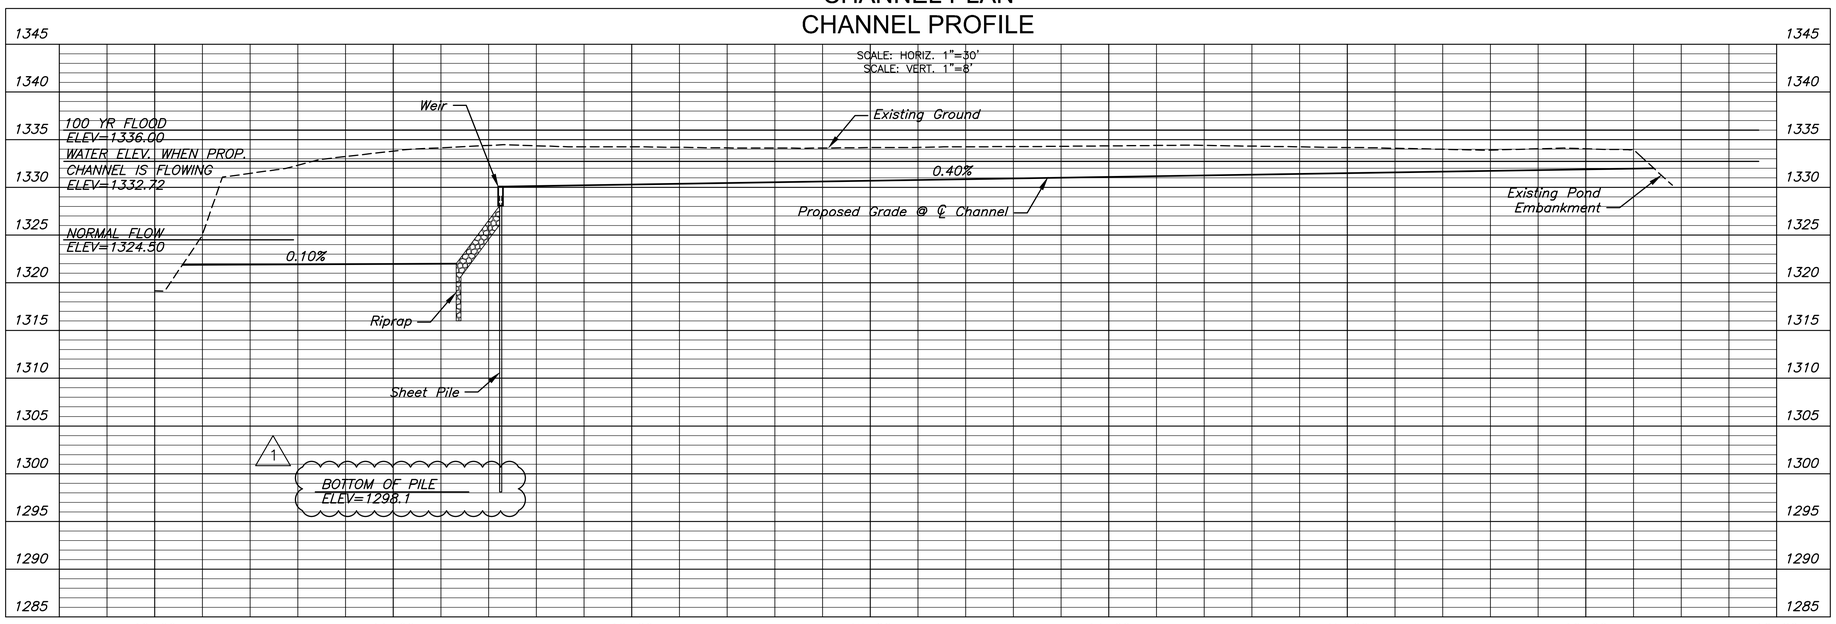

MKEC
Wichita, KS • 316-684-9600

STORM WATER SEWER PLAN FOR

COWSKIN CREEK AT 13TH ST. N.

WICHITA, KANSAS

©2019
MKEC Engineering
All Rights Reserved
www.mkec.com
These drawings and their contents, including, but not limited to, all concepts, designs, & ideas are the exclusive property of MKEC Engineering (MKEC), and may not be used or reproduced in any way without the express consent of MKEC.

CHANNEL PLAN AND PROFILE

PROJECT NO.	468-85055
DATE	OCT. 2016
SCALE	AS SHOWN

DESIGNED	DRAWN	CHECKED
BLB	DMU	BLB

NO.	REVISION	DATE
1	PER KDHE COMMENTS	01/17/19
0	ISSUED FOR CONST.	10/10/16

SHEET NO.

02 OF 17

PLOTTED: Wednesday, December 11, 2019 @ 01:17PM
J:\PROJECTS\2015\150\10\0491_COW 13TH STREET AT COWSKIN_15049 CAD\SHTS\05 CIVIL\SWS\15491P01.DWG