




Maple Shade Addition

Brentwood South Addition

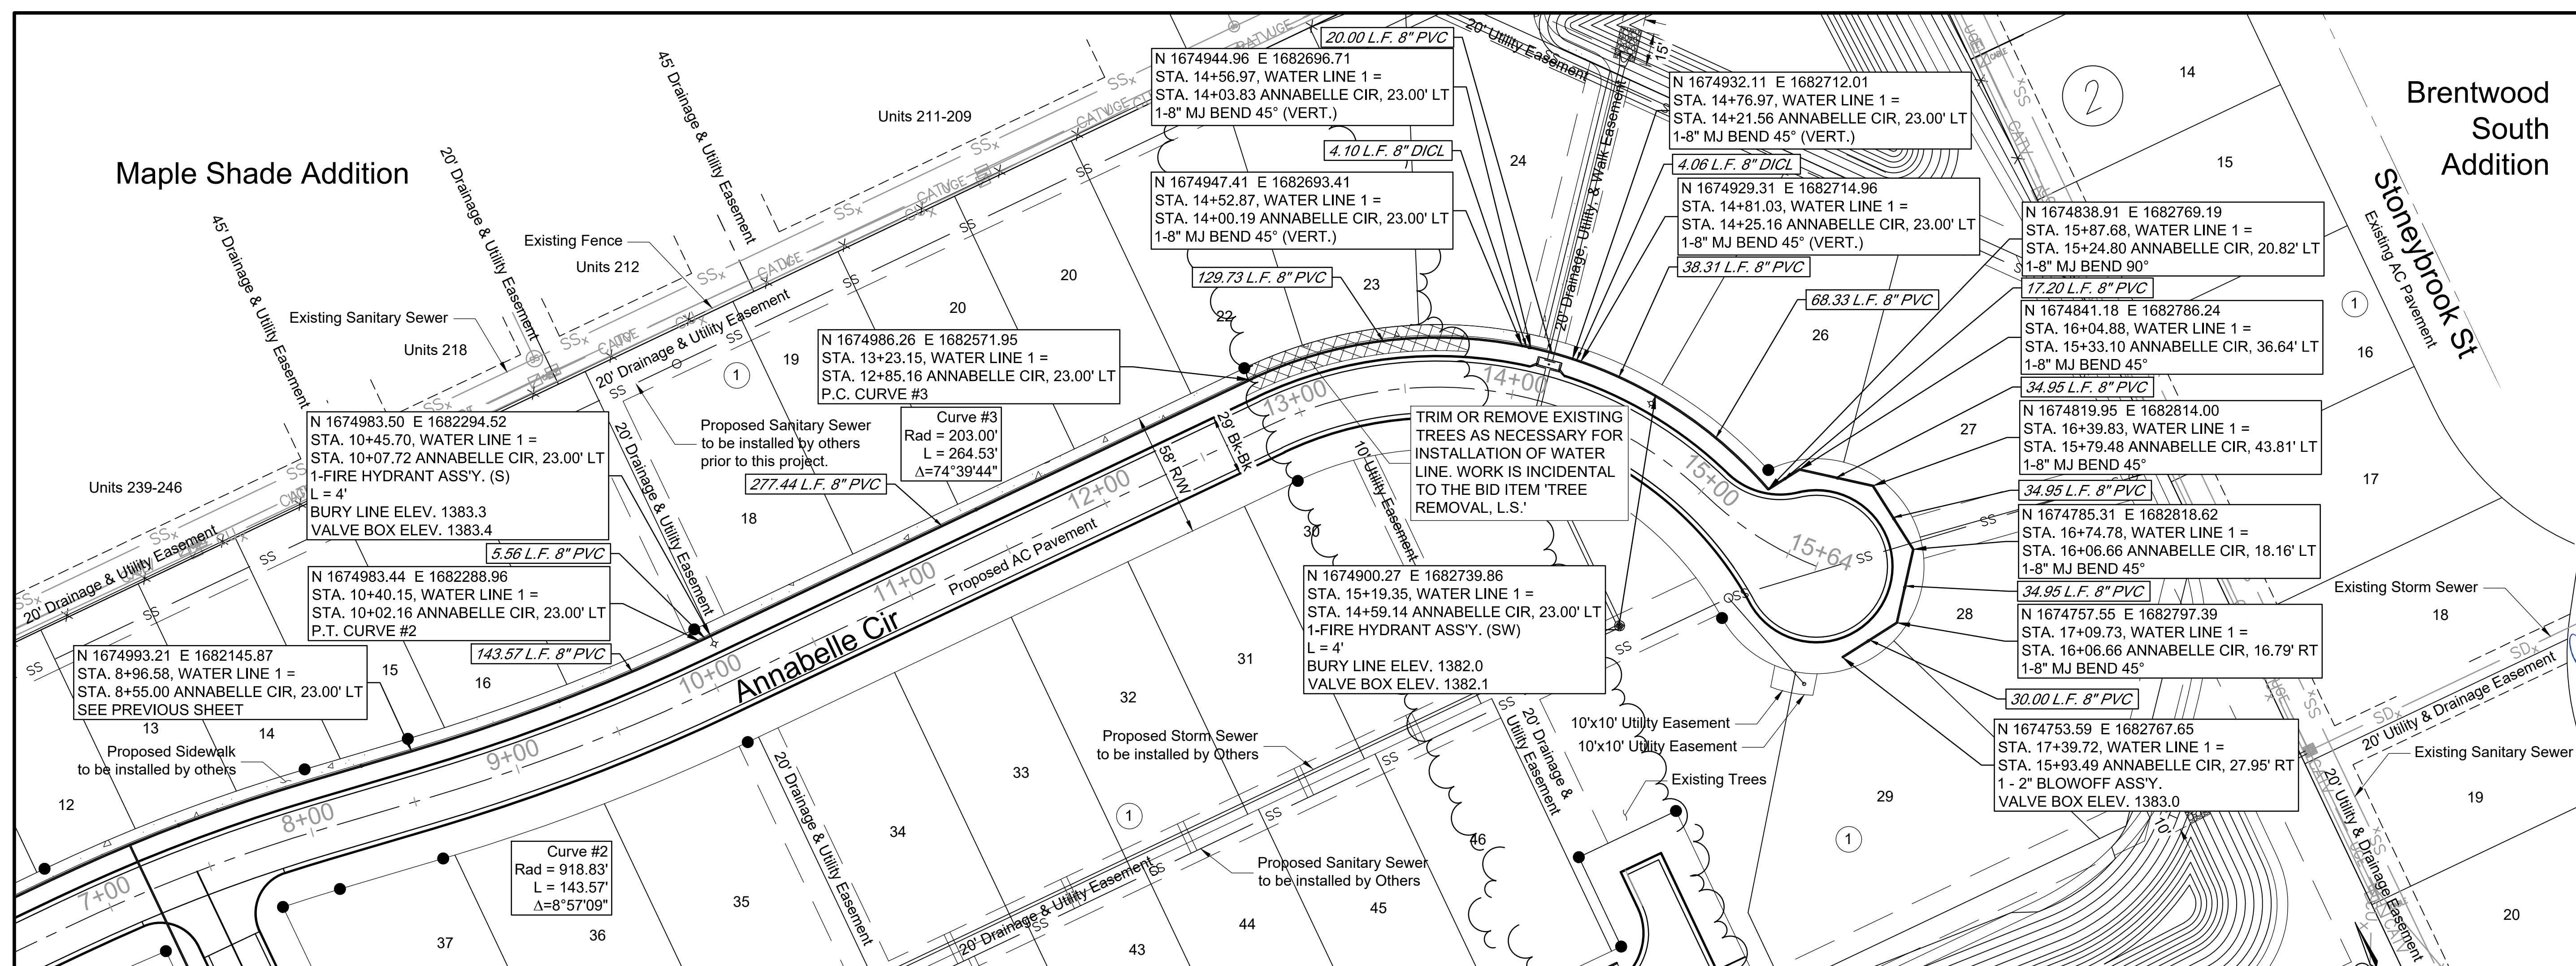

Curve #2
Rad = 918.83'
L = 143.57'
Δ=8°57'09"

Curve #3
Rad = 203.00'
L = 264.53'
Δ=74°39'44"

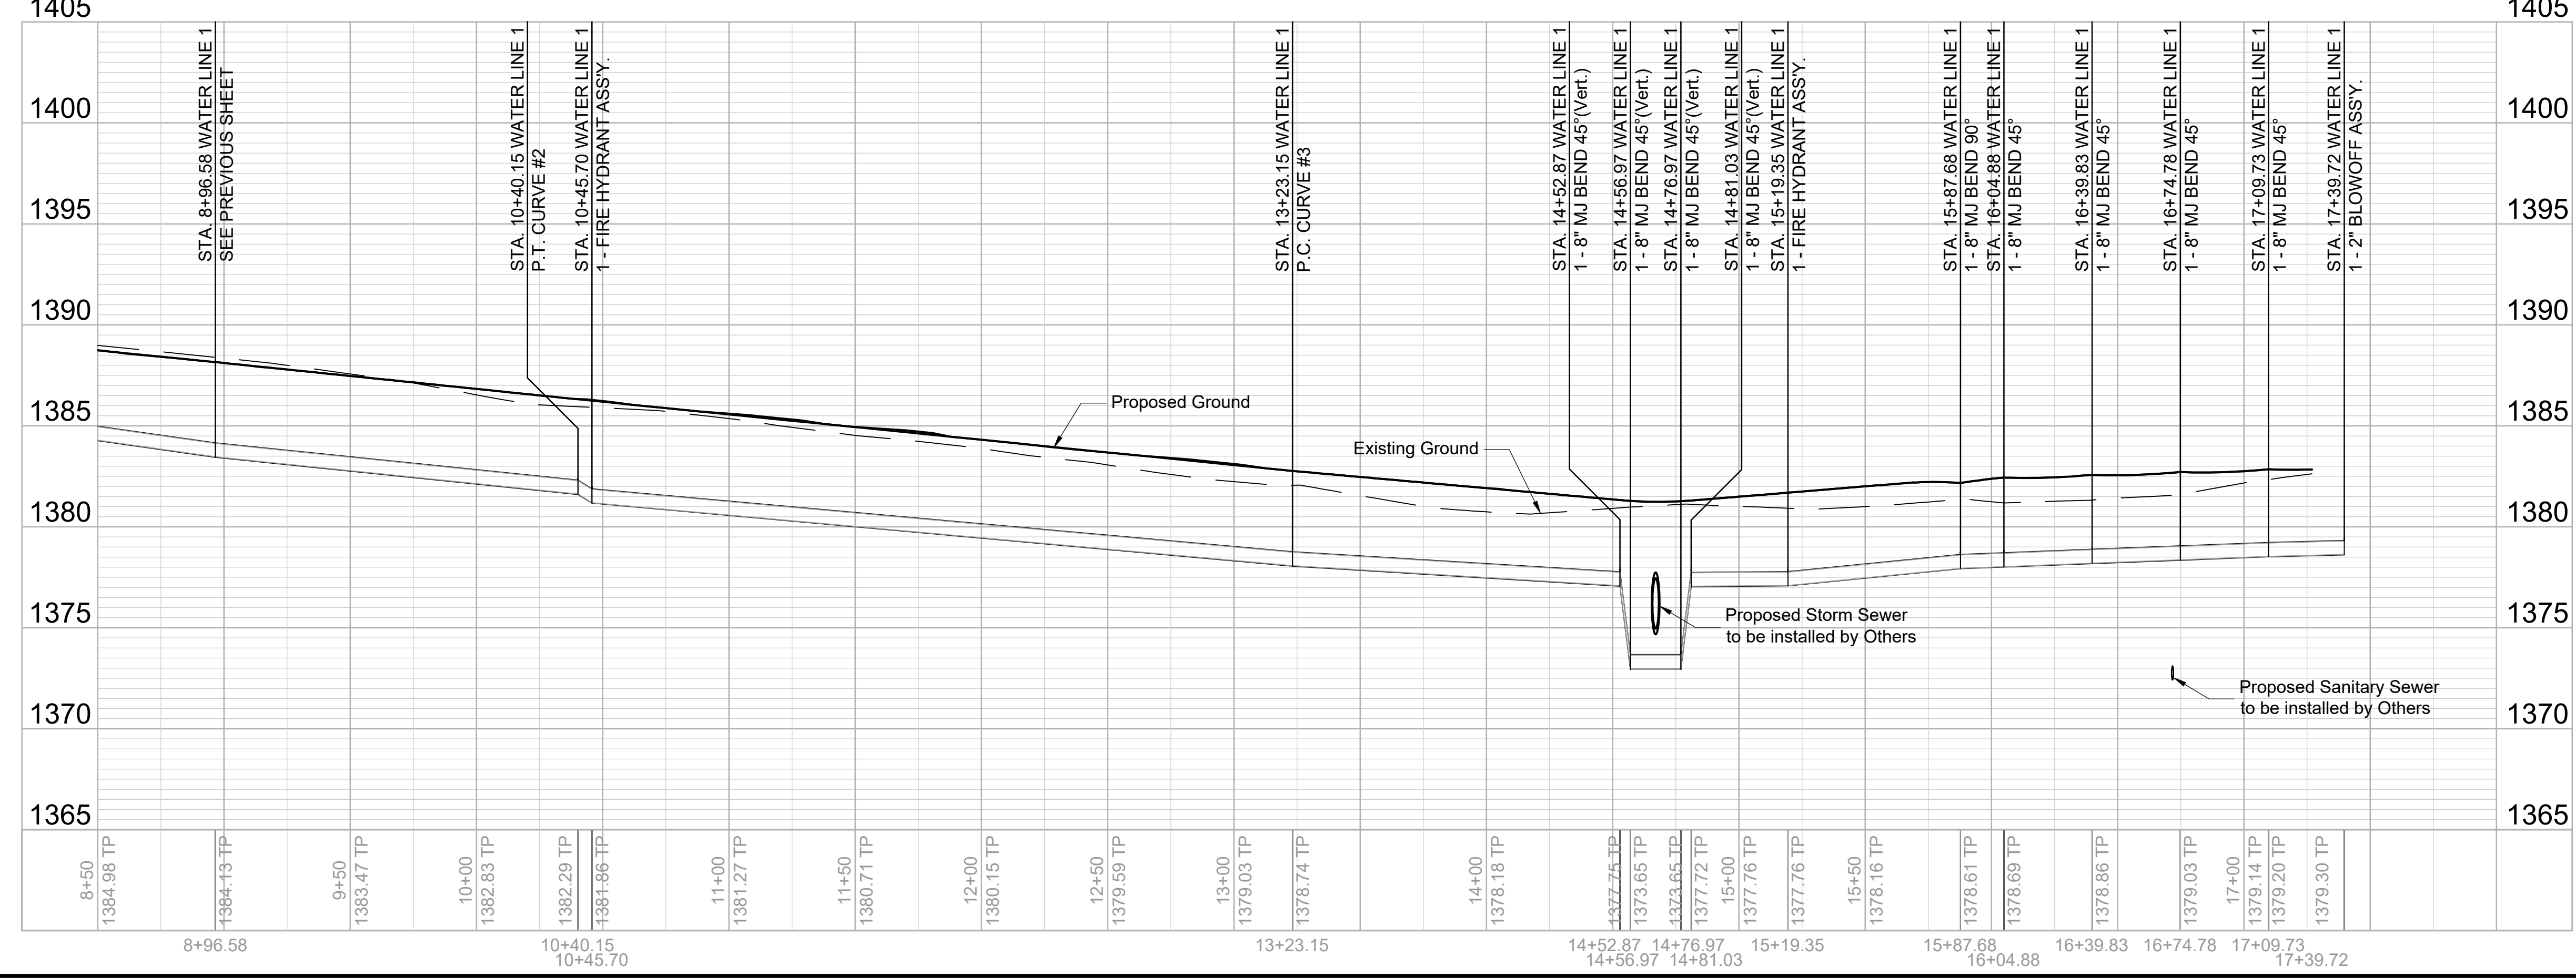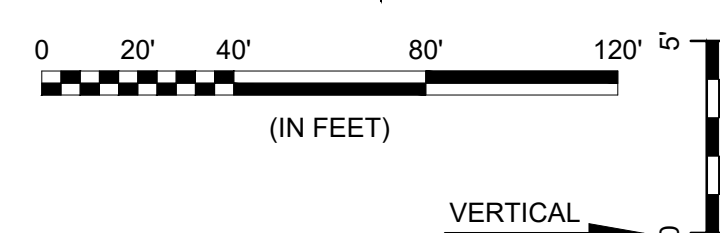

© 2020 GARVER, LLC
THIS DOCUMENT, ALONG WITH THE IDEAS AND DESIGNS CONVEYED HEREIN, SHALL BE CONSIDERED INSTRUMENTS OF PROFESSIONAL SERVICE AND ARE PROPERTY OF GARVER, LLC. ANY USE, REPRODUCTION, OR DISTRIBUTION OF THIS DOCUMENT, ALONG WITH THE IDEAS AND DESIGN CONTAINED HEREIN, IS PROHIBITED UNLESS AUTHORIZED IN WRITING BY GARVER, LLC OR EXPLICITLY ALLOWED IN THE GOVERNING PROFESSIONAL SERVICES AGREEMENT FOR THIS WORK.

REV.	DATE	DESCRIPTION	BY
1	02/28/20	Extended Pipe for Lot 29	CDJ

CITY OF WICHITA
WICHITA, KS
CHALET RIDGE ADDITION
WATER

WATER LINE 1

JOB NO.: 19T41021
DATE: FEB 2019
DESIGNED BY: CMB
DRAWN BY: CDJ

BAR IS ONE INCH ON ORIGINAL DRAWING
IF NOT ONE INCH ON THIS SHEET, ADJUST SCALES ACCORDINGLY.
DRAWING NUMBER
SHEET NUMBER **4** OF **15**

File: L:\2019\19T41021 - VCRC Improvements\Drawings\C3DWATER\WATER LINE 1 (1).dwg Last Save: 2/28/2020 11:54 AM Last saved by: CDJurey
Last plotted by: Jurey, Caleb D. Plot Date: 3/2/2020 8:43 AM Plotter Used: None