



3/27/2020 11:06:45 AM
 BIM 360://198014-003 - Watson Park Events Center New Building/198014_MASTER
 STRUCT_R19.rvt

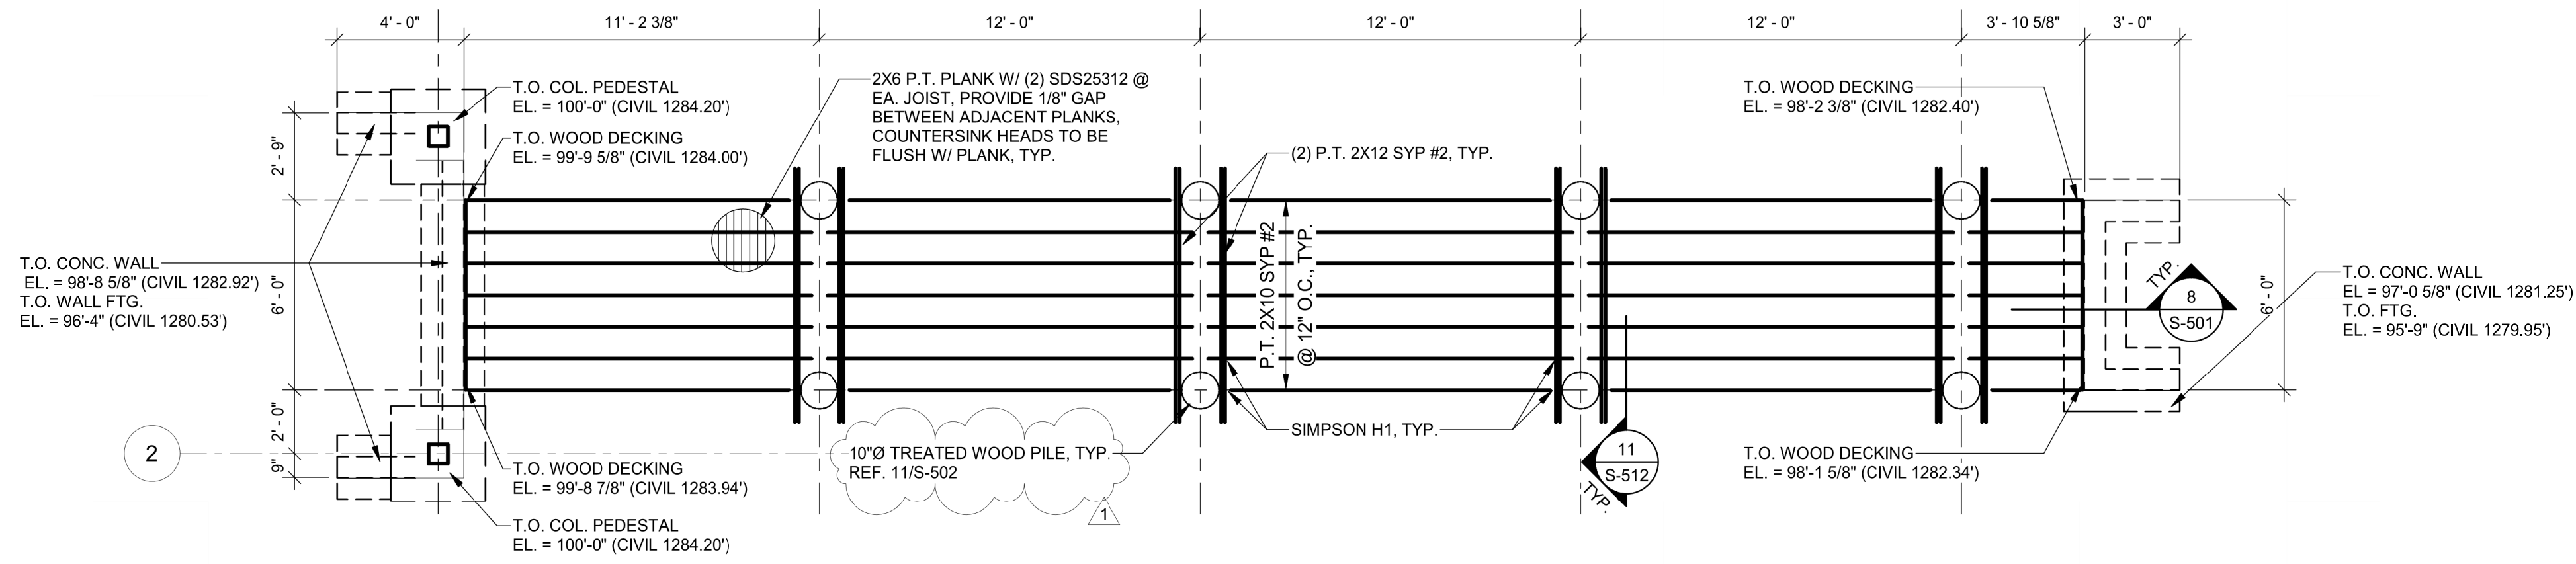

1 EAST BRIDGE FRAMING PLAN
 1/4" = 1'-0"

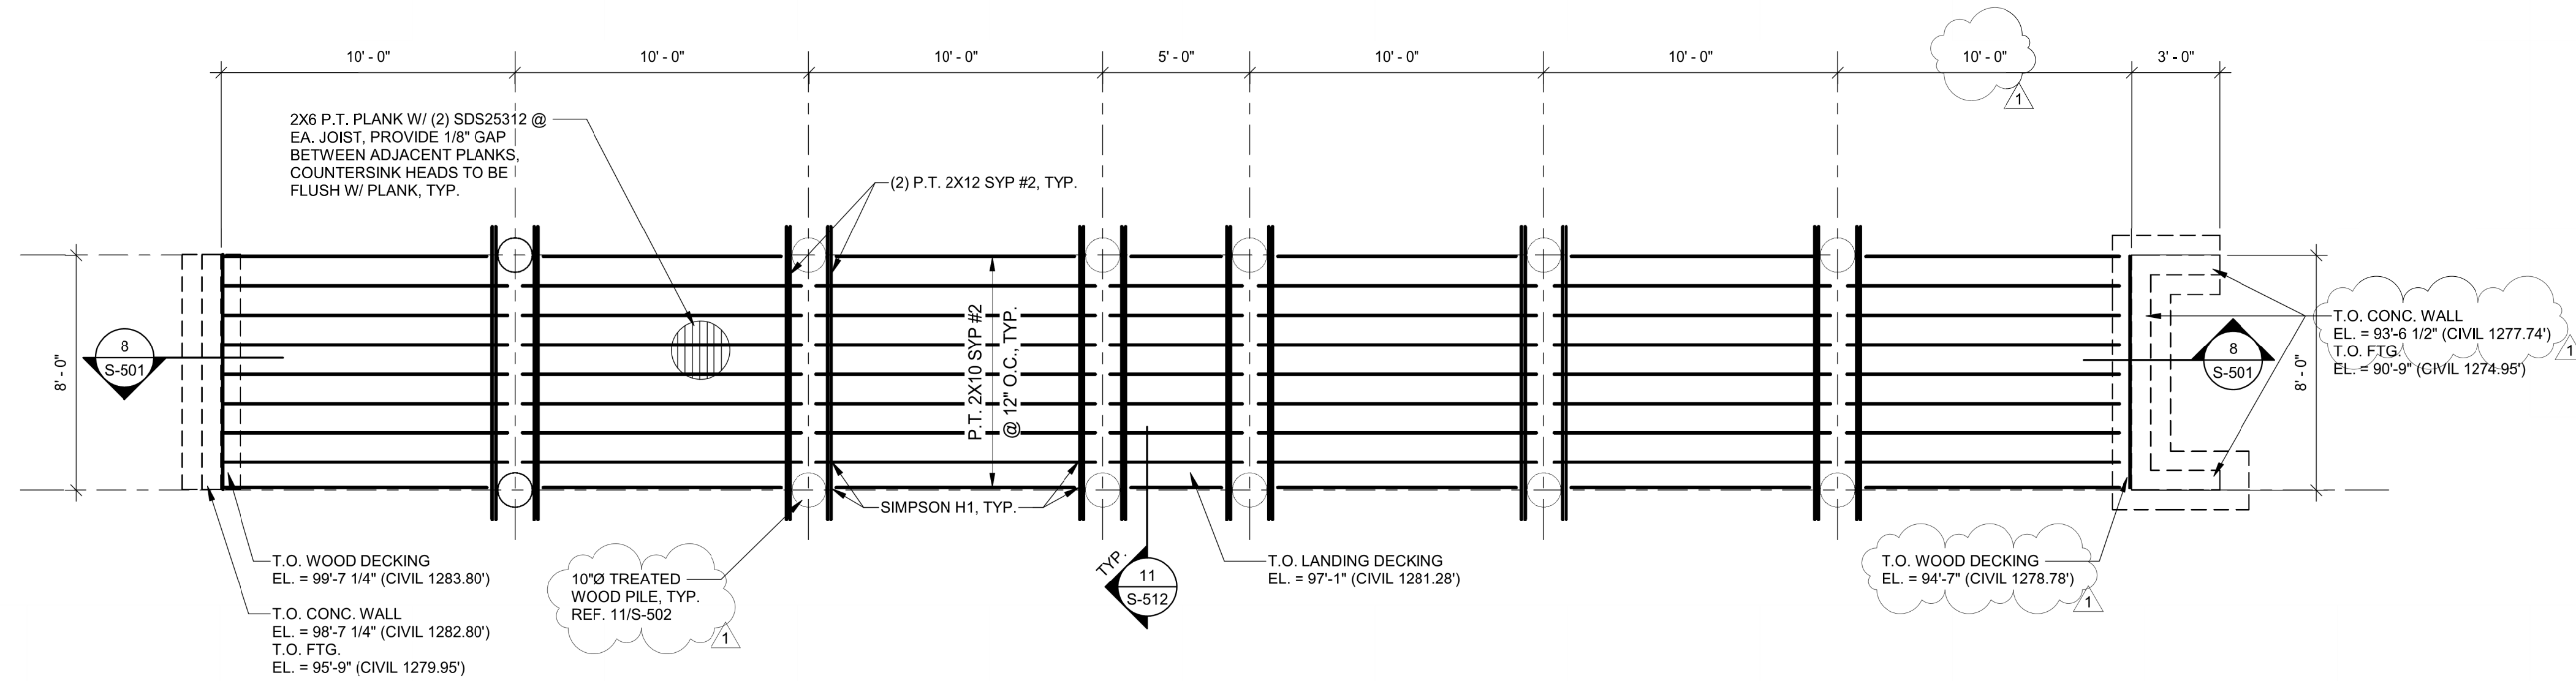

2 SOUTH BRIDGE FRAMING PLAN
 1/4" = 1'-0"