



SAVED 2/28/2020 11:31:35 AM BY TREVOR KAUFMAN
 PLOTTED 2/28/2020 11:36:00 AM BY TREVOR KAUFMAN, PE
 U:\WICHITA-CIVIL\2018\180714\000\MIDDRAWINGS\180714-000-C103-SANITARY SEWER LINE NO.1.DWG

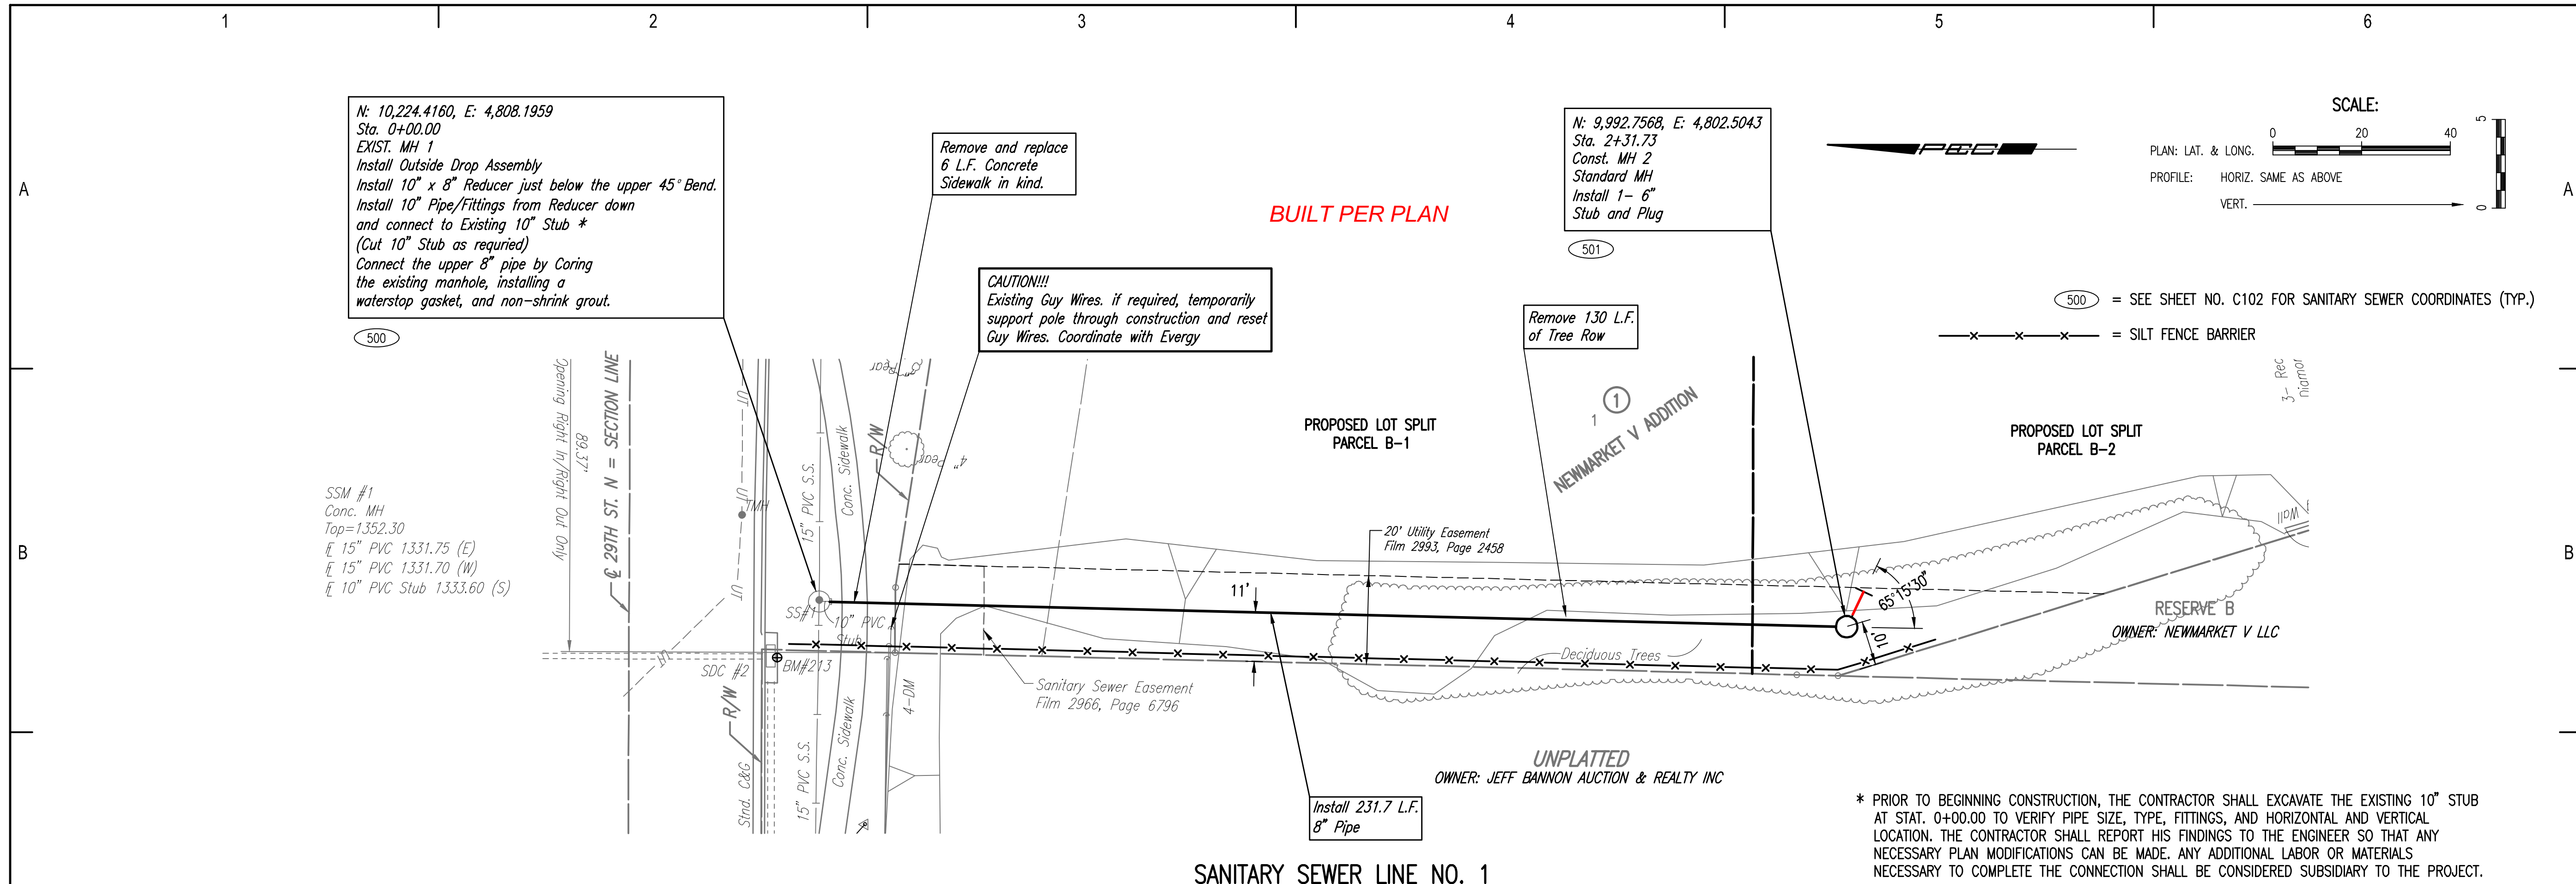

SANITARY SEWER LINE NO. 1

* PRIOR TO BEGINNING CONSTRUCTION, THE CONTRACTOR SHALL EXCAVATE THE EXISTING 10" STUB AT STAT. 0+00.00 TO VERIFY PIPE SIZE, TYPE, FITTINGS, AND HORIZONTAL AND VERTICAL LOCATION. THE CONTRACTOR SHALL REPORT HIS FINDINGS TO THE ENGINEER SO THAT ANY NECESSARY PLAN MODIFICATIONS CAN BE MADE. ANY ADDITIONAL LABOR OR MATERIALS NECESSARY TO COMPLETE THE CONNECTION SHALL BE CONSIDERED SUBSIDIARY TO THE PROJECT.

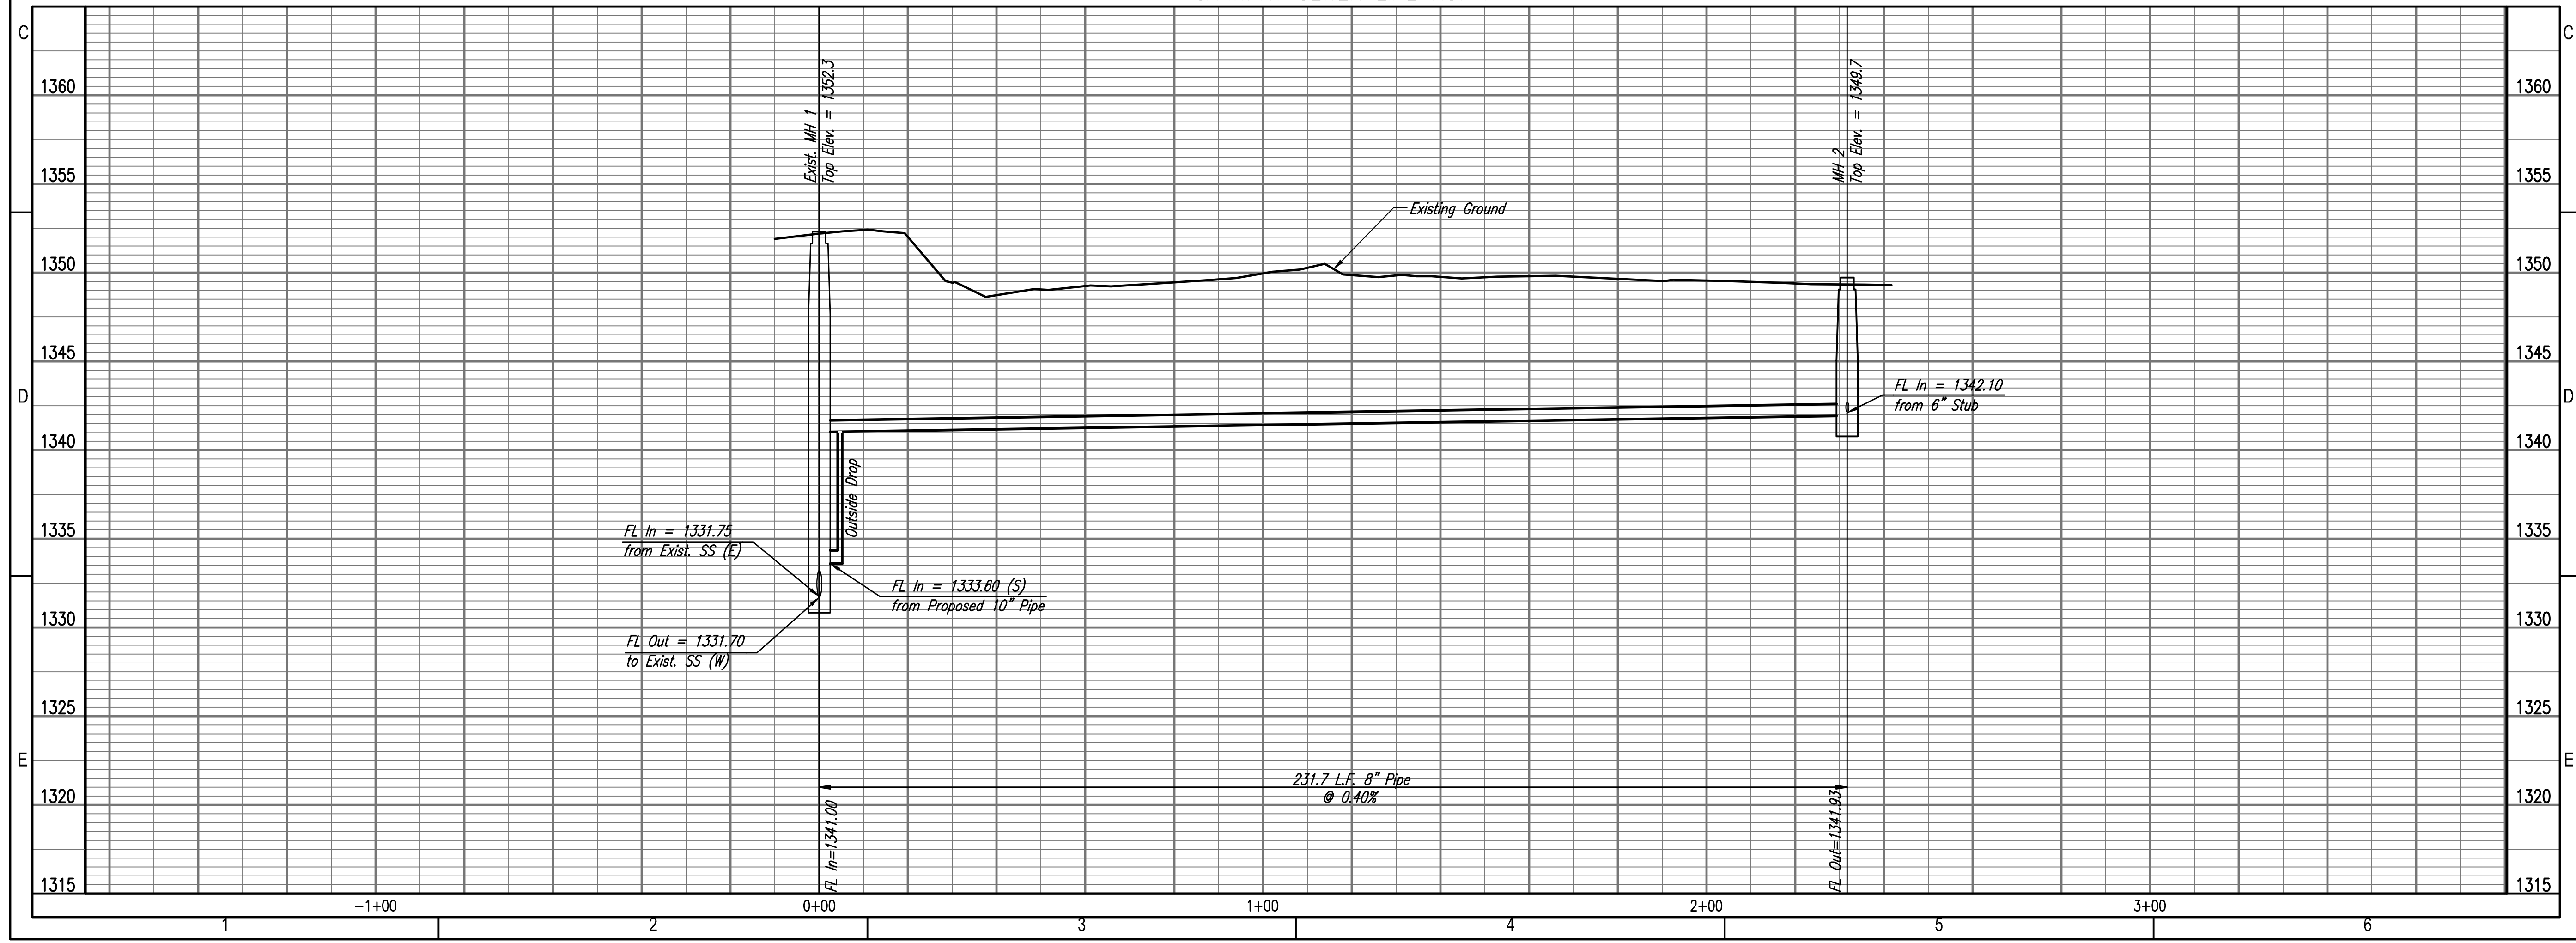

NEWMARKET V ADDITION
SANITARY SEWER EXTENSION
 GARY JANZEN, P.E. - CITY ENGINEER
 CITY OF WICHITA
 PROJECT NO. 468-2019-010174 / 468-85152

Issue:	
JOB NO.	35-180714-000-6364
DATE	OCTOBER 2019
PM	RWG
DESIGNED BY	TBK
DRAWN BY	KTD
CHECKED BY	RWG

SANITARY SEWER LINE NO. 1
C103