


BM#3 - "□" Cut at SE Corner, Lot 4,
Tyler Acres 5th Addition, NW of
Central Avenue & Socora Lane,
65.10'± North and 34.94'± West
of Centerline of Both.
Sta. 28+81.30
Elev. = 148.79 (City Datum)

 = Saw and Remove Full Depth

WATER VALVE BOX & WATER METER ADJUSTMENTS					
ITEM	STATION	EX. OFFSET	NEW OFFSET	EX. ELEV.	NEW ELEV.
WATER VALVE	27+46.99	28.0' Rt.	—	148.22	147.60
WATER VALVE	27+79.18	30.0' Rt.	—	148.37	147.62
WATER VALVE	27+88.35	31.0' Rt.	—	143.36	147.55

SCALE: 1" = 20'

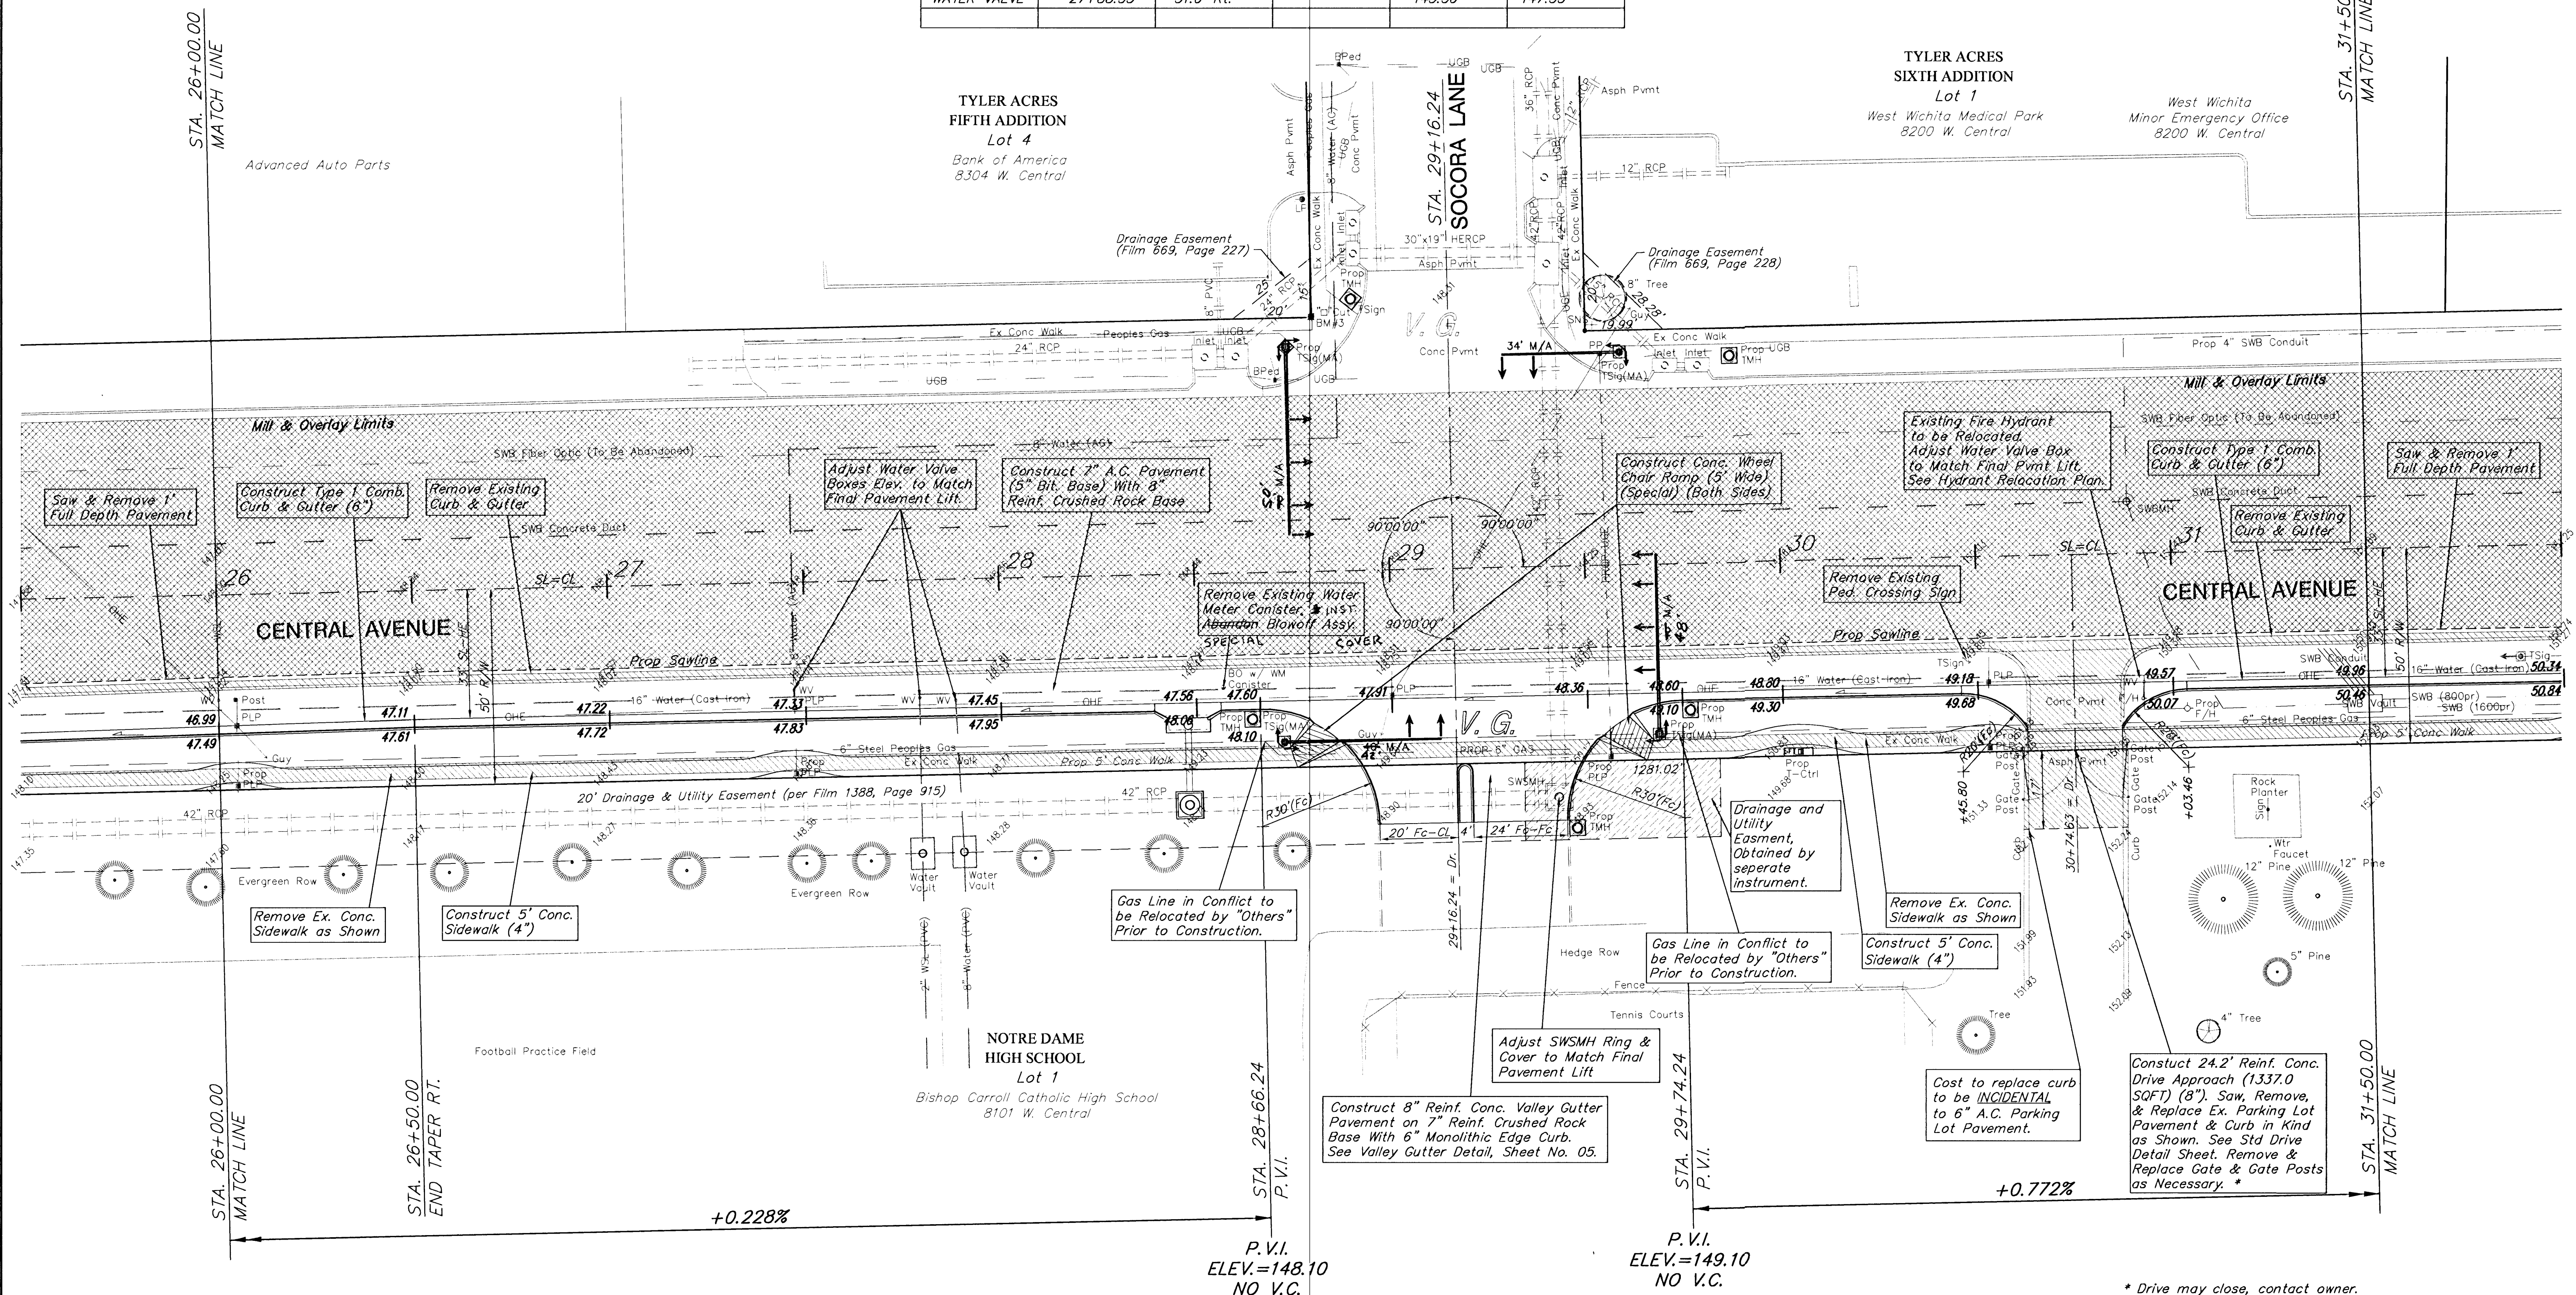

* Drive may close, contact owner.

Irrigation Systems within Public R/W in Conflict with the New Construction to be Removed and Replaced as Necessary.

*Power Poles & Utilities
in Conflict to be
Relocated by "Others"
Prior to Construction.*

PROJECT NUMBER City of Wichita		SHEET NAME PAV05		ENGINEERING DIRECTORY F:\CENTRAL\PAV	
DESIGN JER/IMN	DRAWN IMN/KWR	APPROVED	DATE FEB 2002	SCALE NOTED	BAUGHMAN NO 99-09-F463

CAPITAL IMPROVEMENT PROJECT
CENTRAL AVENUE
TYLER to WOODCHUCK
PAVING PLAN - STA. 26+00.00 to STA. 31+50.00

BAUGHMAN COMPANY, P.A.
ENGINEERING, SURVEYING, & PLANNING
318-262-7271 • 315 ELLIS • WICHITA, KANSAS 67211

SHEET
11
OF
42