



BENCHMARKS:

BM#2 - V-Notch on Back of Walk at SE Corner of Fazoli's Restaurant Parcel, NE of Central Avenue & Tyler Road, 64.89'± North and 987.32'± East of Centerline of Both.
Sta. 19+87.32
Elev. = 146.84 (City Datum)


BM#3 - "□" Cut at SE Corner, Lot 4, Tyler Acres 5th Addition, NW of Central Avenue & Socora Lane, 65.10'± North and 34.94'± West of Centerline of Both.
Sta. 28+81.30
Elev. = 148.79 (City Datum)

Sta. 11+67.04, Line 1
B.L. Sta. 22+80.02, 47.59' Rt.
Construct Reinf. Conc. Manhole
Rim Elev. = 147.10

Sta. 0+00.00, Begin Line 2
B.L. Sta. 28+47.74, 38.67' Rt.
Construct Inlet (Type 1) (Double)
Top Elev. = 148.06

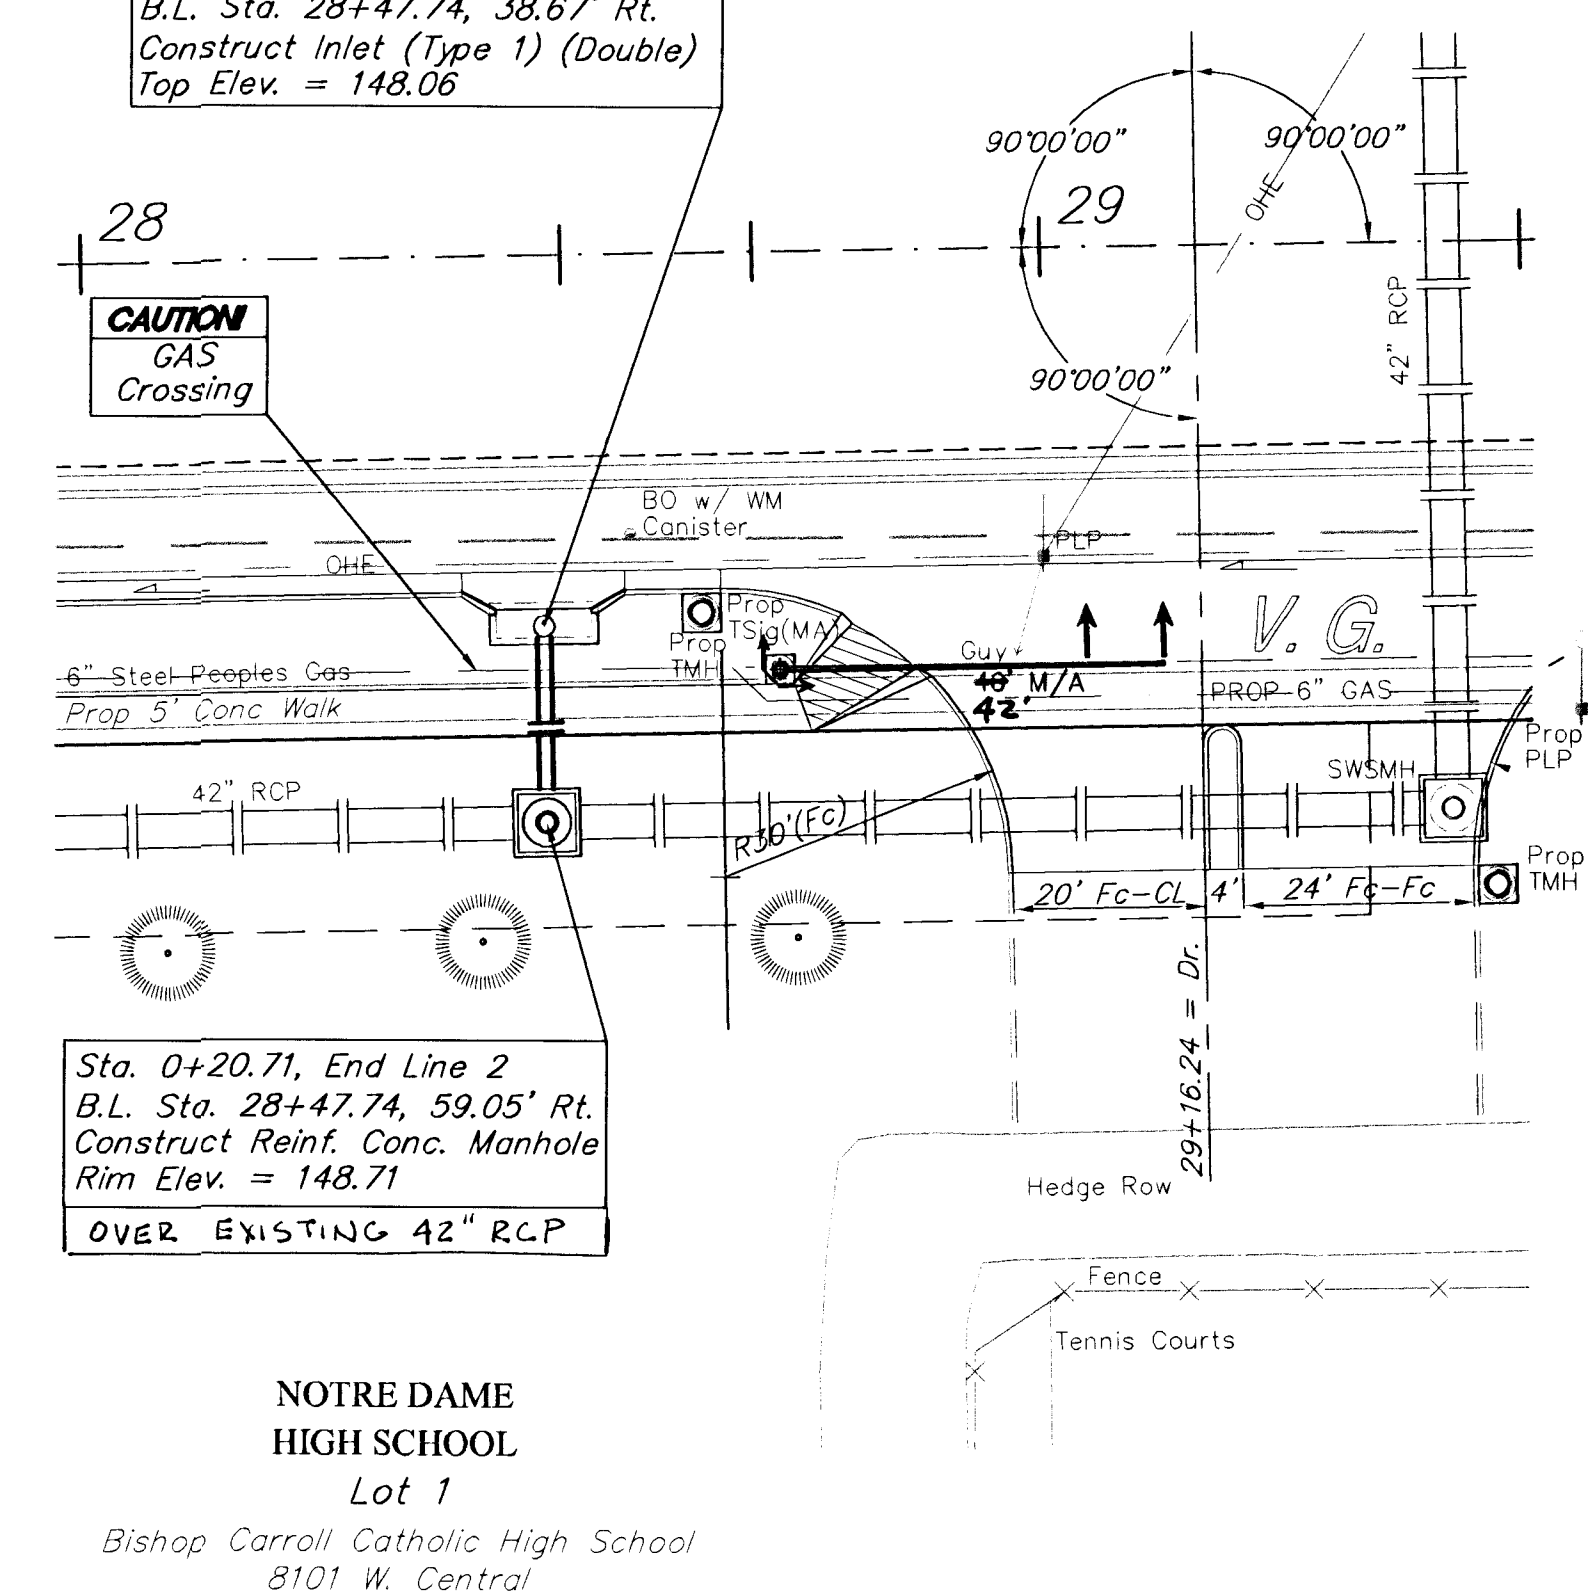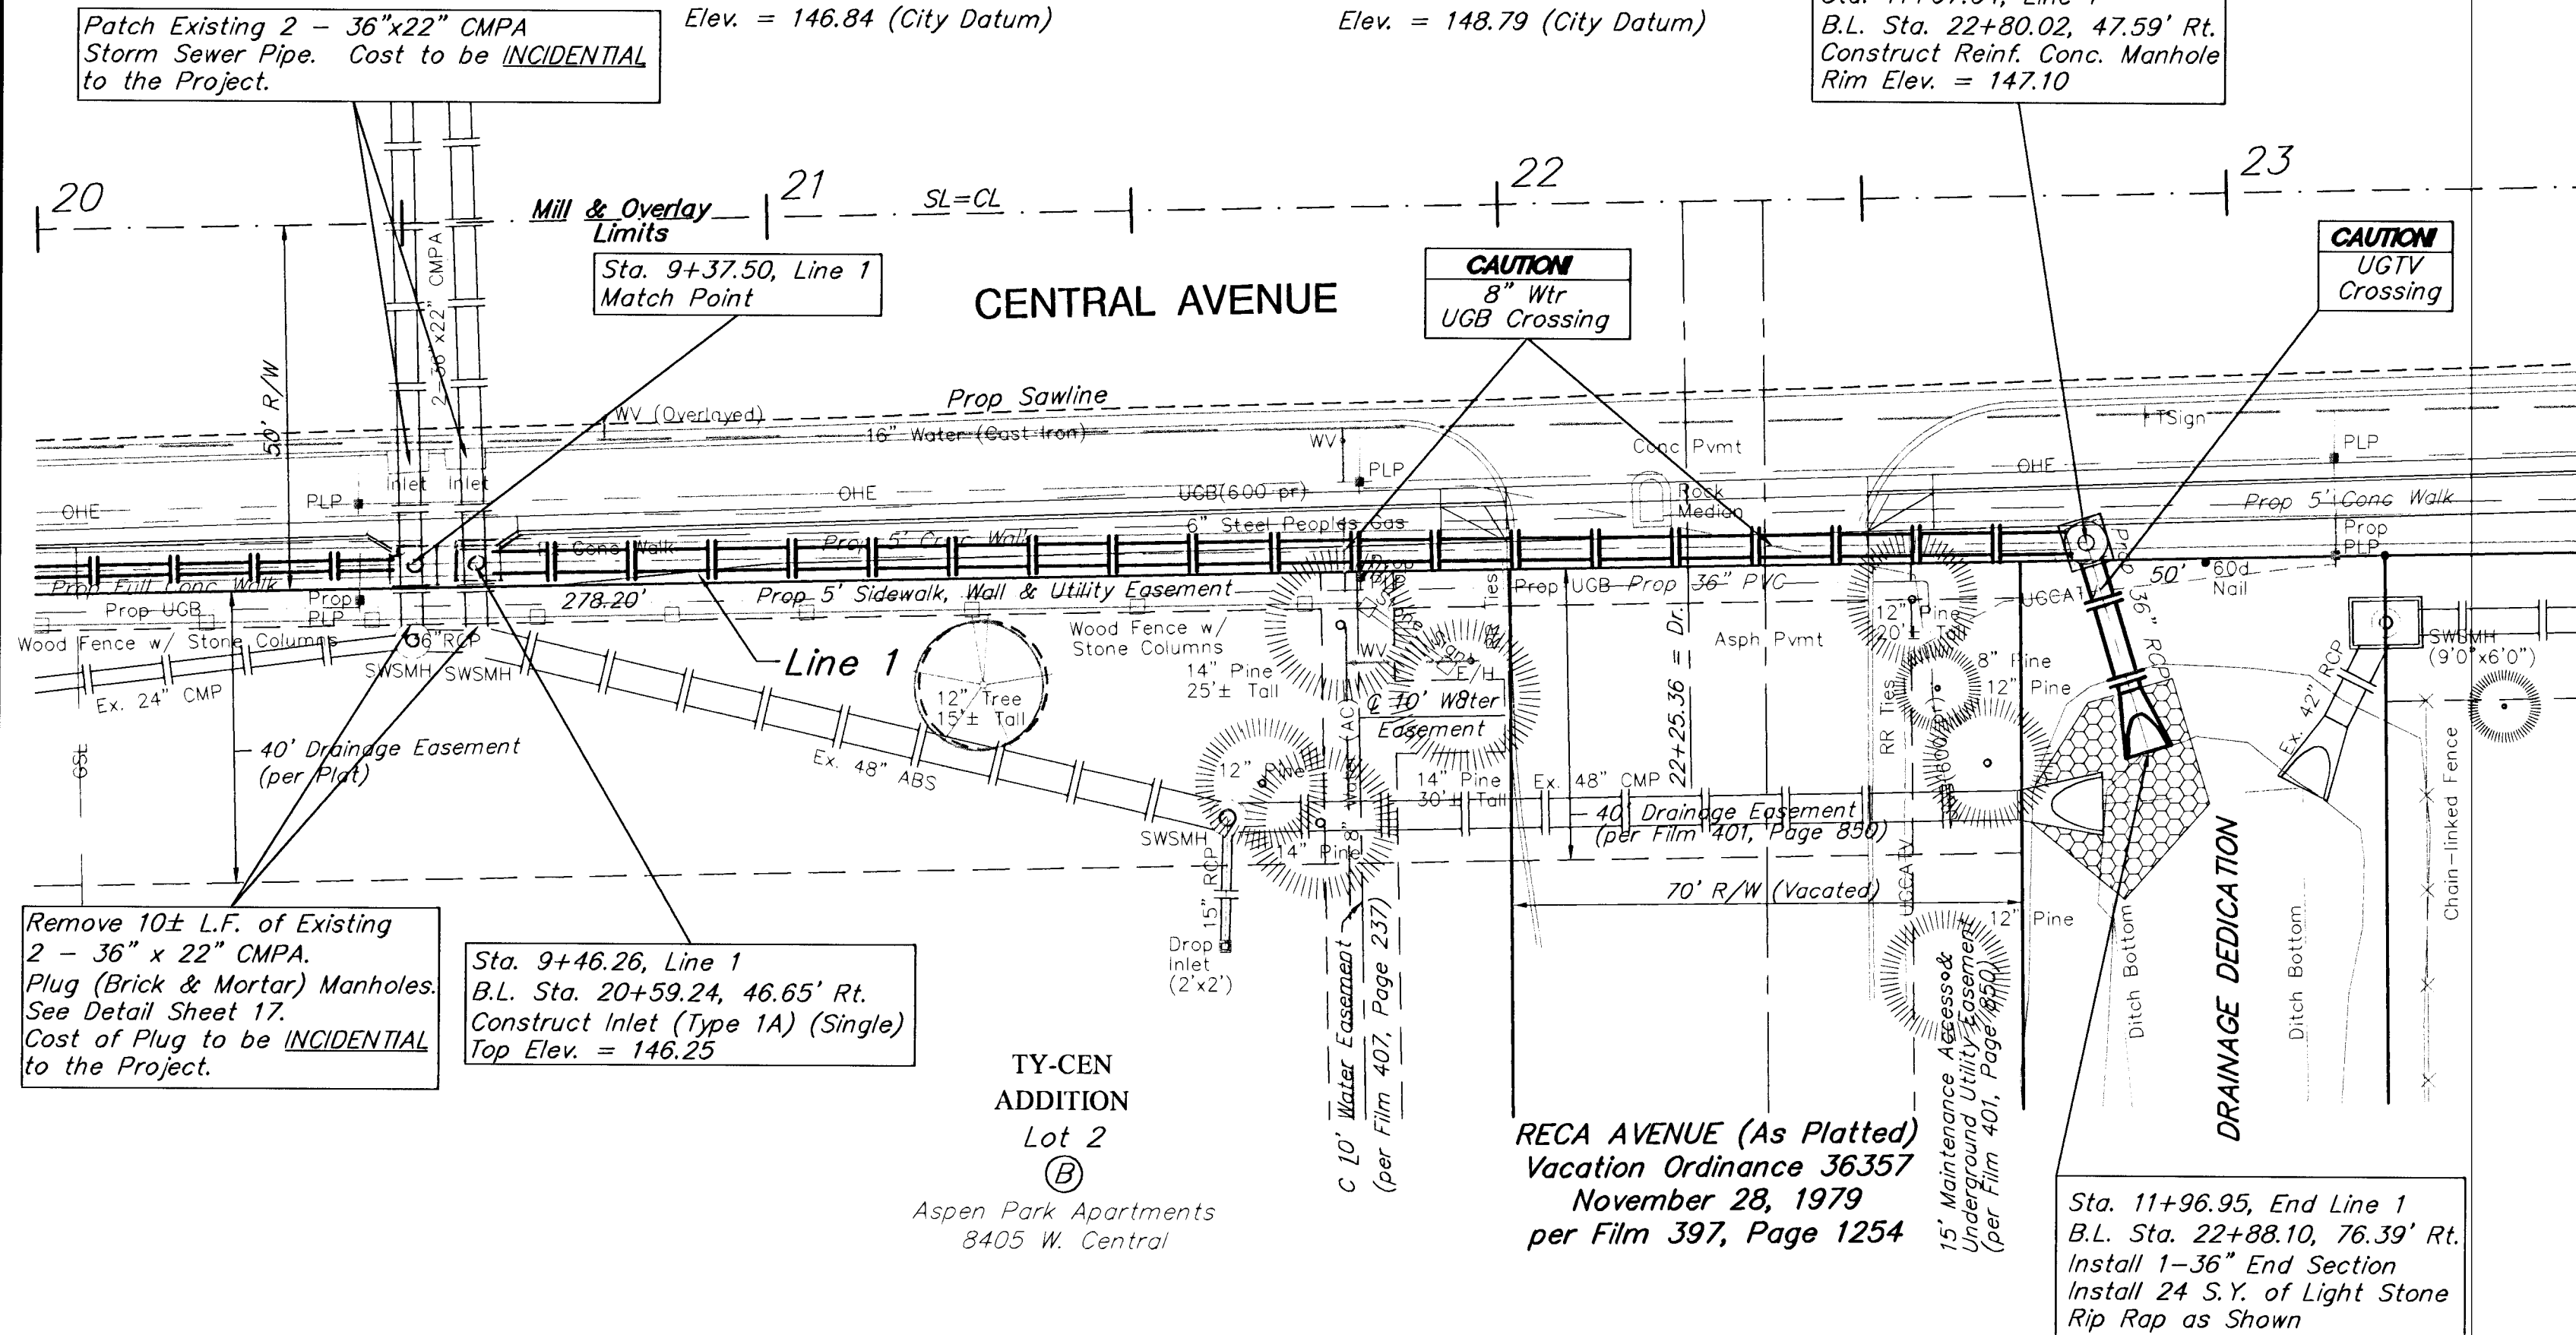

SCALE: 1" = 20'

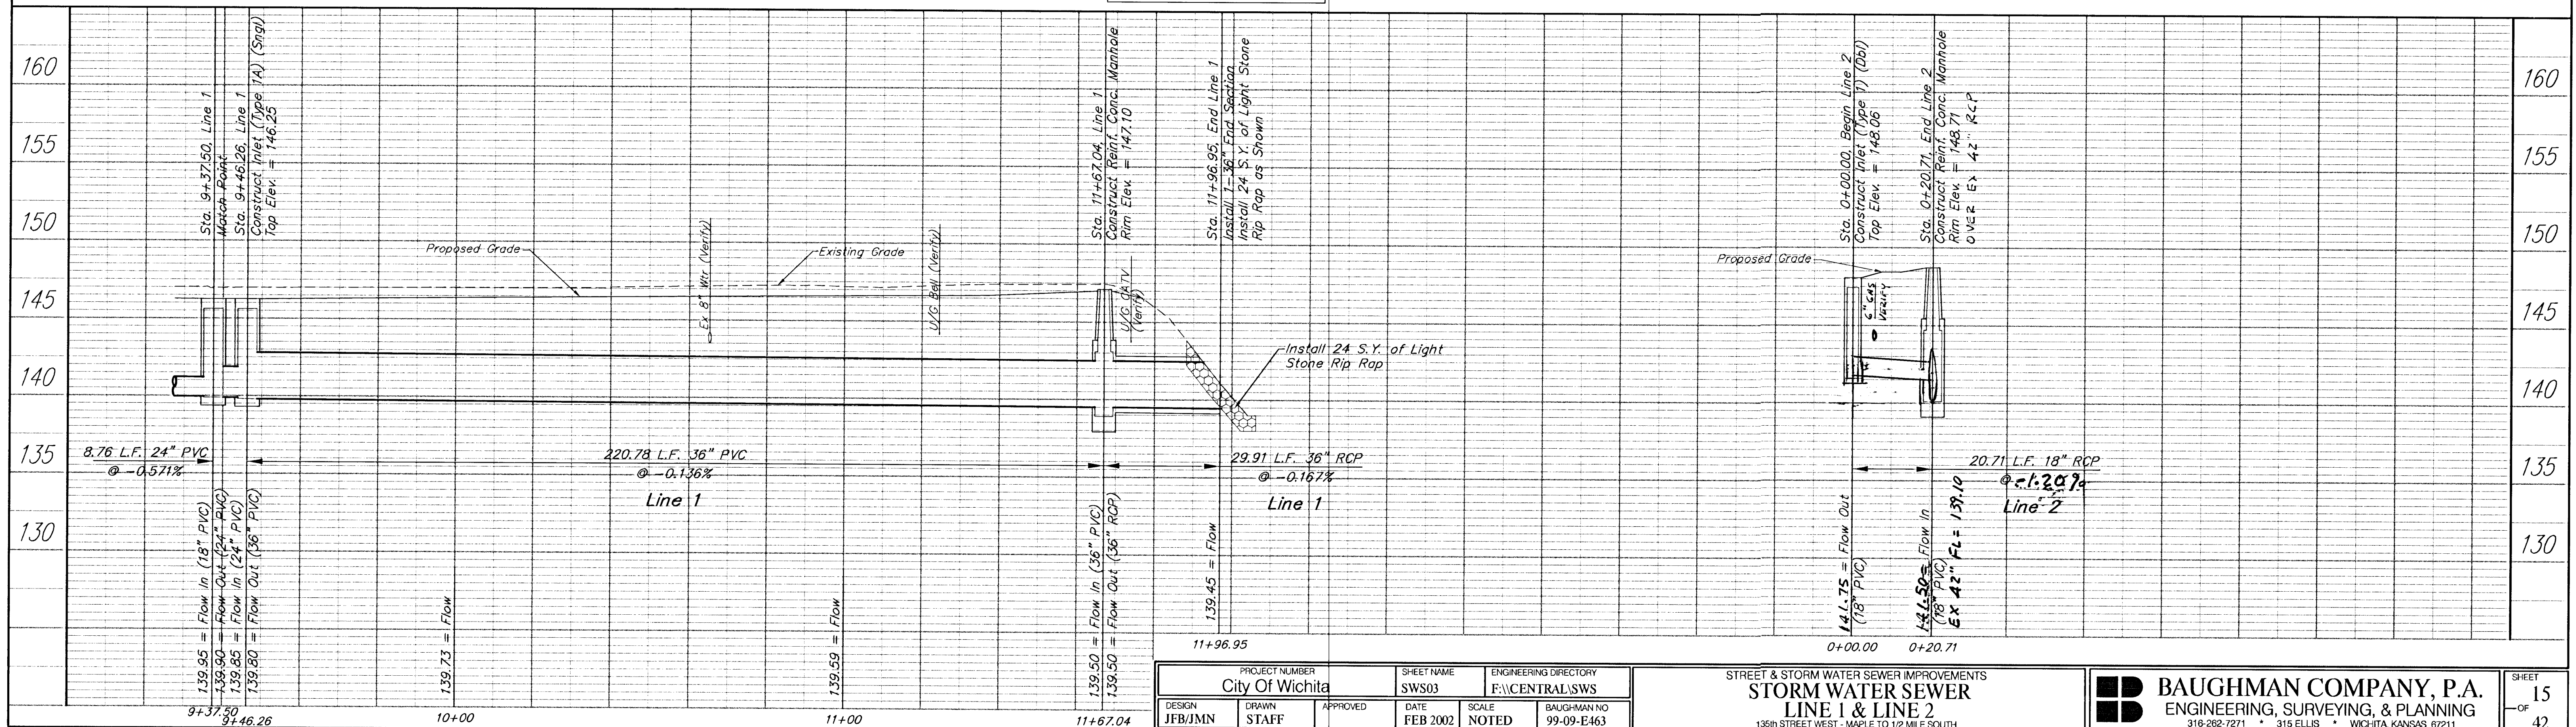

PROJECT NUMBER City Of Wichita		SHEET NAME SWS03		ENGINEERING DIRECTORY F:\CENTRAL\SWS	
DESIGN JFB/JMN	DRAWN STAFF	APPROVED	DATE FEB 2002	SCALE NOTED	BAUGHMAN NO 99-09-E463

STREET & STORM WATER SEWER IMPROVEMENTS
STORM WATER SEWER
LINE 1 & LINE 2

BAUGHMAN COMPANY, P.A.
ENGINEERING, SURVEYING, & PLANNING
316-262-7271 • 315 ELLIS • WICHITA, KANSAS 67211

SHEET
OF
15
42