


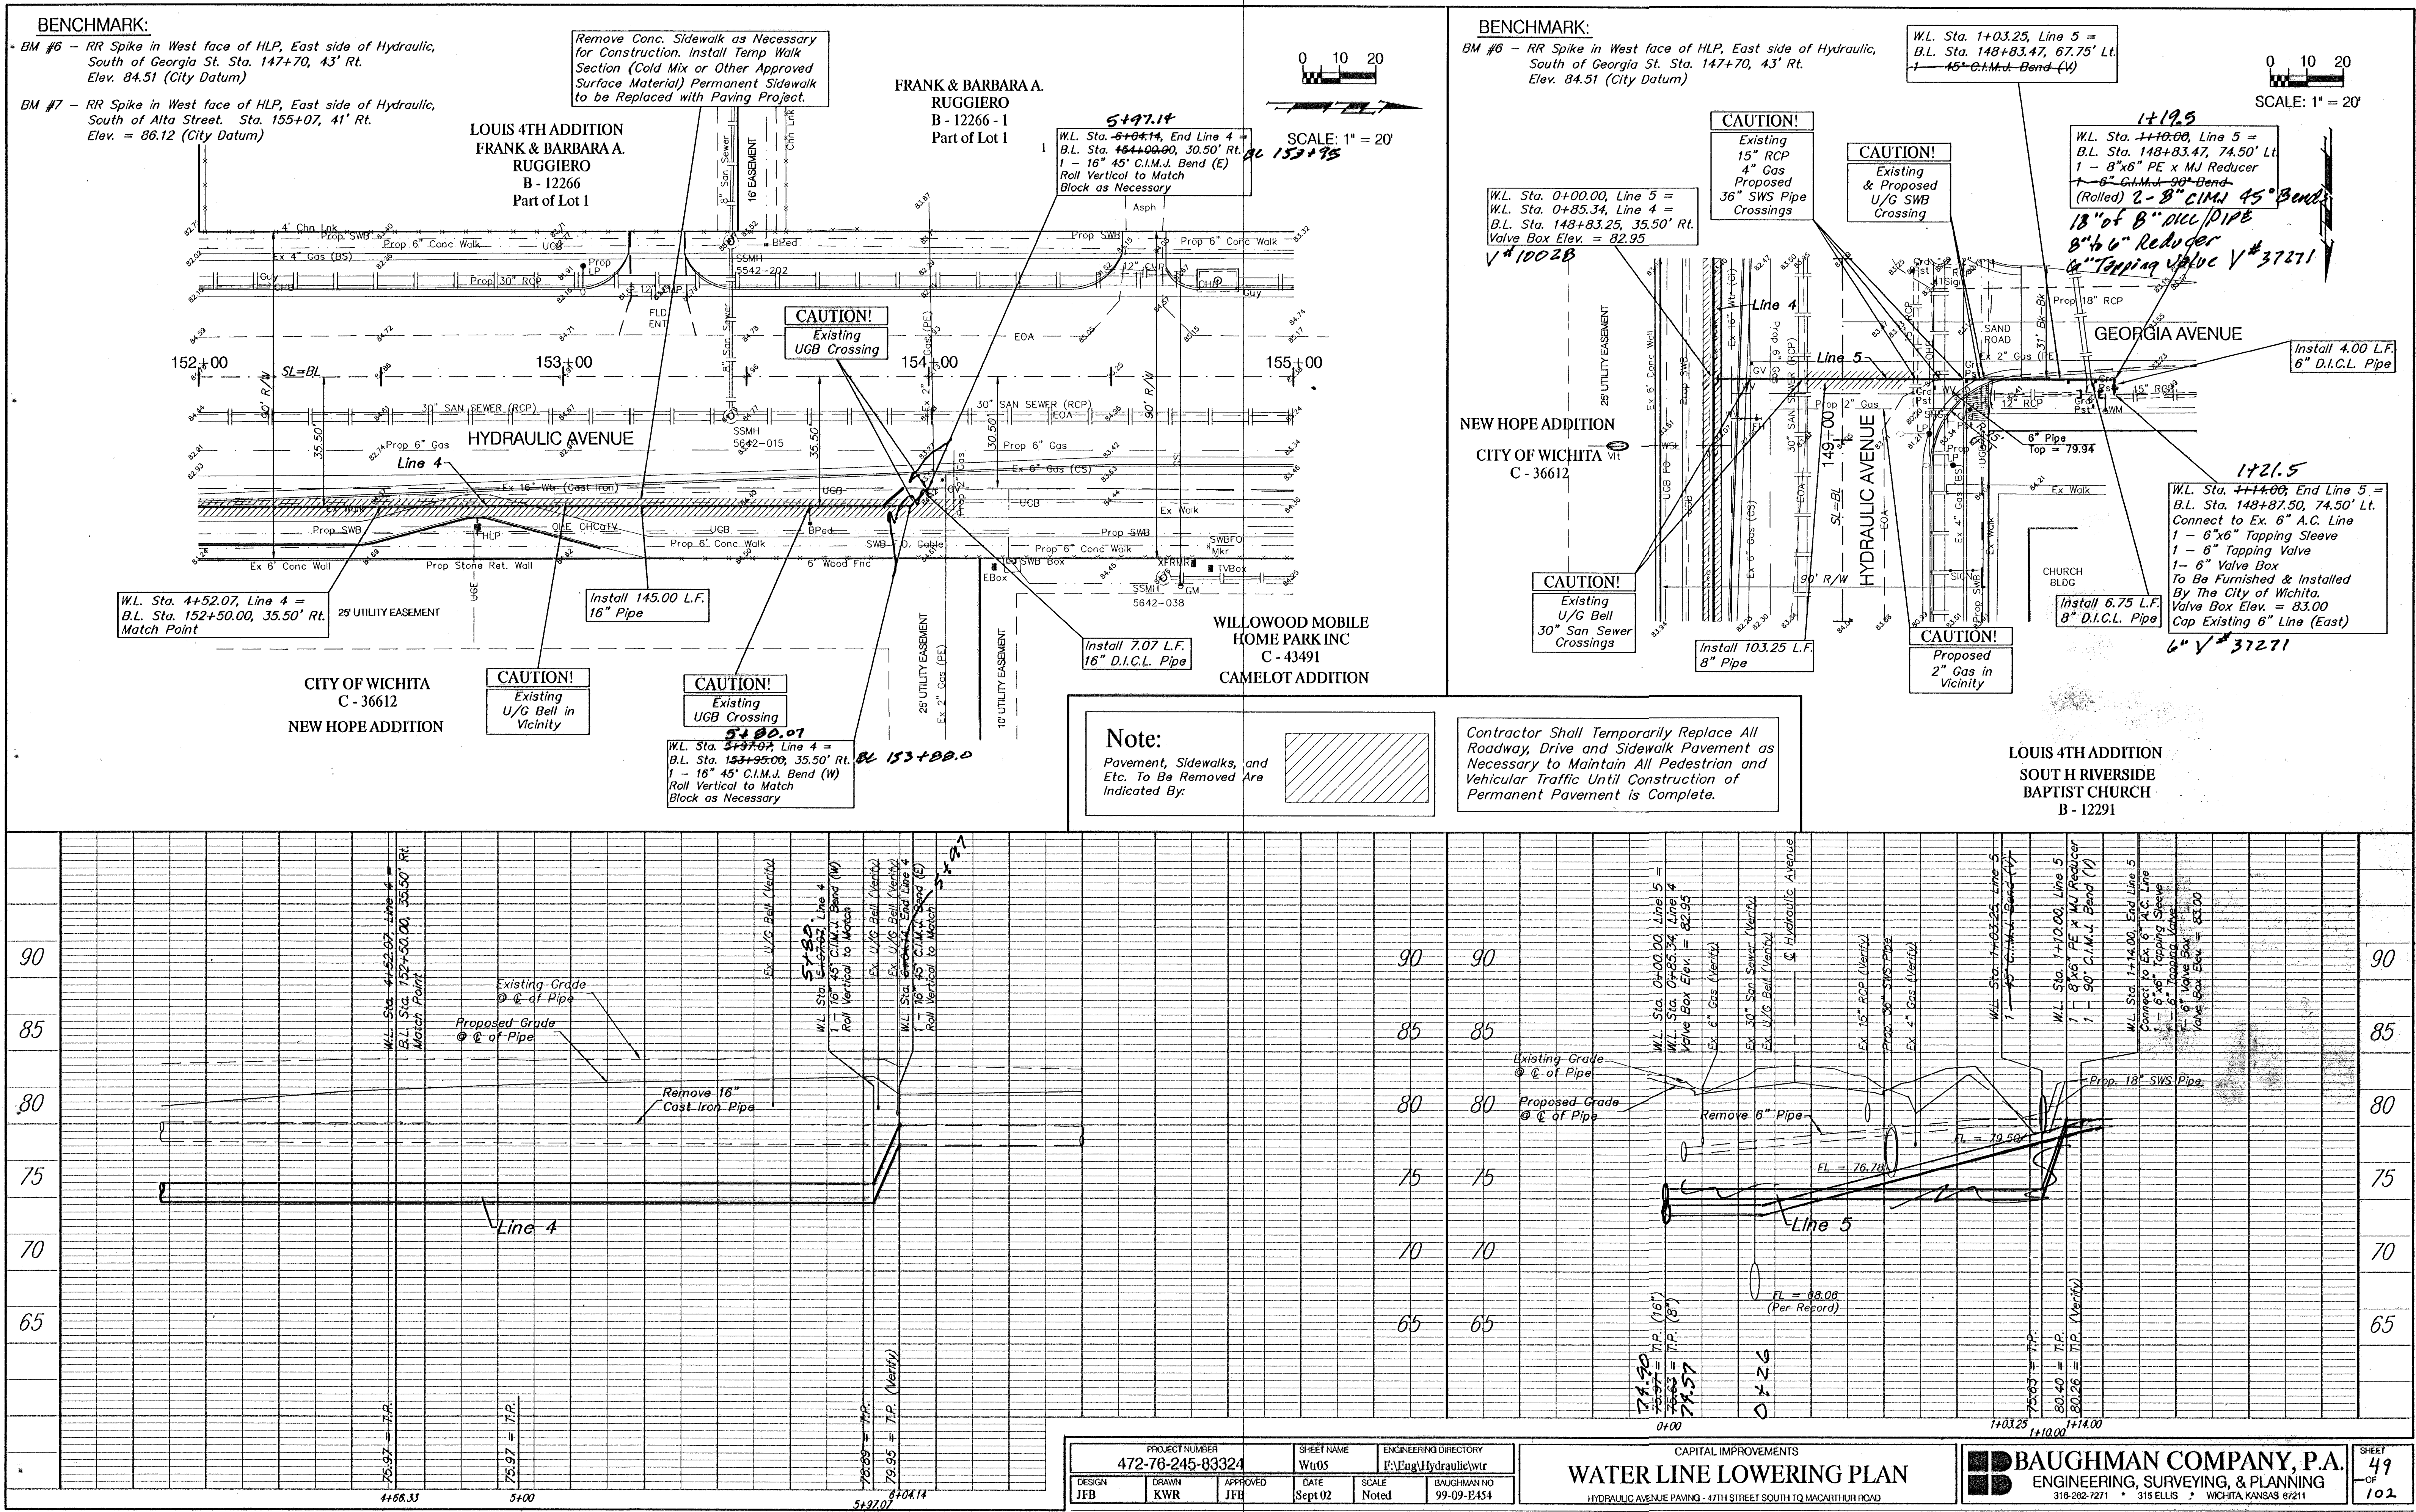

BENCHMARK:
BM #6 - RR Spike in West face of HLP, East side of Hydraulic, South of Georgia St. Sta. 147+70, 43' Rt. Elev. 84.51 (City Datum)
BM #7 - RR Spike in West face of HLP, East side of Hydraulic, South of Alta Street. Sta. 155+07, 41' Rt. Elev. = 86.12 (City Datum)

BENCHMARK:
BM #6 - RR Spike in West face of HLP, East side of Hydraulic, South of Georgia St. Sta. 147+70, 43' Rt. Elev. 84.51 (City Datum)
W.L. Sta. 1+03.25, Line 5 = B.L. Sta. 148+83.47, 67.75' Lt. 1 - 45° C.I.M.J. Bend (W)

Note:
Pavement, Sidewalks, and Etc. To Be Removed Are Indicated By:

Contractor Shall Temporarily Replace All Roadway, Drive and Sidewalk Pavement as Necessary to Maintain All Pedestrian and Vehicular Traffic Until Construction of Permanent Pavement is Complete.

