

BENCHMARK:

BM #9 - City of Wichita Bench Mark Disc, 48.6' South and 32.4' West of Centerlines Hydraulic and Mac Arthur Sta. 168+35.3, 32.4' Rt. Elev. = 86.98 (City Datum)

CHRISTIAN ADDITION

JONH C. VAN VESSUM, II, et al
B - 12209

W.L. Sta. 0+00.00, Begin Line 8 =
B.L. Sta. 164+00.00, 29.95' Rt.
1 - 45° C.I.M.J. Bend (V)

W.L. Sta. 1+31.33, Line 8 =
B.L. Sta. 165+27.92, 33.54' Rt.
Install Fire Hydrant Assy (E)
L = 350' 6.5
Valve Box Elev. = 84.90
Bury Line Elev. = 85.60


16"x6" Tee
6"x12" V
2"x6" D.I.C.L. PIPE
2"x90° Bend (V)
22"x6" D.I.C.L. PIPE (V)
6"x90° Bend (V)
24"x6" D.I.C.L. PIPE

Contractor Shall Temporarily Replace All Roadway, Drive and Sidewalk Pavement as Necessary to Maintain Pedestrian and Vehicular Traffic Until Construction of Permanent Pavement is Complete.

W.L. Sta. 3+87.3, Line 8 =
B.L. Sta. 167+96.77, 32.70' Rt.
1 - 45° C.I.M.J. Bend (V)
Restrainer/Block as Necessary


JERRY & LINDA HANSEN
B - 12208
Part of Lot 9

CAUTION!
Ex. Gas S/L
Prop. Gas S/L
Crossings

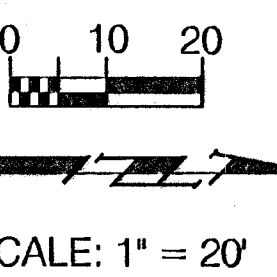

SCALE: 1" = 20'

Note:
Pavement, Sidewalks, and Etc. To Be Removed Are Indicated By:

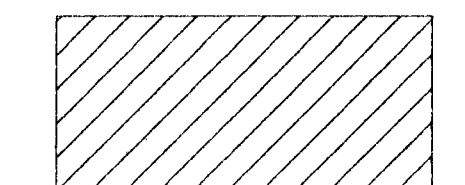

Note:
Trees/Shrubs to be removed are marked thus:



W.L. Sta. 0+07.42, Line 8 =
B.L. Sta. 164+04.10, 33.94' Rt.
1 - 45° C.I.M.J. Bend (V)
Block as Necessary
B.C. 164+15.0

B.L. Sta. 165+18.87, 34.37' Rt.
Remove Hydrant & Blocking
Remove 6" D.I.C.L. as Required.

PENTECOSTAL SECOND ADDITION

FIRST UNITED
PENTECOSTAL CHURCH INC
C - 43602


CAUTION!
Proposed
18" SWS
Crossing

2" V #20798
6"-2" PVC PIPE
6"-90° Bend (V)
3'-1"-2" PVC PIPE
2"-90° Bend
1'-8" PVC
Coupling

W.L. Sta. 3+01.81, Line 8 =
B.L. Sta. 167+05.28, 32.98' Rt.
1 - 2" Service Outlet Assembly
Contractor Shall use Fittings and Pipe as Necessary to Match

T. J. of KANSAS, Inc.
GLADYS MORRIS, et al
C - 116 - UP
Film 75, Page 993

W.L. Sta. 4+00.00, End Line 8 =
B.L. Sta. 168+00.00, 28.69' Rt. 16796
1 - 45° C.I.M.J. Bend (V)

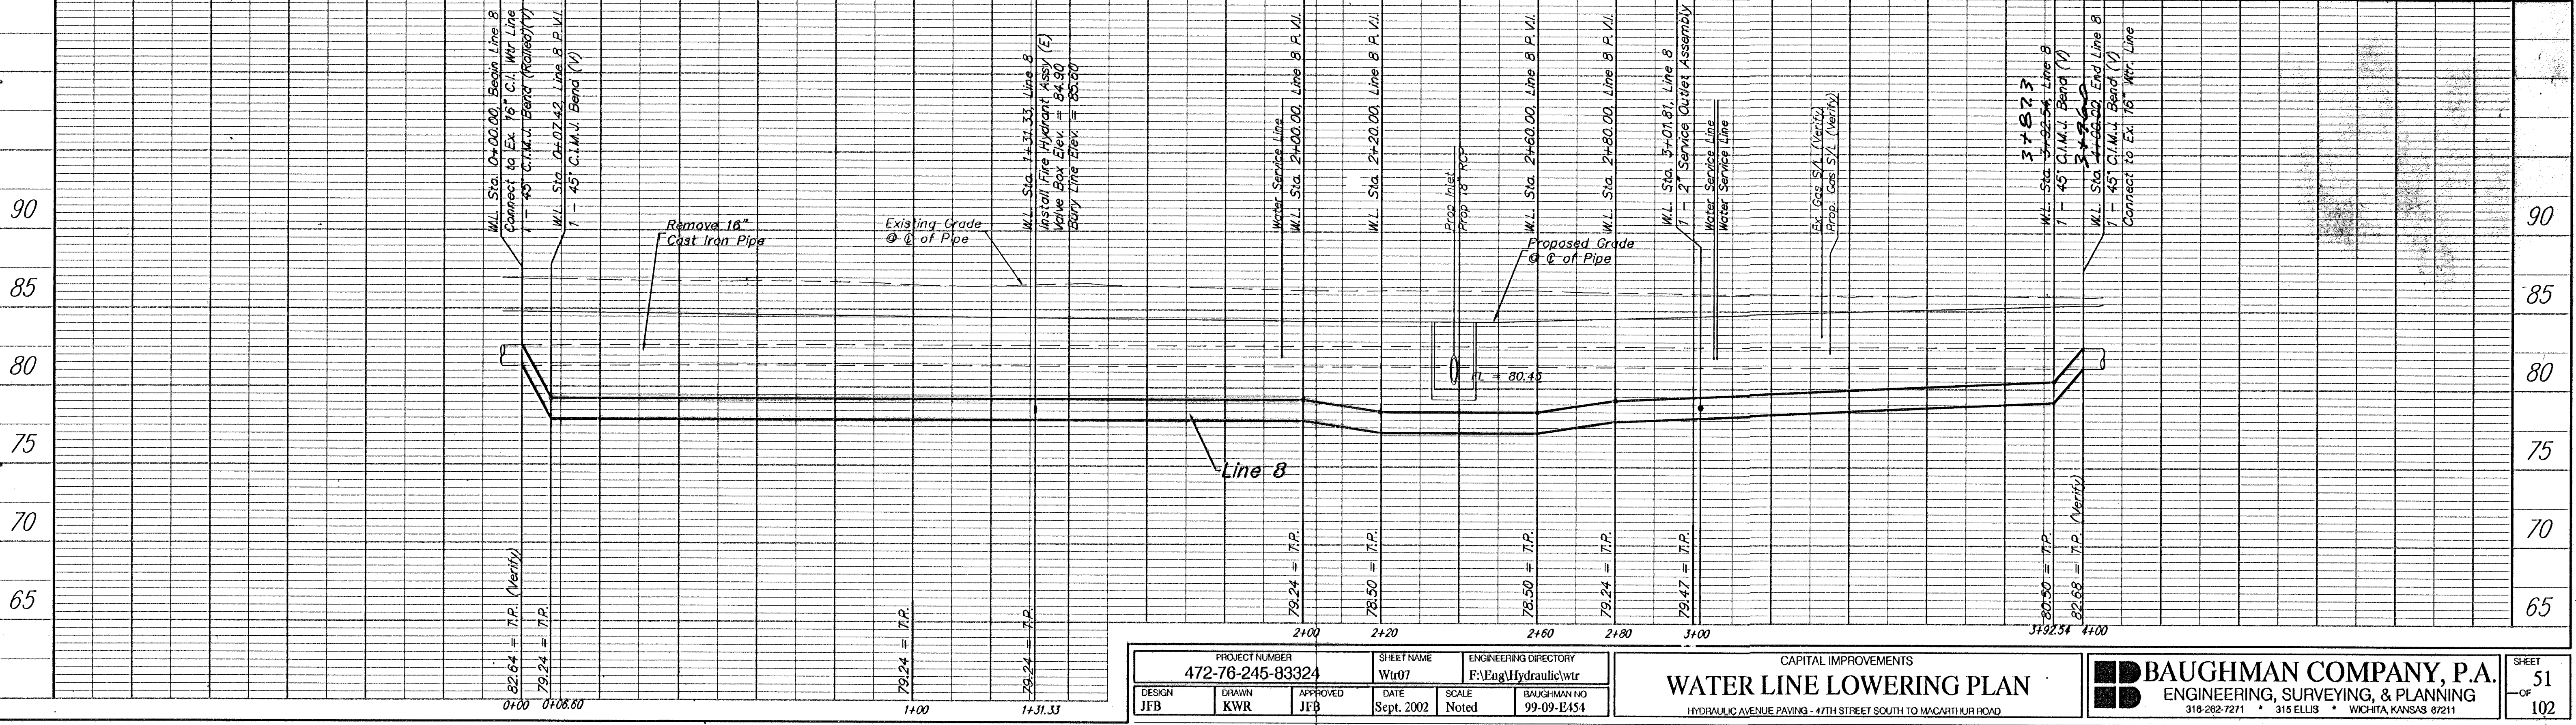

PROJECT NUMBER 472-76-245-83324			SHEET NAME Wtr07		ENGINEERING DIRECTORY F:\Eng\Hydraulic\wtr	
DESIGN JFB	DRAWN KWR	APPROVED JFB	DATE Sept. 2002	SCALE Noted	BAUGHMAN NO 99-09-E454	

CAPITAL IMPROVEMENTS
WATER LINE LOWERING PLAN
HYDRAULIC AVENUE PAVING - 47TH STREET SOUTH TO MACARTHUR ROAD

BAUGHMAN COMPANY, P.A.
ENGINEERING, SURVEYING, & PLANNING
316-262-7271 • 315 ELLIS • WICHITA, KANSAS 67211

SHEET
OF
102